

NOTES

This plan has been prepared from As Constructed Surveys of sewerage, water and drainage services only. No other services have been located.

Before starting any demolition, excavation or construction on the site, the relevant person should make an independent and updated enquiry of "dial before you dig" and any relevant service providers to ascertain the existence of further services (if any) and the accurate location of those not able to have been surveyed at the time of preparing this plan.

* No responsibility can be accepted by Saunders Havill Group Pty Ltd, for any damage caused to any underground service or any loss or injury so suffered if enquiry and verification have not been completed in accordance with this note.

** This note is an integral part of this plan/data. Reproduction of this plan or any part of it without this note being included in full will render the information shown on such reproduction invalid and not suitable for use.


LEGEND

| | by Survey | by Design |
|---------------|-----------|-----------|
| SEWER MAINS | | |
| WATER SUPPLY | | |
| WATER CONDUIT | | |
| WATER SERVICE | | |
| STORMWATER | | |

SYMBOLS **ABBREVIATIONS**

| | | | | |
|-----------------------|--|-----|----|-------------------|
| Sewer Manhole / Shaft | | SMH | MH | Manhole |
| Fire Hydrant | | MS | MS | Maintenance Shaft |
| Valve | | SL | SL | Surface Level |
| Water Meter | | IL | IL | Invert Level |
| Kerb Adapter | | BM | BM | Bench Mark |
| Stormwater Manhole | | Ø | Ø | Diameter |
| Stormwater Pit | | KA | KA | Kerb Adapter |
| | | HC | HC | House Connection |

9001 (Pt)
SP311185

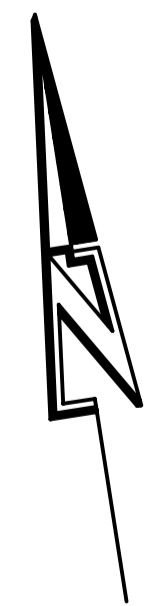

Scale 1:250 - Lengths are in Metres.

saunders havill group
 Saunders Havill Group Pty Ltd ABN 24 144 972 949
 Brisbane • Springfield • Rockhampton
 head office 9 Thompson St Bowen Hills Q 4006
 phone 1800 123 SHG web www.saundershavill.com
 surveying • town planning • urban design • environmental management • landscape architecture

| No. | Drawn | Date | Description | Checked |
|-----|-------|------------|----------------|---------|
| A | JTC | 05.04.2019 | Original Issue | MK |

Plan of **AS CONSTRUCTED SKETCH**
 Project **EDEN'S CROSSING ESTATE - STAGE 11**
 Client **PEET No 119 Pty Ltd**

| Surveyed | Date | Lot Description |
|--|----------|---|
| BH/CU | Mar 2019 | Lots 623-635, 686-694, 719 & 720 on SP302891 |
| Level Datum: AHD der. | | Locality: Redbank Plains Local Government: Ipswich City Council |
| Origin of Levels: PM203515 RL of Origin: 86.32 | | |
| Contour Interval: | | |

surveying
 Scale @A1 1: 250
 @A3 1: 500
 Dwg No. **8655 S 15 BE A**