

NOTES

This plan has been prepared from As Constructed Surveys of sewerage, water and drainage services only. No other services have been located.

Before starting any demolition, excavation or construction on the site, the relevant person should make an independent and updated enquiry of "dial before you dig" and any relevant service providers to ascertain the existence of further services (if any) and the accurate location of those not able to have been surveyed at the time of preparing this plan.

* No responsibility can be accepted by Saunders Havill Group Pty Ltd, for any damage caused to any underground service or any loss or injury so suffered if enquiry and verification have not been completed in accordance with this note.

** This note is an integral part of this plan/data. Reproduction of this plan or any part of it without this note being included in full will render the information shown on such reproduction invalid and not suitable for use.

LEGEND

	by Survey	by Design
SEWER MAINS		
WATER SUPPLY		
WATER CONDUIT		
WATER SERVICE		
STORMWATER		

SYMBOLS

ABBREVIATIONS

Sewer Manhole / Shaft		SMH	Manhole
Fire Hydrant		MS	Maintenance Shaft
Valve		SL	Surface Level
Water Meter		IL	Invert Level
Kerb Adapter		BM	Bench Mark
Stormwater Manhole		Ø	Diameter
Stormwater Pit		KA	Kerb Adapter
		HC	House Connection

Scale 1:250 - Lengths are in Metres.

saunders havill group
 Saunders Havill Group Pty Ltd ABN 24 144 972 949
 Brisbane • Springfield • Rockhampton
 head office 9 Thompson St Bowen Hills Q 4006
 phone 1300 123 SHG web www.saundershavill.com

• surveying • town planning • urban design • environmental management • landscape architecture

No.	Drawn	Date	Description	Checked
A	TBG	03.03.2020	Original Issue	MK

Plan of **AS CONSTRUCTED SKETCH**
 Sheet 1 of 2

Project **EDEN'S CROSSING ESTATE - STAGE 14**

Client **PEET No 119 Pty Ltd**

Surveyed	Date	Lot Description
BH/CU	Mar 2020	Lots 670-685, 740-763 & 1111 on SP302894
Level Datum: AHD der.		Locality: Redbank Plains Local Government: Ipswich City Council
Origin of Levels: PM203515 RL of Origin: 86.32		Dwg No. 8655 S 25 BE A
Contour Interval:		

surveying

Scale @A1 1: 250
 @A3 1: 500



NOTES

This plan has been prepared from As Constructed Surveys of sewerage, water and drainage services only. No other services have been located.

Before starting any demolition, excavation or construction on the site, the relevant person should make an independent and updated enquiry of "dial before you dig" and any relevant service providers to ascertain the existence of further services (if any) and the accurate location of those not able to have been surveyed at the time of preparing this plan.

* No responsibility can be accepted by Saunders Havill Group Pty Ltd, for any damage caused to any underground service or any loss or injury so suffered if enquiry and verification have not been completed in accordance with this note.

** This note is an integral part of this plan/data. Reproduction of this plan or any part of it without this note being included in full will render the information shown on such reproduction invalid and not suitable for use.

LEGEND


SEWER MAINS	by Survey	by Design
WATER SUPPLY		
WATER CONDUIT		
WATER SERVICE		
STORMWATER		

SYMBOLS


Sewer Manhole / Shaft	SMH
Fire Hydrant	
Valve	
Water Meter	WM
Kerb Adapter	Ka
Stormwater Manhole	
Stormwater Pit	

ABBREVIATIONS

MH	Manhole
MS	Maintenance Shaft
SL	Surface Level
IL	Invert Level
BM	Bench Mark
Ø	Diameter
KA	Kerb Adapter
HC	House Connection

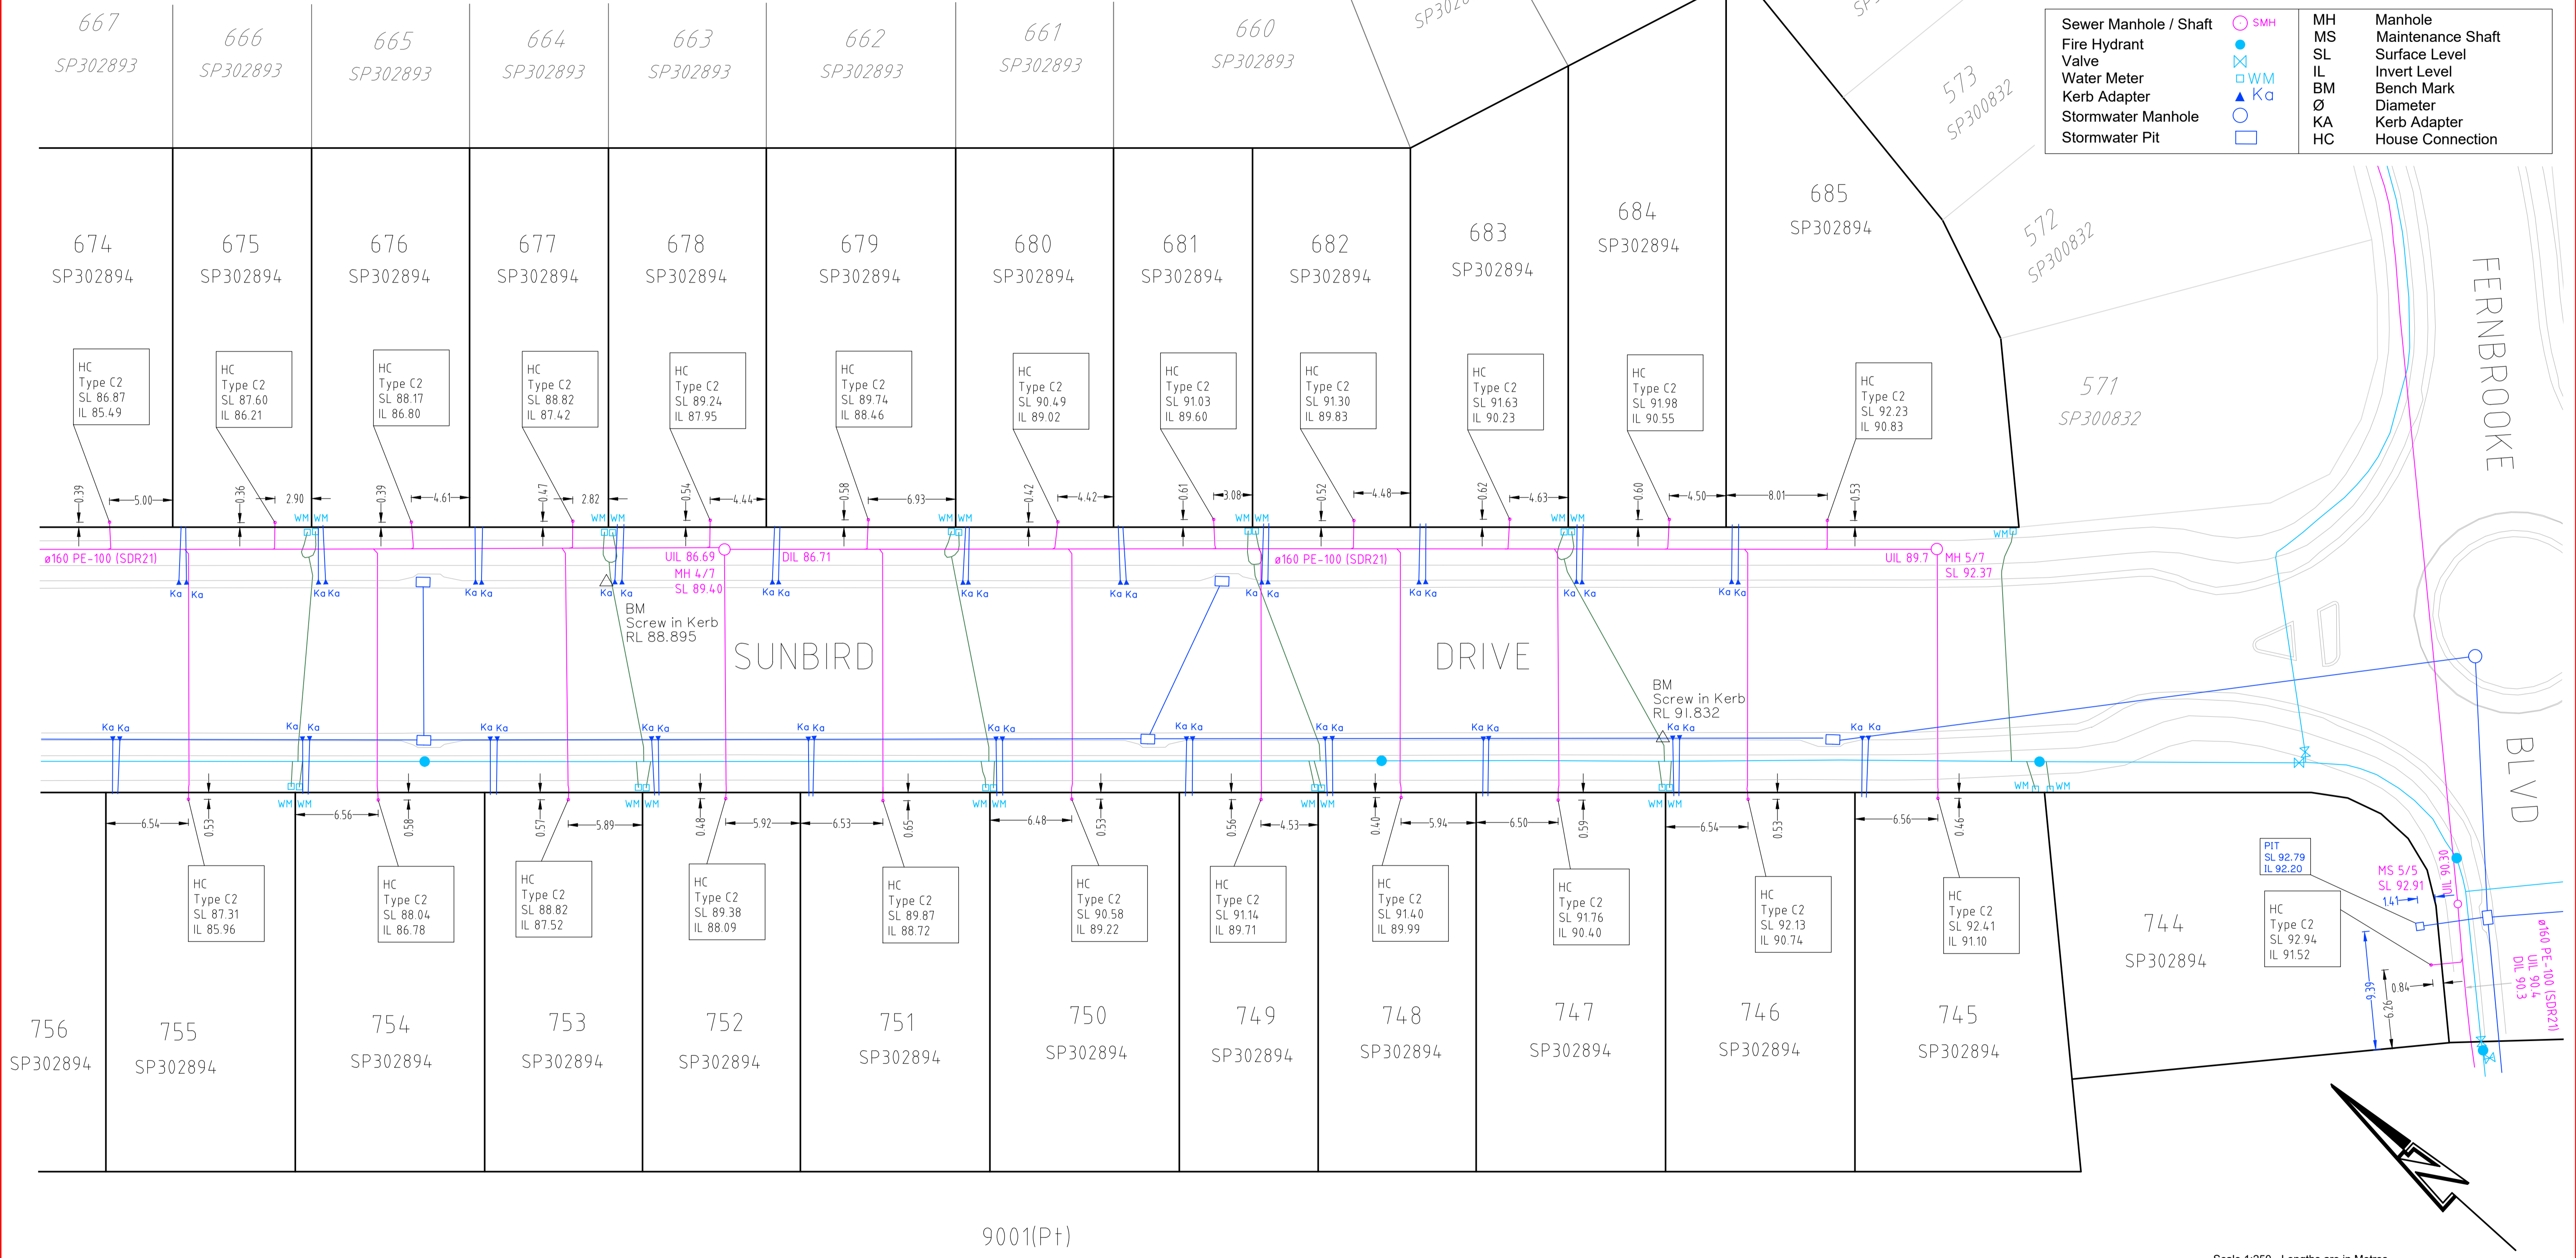

9001(Pt)

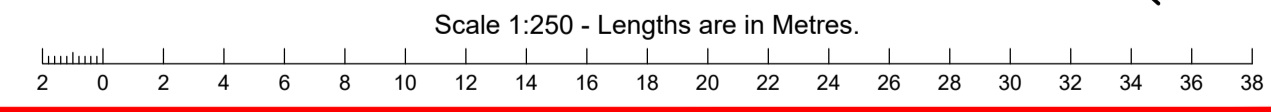

saunders havill group
 Saunders Havill Group Pty Ltd ABN 24 144 972 949
 Brisbane • Springfield • Rockhampton
 head office 9 Thompson St Bowen Hills Q 4006
 phone 1300 123 SHG web www.saundershavill.com

■ surveying ■ town planning ■ urban design ■ environmental management ■ landscape architecture

No.	Drawn	Date	Description	Checked
A	TBG	03.03.2020	Original Issue	MK

Plan of **AS CONSTRUCTED SKETCH**
Sheet 2 of 2

Project **EDEN'S CROSSING ESTATE - STAGE 14**

Client **PEET No 119 Pty Ltd**

Surveyed	Date
BH/CU	Mar 2020
Level Datum: AHD der.	
Origin of Levels: PM203515	
RL of Origin: 86.32	
Contour Interval:	

Lot Description
 Lots 670-685, 740-763 & 1111 on SP302894

Locality: Redbank Plains
 Local Government: Ipswich City Council

surveying

Scale @A1 1: 250
 @A3 1: 500

Dwg No. **8655 S 25 BE A**