



COTTON CRESCENT



LEGEND	
SEWER MAINS	by Survey
WATER MAINS	
WATER CONDUIT	
STORMWATER	

SYMBOLS		ABBREVIATIONS	
Sewer Manhole / Shaft	SMH	MH	Manhole
Fire Hydrant	FD	MS	Maintenance Shaft
Valve	V	SL	Surface Level
Water Meter	WM	IL	Invert Level
Kerb Adapter	Ka	BM	Bench Mark
Stormwater Manhole	SMH	Ø	Diameter
Stormwater Pit	SP	Ka	Kerb Adapter
		HC	House Connection

No.	Drawn	Date	Description	Checked
A	JC	13.09.2018	Original Issue	CU

Plan of **As Constructed Sketch (Sheet 1 of 2)**

Project **EDENS CROSSING - STAGE 7**

Client **Peet Pty Ltd**

Surveyed	Date
CU	Aug 2018

Level Datum: AHD der.

Origin of Levels: PM203515

RL of Origin: 86.32

Contour Interval:

Lot Description **SP300831**

Locality: Redbank Plains

Local Government: Ipswich City Council


surveying

Scale @A1 1:250

@A3 1:500

Dwg No. **8459 S 36 SE A**

SH saunders havill group Saunders Havill Group Pty Ltd ABN 24 144 972 949
 Brisbane • Emerald • Rockhampton
 head office 9 Thompson St Bowen Hills Q 4006
 phone 1300 123 SHG web www.saundershavill.com
 ■ surveying ■ town planning ■ urban design ■ environmental management ■ landscape architecture

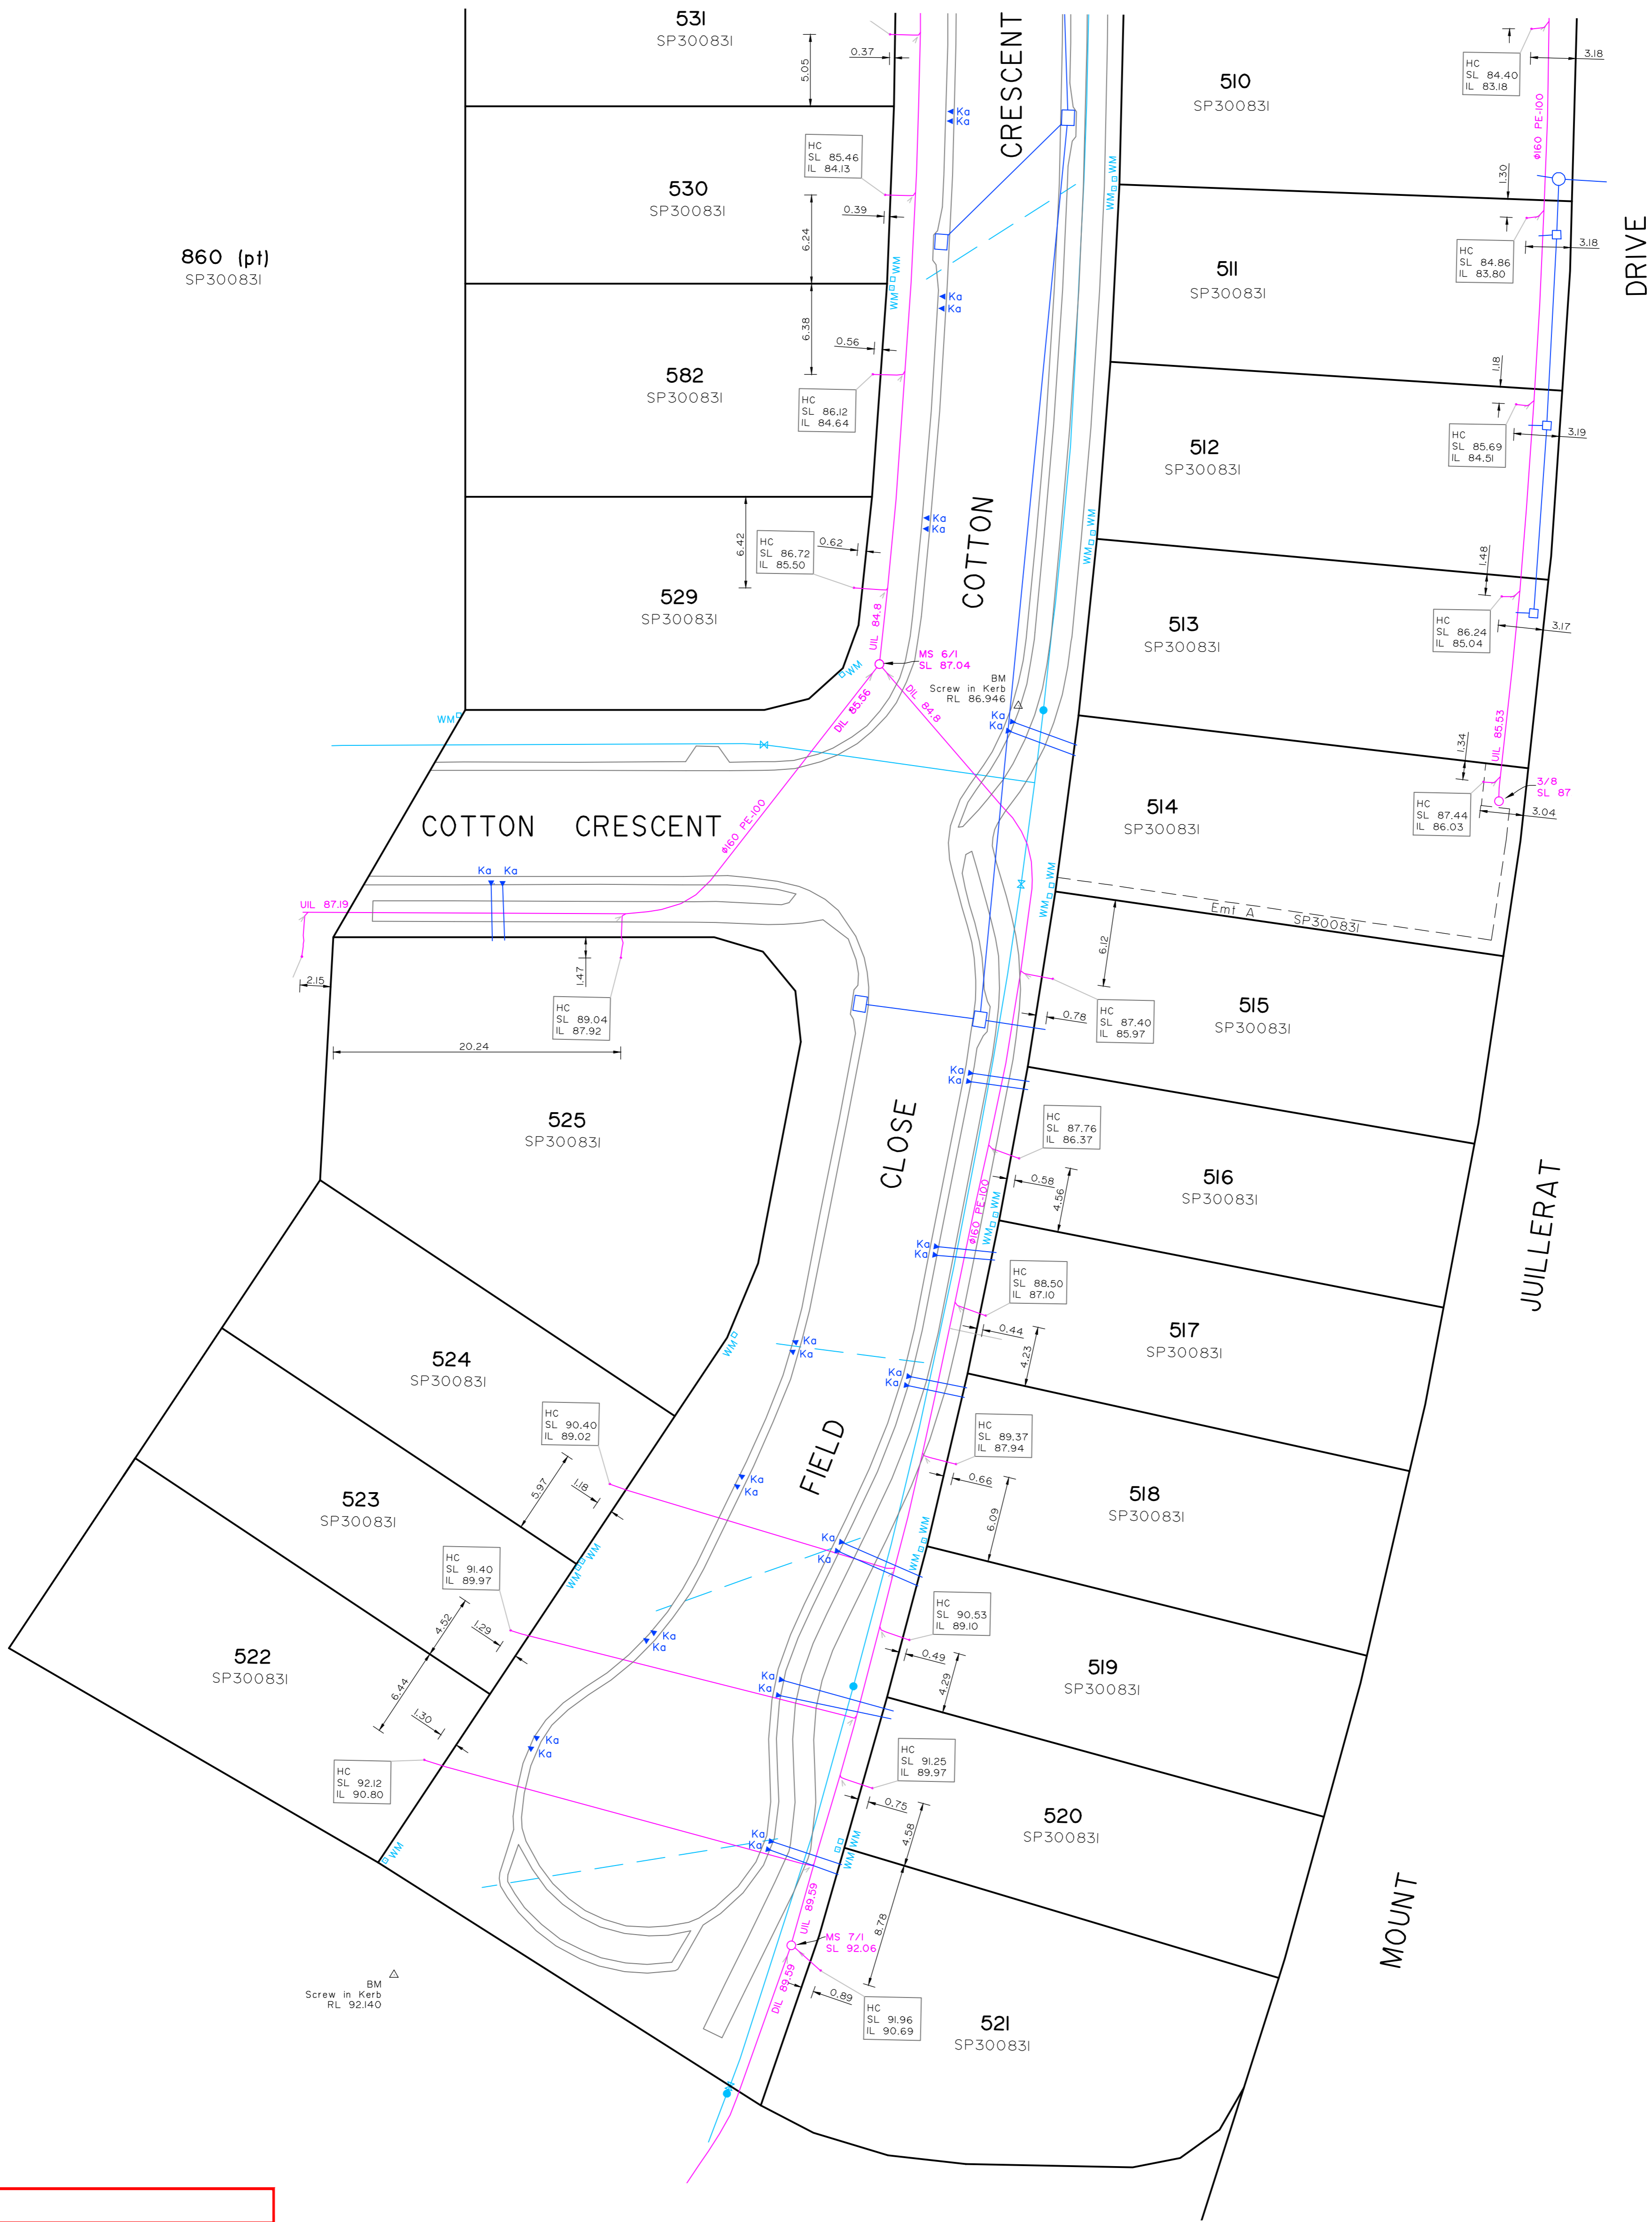

LEGEND

SEWER MAINS	by Survey
WATER MAINS	
WATER CONDUIT	
STORMWATER	

SYMBOLS **ABBREVIATIONS**

Sewer Manhole / Shaft	SMH	MH	Manhole
Fire Hydrant	FD	MS	Maintenance Shaft
Valve	V	SL	Surface Level
Water Meter	WM	IL	Invert Level
Kerb Adapter	Ka	BM	Bench Mark
Stormwater Manhole	SMH	Ø	Diameter
Stormwater Pit	SP	KA	Kerb Adapter
		HC	House Connection

Scale 1:250 - Lengths are in Metres.
0 2 4 6 8 10 12 14 16 18 20 22 24 26 28 30 32 34 36 38

No.	Drawn	Date	Description	Checked
A	JC	13.09.2018	Original Issue	CU

Plan of **As Constructed Sketch (Sheet 2 of 2)**

Project **EDENS CROSSING - STAGE 7**

Client **Peet Pty Ltd**

Surveyed	Date
CU	Aug 2018
Level Datum:	AHD der.
Origin of Levels:	PM203515
RL of Origin:	86.32
Contour Interval:	

Lot Description
SP300831

Locality: Redbank Plains
Local Government:
Ipswich City Council

surveying

Scale @A1 1:250
@A3 1:500

Dwg No. **8459 S 36 SE A**



Saunders Havill Group Pty Ltd ABN 24 144 972 949
Brisbane • Emerald • Rockhampton
head office 9 Thompson St Bowen Hills Q 4006
phone 1300 123 SHG web www.saundershavill.com

■ surveying ■ town planning ■ urban design ■ environmental management ■ landscape architecture