

Consulting Engineer's Certification.

I,, hereby certify that the As Constructed information shown on this plan is a true and correct record of the sizes, types, materials, classes etc., and it corresponds with the relevant approved Engineering Drawings.


Signed..... RPECO No Dated.....

Registered Surveyor's Certification.

We, Queensland Surveying Pty Ltd, hereby certify that the horizontal and vertical locations, and dimensions shown on this plan are a true and correct record of the As Constructed information.

Signed. *RS April* Sadastral Surveyor
..... Brisbane, Reg. No 6152, Dated 05/04/2017




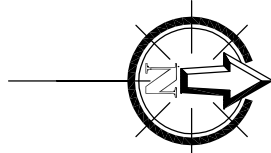

<p>FLAGSTONE</p> <p>STAGE 1C</p> <p>PEET FLAGSTONE</p> <p>CITY PTY LTD</p>		<p>THE PEET FLAGSTONE PTY LTD (AS A COMPANY INCORPORATED IN AUSTRALIA)</p> <p>is pleased to advise you that the following information is available for the public inspection of the documents referred to in the Statement of Intent to Call for Tenders for the above project.</p> <p>The project documents, statements and any other documents referred to in the Statement of Intent to Call for Tenders are available for inspection at the following address:</p> <p>Peet Flagstone Pty Ltd</p> <p>100/1000 Sturt Street</p> <p>Perth Western Australia 6000</p> <p>At the following time and on the following days:</p> <p>From 10.00am to 4.00pm on the following days:</p> <p>Monday 10th July 2017</p> <p>Tuesday 11th July 2017</p> <p>Wednesday 12th July 2017</p> <p>Thursday 13th July 2017</p> <p>Friday 14th July 2017</p> <p>Saturday 15th July 2017</p> <p>Sunday 16th July 2017</p> <p>Monday 17th July 2017</p> <p>Tuesday 18th July 2017</p> <p>Wednesday 19th July 2017</p> <p>Thursday 20th July 2017</p> <p>Friday 21st July 2017</p> <p>Saturday 22nd July 2017</p> <p>Sunday 23rd July 2017</p> <p>Monday 24th July 2017</p> <p>Tuesday 25th July 2017</p> <p>Wednesday 26th July 2017</p> <p>Thursday 27th July 2017</p> <p>Friday 28th July 2017</p> <p>Saturday 29th July 2017</p> <p>Sunday 30th July 2017</p> <p>Monday 31st July 2017</p> <p>Tuesday 1st August 2017</p> <p>Wednesday 2nd August 2017</p> <p>Thursday 3rd August 2017</p> <p>Friday 4th August 2017</p> <p>Saturday 5th August 2017</p> <p>Sunday 6th August 2017</p> <p>Monday 7th August 2017</p> <p>Tuesday 8th August 2017</p> <p>Wednesday 9th August 2017</p> <p>Thursday 10th August 2017</p> <p>Friday 11th August 2017</p> <p>Saturday 12th August 2017</p> <p>Sunday 13th August 2017</p> <p>Monday 14th August 2017</p> <p>Tuesday 15th August 2017</p> <p>Wednesday 16th August 2017</p> <p>Thursday 17th August 2017</p> <p>Friday 18th August 2017</p> <p>Saturday 19th August 2017</p> <p>Sunday 20th August 2017</p> <p>Monday 21st August 2017</p> <p>Tuesday 22nd August 2017</p> <p>Wednesday 23rd August 2017</p> <p>Thursday 24th August 2017</p> <p>Friday 25th August 2017</p> <p>Saturday 26th August 2017</p> <p>Sunday 27th August 2017</p> <p>Monday 28th August 2017</p> <p>Tuesday 29th August 2017</p> <p>Wednesday 30th August 2017</p> <p>Thursday 31st August 2017</p> <p>Friday 1st September 2017</p> <p>Saturday 2nd September 2017</p> <p>Sunday 3rd September 2017</p> <p>Monday 4th September 2017</p> <p>Tuesday 5th September 2017</p> <p>Wednesday 6th September 2017</p> <p>Thursday 7th September 2017</p> <p>Friday 8th September 2017</p> <p>Saturday 9th September 2017</p> <p>Sunday 10th September 2017</p> <p>Monday 11th September 2017</p> <p>Tuesday 12th September 2017</p> <p>Wednesday 13th September 2017</p> <p>Thursday 14th September 2017</p> <p>Friday 15th September 2017</p> <p>Saturday 16th September 2017</p> <p>Sunday 17th September 2017</p> <p>Monday 18th September 2017</p> <p>Tuesday 19th September 2017</p> <p>Wednesday 20th September 2017</p> <p>Thursday 21st September 2017</p> <p>Friday 22nd September 2017</p> <p>Saturday 23rd September 2017</p> <p>Sunday 24th September 2017</p> <p>Monday 25th September 2017</p> <p>Tuesday 26th September 2017</p> <p>Wednesday 27th September 2017</p> <p>Thursday 28th September 2017</p> <p>Friday 29th September 2017</p> <p>Saturday 30th September 2017</p> <p>Sunday 1st October 2017</p> <p>Monday 2nd October 2017</p> <p>Tuesday 3rd October 2017</p> <p>Wednesday 4th October 2017</p> <p>Thursday 5th October 2017</p> <p>Friday 6th October 2017</p> <p>Saturday 7th October 2017</p> <p>Sunday 8th October 2017</p> <p>Monday 9th October 2017</p> <p>Tuesday 10th October 2017</p> <p>Wednesday 11th October 2017</p> <p>Thursday 12th October 2017</p> <p>Friday 13th October 2017</p> <p>Saturday 14th October 2017</p> <p>Sunday 15th October 2017</p> <p>Monday 16th October 2017</p> <p>Tuesday 17th October 2017</p> <p>Wednesday 18th October 2017</p> <p>Thursday 19th October 2017</p> <p>Friday 20th October 2017</p> <p>Saturday 21st October 2017</p> <p>Sunday 22nd October 2017</p> <p>Monday 23rd October 2017</p> <p>Tuesday 24th October 2017</p> <p>Wednesday 25th October 2017</p> <p>Thursday 26th October 2017</p> <p>Friday 27th October 2017</p> <p>Saturday 28th October 2017</p> <p>Sunday 29th October 2017</p> <p>Monday 30th October 2017</p> <p>Tuesday 31st October 2017</p> <p>Wednesday 1st November 2017</p> <p>Thursday 2nd November 2017</p> <p>Friday 3rd November 2017</p> <p>Saturday 4th November 2017</p> <p>Sunday 5th November 2017</p> <p>Monday 6th November 2017</p> <p>Tuesday 7th November 2017</p> <p>Wednesday 8th November 2017</p> <p>Thursday 9th November 2017</p> <p>Friday 10th November 2017</p> <p>Saturday 11th November 2017</p> <p>Sunday 12th November 2017</p> <p>Monday 13th November 2017</p> <p>Tuesday 14th November 2017</p> <p>Wednesday 15th November 2017</p> <p>Thursday 16th November 2017</p> <p>Friday 17th November 2017</p> <p>Saturday 18th November 2017</p> <p>Sunday 19th November 2017</p> <p>Monday 20th November 2017</p> <p>Tuesday 21st November 2017</p> <p>Wednesday 22nd November 2017</p> <p>Thursday 23rd November 2017</p> <p>Friday 24th November 2017</p> <p>Saturday 25th November 2017</p> <p>Sunday 26th November 2017</p> <p>Monday 27th November 2017</p> <p>Tuesday 28th November 2017</p> <p>Wednesday 29th November 2017</p> <p>Thursday 30th November 2017</p> <p>Friday 1st December 2017</p> <p>Saturday 2nd December 2017</p> <p>Sunday 3rd December 2017</p> <p>Monday 4th December 2017</p> <p>Tuesday 5th December 2017</p> <p>Wednesday 6th December 2017</p> <p>Thursday 7th December 2017</p> <p>Friday 8th December 2017</p> <p>Saturday 9th December 2017</p> <p>Sunday 10th December 2017</p> <p>Monday 11th December 2017</p> <p>Tuesday 12th December 2017</p> <p>Wednesday 13th December 2017</p> <p>Thursday 14th December 2017</p> <p>Friday 15th December 2017</p> <p>Saturday 16th December 2017</p> <p>Sunday 17th December 2017</p> <p>Monday 18th December 2017</p> <p>Tuesday 19th December 2017</p> <p>Wednesday 20th December 2017</p> <p>Thursday 21st December 2017</p> <p>Friday 22nd December 2017</p> <p>Saturday 23rd December 2017</p> <p>Sunday 24th December 2017</p> <p>Monday 25th December 2017</p> <p>Tuesday 26th December 2017</p> <p>Wednesday 27th December 2017</p> <p>Thursday 28th December 2017</p> <p>Friday 29th December 2017</p> <p>Saturday 30th December 2017</p> <p>Sunday 31st December 2017</p>	
--	--	---	--

Local Authority:	LCC
Horizontal Meridian:	MGA
Vertical Level Datum:	AHD D
Level Origin:	PM107142(RL39.078)
Scale:	1:500 @ A1
Surveyed:	JM
Designed:	BRADLEES
Drawn:	EJM
Checked:	EJM
Plot Date:	14 Mar, 2017
File Ref:	
30/06/11029 ASW01(B) FFSB.dwg	

AS-CONSTRUCTED STORMWATER

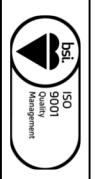

OSBANE PROSERPINE
09060 4700 (07) 9445 1722
OCKAY CAIRNS
0451 2011 (07) 4051 6722
verts.com.au

ACN 604 671 374
Overland Surveying Pty Ltd t/a Vertis

Drawing No	Issue
30109-11039-ASW01	B

