



Consulting Engineer's Certification.

I, hereby certify that the As Constructed information shown on this plan is a true and correct record of the sizes, types, materials, classes etc., and it corresponds with the relevant approved Engineering Drawings.

Signed..... RPEQ No Dated.....

Registered Surveyor's Certification.

We, Queensland Surveying Pty Ltd, hereby certify that the horizontal and vertical locations, and dimensions shown on this plan are a true and correct record of the As Constructed information.

Cadastral Surveyor
Signed..... & Delegate, Reg. No ...6152... Dated.....

FLAGSTONE STAGE 1E
PEET FLAGSTONE CITY PTY LTD

IMPORTANT NOTES:
This Plan has been prepared for PEET FLAGSTONE CITY PTY LTD in Logan City Council's jurisdiction for the purpose of recording the As Constructed details of a new service constructed under a specific Council Approval and should not be used for any other purpose.
No report is made on any other services, nor any services that may exist before or be constructed after, the area of survey, or constructed under any other approval.
The property boundaries, easements and lot numbers shown herein may be proposed only and subject to registration by the Department of Natural Resources. All property information should be determined from the registered Survey Plans.
All dimensions should be verified and confirmed against the latest information prior to commencement by any person using this plan for building purposes.
Queensland Surveying Pty Ltd accepts no responsibility for any changes made to construction or otherwise, after the date of this plan. Any discrepancies should be clarified in writing with the relevant Authority prior to commencement of the work.
Copyright © Queensland Surveying Pty Ltd in Veris Company 12/09/2017.

THESE COPIES AND DRAWINGS ARE COPYRIGHT AND ARE NOT TO BE USED OR REPRODUCED WITHOUT THE WRITTEN PERMISSION OF VERIS

Data Sources	Customer Boundaries	30109-11059-AS101/F04 2014.dwg
As-con survey	Veris	
Engineering Design	Brad Lees	

C Update	21.07.2017	RP
B Update	18.07.2017	RP
A Original	12.06.2017	EM

 
Local Authority: LCC
Horizontal Meridian: MGA
Vertical Level Datum: AHD D
Level Origin: PM107142(RL39.078)
Scale: 1:500 @ A1
Surveyed: JM
Designed: BRAD LEES
Drawn: EJM
Checked: EJM
Plot Date: 23 Jul. 2017
Computer File Ref: 30109-11059-AS101(D) 210717.dwg

AS-CONSTRUCTED SEWER RETICULATION

veris

BRISBANE (07) 4651 4700
PROSERPINE (07) 4651 4722
MACKAY (07) 4651 2911
CAIRNS (07) 4651 4722
veris.com.au
ACN: 604 671 374
Queensland Surveying Pty Ltd in Veris

Drawing No: 30109-11059-AS01 Issue: D





Consulting Engineer's Certification.
 I, hereby certify that the As Constructed information shown on this plan is a true and correct record of the sizes, types, materials, classes etc., and it corresponds with the relevant approved Engineering Drawings.
 Signed..... RPEQ No Dated.....

Registered Surveyor's Certification.
 We, Queensland Surveying Pty Ltd, hereby certify that the horizontal and vertical locations, and dimensions shown on this plan are a true and correct record of the As Constructed information.
 Cadastrial Surveyor & Delegate. Reg. No. 6152. Dated. 21/06/2017
 Signed.....





Consulting Engineer's Certification.

I, hereby certify that the As Constructed information shown on this plan is a true and correct record of the sizes, types, materials, classes etc., and it corresponds with the relevant approved Engineering Drawings.

Signed..... RPEQ No Dated.....

Registered Surveyor's Certification.

We, Queensland Surveying Pty Ltd, hereby certify that the horizontal and vertical locations, and dimensions shown on this plan are a true and correct record of the As Constructed information.

Signed.. *AS* Cadastral Surveyor & Delegate, Reg. No ...6152... Dated 28/07/2017

- LEGEND**
- Ø100 PVC-M Pipe ————
 - Ø100 DI CL Pipe ————
 - Ø100 uPVC CONDUIT ————
 - House Connection ————
 - Service Point (Indicative) x

- TABLE OF FITTINGS**
- ① Ø100 Stop Valve
 - ② Ø100 Fire Hydrant
 - ③ Ø100 x Ø100 Tee
 - ④ Ø100 End Cap

NOTES: Water mains are PVC-M PN16 aside from road crossings which are DI CL PN35.

FLAGSTONE STAGE 1E
 For
PEET FLAGSTONE CITY PTY LTD

IMPORTANT NOTES:
 This Plan has been prepared for PEET FLAGSTONE CITY PTY LTD to Logan City Council for the purpose of recording the As Constructed details of the water reticulation under a Specific Council Approval and should not be used for any other purpose.
 No report is made on any other services, nor any services that may exist before or be constructed after, the date of survey, or constructed under any other approval.
 The property boundaries, easements and lot numbers shown herein may be proposed only and subject to registration by the Department of Natural Resources. All property information should be determined from the registered Survey Plans.
 All boundaries should be verified and confirmed against the latest information prior to commencement by any person using this plan for building purposes.
 Queensland Surveying Pty Ltd accepts no responsibility for any changes made to construction or otherwise, after the date of this plan. Any alterations should be identified by the relevant Authority prior to commencement of the work.
 Copyright © Queensland Surveying Pty Ltd 28/07/2017.

THESE DESIGNS AND DRAWINGS ARE COPYRIGHT AND ARE NOT TO BE USED OR REPRODUCED WITHOUT THE WRITTEN PERMISSION OF VERIS

Date Sources	Author	Drawn	Checked	Issue
Original Survey	2010/04/20	2010/04/20	2010/04/20	2010/04/20
As-constructed	2017/07/28	2017/07/28	2017/07/28	2017/07/28

Local Authority: LCC
 Horizontal Meridian: MGA
 Vertical Level Datum: AHD D
 Level Origin: PM107142(RL59.078)
 Scale: 1:500 @ A1
 Surveyed: JM
 Designed: BRADLEES
 Drawn: EJM
 Checked: EJM
 Plot Date: 28 Jul 2017
 Computer File Ref: 30109-11059-AW01(D)FSBA.dwg

AS-CONSTRUCTED WATER RETICULATION

veris

BRISBANE (07) 4561 4700 WHITSUNDAYS (07) 4561 4702
 MACKAY (07) 4561 2911 CAIRNS (07) 4561 6722

veris.com.au
 ACN: 604 671 374
 Queensland Surveying Pty Ltd is Veris Company

Drawing No: 30109-11059-AW01 Issue: D





Consulting Engineer's Certification.

I, hereby certify that the As Constructed information shown on this plan is a true and correct record of the sizes, types, materials, classes etc., and it corresponds with the relevant approved Engineering Drawings.

Signed..... RPEQ No Dated.....

Registered Surveyor's Certification.

We, Queensland Surveying Pty Ltd, hereby certify that the horizontal and vertical locations, and dimensions shown on this plan are a true and correct record of the As Constructed information.

Signed.. *AJ. Aythya* Cadastral Surveyor & Delegate Reg. No 6152 Dated 28/07/2017

FLAGSTONE STAGE 1E
 For
PEET FLAGSTONE CITY PTY LTD

IMPORTANT NOTES:
 This Plan has been prepared for PEET FLAGSTONE CITY PTY LTD by Logan City Council for the purpose of recording the As Constructed details of the water constructed under a specific Council Approval and should not be used for any other purpose.
 No report is made on any other services, nor any services that may exist before or be constructed after, the date of survey, or constructed under any other approval.
 The property boundaries, easements and lot numbers shown herein may be proposed only and subject to registration by the Department of Natural Resources. All property information should be determined from the registered Survey Plans.
 All boundaries should be verified and confirmed against the latest information prior to commencement by any person using this plan for building purposes.
 Queensland Surveying Pty Ltd accepts no responsibility for any changes made to construction or otherwise, after the date of this plan. Any alterations should be notified by writing to the relevant Authority prior to commencement of the work.
 Copyright © Queensland Surveying Pty Ltd a Veris Company 03/07/2017.

THESE DRAWINGS AND DRAWINGS ARE COPYRIGHT AND ARE NOT TO BE USED OR REPRODUCED WITHOUT THE WRITTEN PERMISSION OF VERIS

Date	Source	Author	Checked	Drawn
2017/07/28	As-on survey	Veris	Brad Lees	Brad Lees
2017/07/28	Original	Veris	Brad Lees	Brad Lees
2017/07/28	Original	Veris	Brad Lees	Brad Lees

Local Authority: LCC
 Horizontal Meridian: MGA
 Vertical Level Datum: AHD D
 Level Origin: PM107142(RL9.078)
 Scale: 1:500 @ A1
 Surveyed: JMRP
 Checked: BRAD LEES
 Drawn: EJMRRP
 Checked: EJM
 Plot Date: 28 Jul 2017
 Computer File Ref: 30109-11059-ARW01D.FSB4.dwg

AS-CONSTRUCTED ROOFWATER

veris

BRISBANE WHITSUNDAYS
 (07) 4561 4700 (07) 4561 4722
 MACKAY CAIRNS
 (07) 4561 2911 (07) 4561 6722

veris.com.au
 ACN: 604 671 374
 Queensland Surveying Pty Ltd a Veris Company

Drawing No: 30109-11059-ARW01 D Issue

