

Consulting Engineer's Certification.

I, hereby certify that the As Constructed information shown on this plan is a true and correct record of the sizes, types, materials, classes etc., and it corresponds with the relevant approved Engineering Drawings.

Signed..... RPEQ No Dated.....

Registered Surveyor's Certification.

We,VERIS AUSTRALIA PTY LTD..... hereby certify that the horizontal and vertical locations, and dimensions shown on this plan are a true and correct record of the As Constructed information.

Signed.. *Ag. April* .. Cadastral Surveyor & Delegate. Reg. No ...6448.... Dated 09/08/2018

FLAGSTONE STAGE 1W

PEET FLAGSTONE CITY PTY LTD

IMPORTANT NOTES:

This Plan has been prepared for PEET FLAGSTONE CITY PTY LTD to Logan City Council standards for the purpose of recording the As Constructed details of a new service constructed under a specific Council Approval and should not be used for any other purposes.

No report is made on any other services, nor any services that may exist before or be constructed after, the time of survey, or constructed under any other approval.

The property boundaries, easements and lot numbers shown herein may be proposed only and subject to registration by the Department of Natural Resources. All property information should be determined from the registered Survey Plans.

All dimensions should be verified and confirmed against the latest information prior to commencement by any person using this plan for building purposes.

Queensland Surveying Pty Ltd accepts no responsibility for any changes made to construction or otherwise, after the date of this plan. Any discrepancies should be clarified in writing with the relevant Authority prior to commencement of the work.

Copyright © Queensland Surveying Pty Ltd a Veris company 25032018.

THESE DRAWINGS AND DRAWINGS ARE COPYRIGHT AND ARE NOT TO BE REPRODUCED OR REPRODUCED WITHOUT THE WRITTEN PERMISSION OF VERIS

Data Sources			
Cadastral Boundaries	30109-11239-AS01	Veris	Business Mastercard
As-con survey	Veris		
Engineering Design	Veris		

Rev	Progress File	Date	Drawn
H	Progress File	08.08.2018	J.M
G	Progress File	08.08.2018	J.M
F	Progress File	08.07.2018	J.M
E	Progress File	07.07.2018	J.M
D	Progress File	27.06.2018	J.M
C	Progress File	08.06.2018	J.M
B	Progress File	26.05.2018	J.M
A	Progress File	24.05.2018	J.M

Issue: Revisions

Local Authority: LCC

Horizontal Meridian: MGA

Vertical Level Datum: AHD D

Level Origin: PM107142(RL39.078)

Scale: 1:500 @ A1

Surveyed: DW

Designed: BRADLEES

Drawn: JMc

Checked: JMc

Plot Date: 09 Aug 2018

Computer File Ref: 30109-11239-AS01(H) F594.dwg

AS-CONSTRUCTED SEWER RETICULATION

BRISBANE 071 366 4700

WHITSUNDAYS 071 494 1722

MACKAY 071 4551 2911

CAIRNS 071 4051 6722


veris.com.au

ACN 604 671 374

Queensland Surveying Pty Ltd a Veris Company

Drawing No 30109-11239-AS01

Issue H

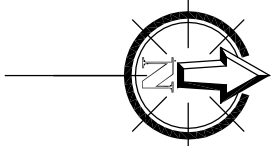

FUTURE
STAGE 1X

Consulting Engineer's Certification.
I, hereby certify that the As Constructed information shown on this plan is a true and correct record of the sizes, types, materials, classes etc., and it corresponds with the relevant approved Engineering Drawings.
Signed..... RPEQ No Dated

Registered Surveyor's Certification.
We, Veris Australia Pty Ltd hereby certify that the horizontal and vertical locations, and dimensions shown on this plan are a true and correct record of the As Constructed information.

Signed.....
Cadastral Surveyor
& Delegate, Reg. No. 6448 Dated: 9/08/2018.

LEGEND
Ø100 PVC-M Pipe
Ø100 DIOL Pipe
Ø100 uPVC CONDUIT
House Connection
Service Point(Indicative)

1 Ø100 Stop Valve
2 Ø100 Fire Hydrant
3 Ø100 x Ø100 Tee
4 Ø100 Dead End Cap
5 Ø100 11.25° Bend
6 Ø100 22.5° Bend
7 Ø100 45° Bend

TABLE OF FITTINGS
1 Ø100 Stop Valve
2 Ø100 Fire Hydrant
3 Ø100 x Ø100 Tee
4 Ø100 Dead End Cap
5 Ø100 11.25° Bend
6 Ø100 22.5° Bend
7 Ø100 45° Bend


NOTES: Water mains are PVC-M PN16
DIOL PN16.
All crossings are shown as crossings which are

FLAGSTONE
STAGE 1W
PEET FLAGSTONE
CITY PTY LTD

This plan has been prepared by PEET FLAGSTONE CITY PTY LTD for the purpose of showing the location and dimensions of the proposed water mains and fittings. It is not to be used for any other purpose. It is not to be used for any other purpose. It is not to be used for any other purpose.	
Project Name	FLAGSTONE STAGE 1W
Project No	1500 @ A1
Project Date	15/08/2018
Project No	1500 @ A1
Project Date	15/08/2018

This plan has been prepared by PEET FLAGSTONE CITY PTY LTD for the purpose of showing the location and dimensions of the proposed water mains and fittings. It is not to be used for any other purpose. It is not to be used for any other purpose. It is not to be used for any other purpose.	
Project Name	FLAGSTONE STAGE 1W
Project No	1500 @ A1
Project Date	15/08/2018
Project No	1500 @ A1
Project Date	15/08/2018

AS-CONSTRUCTED
WATER
RETICULATION

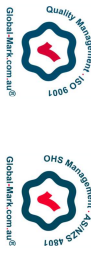


veris


BRISBANE WILTSUNDAYS

MACKAY

CAIRNS

30109-11239-AW01 F

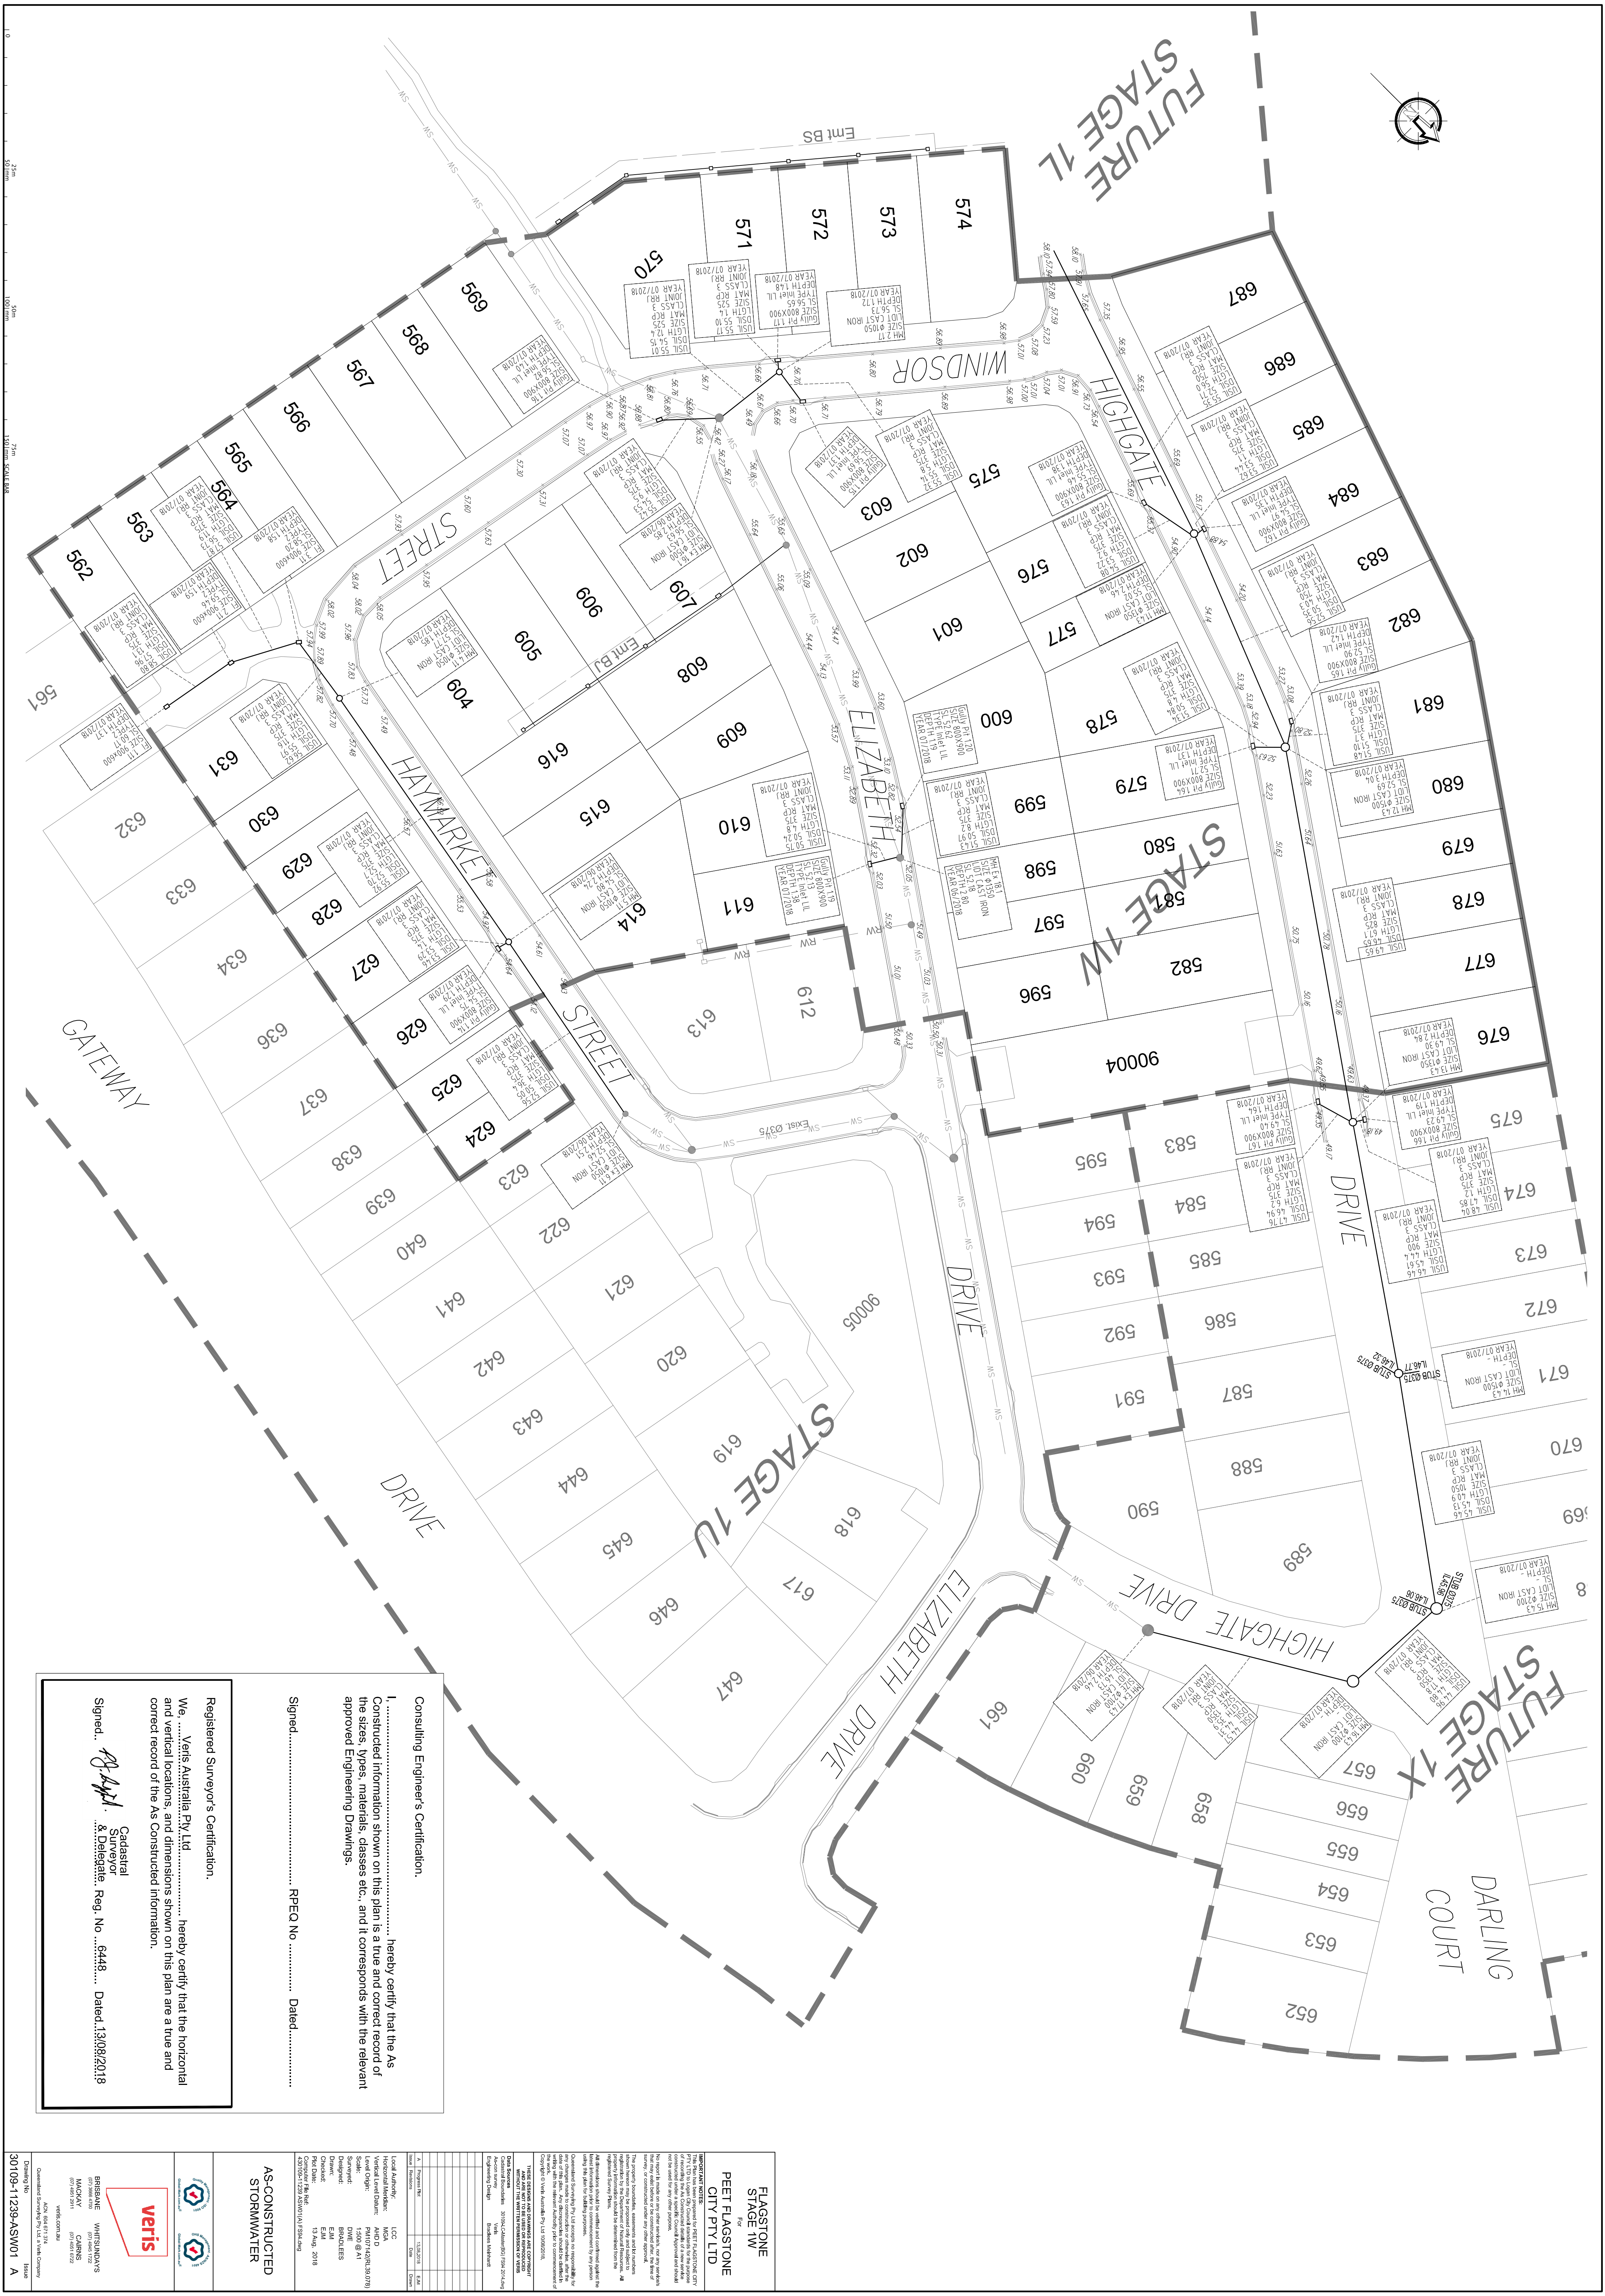

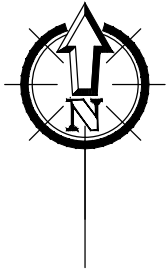

Consulting Engineer's Certification.

I, hereby certify that the As Constructed information shown on this plan is a true and correct record of the sizes, types, materials, classes etc., and it corresponds with the relevant approved Engineering Drawings.

Signed..... RPEQ No Dated.....

Registered Surveyor's Certification.

We, Veris Australia Pty Ltd hereby certify that the horizontal and vertical locations, and dimensions shown on this plan are a true and correct record of the As Constructed information.

Signed.....*R. J. Ayl*..... Cadastral Surveyor & Delegate. Reg. No ...6448..... Dated 10/08/2018

FLAGSTONE
STAGE 1W
For
PEET FLAGSTONE
CITY PTY LTD

IMPORTANT NOTES:

This Plan has been prepared for PEET FLAGSTONE CITY PTY LTD by Logan City Council pursuant to the purpose of recording the As Constructed details of a new service constructed under a specific Council Approval and should not be used for any other purpose.

No report is made on any other services, nor any services that may exist before or be constructed after, the time of survey, or constructed under any other approval.

The property boundaries, easements and lot numbers shown herein may be proposed only and subject to registration by the Department of Natural Resources. All property information should be determined from the registered Survey Plans.

All dimensions should be verified and confirmed against the latest information prior to commencement by any person using this plan for building purposes.

Queensland Surveying Pty Ltd accepts no responsibility for any changes made to construction or otherwise, after the date of this plan. Any discrepancies should be clarified in writing with the relevant Authority prior to commencement of the work.

Copyright © Veris Australia Pty Ltd 05/06/2018.

THESE DESIGNS AND DRAWINGS ARE COPYRIGHT AND ARE NOT TO BE USED OR REPRODUCED WITHOUT THE WRITTEN PERMISSION OF VERIS

Data Sources

Cadastral Boundaries	30109-LC-Master(WV)FSM 2014.dwg
As-con survey	Veris
Engineering Design	Bradley Menhardt

Issue	Revision	Date	Drawn
C	Progress Plot	10.08.2018	EJM
R	Progress Plot	02.07.2018	JAL
A	Progress Plot	05.06.2018	JAL

Local Authority: LCC
Horizontal Meridian: MGA
Vertical Level Datum: AHD D
Level Origin: PM107142(RL39.078)
Scale: 1:500 @ A1
Surveyed: DWE
Designed: BRADLEES
Drawn: JMC
Checked: JMC
Plot Date: 10 Aug. 2018
Computer File Ref: 30109-11239-ARW01(C) FS04.dwg

AS-CONSTRUCTED
ROOFWATER



BRISBANE
(07) 3666 4700

WHITSUNDAYS
(07) 4665 1722

MACKAY
(07) 4651 2011

CAIRNS
(07) 4051 8722

veris.com.au

ACN 604 871 374
Queensland Surveying Pty Ltd, a Veris Company

Drawing No 30109-11239-ARW01 C Issue