


STAGE 11

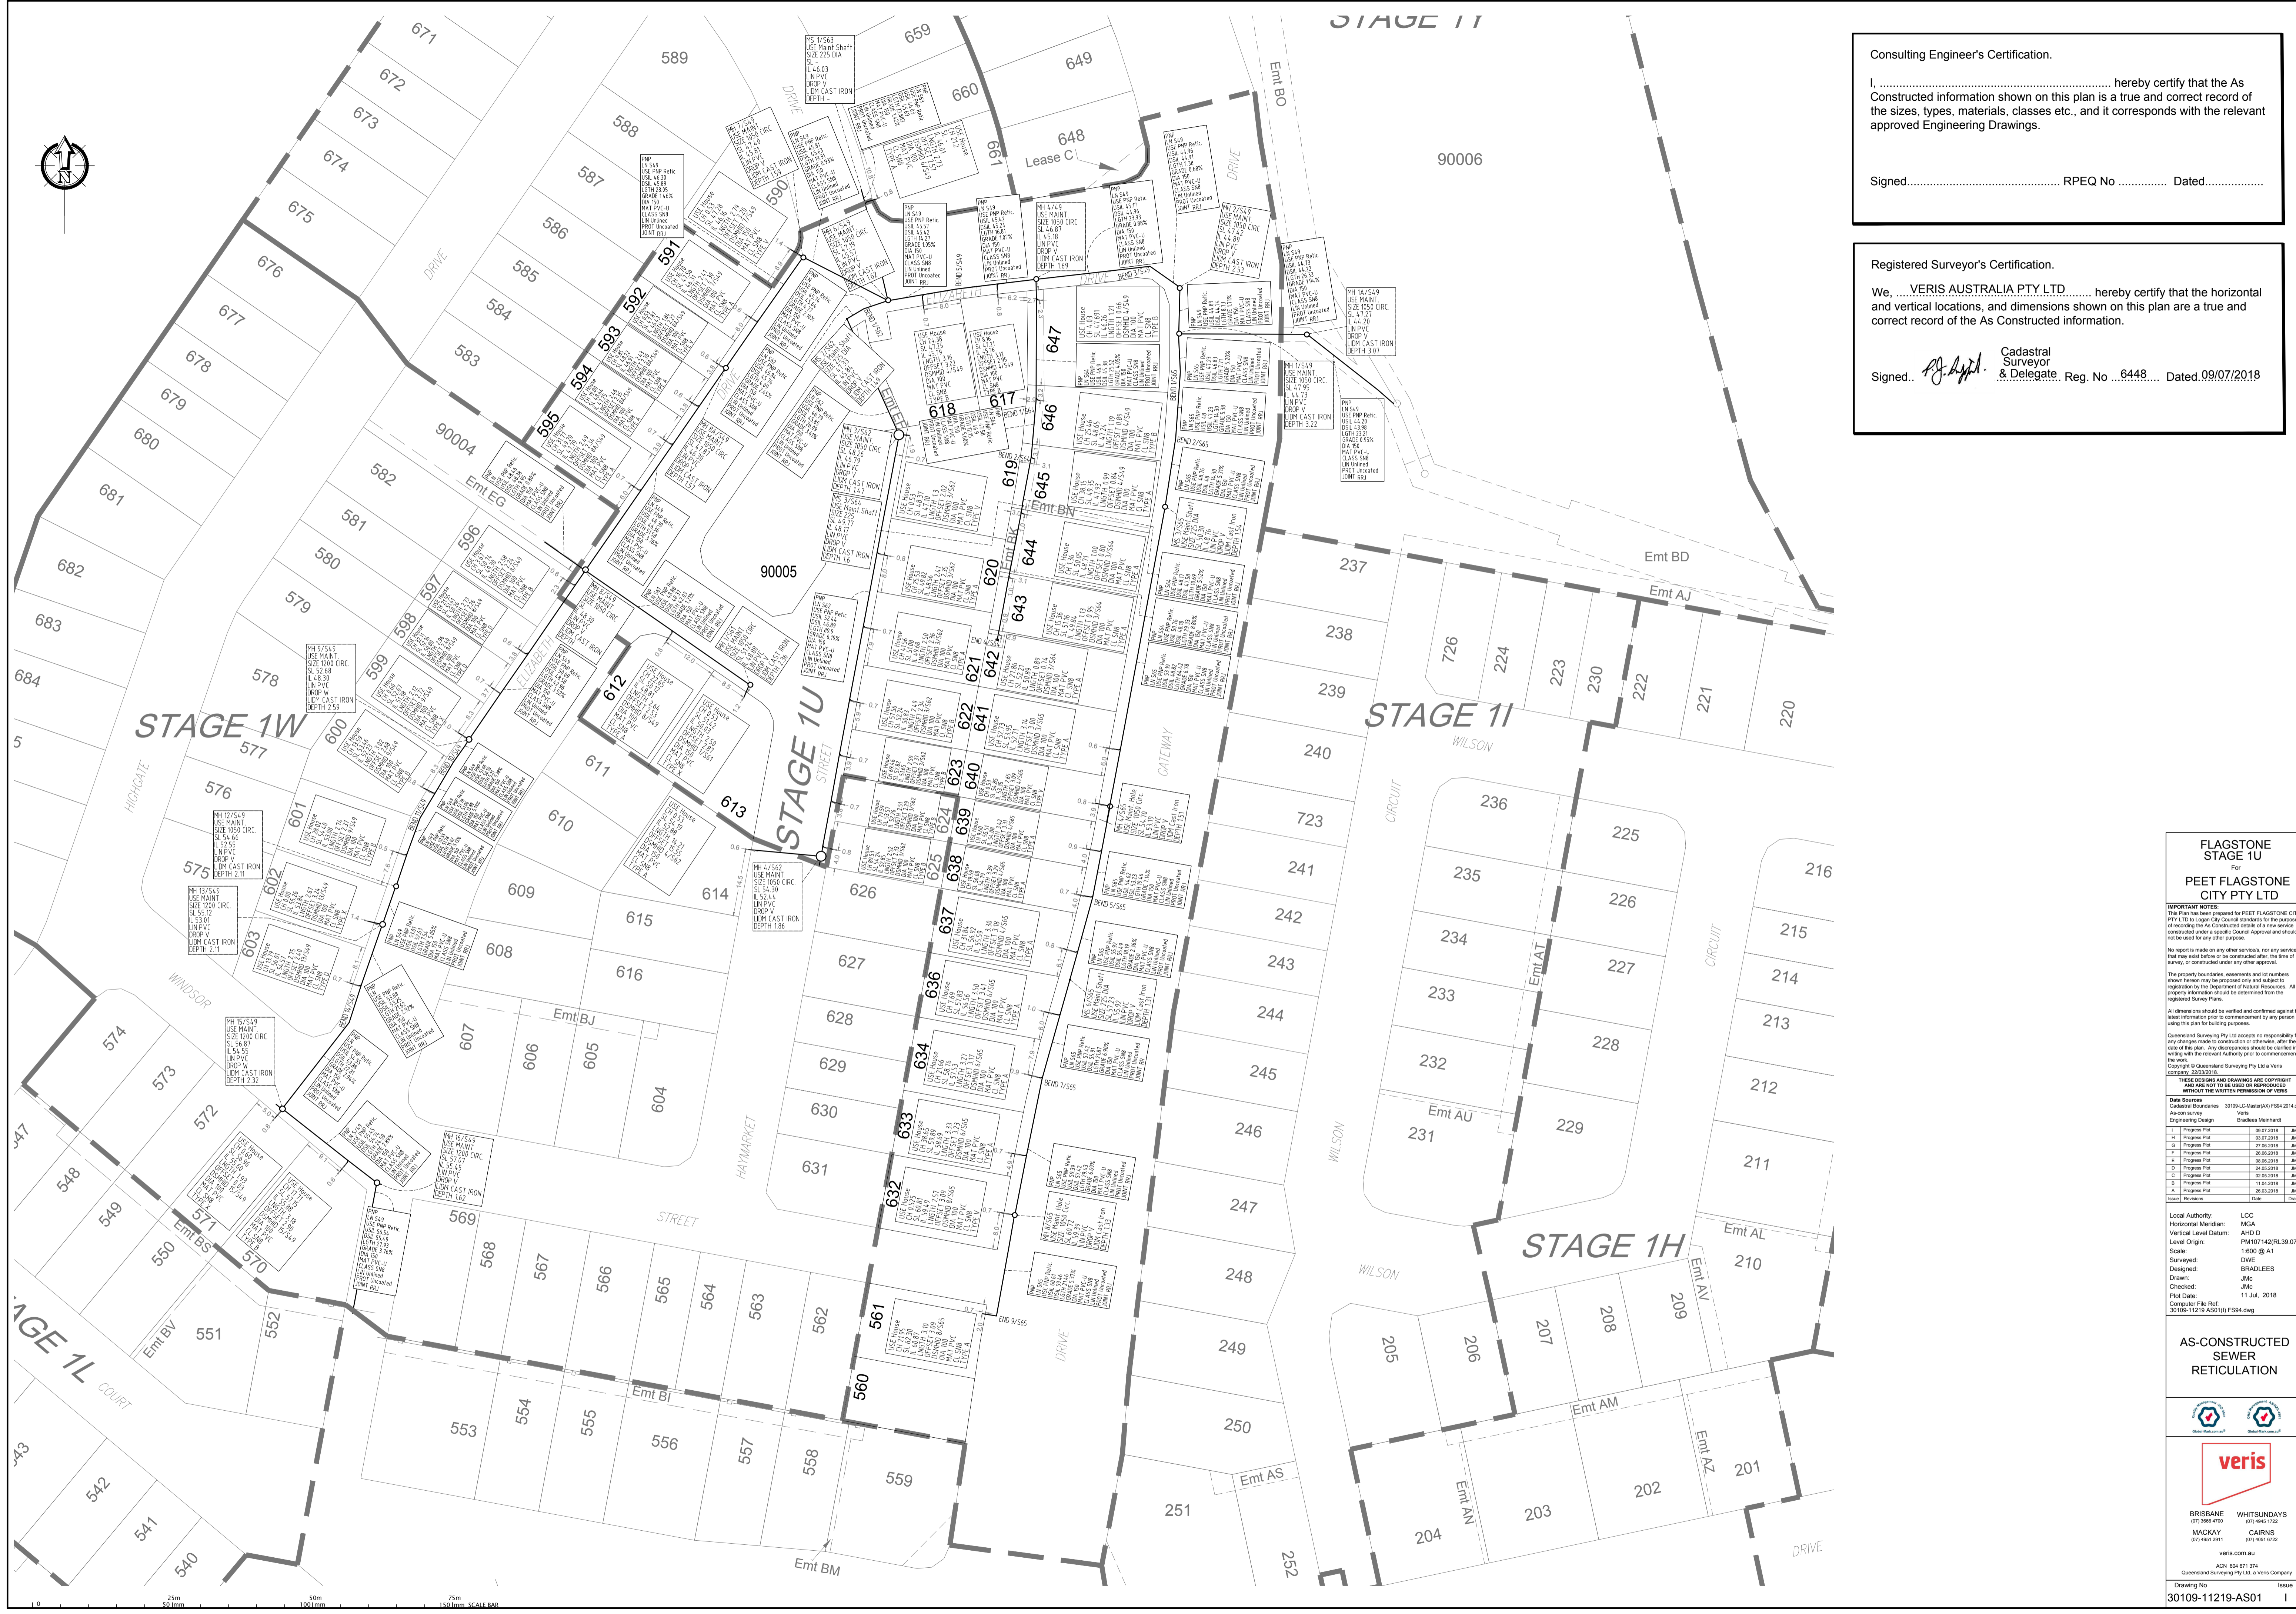

Consulting Engineer's Certification.

I, hereby certify that the As Constructed information shown on this plan is a true and correct record of the sizes, types, materials, classes etc., and it corresponds with the relevant approved Engineering Drawings.

Signed..... RPEQ No Dated.....

Registered Surveyor's Certification.

We, VERIS AUSTRALIA PTY LTD hereby certify that the horizontal and vertical locations, and dimensions shown on this plan are a true and correct record of the As Constructed information.

Signed.. *[Signature]* Cadastral Surveyor & Delegate Reg. No. 6448 Dated. 09/07/2018

FLAGSTONE STAGE 1U
For
PEET FLAGSTONE CITY PTY LTD

IMPORTANT NOTES:
This Plan has been prepared for PEET FLAGSTONE CITY PTY LTD in accordance with the requirements of the Survey Act 1981 and the Survey Regulation 2001. It is a true and correct record of the As Constructed information shown on this plan. Any discrepancies should be clarified by writing with the relevant Authority prior to commencement of the work.
No report is made on any other services, nor any services that may exist before or be constructed after the time of survey, or constructed under any other approval.
The property boundaries, easements and lot numbers shown herein may be proposed only and subject to registration by the Department of Natural Resources. All property information should be determined from the registered Survey Plans.
All dimensions should be verified and confirmed against the field information prior to commencement by any person using this plan for building purposes.
Quantum Surveying Pty Ltd accepts no responsibility for any changes made to construction or otherwise, after the date of this plan. Any discrepancies should be clarified by writing with the relevant Authority prior to commencement of the work.
Copyright © Quantum Surveying Pty Ltd a Veris Company 2018/2019

These Designs and Drawings are Copyright and are not to be used or reproduced without the written permission of Veris

Program Plot	Date	Author
A	09.07.2018	JAL
H	09.07.2018	JAL
G	27.06.2018	JAL
F	26.06.2018	JAL
E	18.06.2018	JAL
D	24.05.2018	JAL
C	02.05.2018	JAL
B	11.04.2018	JAL
A	26.03.2018	JAL

Local Authority: LCC
Horizontal Meridian: MGA
Vertical Level Datum: AHD D
Level Origin: PM107142(RL39.078)
Scale: 1:600 @ A1
Surveyed: DWE
Designed: BRADLEES
Drawn: JAL
Checked: JAL
Plot Date: 11 Jul. 2018
Computer File Ref: 30109-11219-AS01(1) F504.dwg

AS-CONSTRUCTED SEWER RETICULATION

BRISBANE (07) 3966 4700 WHITSUNDAYS (07) 4945 1722
MACKAY (07) 4951 2911 CAIRNS (07) 4091 6722
veris.com.au
ACN 604 071 574
Quantum Surveying Pty Ltd a Veris Company
Drawing No 30109-11219-AS01 Issue 1

