



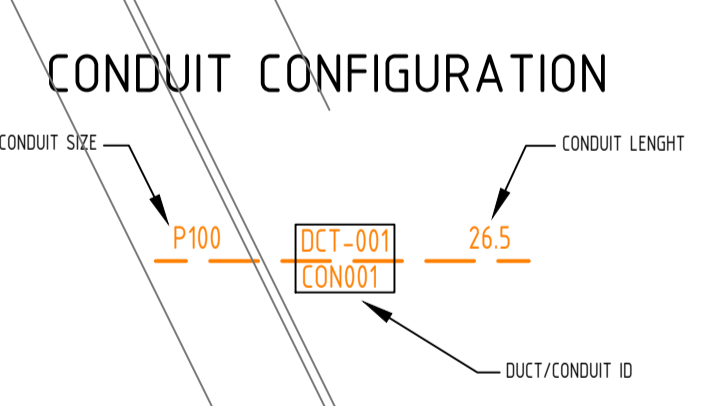

**AS CONSTRUCTED**

Development Information		
Development Name:	Developer Company:	
FLAGSTONE CITY	PEET LTD	
Development Address:		
HOMESTEAD DR, UNDULLAH		
Authorised Rep:		
PETER EUSTACE & ASSOCIATES		
Phone: 07 5596 1425		
E-Mail: mail@petereustace.com.au		
CRM ID:	Stage Number:	
AYCA-1XFXRZ	1C	
BILL OF MATERIAL		
NO OF LOTS: 46		
PITS		
SIZE	QTY	
2	0	
5	25	
8	6	
9	1	
DUCTS		
SIZE	QTY	MTRS
P100	22	706.4
P50	11	301.2
P23	46	430.5
TOTAL NUMBER OF PITS: 32		
TOTAL NUMBER OF CONDUITS: 79		
TOTAL LENGTH OF CONDUITS: 1438.1		

NBN SYMBOL LEGEND	
	Transformer / Kiosk / Pad Mount Sub-station / Pole Mount Transformer
	Fibre Distribution Hub-FDH Cabinet with Cabinet ID shown
	Network Boundary/Local Network Pit (Single Lid) (700mmX450mmX650mm)
	Distribution/Local Network Connection Pit (1360mmX555mmX860mm)
	Fibre Distribution Hub (FDH) Pit (2000mmX555mmX900mm)

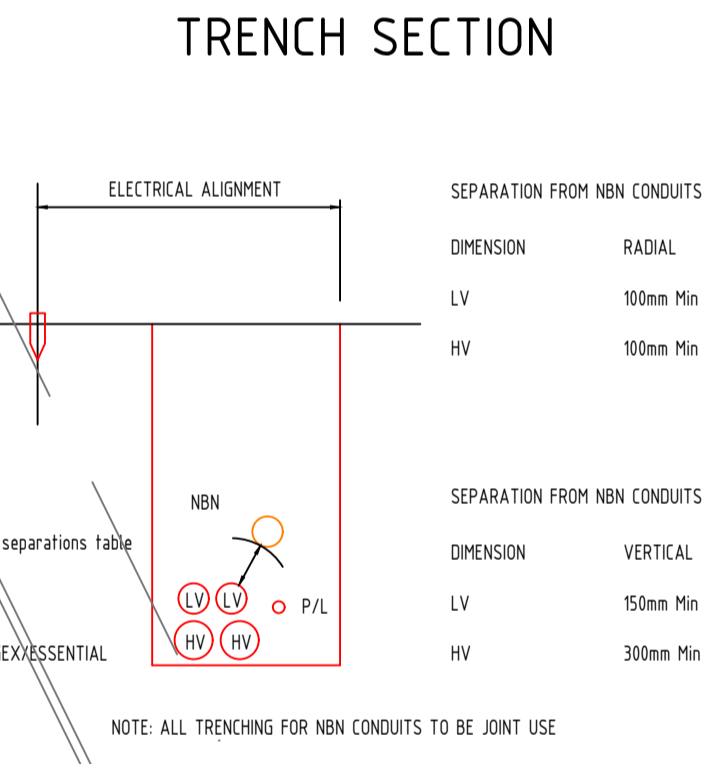

**\*\*ATTENTION\*\***  
**CONSTRUCTORS DO NOT**  
 change or alter job  
 specifications unless first  
 checking with designer.

REV	DATE	DRAFTER	DESCRIPTION	APPROVED
F	11.11.16	AP	ISSUE AS CONSTRUCTED	
E	04.11.16	AP	OFFSETS TO VARIOUS PITS ADDED.	
D	01.11.16	AP	OFFSET FOR PIT-020 ADDED.	
C	14.10.16	A.P.	ISSUE FOR CONSTRUCTION.	
B	21.06.16	A.P.	ISSUE FOR TENDER. NOT FOR CONSTRUCTION.	
A	22.04.15	A.P.	ISSUE FOR NBN APPROVAL. NOT FOR CONSTRUCTION	

**NBNCO APPROVAL RECORD:**

SIGNATURE	DATE
<input type="checkbox"/> DD	_____
<input type="checkbox"/> WD	_____
<input type="checkbox"/> AB	_____


**QUALITY RECORD :**

**NBNCO DISCLAIMER**

THIS DOCUMENT HAS BEEN PREPARED SOLELY FOR THE USE OF NBNCO LIMITED (ABN 86 136 533 741) FOR USE IN MAINTAINING NBNCO FACILITIES. IT HAS NOT BEEN CREATED FOR ANY OTHER USE. IT SHOULD NOT BE SCALED TO LOCATE NBNCO ASSETS. NO WARRANTY IS GIVEN THAT THE INFORMATION IS ACCURATE OR COMPLETE.

**Peter Eustace & Associates**  
 Consulting Engineers  
 ELECTRICAL & MECHANICAL

Gold Coast Office  
 Unit 14, 30-41 Lawrence Dr, Nerang QLD 4211  
 STREET ADDRESS  
 PO Box 712, Nerang QLD 4211  
 POSTAL ADDRESS  
 (07) 5596 1425  
 TELEPHONE  
 mail@petereustace.com.au  
 EMAIL

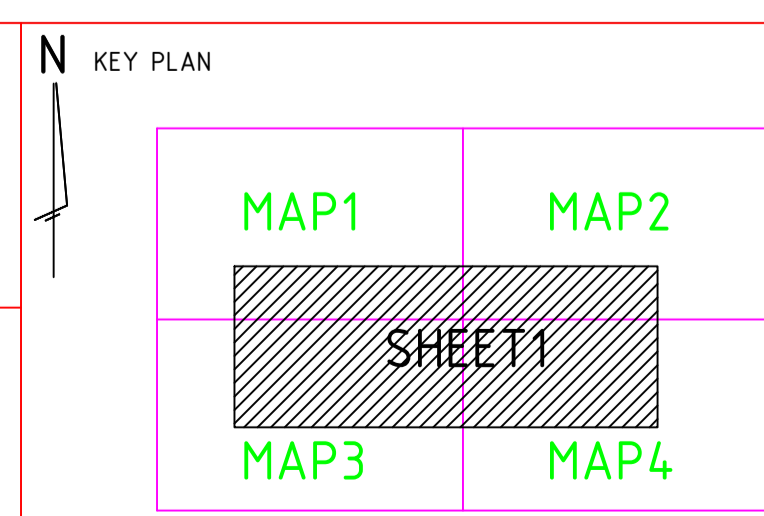

**DRAWING TITLE:**  
 PIT & PIPE LAYOUT  
 FLAGSTONE CITY  
 STAGE 1A - 46 LOT SUBDIVISION

STATE: QLD	REGION: UNDULLAH
FSA: _____	FSAM: _____
PROJECT No: AYCA-1XDH0G	FDA: _____
CADREF No: _____	
SCALE: 1:500@A1	SHEET No. 1 OF 1
	REV. F