



Consulting Engineer's Certification.

I, hereby certify that the As Constructed information shown on this plan is a true and correct record of the sizes, types, materials, classes etc., and it corresponds with the relevant approved Engineering Drawings.

Signed..... RPEQ No Dated.....

Registered Surveyor's Certification.

We, Queensland Surveying Pty Ltd..... hereby certify that the horizontal and vertical locations, and dimensions shown on this plan are a true and correct record of the As Constructed information.

Signed.. *AS-Constructed* ..
Cadastral Surveyor & Delegate. Reg. No ...6152.... Dated 30/01/2018

FLAGSTONE STAGE 1D
For
PEET FLAGSTONE CITY PTY LTD

IMPORTANT NOTES:

This Plan has been prepared for PEET FLAGSTONE CITY PTY LTD to Logan City Council standards for the purpose of recording the As Constructed details of a new service constructed under a specific Council Approval and should not be used for any other purpose.

No report is made on any other services, nor any services that may exist before or be constructed after the date of survey, or constructed under any other approval.

The property boundaries, easements and lot numbers shown herein may be proposed only and subject to registration by the Department of Natural Resources. All property information should be determined from the registered Survey Plans.

All dimensions should be verified and confirmed against the latest information prior to commencement by any person using this plan for building purposes.

Queensland Surveying Pty Ltd accepts no responsibility for any changes made to construction or otherwise, after the date of this plan. Any discrepancies should be clarified in writing with the relevant Authority prior to commencement of the work.

Copyright © Queensland Surveying Pty Ltd to Veris 2010/2017.

THESE DESIGNS AND DRAWINGS ARE COPYRIGHT AND ARE NOT TO BE USED OR REPRODUCED WITHOUT THE WRITTEN PERMISSION OF VERIS



Data Sources


Cadastral Boundaries	30109-11049-ARW01.dwg
As-con survey	Veris & PDM
Engineering Design	Bradlees Measurment

Rev	Update	30/01/2018	AS
A	Preliminary	30/10/2017	EJM
Issue	Revisions	Date	Drawn

Local Authority: LCC
Horizontal Meridian: MGA
Vertical Level Datum: AHD D
Level Origin: PM107142(RL39.078)
Scale: 1:500 @ A1
Surveyed: DE
Designed: BRADLEES
Drawn: EJM
Checked: EJM
Plot Date: 30 Jan. 2018
Computer File Ref: 20109-11049-ARW01(B) F594.dwg


AS-CONSTRUCTED ROOFWATER





BRISBANE (07) 386 4100
MACKAY (07) 4951 2911
WHITSUNDAYS (07) 464 1522
CAIRNS (07) 4001 6722
veris.com.au
ACN: 604 671 374
Queensland Surveying Pty Ltd, a Veris Company

Drawing No	Issue
30109-11049-ARW01	B

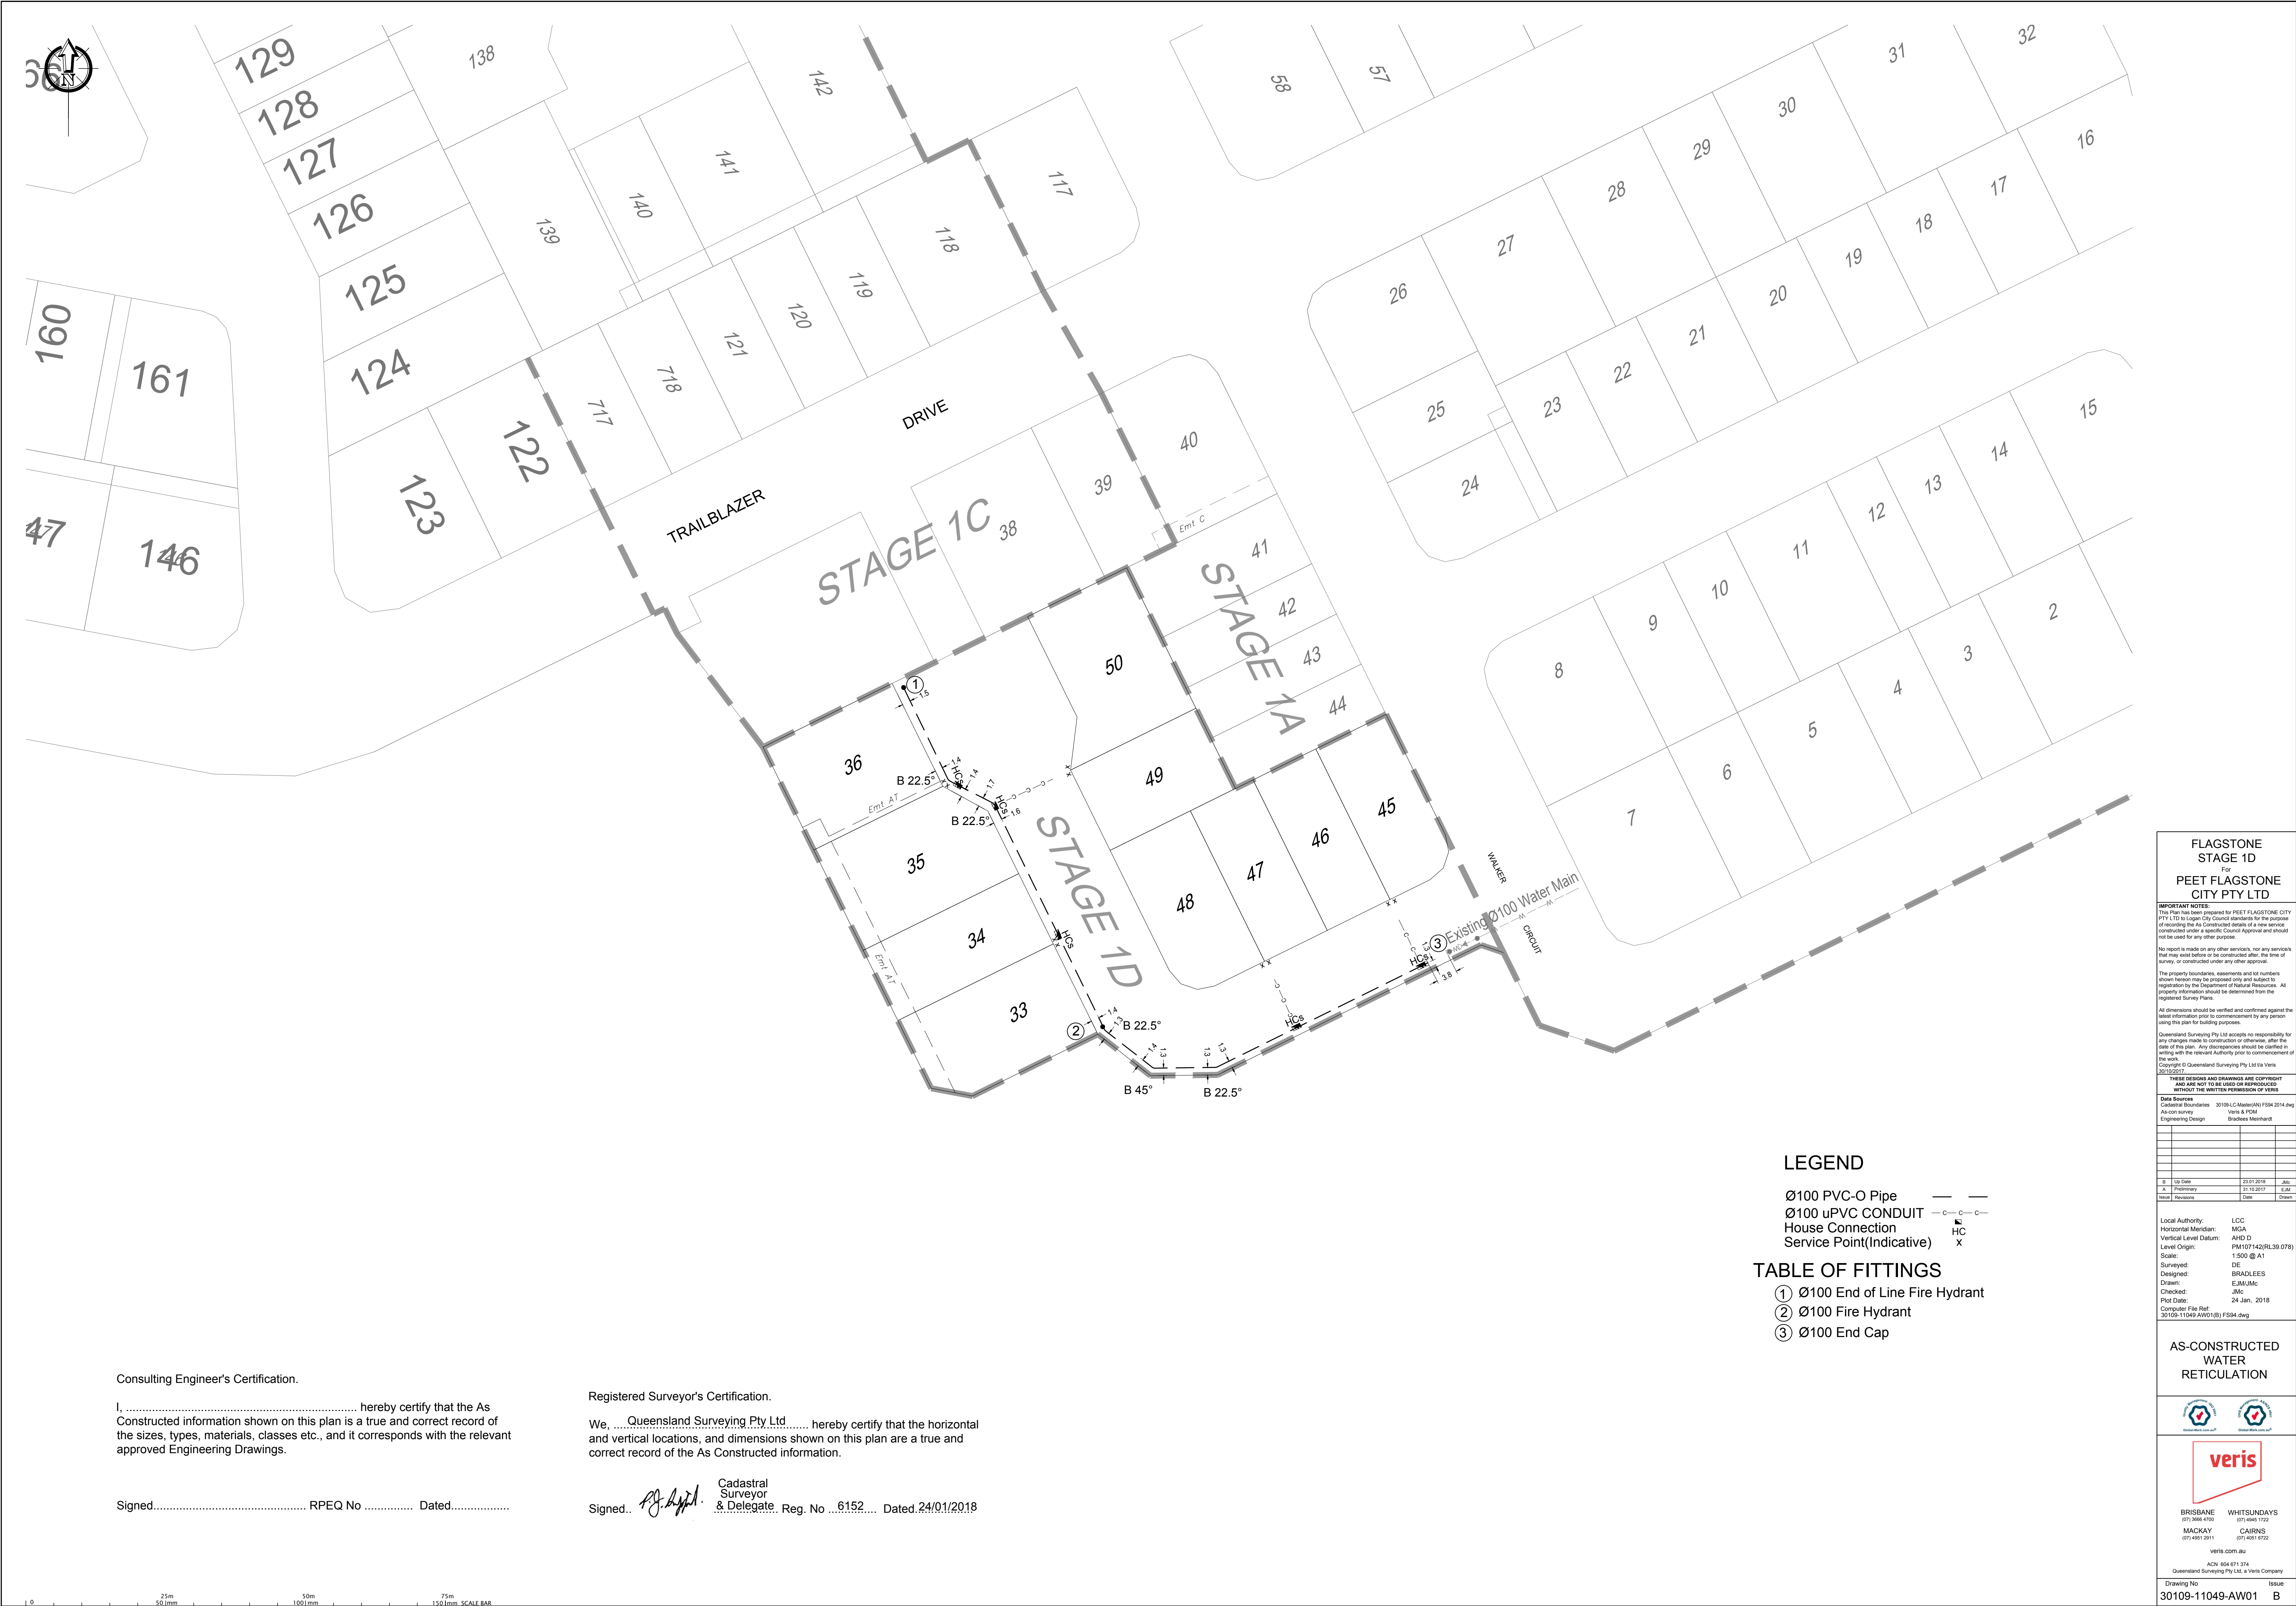

FLAGSTONE
STAGE 1D
For
PEET FLAGSTONE
CITY PTY LTD

IMPORTANT NOTES:
This Plan has been prepared for PEET FLAGSTONE CITY PTY LTD to Logan City Council standards for the purpose of recording the As Constructed details of a new service constructed under a specific Council Approval and should not be used for any other purpose.
No report is made on any other services, nor any services that may exist before or be constructed after the date of survey, or constructed under any other approval.
The property boundaries, easements and lot numbers shown herein may be proposed only and subject to registration by the Department of Natural Resources. All property information should be determined from the registered Survey Plans.
All dimensions should be verified and confirmed against the latest information prior to commencement by any person using this plan for building purposes.
Queensland Surveying Pty Ltd accepts no responsibility for any changes made to construction or otherwise, after the date of this plan. Any discrepancies should be clarified in writing with the relevant Authority prior to commencement of the work.
Copyright © Queensland Surveying Pty Ltd to Veris 2010/2017.


THESE DESIGNS AND DRAWINGS ARE COPYRIGHT AND ARE NOT TO BE USED OR REPRODUCED WITHOUT THE WRITTEN PERMISSION OF VERIS

Data Sources
Cadastral Boundaries 30109-11049-AW1 FSRM 2014.dwg
As-con survey Veris & PDM
Engineering Design Bradlees Meermans

Rev	Issue	Date	By	Drawn
0	Issue	23/01/2018	JMC	
1	Preliminary	31/10/2017	JMC	
2	Revisions			


Local Authority: LCC
Horizontal Meridian: MGA
Vertical Level Datum: AHD D
Level Origin: PM107142(RL39.078)
Scale: 1:500 @ A1
Surveyed: DE
Designed: BRADLEES
Drawn: EJM/JMC
Checked: JMC
Plot Date: 24 Jan, 2018
Computer File Ref: 20109-11049-AW01(B) FSRM.dwg

**AS-CONSTRUCTED
WATER
RETICULATION**



BRISBANE WHITSUNDAYS
(07) 386 4100 (07) 464 1522
MACKAY CAIRNS
(07) 4951 2911 (07) 4051 6722
veris.com.au
ACN 604 671 374
Queensland Surveying Pty Ltd, a Veris Company

Drawing No. 30109-11049-AW01 Issue B

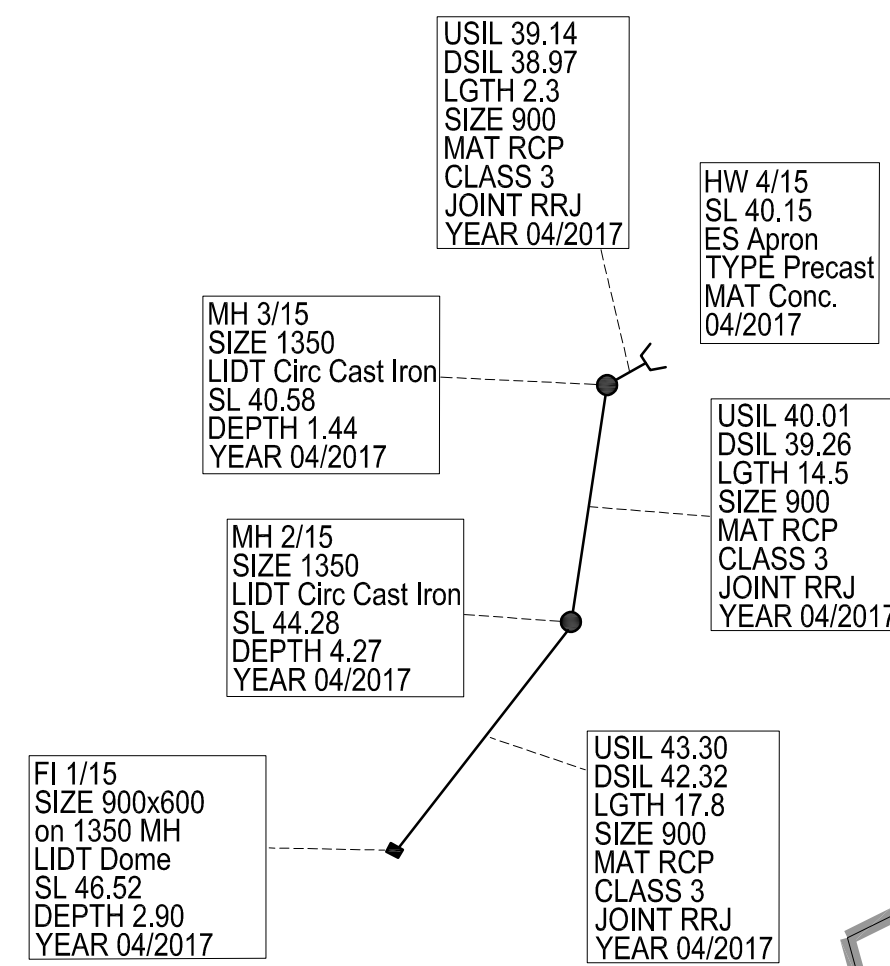

I, hereby certify that the As
Constructed information shown on this plan is a true and correct record of
the sizes, types, materials, classes etc., and it corresponds with the relevant
approved Engineering Drawings.

Registered Surveyor's Certification.

We, Queensland Surveying Pty Ltd..... hereby certify that the horizontal and vertical locations, and dimensions shown on this plan are a true and correct record of the As Constructed information.

Signed..  Cadastral
Surveyor
& Delegate Reg. No. 6152 Dated 21/06/2017

FLAGSTONE
STAGE 1C
For
PEET FLAGSTONE
CITY PTY LTD

IMPORTANT NOTES:
This Plan has been prepared for PEET FLAGSTONE PTY LTD to Logan City Council standards for the purpose of recording the As Constructed details of a new service constructed under a specific Council Approval and is not to be used for any other purpose.

No report is made on any other service/s, nor any service that may exist before or be constructed after, the time of survey, or constructed under any other approval.

No report is made on any other service's, nor any set that may exist before or be constructed after, the time survey, or constructed under any other approval.

The property boundaries, easements and lot number shown hereon may be proposed only and subject to registration by the Department of Natural Resources. Property information should be determined from the registered Survey Plans.

All dimensions should be verified and confirmed against latest information prior to commencement by any person using this plan for building purposes.

Queensland Surveying Pty Ltd accepts no responsibility for any changes made to construction or otherwise, after date of this plan. Any discrepancies should be dealt with with the relevant Authority prior to commencing the work.

Copyright © Queensland Surveying Pty Ltd 1/4 Verdes
07/03/2017.

THESE DESIGNS AND DRAWINGS ARE COPYRIGHTED AND ARE NOT TO BE USED OR REPRODUCED WITHOUT THE WRITTEN PERMISSION OF VERIS	
Data Sources Cadastral Boundaries As-on survey Engineering Design	30109-LC-Master(U) FS94 20 Veris & PDM Bradlees Melnhardt

G	Add pipes to 14C & 14D Stage 1D	21.06.2017
F	Update SL 1/15	05.06.2017
E	Update	18.05.2017
D	Update	03.05.2017
C	Update	20.04.2017
B	Update	14.03.2017
A	Preliminary	07.03.2017
Issue	Revisions	Date

Local Authority: LCC
Horizontal Meridian: MGA
Vertical Level Datum: AHD D
Level Origin: PM107142(RL3)
Scale: 1:500 @ A1
Surveyed: JM
Designed: BRADLEES
Drawn: EJM
Checked: EJM
Plot Date: 21 Jun, 2017
Computer File Ref:

AS-CONSTRUCTED
STORMWATER
SHEET 1 OF 2



BRISBANE
(07) 3986 4700

MACKAY
(07) 4951 2911


PROSERPINE
(07) 4945 1722

CAIRNS
(07) 4051 6722

ACN 604 671 374

Drawing No	Iss
30109-11039-ASW01	G

[illegible]

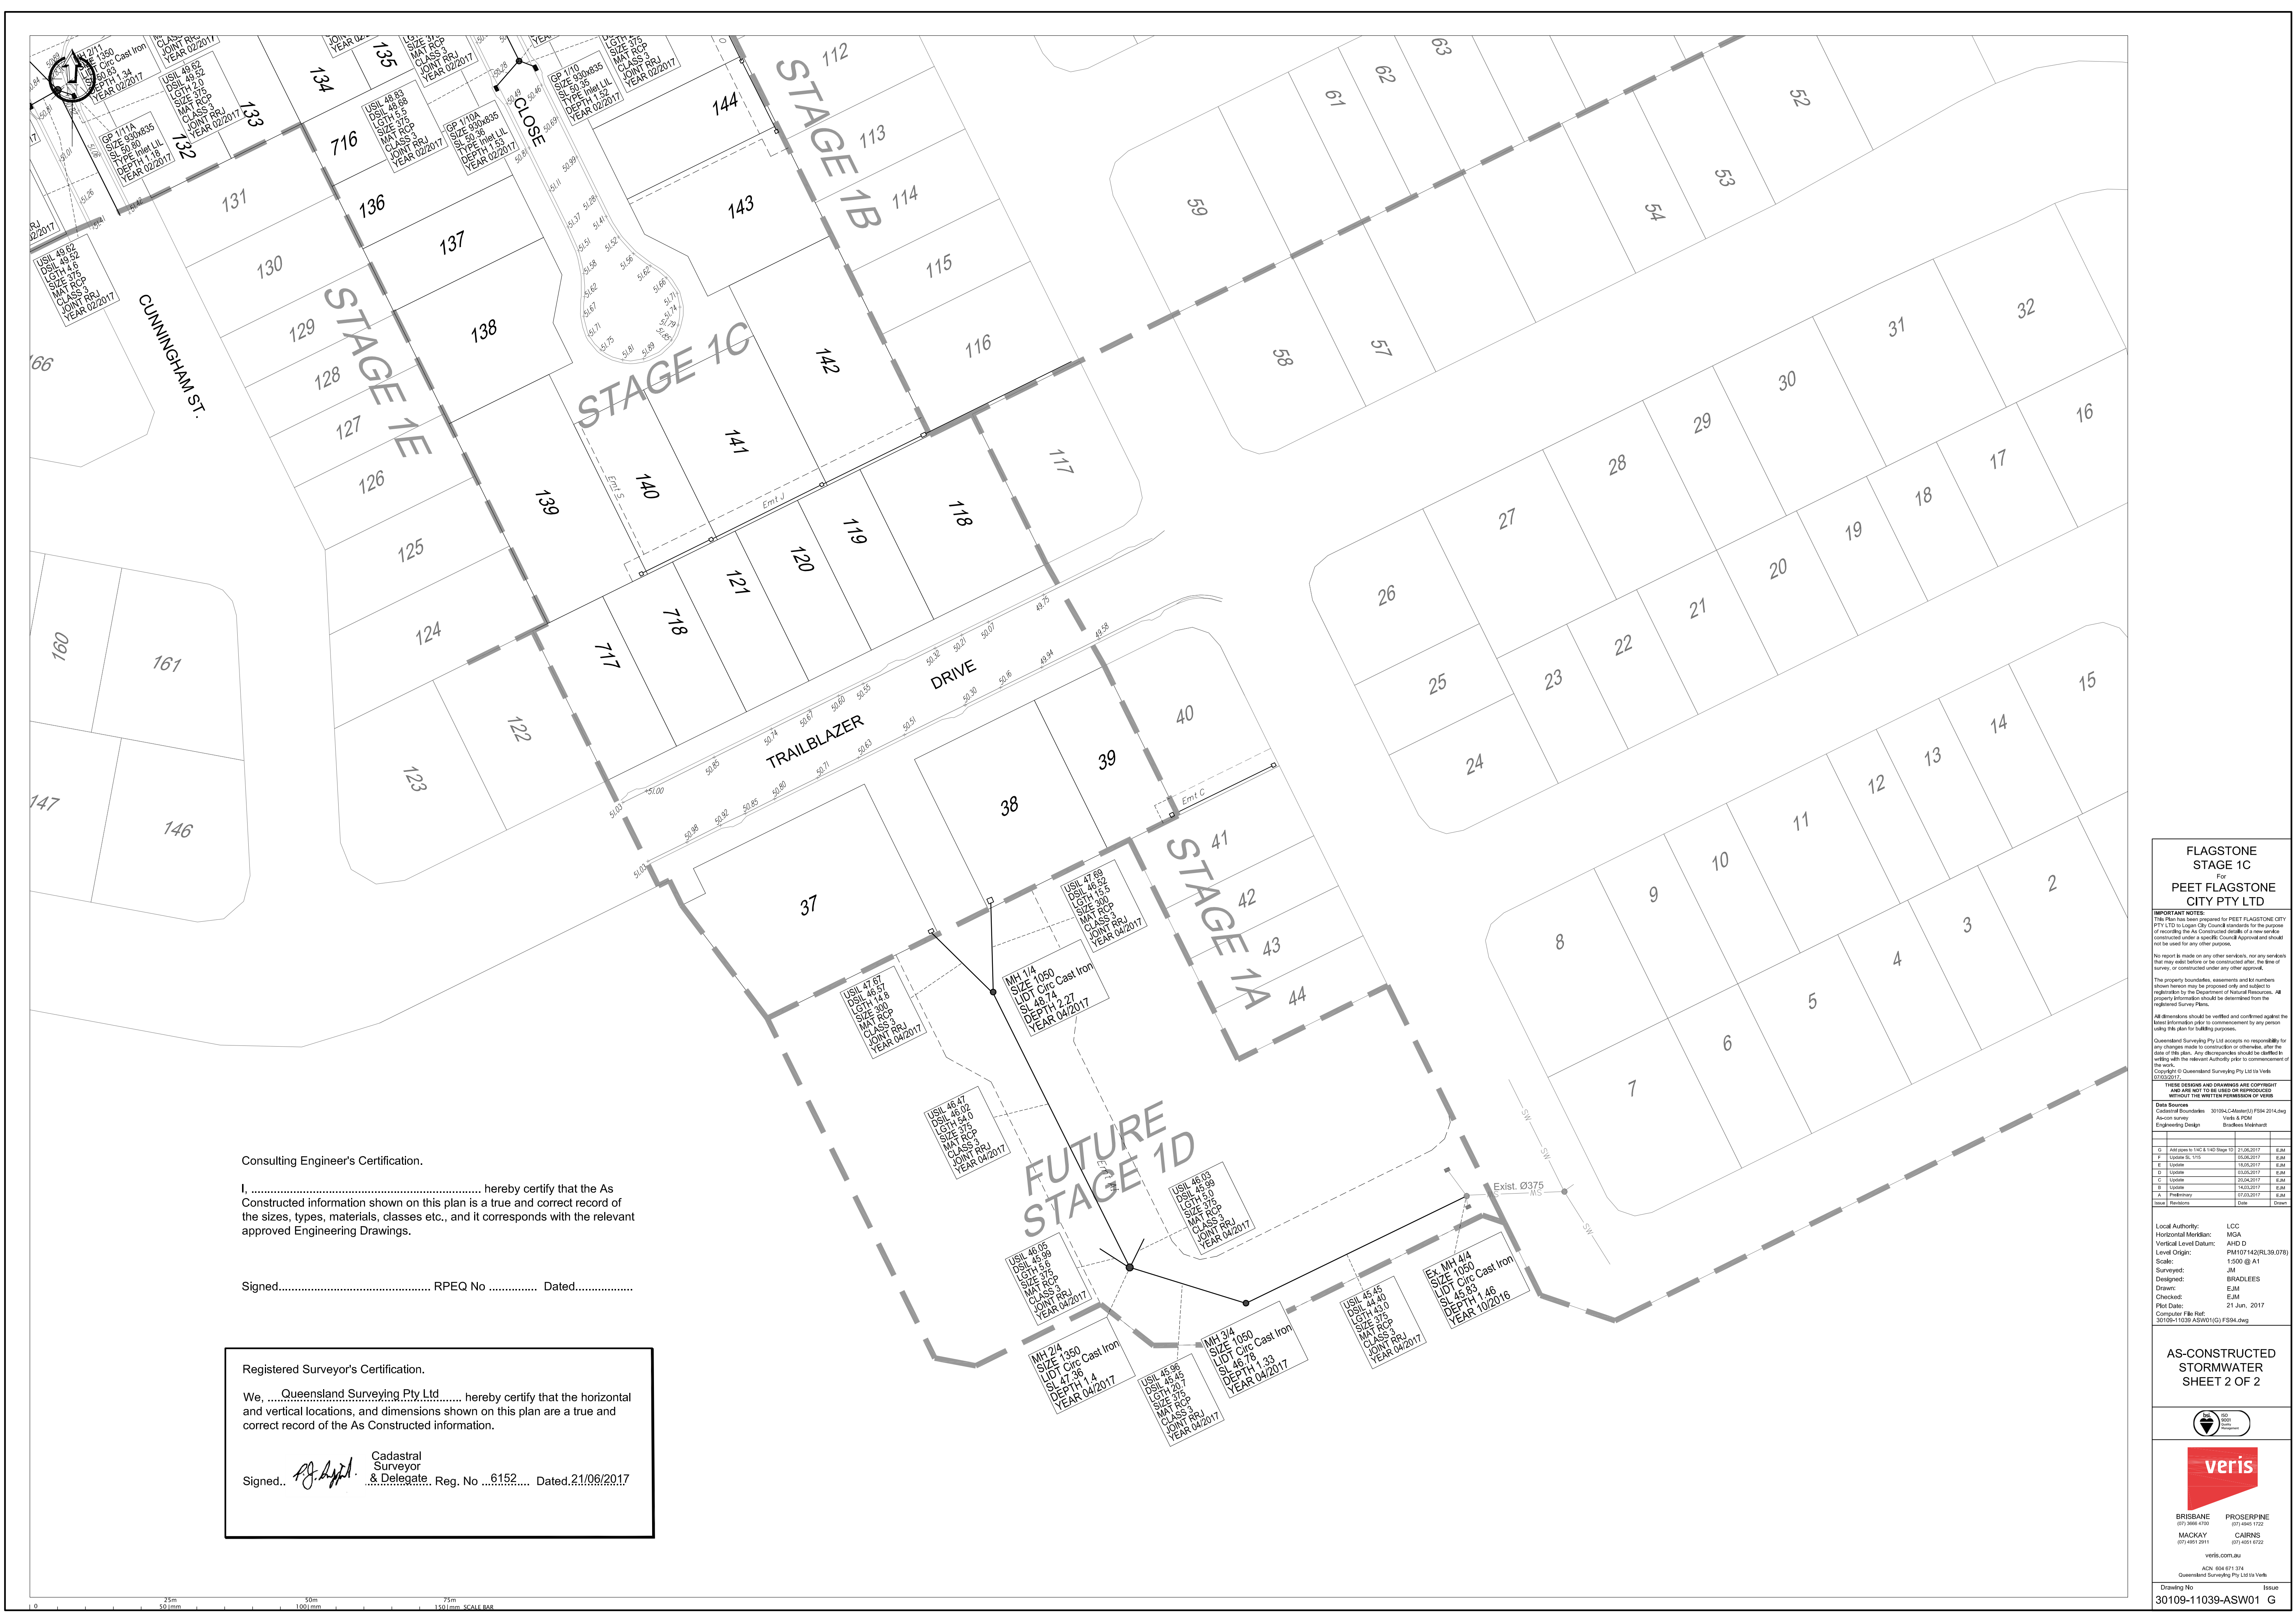

Consulting Engineer's Certification.

I, hereby certify that the As Constructed information shown on this plan is a true and correct record of the sizes, types, materials, classes etc., and it corresponds with the relevant approved Engineering Drawings.

Signed..... RPEQ No Dated.....

Registered Surveyor's Certification.

We, Queensland Surveying Pty Ltd. hereby certify that the horizontal and vertical locations, and dimensions shown on this plan are a true and correct record of the As Constructed information.

Signed.. *AS* Cadastral Surveyor & Delegate. Reg. No ...8152.... Dated.21/06/2017

FLAGSTONE
STAGE 1C
For
PEET FLAGSTONE
CITY PTY LTD

IMPORTANT NOTES:

This Plan has been prepared for PEET FLAGSTONE CITY PTY LTD by Logan City Council. It is intended for the purpose of recording the As Constructed details of a new water construction under a specific Council Approval and should not be used for any other purpose.

No report is made on any other services, nor any services that may exist before or be constructed after, the area of survey, or constructed under any other approval.

The property boundaries, easements and lot numbers shown herein may be proposed only and subject to registration by the Department of Natural Resources. All property information should be determined from the registered Survey Plans.

All dimensions should be verified and confirmed against the latest information prior to commencement by any person using this plan for building purposes.

Queensland Surveying Pty Ltd accepts no responsibility for any changes made to construction or otherwise, after the date of this plan. Any discrepancies should be identified with the relevant Authority prior to commencement of the work.

Copyright © Queensland Surveying Pty Ltd to Veris 07/05/2017.

THESE DESIGNS AND DRAWINGS ARE COPYRIGHTED AND ARE NOT TO BE USED OR REPRODUCED WITHOUT THE WRITTEN PERMISSION OF VERIS

Data Sources

Cadastral Boundaries	2010/04/01 (Matter) (F) 2014/04/01
As-con survey	Veris & PDM
Engineering Design	Bradlees Mainland

C	Add new to LCC & LHD Stage 1C	21/06/2017	EJM
F	Update BL 315	05/06/2017	EJM
E	Update	16/05/2017	EJM
D	Update	19/05/2017	EJM
C	Update	20/04/2017	EJM
E	Update	14/03/2017	EJM
A	Preliminary	07/03/2017	EJM
Issue	Revisions	Date	Drawn

Local Authority: LCC
Horizontal Meridian: MGA
Vertical Level Datum: AHD D
Level Origin: PM107142(RL39.078)
Scale: 1:500 @ A1
Surveyed: JM
Designed: BRADLEES
Drawn: EJM
Checked: EJM
Plot Date: 21 Jun. 2017
Computer File Ref: 2010/04/01-ASW01(G)-FS94.dwg

AS-CONSTRUCTED
STORMWATER
SHEET 2 OF 2

BRISBANE
(07) 3861 6700

PROSERPINE
(07) 4945 1122

MACKAY
(07) 4551 2911

CAIRNS
(07) 4051 6722

veris.com.au

ACN: 604 671 374
Queensland Surveying Pty Ltd is a Veris

Drawing No: 30109-11039-ASW01
Issue: G