


REGISTERED SURVEYOR'S CERTIFICATION
 I, Andrew Robert Thurston (Cad. Surv.), hereby certify that the vertical and horizontal locations and dimensions shown on this plan are a true and correct record and were located by survey.
 Registered Surveyor (sig.) _____ Reg. Surveyor No. 3047 Date: 13/12/2017

ENGINEER'S CERTIFICATION
 I, _____, hereby certify that:
 1. The information contained in this drawing / document is in compliance with approved drawings and design.
 2. The new water and sewerage works defined by this drawing have been designed and constructed in accordance with the SEQ Code.
 3. This represents an accurate record of as-constructed works.
 4. I accept responsibility for the information contained in this drawing / document.
 RPEQ (signature) _____ RPEQ No. _____ Date: _____

- LEGEND:**
- NEW SEWER MAIN
 - s- EXISTING SEWER MAIN
 - / NEW HOUSE CONNECTION
 - SEWER MAINTENANCE HOLE
 - SEWER MAINTENANCE SHAFT U.N.O.
 - SEWER EOL

- NOTE:**
- ALL SEWER MAINS DN160 PE100 CLASS SDR21 U.N.O.
 - ALL MAINTENANCE HOLES (MH) 1200Ø CONCRETE INSITU U.N.O.
 - ALL MAINTENANCE SHAFTS (MS) 600Ø SERVICESTREAM PE100

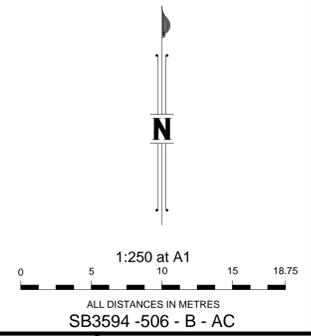

A1	B	13/12/2017	As Constructed	JC	ADH	AT
	A	01/12/2017	Preliminary Issue	JC	ADH	AT
	INDEX	DATE	REVISIONS	DRAWN	CHECKED	PASSED

DRAWN	JC	13/12/2017
CHECKED	ADJ	13/12/2017
PASSED	AT	13/12/2017
INITIALS		DATE

WOLTER consulting group
 Planning Urban Design Landscape Environment Surveying
 Brisbane: Level 2, 1 Breakfast Ck Road, Newstead, QLD 4006 Phone: (07) 3666 5200




Unitywater
 Riverbank Estate Stage 6A
 As-Constructed Sewer Reticulation
 DA/30466/2015/V3RM

SCALE	1:250 (A1)
SHEET	1 OF 4 SHEETS
DRAWING NO.	

REGISTERED SURVEYOR'S CERTIFICATION
 I, Andrew Robert Thurston (Cad. Surv.), hereby certify that the vertical and horizontal locations and dimensions shown on this plan are a true and correct record and were located by survey.
 Registered Surveyor (sig.) _____ Reg. Surveyor No. 3047 Date: 13/12/2017

ENGINEER'S CERTIFICATION
 I, _____, hereby certify that:
 1. The information contained in this drawing / document is in compliance with approved drawings and design.
 2. The new water and sewerage works defined by this drawing have been designed and constructed in accordance with the SEQ Code.
 3. This represents an accurate record of as-constructed works.
 4. I accept responsibility for the information contained in this drawing / document.
 RPEQ (signature) _____ RPEQ No. _____ Date: _____

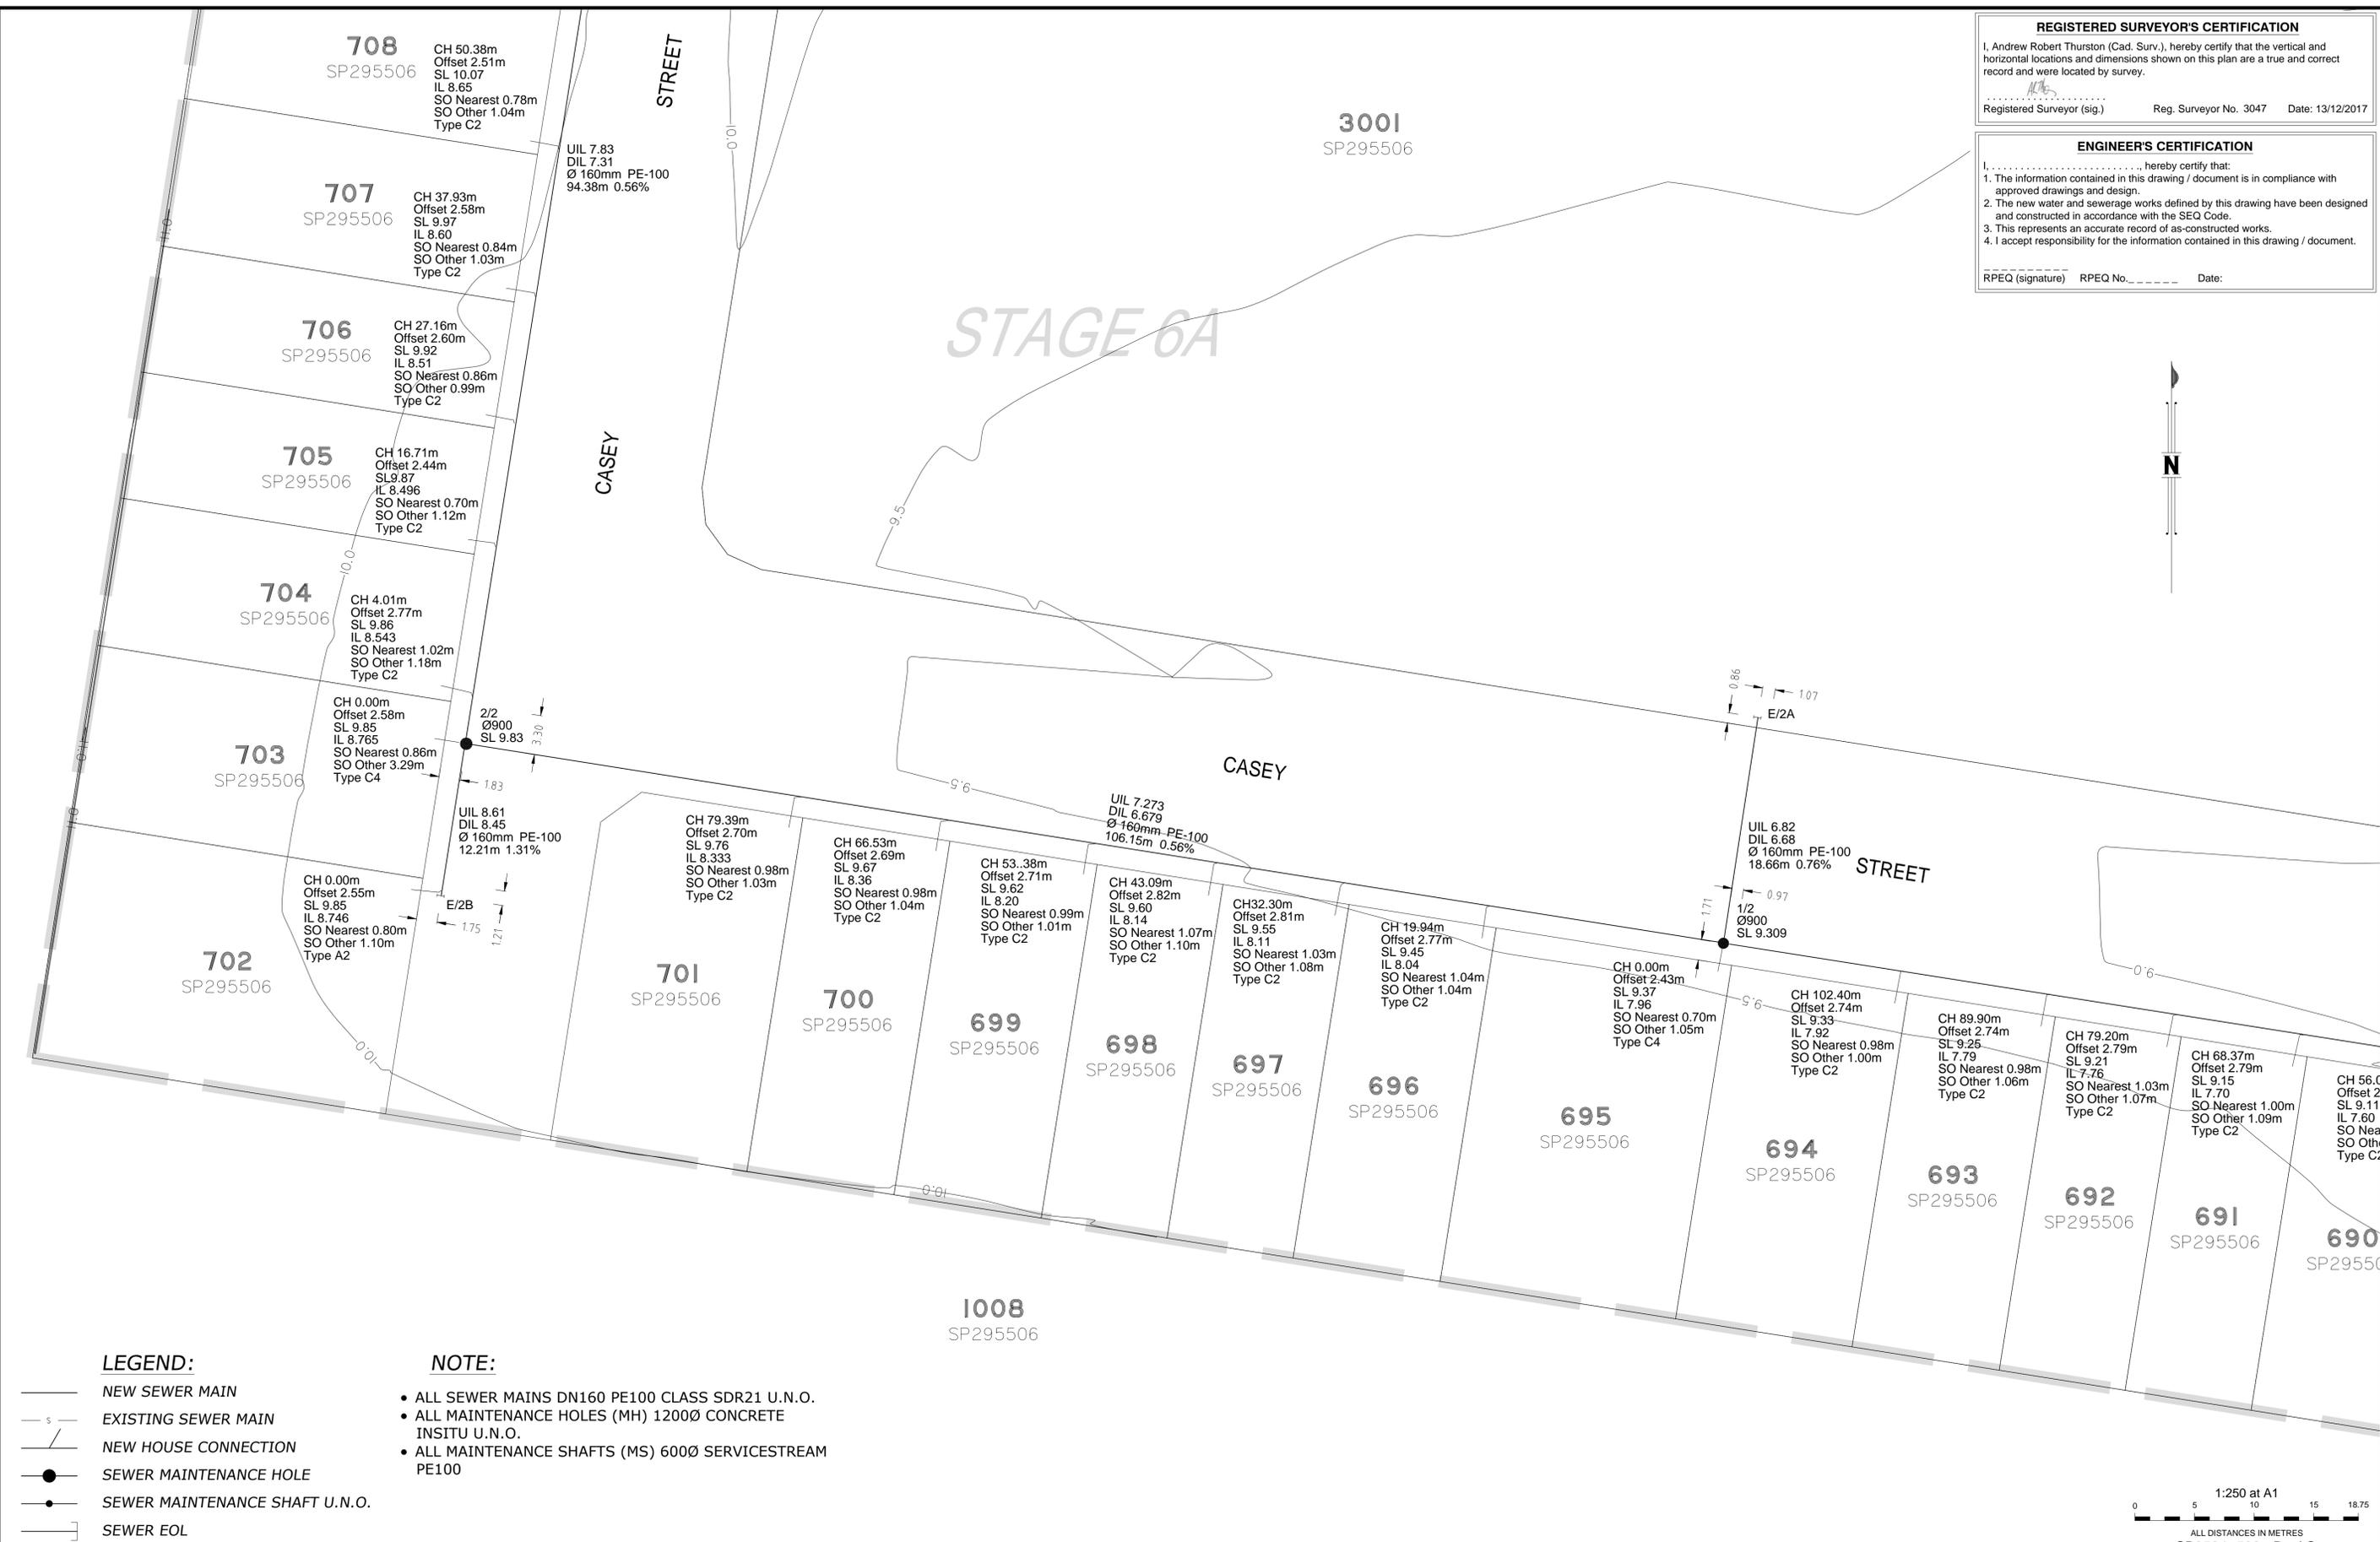


LEGEND:

- NEW SEWER MAIN
- s- EXISTING SEWER MAIN
- NEW HOUSE CONNECTION
- SEWER MAINTENANCE HOLE
- SEWER MAINTENANCE SHAFT U.N.O.
- SEWER EOL

NOTE:

- ALL SEWER MAINS DN160 PE100 CLASS SDR21 U.N.O.
- ALL MAINTENANCE HOLES (MH) 1200Ø CONCRETE INSITU U.N.O.
- ALL MAINTENANCE SHAFTS (MS) 600Ø SERVICESTREAM PE100

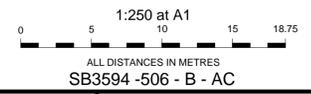

A1	B	13/12/2017	As Constructed	JC	ADH	AT
	A	01/12/2017	Preliminary Issue	JC	ADH	AT
	INDEX DATE			REVISIONS		
	DRAWN	CHECKED	PASSED	DRAWN	CHECKED	PASSED

DRAWN	JC	13/12/2017
CHECKED	ADJ	13/12/2017
PASSED	AT	13/12/2017
INITIALS		DATE



Unitywater
 Riverbank Estate Stage 6A
 As-Constructed Sewer Reticulation
 DA/30466/2015/V3RM

SCALE	1:250 (A1)
SHEET	2 OF 4 SHEETS
DRAWING NO.	
	B
	A

STAGE 6A




REGISTERED SURVEYOR'S CERTIFICATION
 I, Andrew Robert Thurston (Cad. Surv.), hereby certify that the vertical and horizontal locations and dimensions shown on this plan are a true and correct record and were located by survey.
 Registered Surveyor (sig.) _____ Reg. Surveyor No. 3047 Date: 13/12/2017

ENGINEER'S CERTIFICATION
 I, _____, hereby certify that:
 1. The information contained in this drawing / document is in compliance with approved drawings and design.
 2. The new water and sewerage works defined by this drawing have been designed and constructed in accordance with the SEQ Code.
 3. This represents an accurate record of as-constructed works.
 4. I accept responsibility for the information contained in this drawing / document.
 RPEQ (signature) _____ RPEQ No. _____ Date: _____

- LEGEND:**
- NEW SEWER MAIN
 - s- EXISTING SEWER MAIN
 - NEW HOUSE CONNECTION
 - SEWER MAINTENANCE HOLE
 - SEWER MAINTENANCE SHAFT U.N.O.
 - SEWER EOL

- NOTE:**
- ALL SEWER MAINS DN160 PE100 CLASS SDR21 U.N.O.
 - ALL MAINTENANCE HOLES (MH) 1200Ø CONCRETE INSITU U.N.O.
 - ALL MAINTENANCE SHAFTS (MS) 600Ø SERVICESTREAM PE100

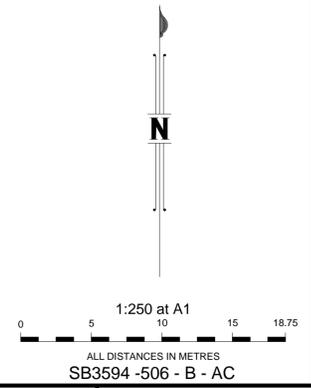

A1	B	13/12/2017	As Constructed	JC	ADH	AT
	A	01/12/2017	Preliminary Issue	JC	ADH	AT
	INDEX	DATE	REVISIONS	DRAWN	CHECKED	PASSED

DRAWN	JC	13/12/2017
CHECKED	ADJ	13/12/2017
PASSED	AT	13/12/2017
INITIALS	DATE	

WOLTER consulting group
 Planning Urban Design Landscape Environment Surveying
 Brisbane: Level 2, 1 Breakfast Ck Road, Newstead, QLD 4006 Phone: (07) 3666 5200



Unitywater
 Riverbank Estate Stage 6A
 As-Constructed Sewer Reticulation
 DA/30466/2015/V3RM

SCALE	1:250 (A1)
SHEET	3 OF 4 SHEETS
DRAWING NO.	

REGISTERED SURVEYOR'S CERTIFICATION
 I, Andrew Robert Thurston (Cad. Surv.), hereby certify that the vertical and horizontal locations and dimensions shown on this plan are a true and correct record and were located by survey.
 Registered Surveyor (sig.) _____ Reg. Surveyor No. 3047 Date: 13/12/2017


ENGINEER'S CERTIFICATION
 I, _____, hereby certify that:
 1. The information contained in this drawing / document is in compliance with approved drawings and design.
 2. The new water and sewerage works defined by this drawing have been designed and constructed in accordance with the SEQ Code.
 3. This represents an accurate record of as-constructed works.
 4. I accept responsibility for the information contained in this drawing / document.
 RPEQ (signature) _____ RPEQ No. _____ Date: _____

- LEGEND:**
- NEW SEWER MAIN
 - s- EXISTING SEWER MAIN
 - / NEW HOUSE CONNECTION
 - SEWER MAINTENANCE HOLE
 - SEWER MAINTENANCE SHAFT U.N.O.
 - SEWER EOL

- NOTE:**
- ALL SEWER MAINS DN160 PE100 CLASS SDR21 U.N.O.
 - ALL MAINTENANCE HOLES (MH) 1200Ø CONCRETE INSITU U.N.O.
 - ALL MAINTENANCE SHAFTS (MS) 600Ø SERVICESTREAM PE100



STAGE 6A

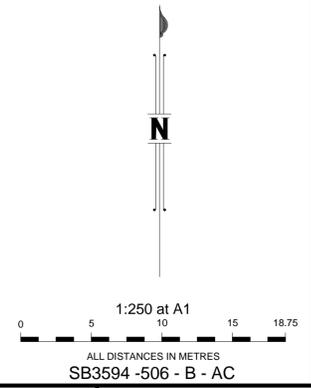

A1	B	13/12/2017	As Constructed	JC	ADH	AT
	A	01/12/2017	Preliminary Issue	JC	ADH	AT
	INDEX	DATE	REVISIONS	DRAWN	CHECKED	PASSED

DRAWN	JC	13/12/2017
CHECKED	ADJ	13/12/2017
PASSED	AT	13/12/2017
INITIALS		DATE

WOLTER consulting group
 Planning Urban Design Landscape Environment Surveying
 Brisbane: Level 2, 1 Breakfast Ck Road, Newstead, QLD 4006 Phone: (07) 3666 5200




Unitywater
 Riverbank Estate Stage 6A
 As-Constructed Sewer Reticulation
 DA/30466/2015/V3RM

SCALE	1:250 (A1)
SHEET	4 OF 4 SHEETS
DRAWING NO.	

REGISTERED SURVEYOR'S CERTIFICATION
 I, Andrew Robert Thurston (Cad. Surv.), hereby certify that the vertical and horizontal locations and dimensions shown on this plan are a true and correct record and were located by survey.
 Registered Surveyor (sig.) _____ Reg. Surveyor No. 3047 Date: 13/12/2017

ENGINEER'S CERTIFICATION
 I, _____, hereby certify that:
 1. The information contained in this drawing / document is in compliance with approved drawings and design.
 2. The new water and sewerage works defined by this drawing have been designed and constructed in accordance with the SEQ Code.
 3. This represents an accurate record of as-constructed works.
 4. I accept responsibility for the information contained in this drawing / document.
 RPEQ (signature) _____ RPEQ No. _____ Date: _____

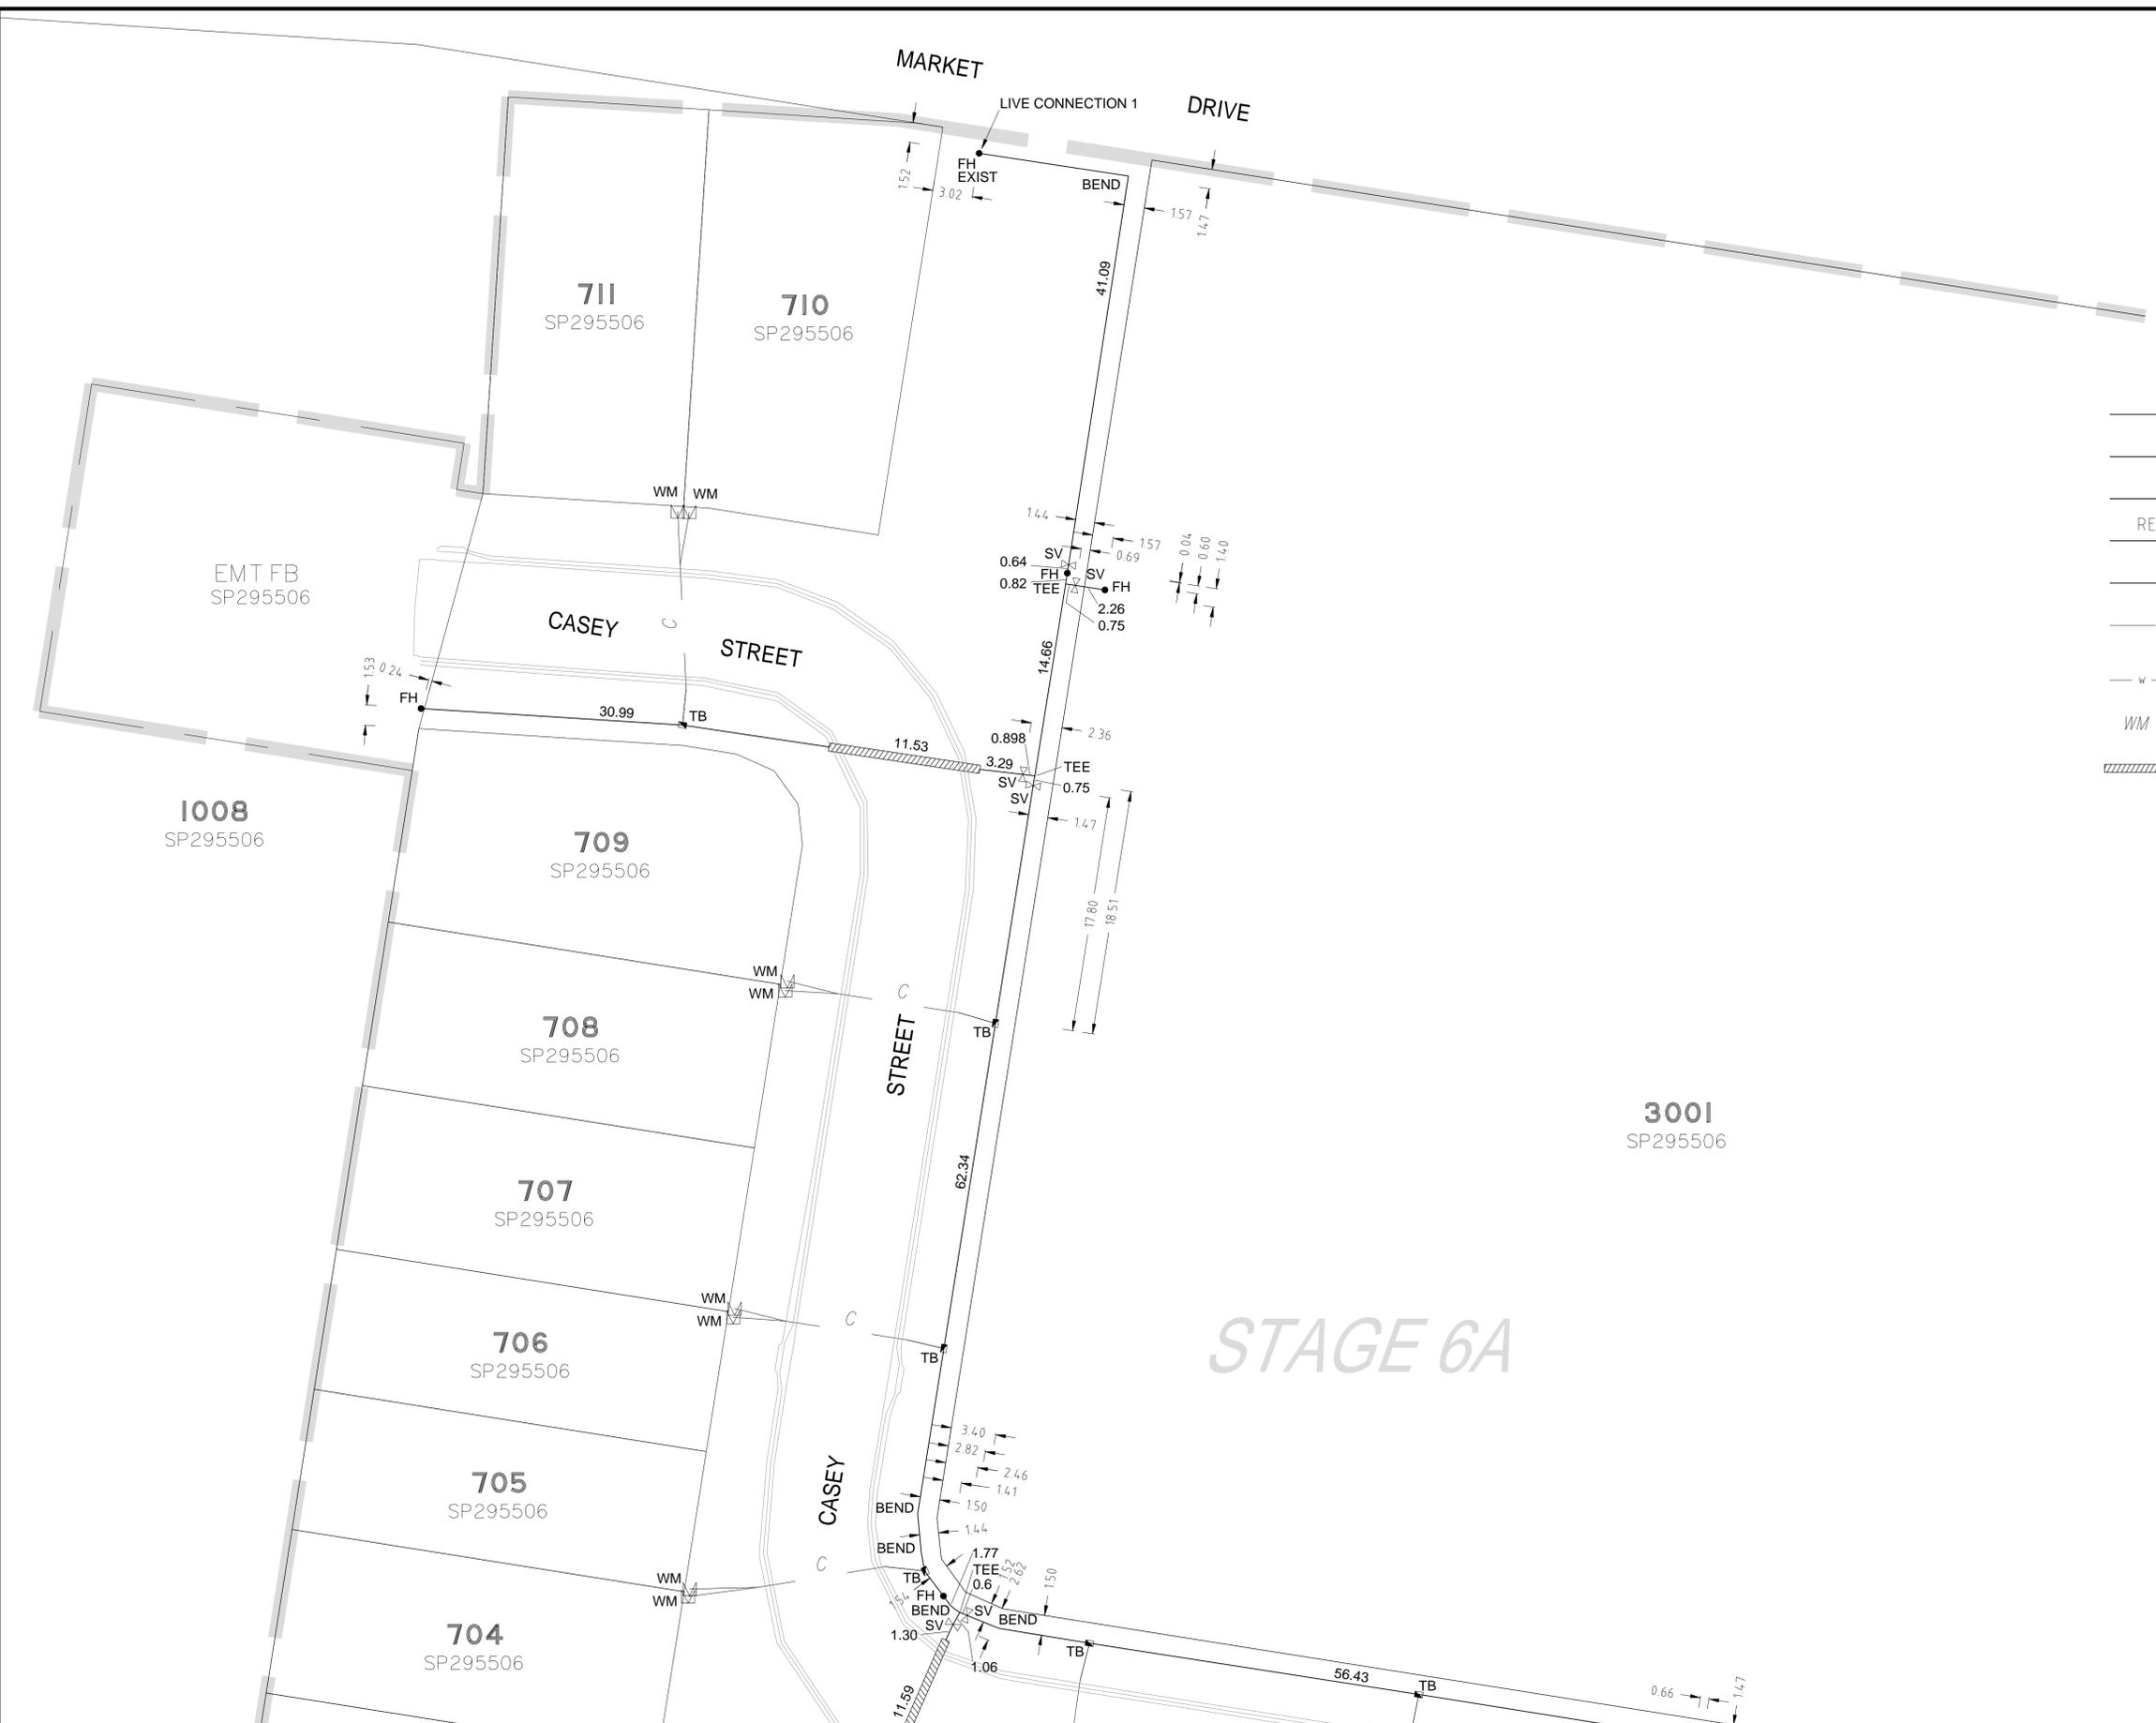


LEGEND:

- NEW READY TAP HOUSE CONNECTION
- NEW HYDRANT
- NEW SLUICE VALVE
- NEW Ø150xØ100 REDUCER
- NEW END CAP
- NEW WATER SERVICE CONDUIT Ø100 PVC-O
- EXISTING Ø150 WATER MAIN
- NEW WATER SERVICE CONNECTION 20mm MANUFACTURER - ITRON
- Ø150 DICL WATERMAIN

NOTE:

- ALL MAINS Ø150 PVC-U CLASS PN16 U.N.O.

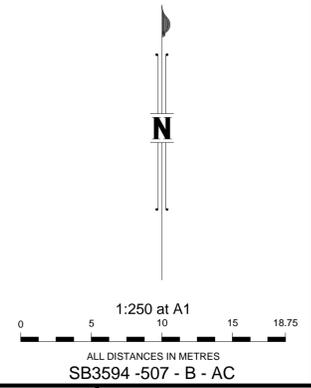

A1	B	13/12/2017	As Constructed	JC	ADH	AT
	A	01/12/2017	Preliminary Issue	JC	ADH	AT
	INDEX	DATE	REVISIONS	DRAWN	CHECKED	PASSED

DRAWN	JC	13/12/2017
CHECKED	ADJ	13/12/2017
PASSED	AT	13/12/2017
INITIALS	DATE	



Unitywater
 Riverbank Estate Stage 6A
 As-Constructed Water Reticulation
 DA/30466/2015/V3RM

SCALE	1:250 (A1)
SHEET	1 OF 4 SHEETS
DRAWING NO.	

STAGE 6A

3002
SP295506

3001
SP295506

684
SP295506

1008
SP295506

685
SP295506

691
SP295506

690
SP295506

689
SP295506

688
SP295506

686
SP295506

687
SP295506

EMT FA
SP295506


REGISTERED SURVEYOR'S CERTIFICATION
I, Andrew Robert Thurston (Cad. Surv.), hereby certify that the vertical and horizontal locations and dimensions shown on this plan are a true and correct record and were located by survey.
Registered Surveyor (sig.) _____ Reg. Surveyor No. 3047 Date: 13/12/2017

ENGINEER'S CERTIFICATION
I, _____, hereby certify that:
1. The information contained in this drawing / document is in compliance with approved drawings and design.
2. The new water and sewerage works defined by this drawing have been designed and constructed in accordance with the SEQ Code.
3. This represents an accurate record of as-constructed works.
4. I accept responsibility for the information contained in this drawing / document.
RPEQ (signature) _____ RPEQ No. _____ Date: _____

- LEGEND:**
- NEW READY TAP HOUSE CONNECTION
 - NEW HYDRANT
 - NEW SLUICE VALVE
 - NEW Ø150xØ100 REDUCER
 - NEW END CAP
 - NEW WATER SERVICE CONDUIT Ø100 PVC-O
 - EXISTING Ø150 WATER MAIN
 - NEW WATER SERVICE CONNECTION 20mm MANUFACTURER - ITRON
 - Ø150 DICL WATERMAIN

NOTE:

- ALL MAINS Ø150 PVC-U CLASS PN16 U.N.O.

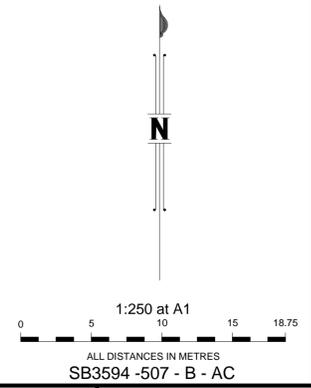

A1	B	13/12/2017	As Constructed	JC	ADH	AT
	A	01/12/2017	Preliminary Issue	JC	ADH	AT
	INDEX	DATE	REVISIONS	DRAWN	CHECKED	PASSED


DRAWN	JC	13/12/2017
CHECKED	ADJ	13/12/2017
PASSED	AT	13/12/2017
INITIALS	DATE	

WOLTER consulting group
 Planning Urban Design Landscape Environment Surveying
 Brisbane: Level 2, 1 Breakfast Ck Road, Newstead, QLD 4006 Phone: (07) 3666 5200

Unitywater

Unitywater
 Riverbank Estate Stage 6A
 As-Constructed Water Reticulation
 DA/30466/2015/V3RM

SCALE	1:250 (A1)
SHEET	3 OF 4 SHEETS
DRAWING NO.	
	B A

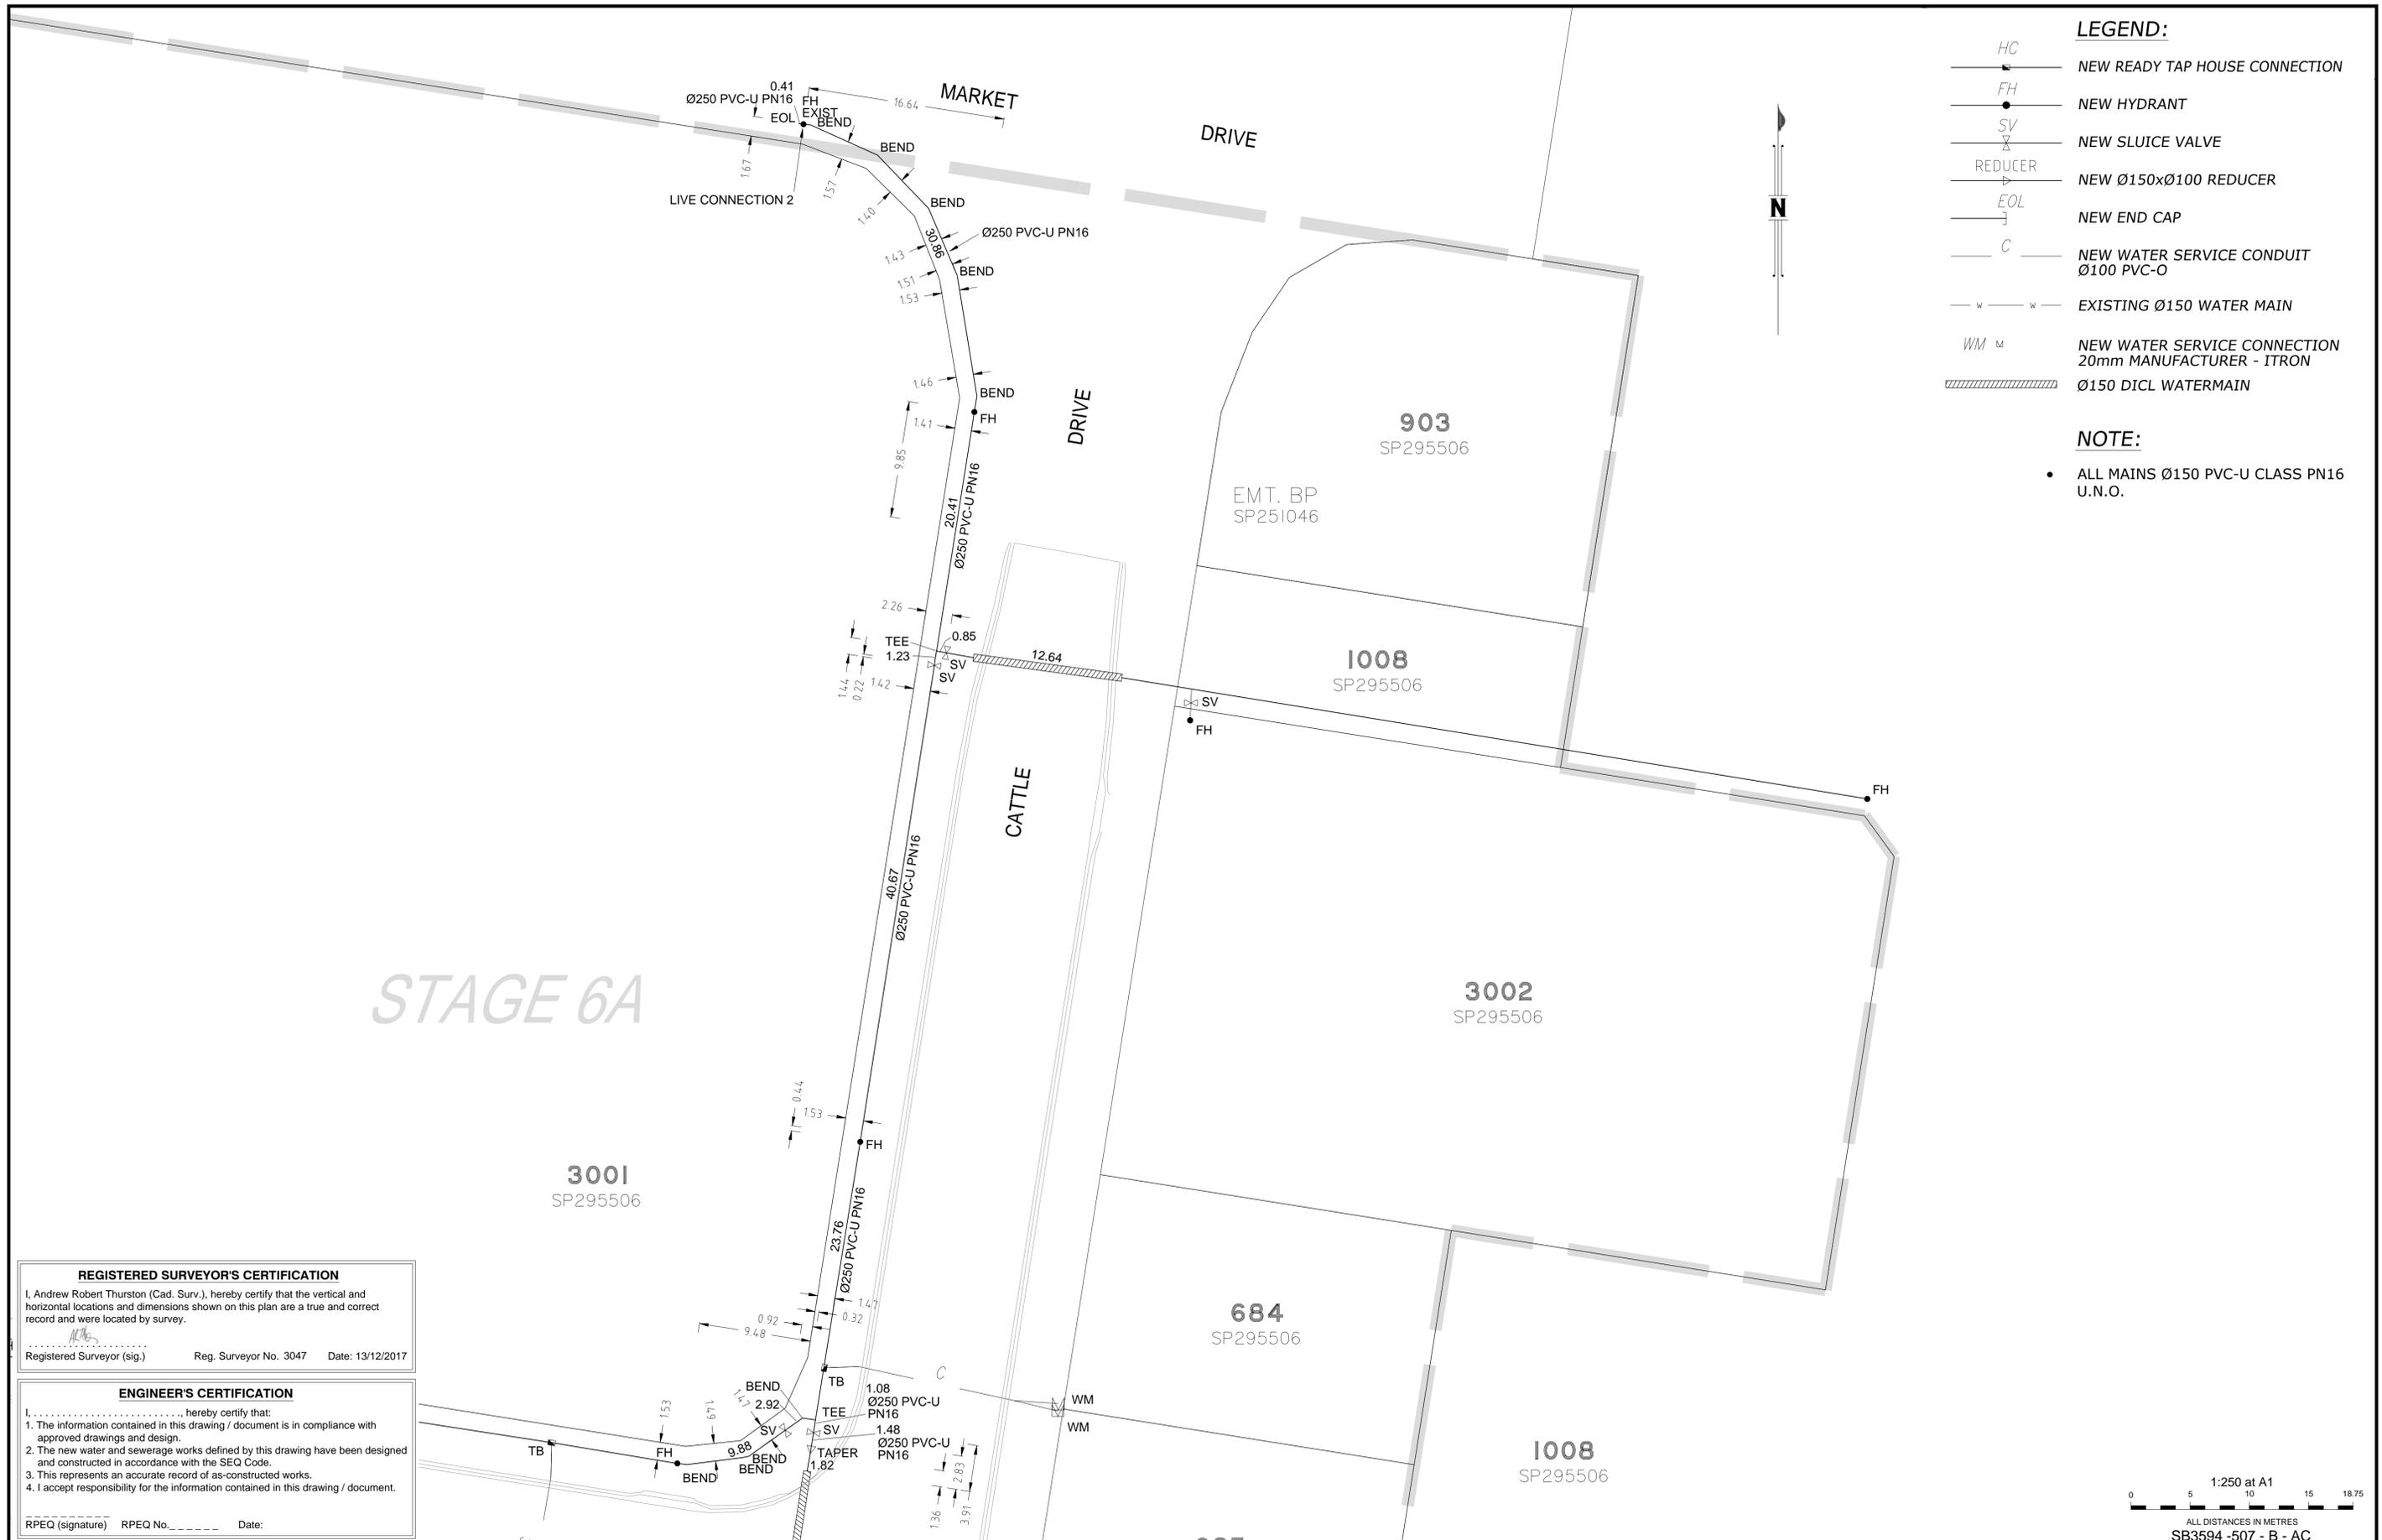

LEGEND:

- NEW READY TAP HOUSE CONNECTION
- NEW HYDRANT
- NEW SLUICE VALVE
- NEW Ø150xØ100 REDUCER
- NEW END CAP
- NEW WATER SERVICE CONDUIT Ø100 PVC-O
- EXISTING Ø150 WATER MAIN
- NEW WATER SERVICE CONNECTION 20mm MANUFACTURER - ITRON
- Ø150 DI CL WATERMAIN

NOTE:

- ALL MAINS Ø150 PVC-U CLASS PN16 U.N.O.

STAGE 6A

REGISTERED SURVEYOR'S CERTIFICATION


I, Andrew Robert Thurston (Cad. Surv.), hereby certify that the vertical and horizontal locations and dimensions shown on this plan are a true and correct record and were located by survey.

Registered Surveyor (sig.) _____ Reg. Surveyor No. 3047 Date: 13/12/2017

ENGINEER'S CERTIFICATION

- I, _____, hereby certify that:
1. The information contained in this drawing / document is in compliance with approved drawings and design.
 2. The new water and sewerage works defined by this drawing have been designed and constructed in accordance with the SEQ Code.
 3. This represents an accurate record of as-constructed works.
 4. I accept responsibility for the information contained in this drawing / document.

RPEQ (signature) _____ RPEQ No. _____ Date: _____

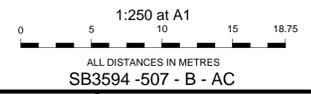

A1	B	13/12/2017	As Constructed	JC	ADH	AT
	A	01/12/2017	Preliminary Issue	JC	ADH	AT
	INDEX	DATE	REVISIONS	DRAWN	CHECKED	PASSED

DRAWN	JC	13/12/2017
CHECKED	ADJ	13/12/2017
PASSED	AT	13/12/2017
INITIALS	DATE	

WOLTER
consulting group

Planning
 Urban Design
 Landscape
 Environment
 Surveying


Brisbane: Level 2, 1 Breakfast Ck Road, Newstead, QLD 4006 Phone: (07) 3666 5200

Unitywater

Unitywater

Riverbank Estate Stage 6A
As-Constructed Water Reticulation
DA/30466/2015/V3RM

SCALE	1:250 (A1)
SHEET	4 OF 4 SHEETS
DRAWING NO.	
A	A

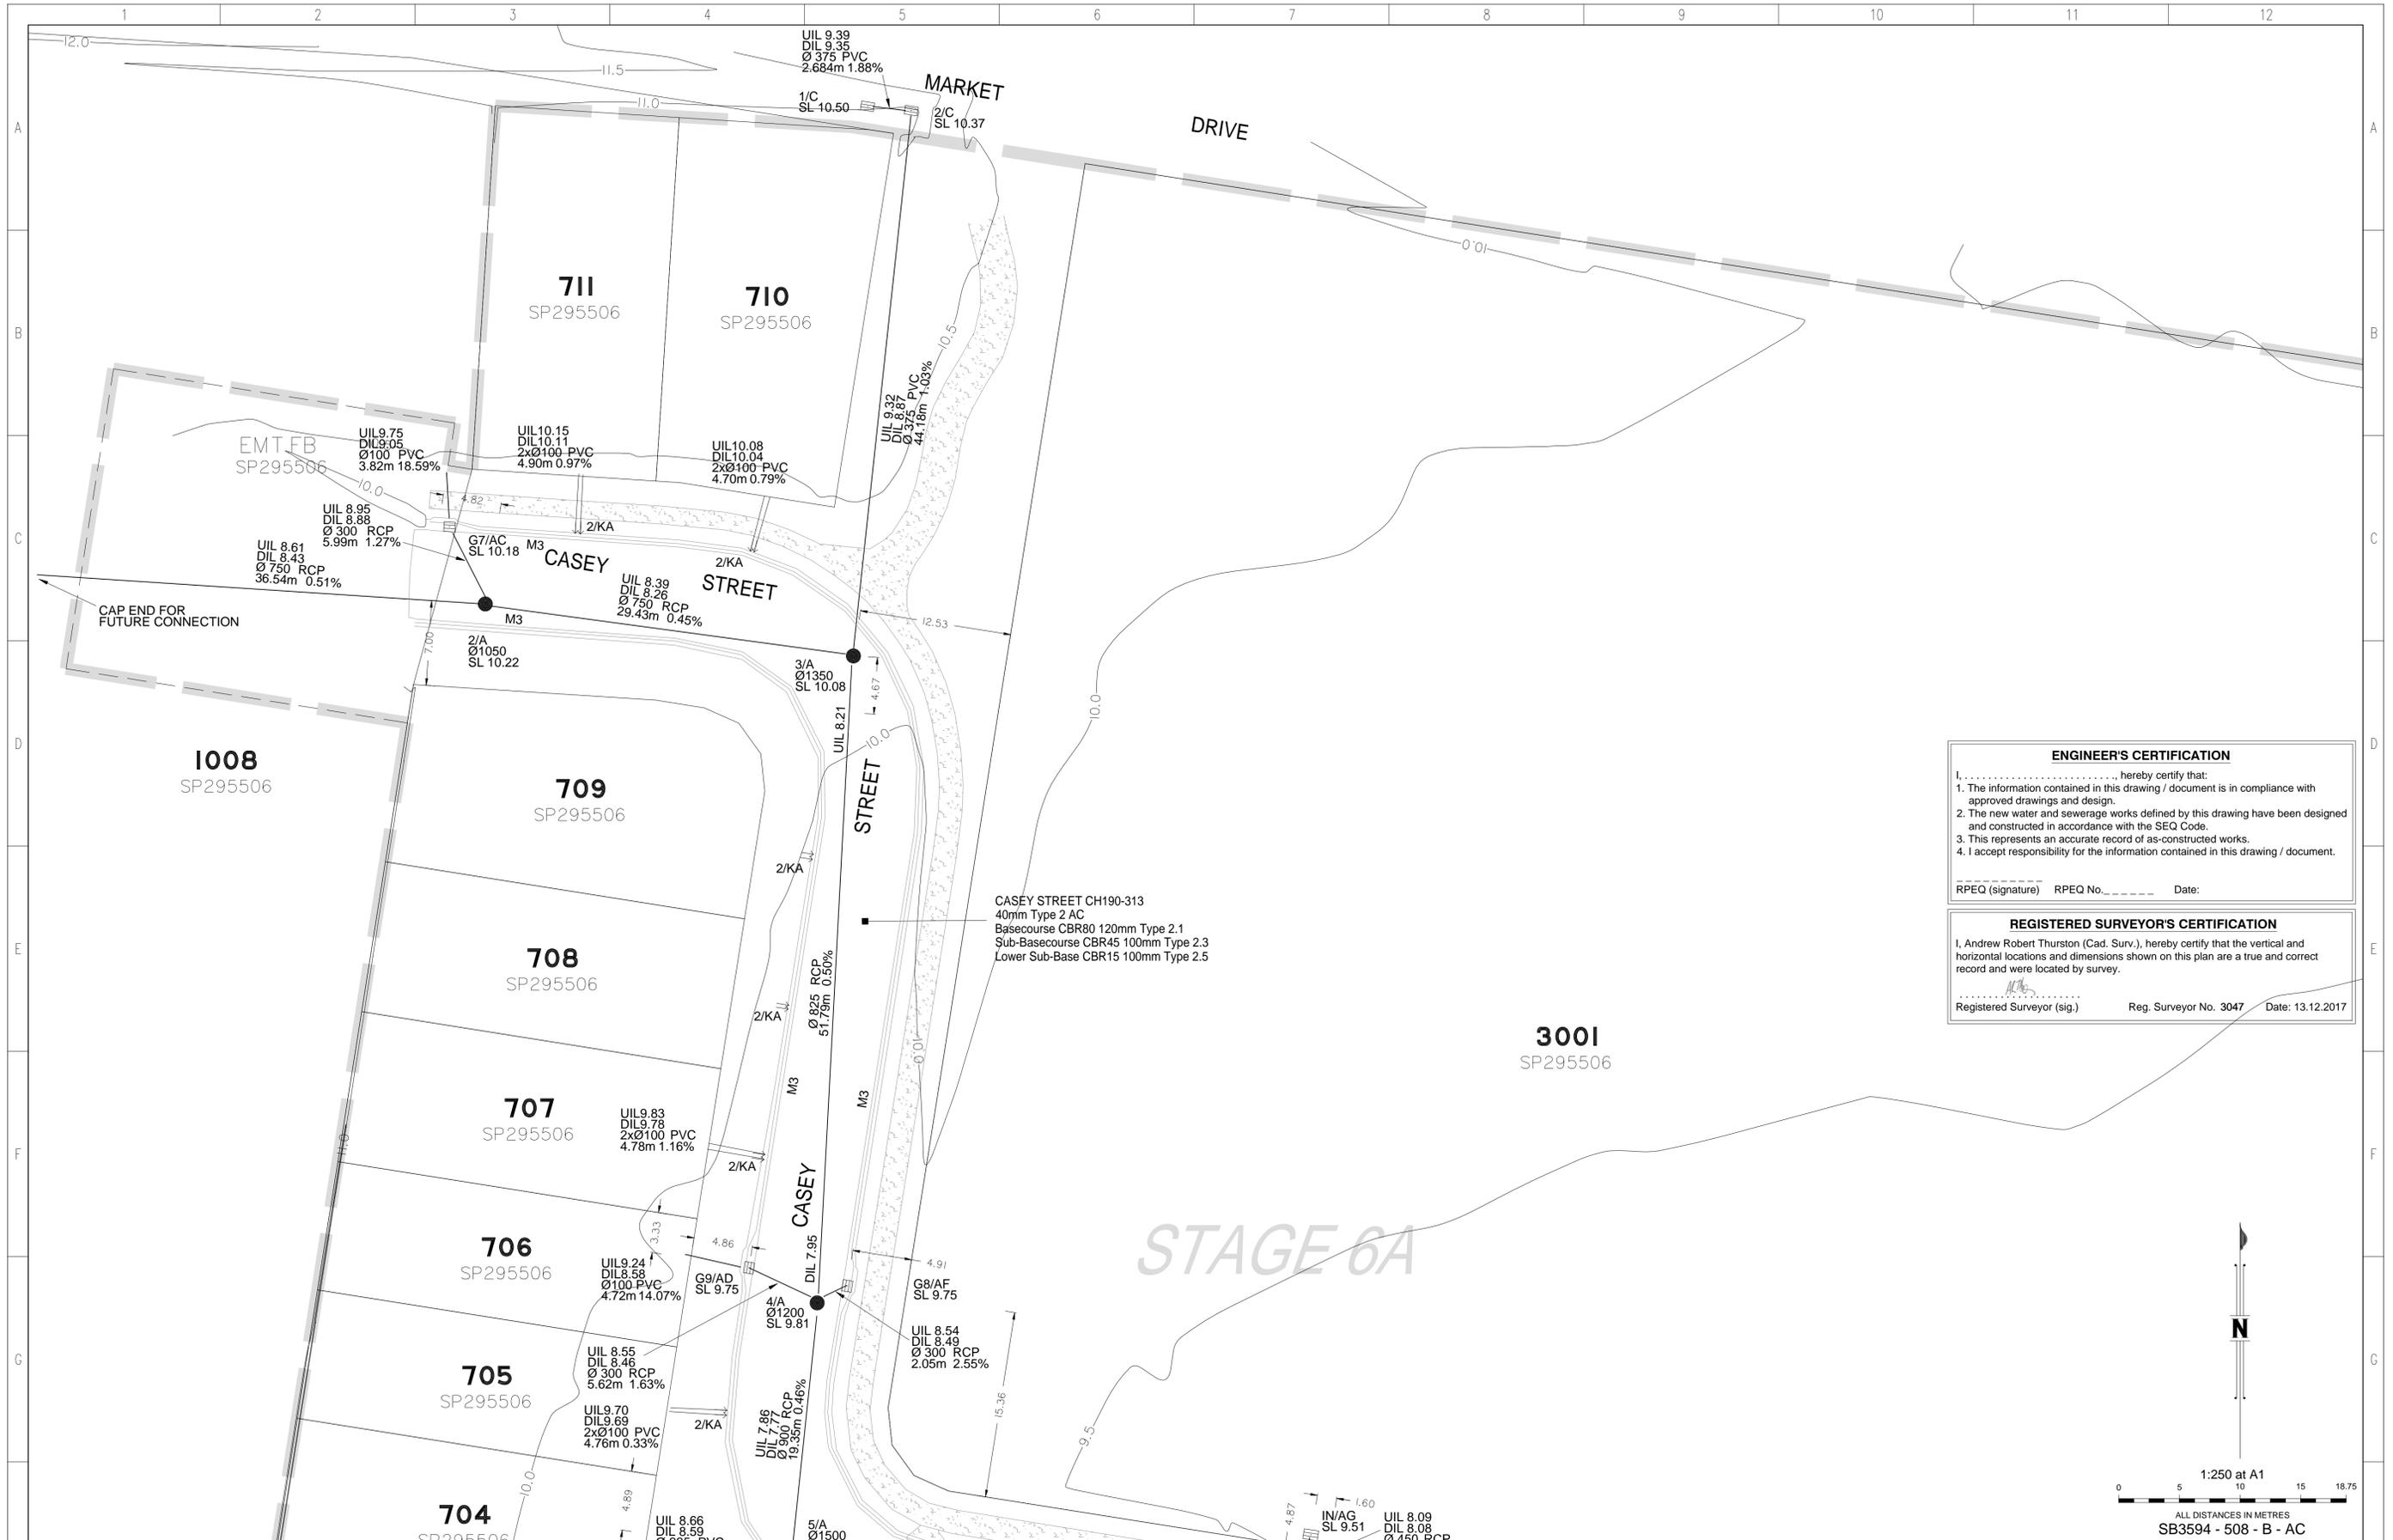

ENGINEER'S CERTIFICATION
 I, _____, hereby certify that:
 1. The information contained in this drawing / document is in compliance with approved drawings and design.
 2. The new water and sewerage works defined by this drawing have been designed and constructed in accordance with the SEQ Code.
 3. This represents an accurate record of as-constructed works.
 4. I accept responsibility for the information contained in this drawing / document.
 RPEQ (signature) RPEQ No. _____ Date: _____

REGISTERED SURVEYOR'S CERTIFICATION
 I, Andrew Robert Thurston (Cad. Surv.), hereby certify that the vertical and horizontal locations and dimensions shown on this plan are a true and correct record and were located by survey.
 Registered Surveyor (sig.) Reg. Surveyor No. 3047 Date: 13.12.2017

STAGE 6A

DRAWING REVISIONS		REFERENCE DRAWINGS		DESIGN FILE No.		DESIGNED BY:	
REV.	REVISION DESCRIPTION	DRG. No.	DESCRIPTION	CONSTRUCT. No.	DATE	DATE	DATE
A	PRELIMINARY ISSUE					13.12.2017	JC
B	AS CONSTRUCTED					13.12.2017	ADH

THIS WORK WAS PREPARED BY:

WOLTER consulting group
 Planning Urban Design Landscape Environment Surveying
 Brisbane Level 2, 1 Breakfast Ck Road, Newstead, QLD 4056 Phone: (07) 5666 5300


SCALE 1:250 ORIGINAL SIZE A1

Moreton Bay Regional Council

MORETON BAY REGIONAL COUNCIL
 CABOOLTURE DISTRICT OFFICE
 2 HASKING STREET CABOOLTURE QLD 4510
 PO BOX 159 CABOOLTURE QLD 4510
 Telephone: (07) 5433 0100
 Fax: (07) 5433 4000

RIVERBANK ESTATE
 STAGE 6A
 AS CONSTRUCTED
 ROADS AND DRAINAGE


CSC SUBDIVISION REFERENCE	
DA/30466/2015/V3RM	
No. 1 OF 4 PLANS	
ASCAN GRID NUMBER	REV.
-	B

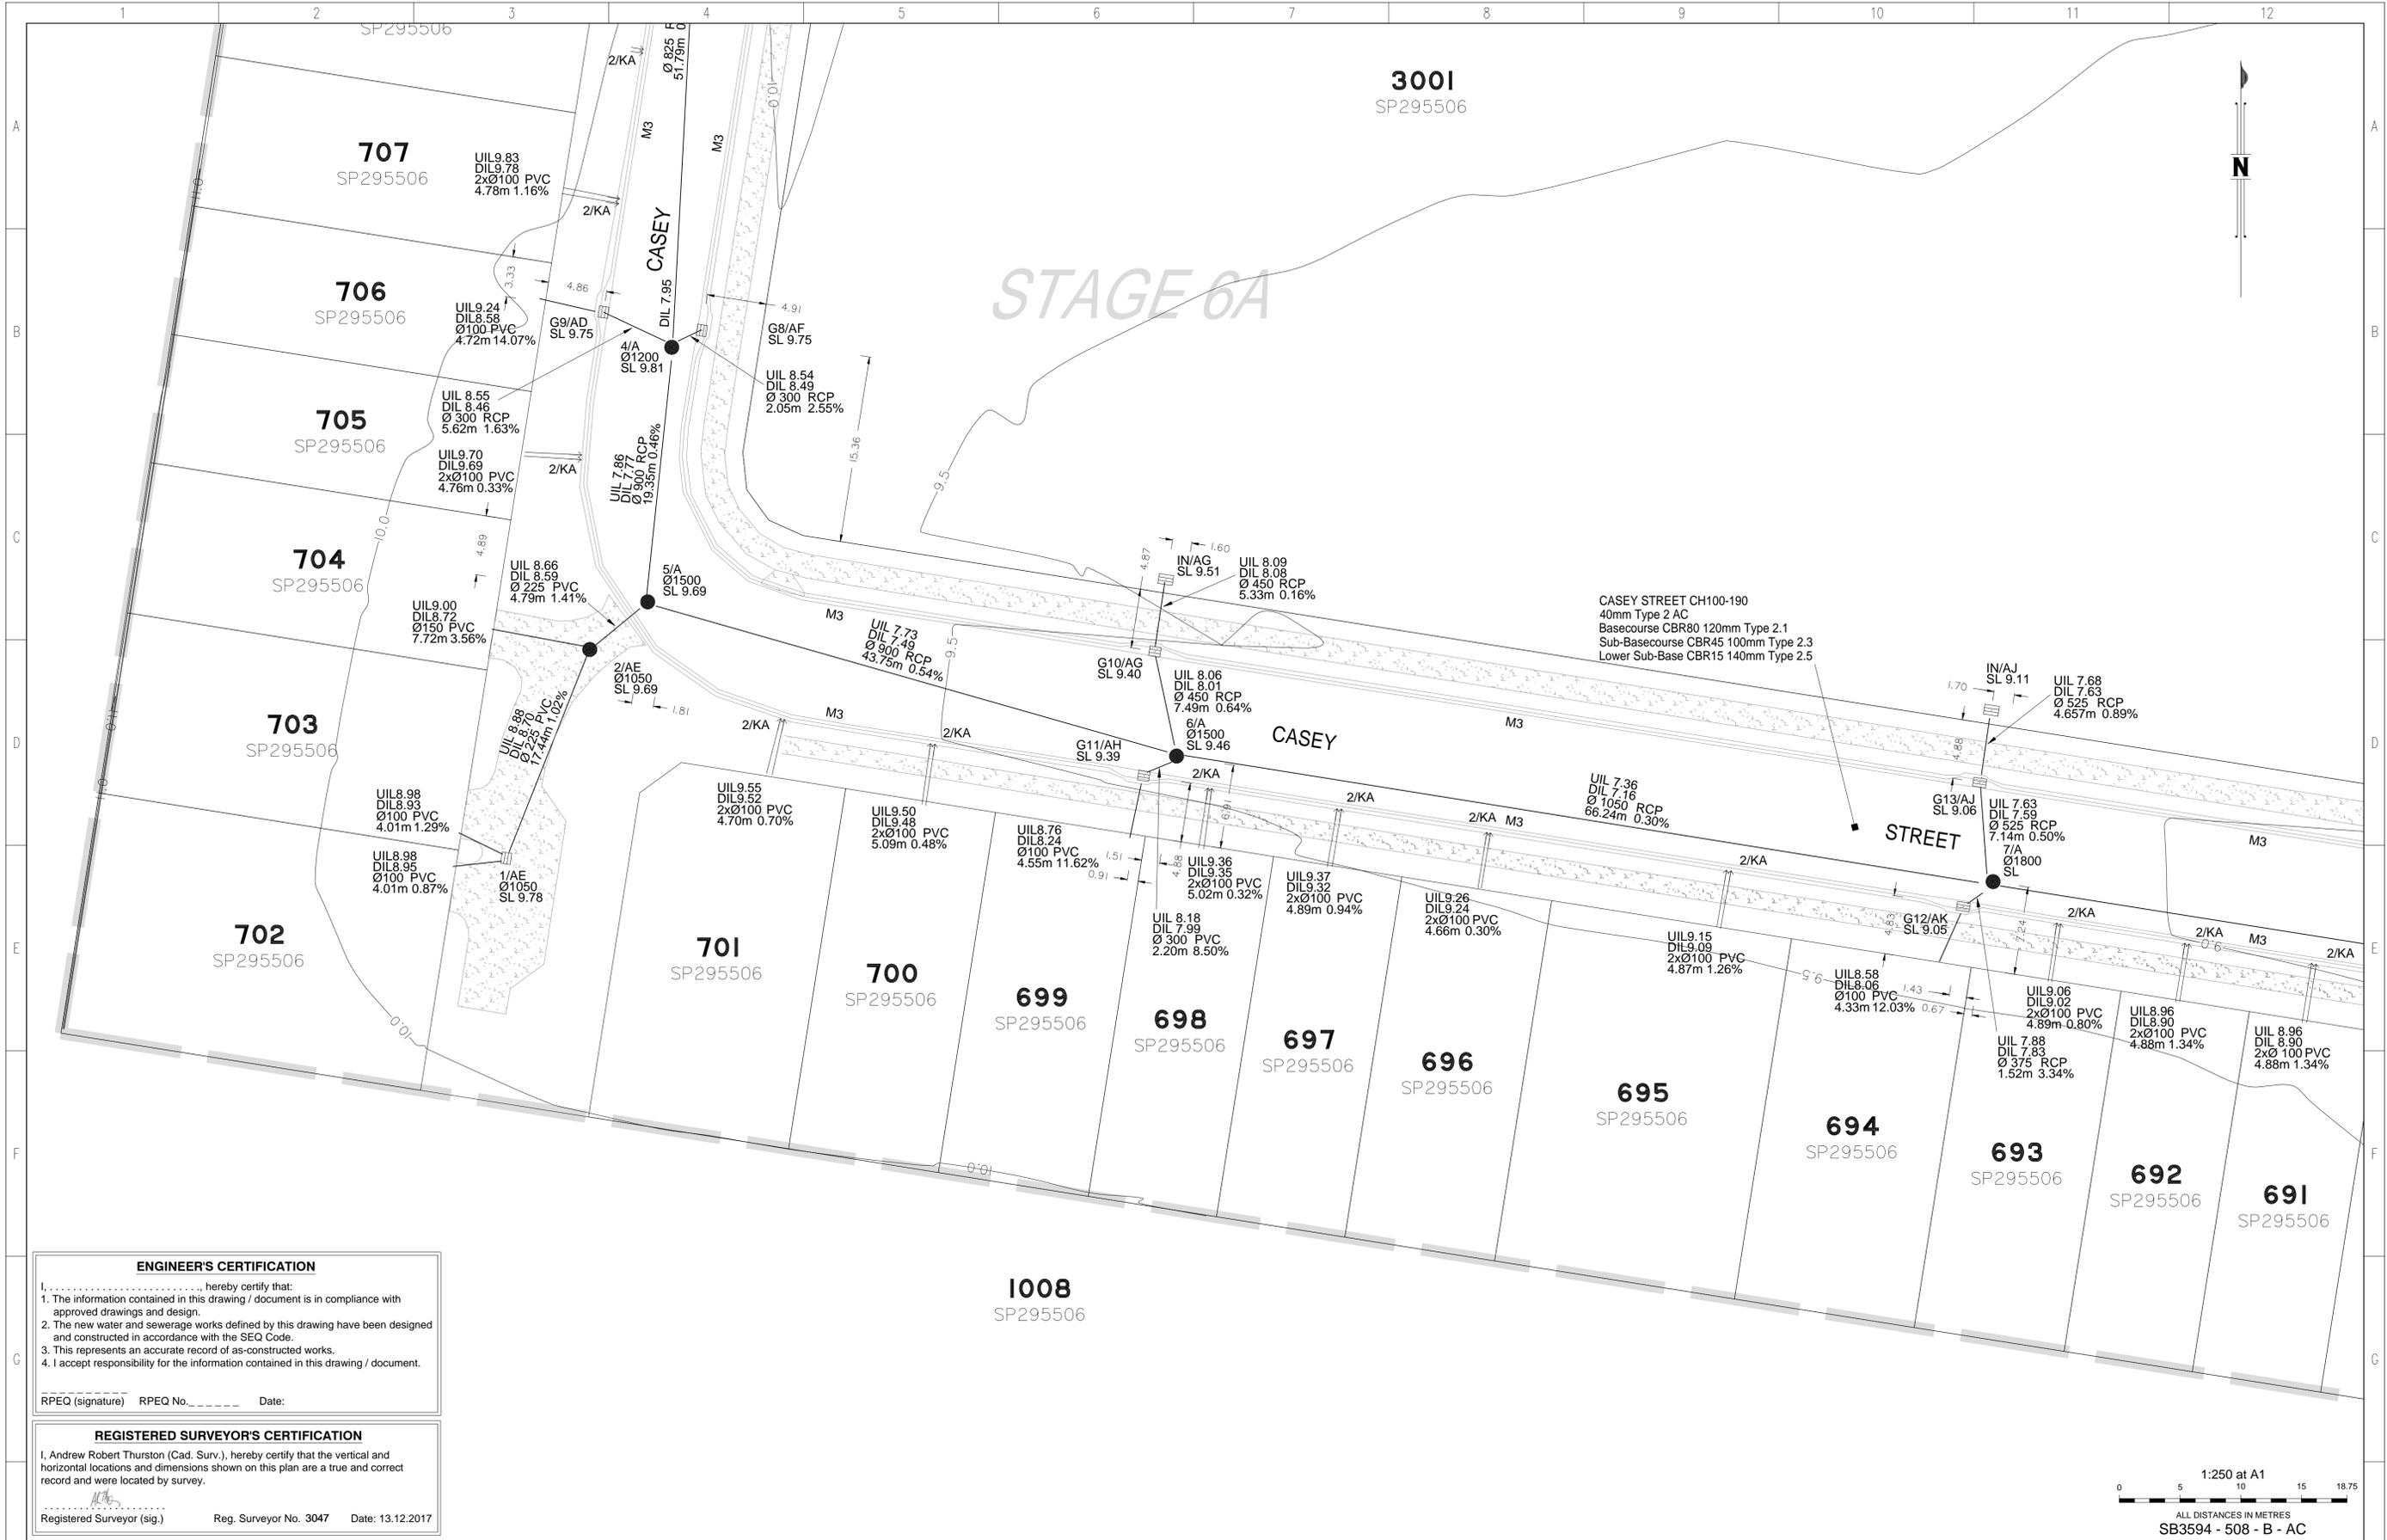

ENGINEER'S CERTIFICATION
 I, _____, hereby certify that:
 1. The information contained in this drawing / document is in compliance with approved drawings and design.
 2. The new water and sewerage works defined by this drawing have been designed and constructed in accordance with the SEQ Code.
 3. This represents an accurate record of as-constructed works.
 4. I accept responsibility for the information contained in this drawing / document.
 RPEQ (signature) RPEQ No. _____ Date: _____

REGISTERED SURVEYOR'S CERTIFICATION
 I, Andrew Robert Thurston (Cad. Surv.), hereby certify that the vertical and horizontal locations and dimensions shown on this plan are a true and correct record and were located by survey.

 Registered Surveyor (sig.) Reg. Surveyor No. 3047 Date: 13.12.2017

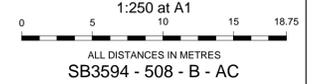

DRAWING REVISIONS		REFERENCE DRAWINGS		DESIGN FILE No.	DESIGNED	
REV.	REVISION DESCRIPTION	DRG. No.	DESCRIPTION	CONSTRUCT. No.	DATE	
A	PRELIMINARY ISSUE				01.12.2017	JC
B	AS CONSTRUCTED					ADH
					01.12.2017	

THIS WORK WAS PREPARED BY:

 Planning Urban Design Landscape Environment Surveying
 Brisbane Level 2, 1 Breakfast Ct Road, Newstead, QLD 4056. Phone: 07 5566 5000

SCALE 1:250 ORIGINAL SIZE A1

MORETON BAY REGIONAL COUNCIL
 CABOOLTURE DISTRICT OFFICE
 2 HASKING STREET CABOOLTURE QLD 4510
 PO BOX 159 CABOOLTURE QLD 4510
 Telephone: (07) 5433 0100
 Fax: (07) 5433 4000

RIVERBANK ESTATE
 STAGE 6A
 AS CONSTRUCTED
 ROADS AND DRAINAGE

CSC SUBDIVISION REFERENCE	
DA/30466/2015/V3RM	
No. 2 OF 4 PLANS	
ASCAN GRID NUMBER	REV.
-	B

STAGE 6A

3002
SP295506

3001
SP295506

CATTLE DRIVE
40mm Type 2 AC
Basecourse CBR80 140mm Type 2.1
Sub-Basecourse CBR45 100mm Type 2.3
Lower Sub-Base CBR15 100mm Type 2.5

684
SP295506

1008
SP295506

685
SP295506

686
SP295506

687
SP295506

693
SP295506

692
SP295506

691
SP295506

690
SP295506

689
SP295506

688
SP295506

EMT FA
SP295506

IN/AJ
SL 9.11
UIL 7.68
DIL 7.63
Ø 525 RCP
4.657m 0.89%

G13/AJ
SL 9.06
UIL 7.63
DIL 7.59
Ø 525 RCP
7.14m 0.50%

UIL 7.14
DIL 7.12
Ø 675 RCP
5.05m 0.43%

UIL 7.29
DIL 6.83
Ø 525 RCP
78.75m 0.56%

UIL 9.13
DIL 9.10
2xØ 100 PVC
4.81m 0.56%

UIL 7.14
DIL 6.92
Ø 1050 RCP
71.13m 0.32%

UIL 7.08
DIL 7.04
Ø 750 RCP
6.72m 0.63%

UIL 9.18
DIL 9.16
2xØ 100 PVC
4.82m 0.47%

UIL 9.06
DIL 9.02
2xØ 100 PVC
4.89m 0.80%

UIL 8.96
DIL 8.90
2xØ 100 PVC
4.88m 1.34%

UIL 8.96
DIL 8.90
2xØ 100 PVC
4.88m 1.34%

UIL 8.85
DIL 8.80
2xØ 100 PVC
4.75m 0.99%

UIL 8.79
DIL 8.77
2xØ 100 PVC
4.78m 0.29%

UIL 8.17
DIL 7.29
Ø 100 PVC
5.60m 16.02%

UIL 7.21
DIL 7.20
Ø 750 RCP
1.16m 1.11%

UIL 6.89
DIL 6.84
2xØ 1050 RCP
6.90m 0.23%


UIL 9.12
DIL 9.08
2xØ 100 PVC
4.82m 0.79%

UIL 6.79
DIL 6.65
Ø 1500 RCP
58.87m 0.24%

UIL 9.01
DIL 8.98
2xØ 100 PVC
4.77m 0.63%

ENGINEER'S CERTIFICATION
I, _____, hereby certify that:
1. The information contained in this drawing / document is in compliance with approved drawings and design.
2. The new water and sewerage works defined by this drawing have been designed and constructed in accordance with the SEQ Code.
3. This represents an accurate record of as-constructed works.
4. I accept responsibility for the information contained in this drawing / document.
RPEQ (signature) RPEQ No. _____ Date: _____

REGISTERED SURVEYOR'S CERTIFICATION
I, Andrew Robert Thurston (Cad. Surv.), hereby certify that the vertical and horizontal locations and dimensions shown on this plan are a true and correct record and were located by survey.
Registered Surveyor (sig.) Reg. Surveyor No. 3047 Date: 13.12.2017

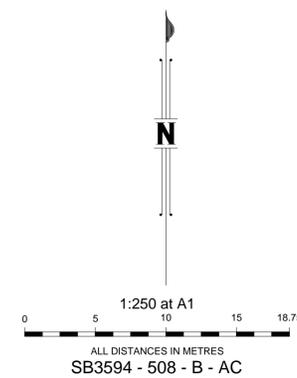

DRAWING REVISIONS		REFERENCE DRAWINGS		DESIGN FILE No.		DESIGNED	
REV.	REVISION DESCRIPTION	DRG. No.	DESCRIPTION	CONSTRUCT. No.	Ref	DATE	DATE
A	PRELIMINARY ISSUE					01.12.2017	JC
B	AS CONSTRUCTED					01.12.2017	ADH
						01.12.2017	


THIS WORK WAS PREPARED BY:

 WOLTER consulting group
 Planning Urban Design Landscape Environment Surveying
 Brisbane Level 2, 1 Breakfast Ct Road, Newstead, QLD 4056 Phone: (07) 5666 5300
 SCALE 1:250 ORIGINAL SIZE A1

MORETON BAY REGIONAL COUNCIL
 CABOOLTURE DISTRICT OFFICE
 2 HASKING STREET CABOOLTURE QLD 4510
 PO BOX 159 CABOOLTURE QLD 4510
 Telephone: (07) 5433 0100
 Fax: (07) 5433 4000

RIVERBANK ESTATE
 STAGE 6A
 AS CONSTRUCTED
 ROADS AND DRAINAGE

CSC SUBDIVISION REFERENCE	
DA/30466/2015/V3RM	
No. 3 OF 4 PLANS	
ASCAN GRID NUMBER	REV.
-	B

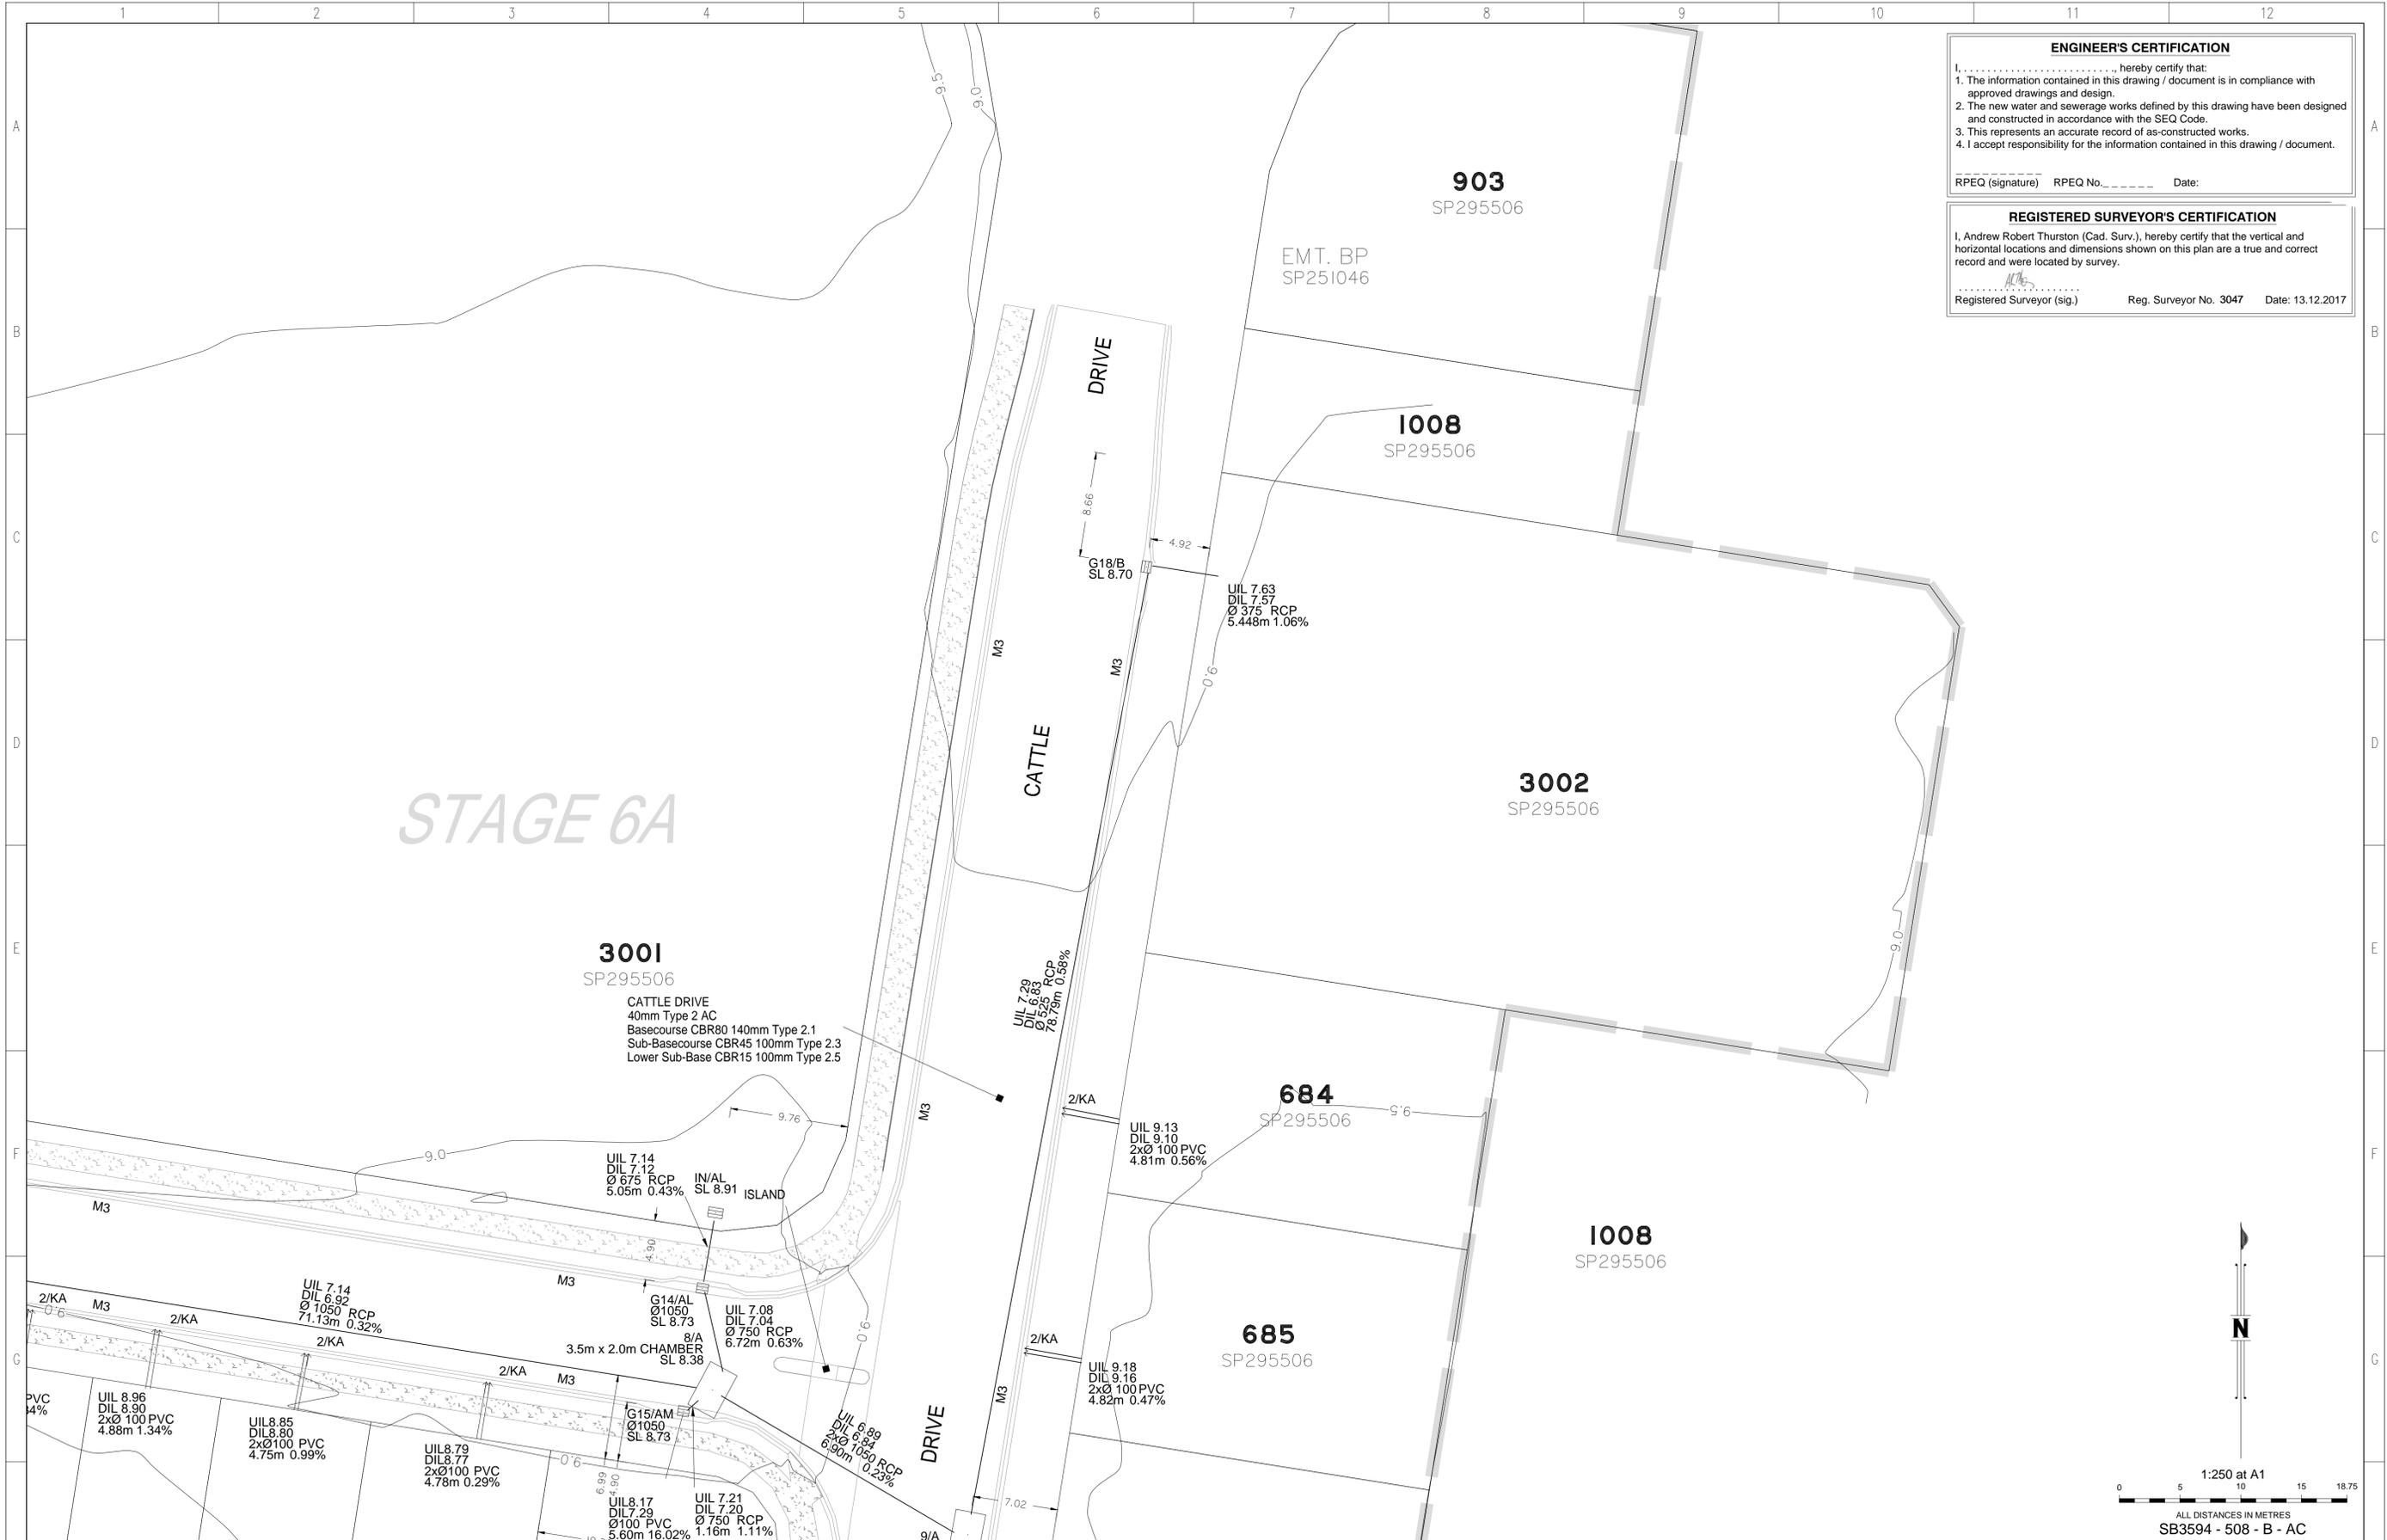

ENGINEER'S CERTIFICATION
 I,, hereby certify that:
 1. The information contained in this drawing / document is in compliance with approved drawings and design.
 2. The new water and sewerage works defined by this drawing have been designed and constructed in accordance with the SEQ Code.
 3. This represents an accurate record of as-constructed works.
 4. I accept responsibility for the information contained in this drawing / document.
 RPEQ (signature) RPEQ No. _____ Date: _____

REGISTERED SURVEYOR'S CERTIFICATION
 I, Andrew Robert Thurston (Cad. Surv.), hereby certify that the vertical and horizontal locations and dimensions shown on this plan are a true and correct record and were located by survey.
 Registered Surveyor (sig.) _____ Reg. Surveyor No. 3047 Date: 13.12.2017

STAGE 6A

3001
 SP295506
 CATTLE DRIVE
 40mm Type 2 AC
 Basecourse CBR80 140mm Type 2.1
 Sub-Basecourse CBR45 100mm Type 2.3
 Lower Sub-Base CBR15 100mm Type 2.5

903
 SP295506
 EMT. BP
 SP251046

1008
 SP295506

3002
 SP295506

684
 SP295506

1008
 SP295506

685
 SP295506

DRAWING REVISIONS		REFERENCE DRAWINGS		DESIGN FILE No.		DESIGNED	
REV.	REVISION DESCRIPTION	DRG. No.	DESCRIPTION	CONSTRUCT. No.	Ref	DATE	DATE
A	PRELIMINARY ISSUE			SURVEY FILE No.		01.12.2017	JC
B	AS CONSTRUCTED			FIELD BOOK			ADH
				LOG BOOK			
				LEVEL DATUM	Lev. datum	01.12.2017	
				DATUM	Datum		

THIS WORK WAS PREPARED BY:

 WOLTER consulting group
 Planning Urban Design Landscape Environment Surveying
 1/1000 Level 2, 1 Brisbane Dr Road, Newstead, QLD 4056 Phone: (07) 3666 5330

SCALE 1:250 ORIGINAL SIZE A1



MORETON BAY REGIONAL COUNCIL
 CABOOLTURE DISTRICT OFFICE
 2 HASKING STREET CABOOLTURE QLD 4510
 PO BOX 159 CABOOLTURE QLD 4510
 Telephone: (07) 5433 0100
 Fax: (07) 5433 4000

RIVERBANK ESTATE
 STAGE 6A
 AS CONSTRUCTED
 ROADS AND DRAINAGE

CSC SUBDIVISION REFERENCE	
DA/30466/2015/V3RM	
No. 4 OF 4 PLANS	
ASCAN GRID NUMBER	REV.
-	B