






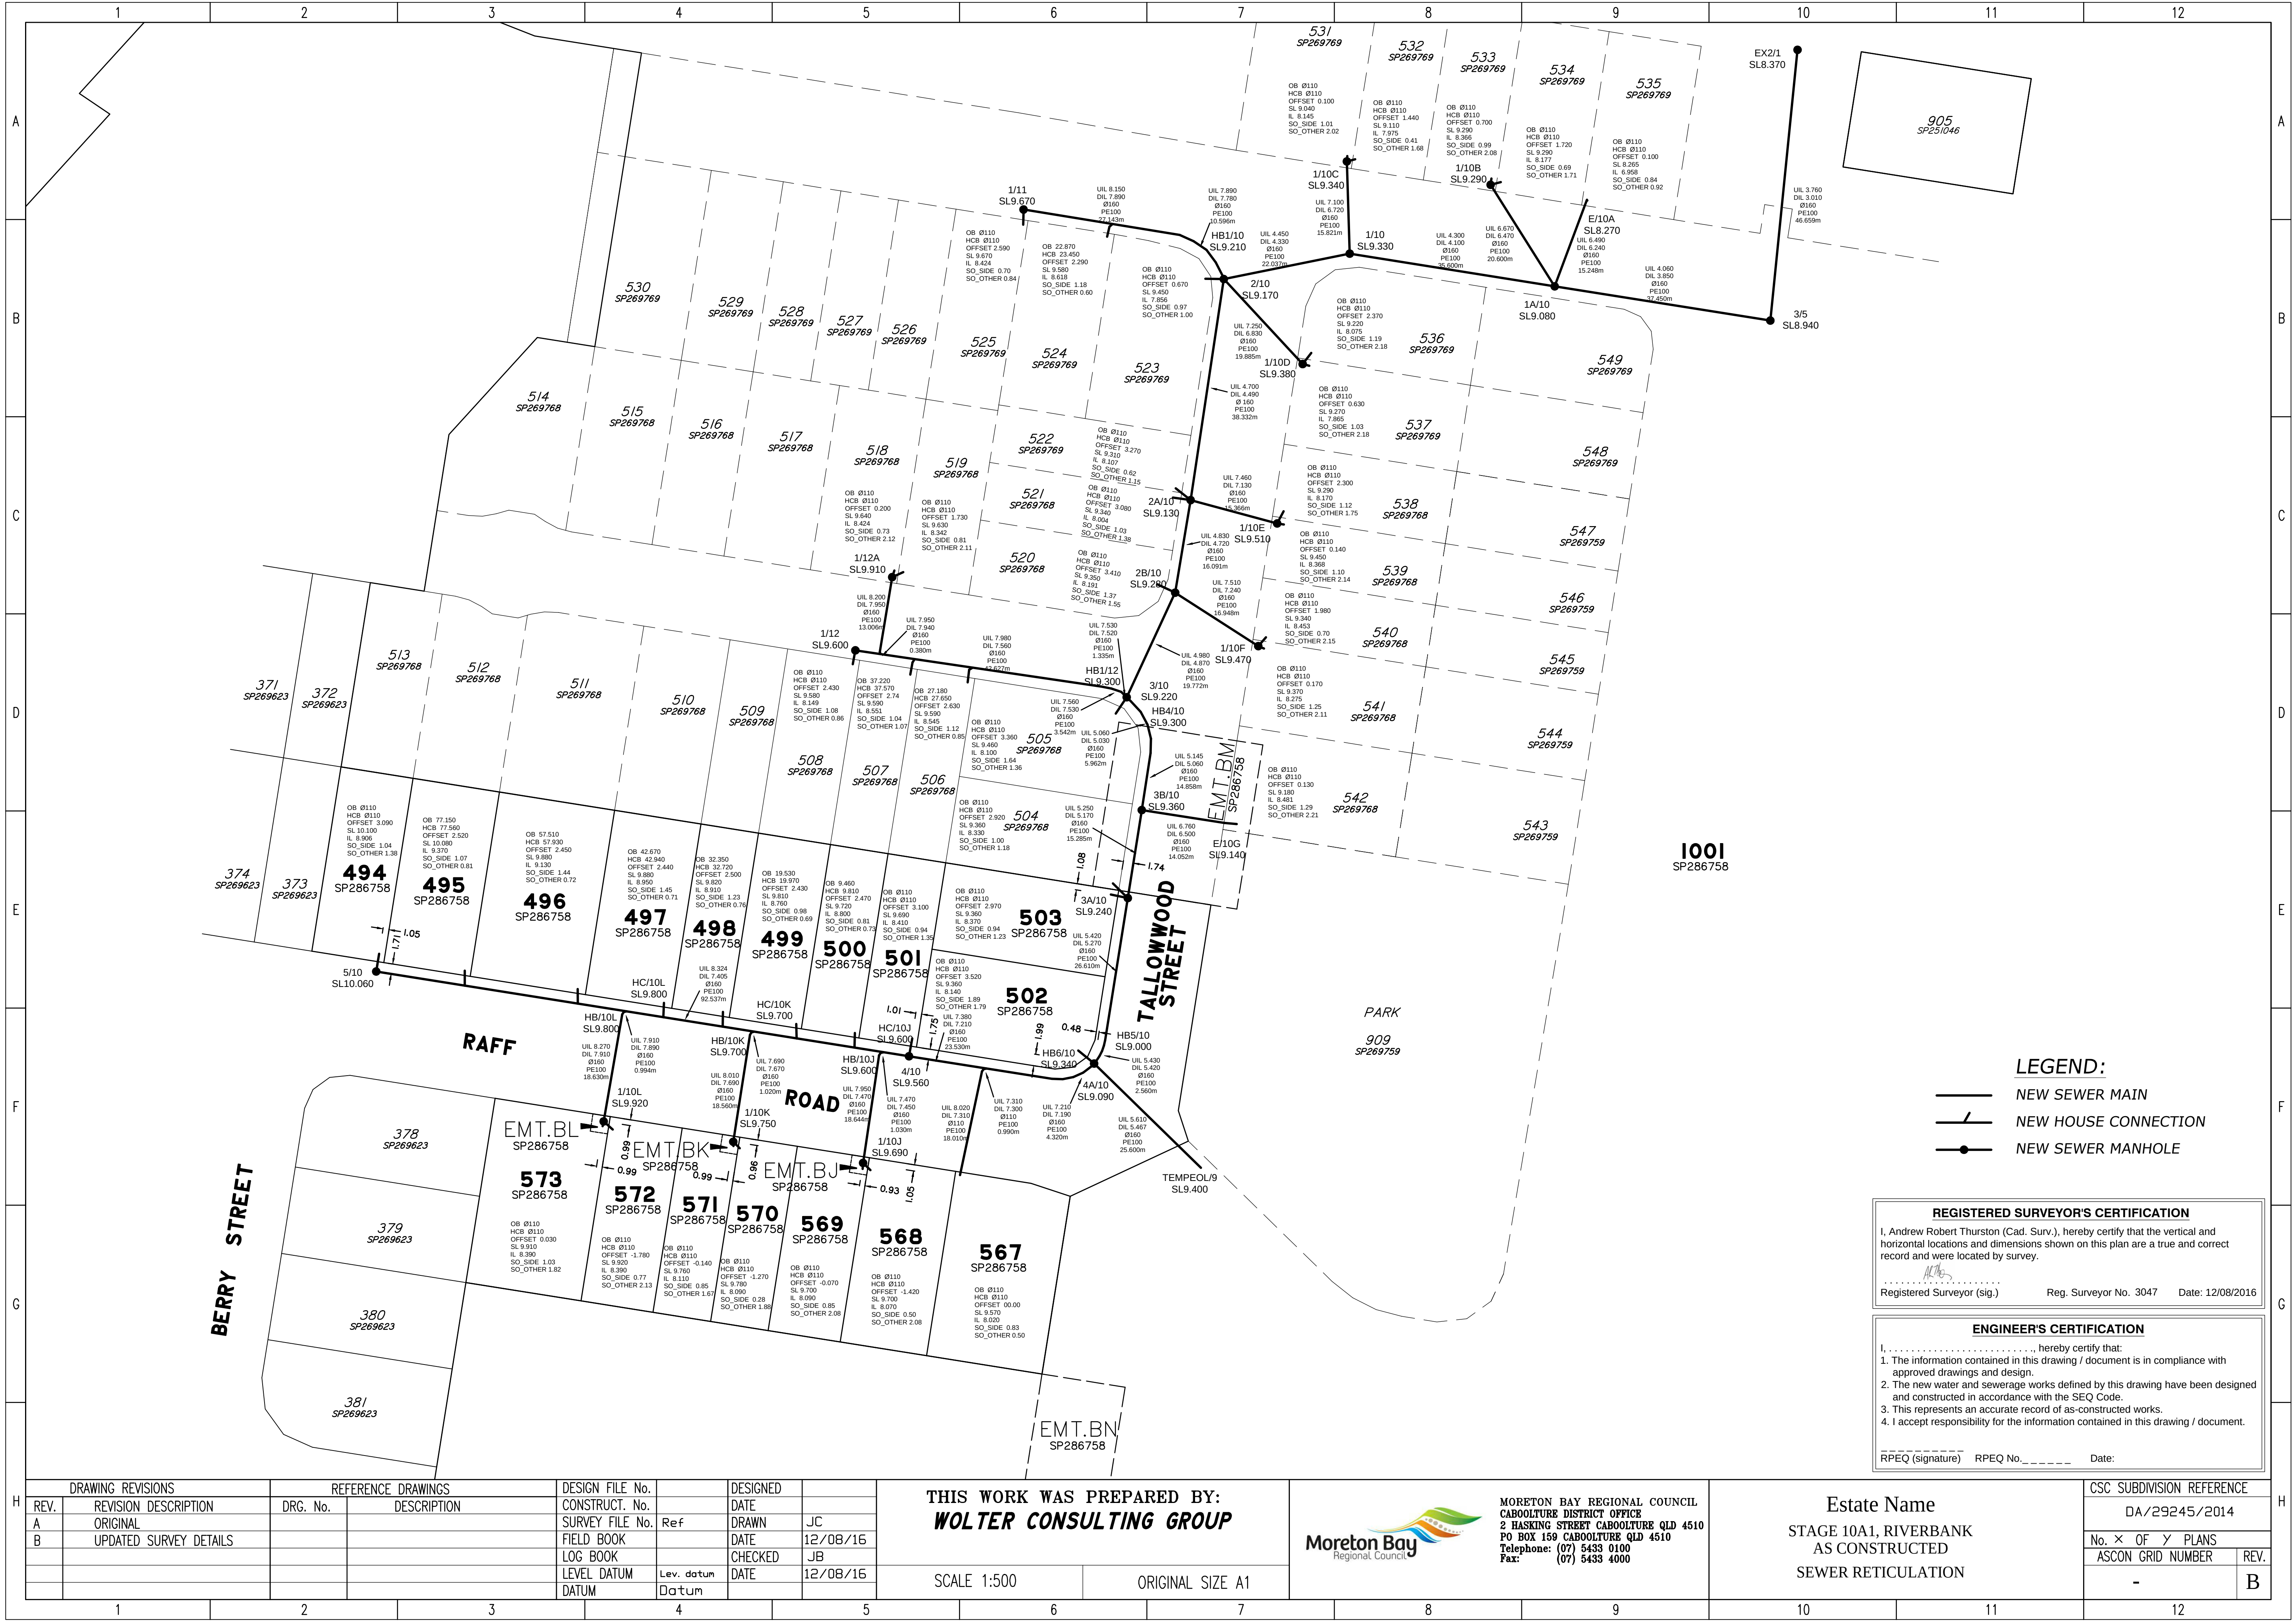

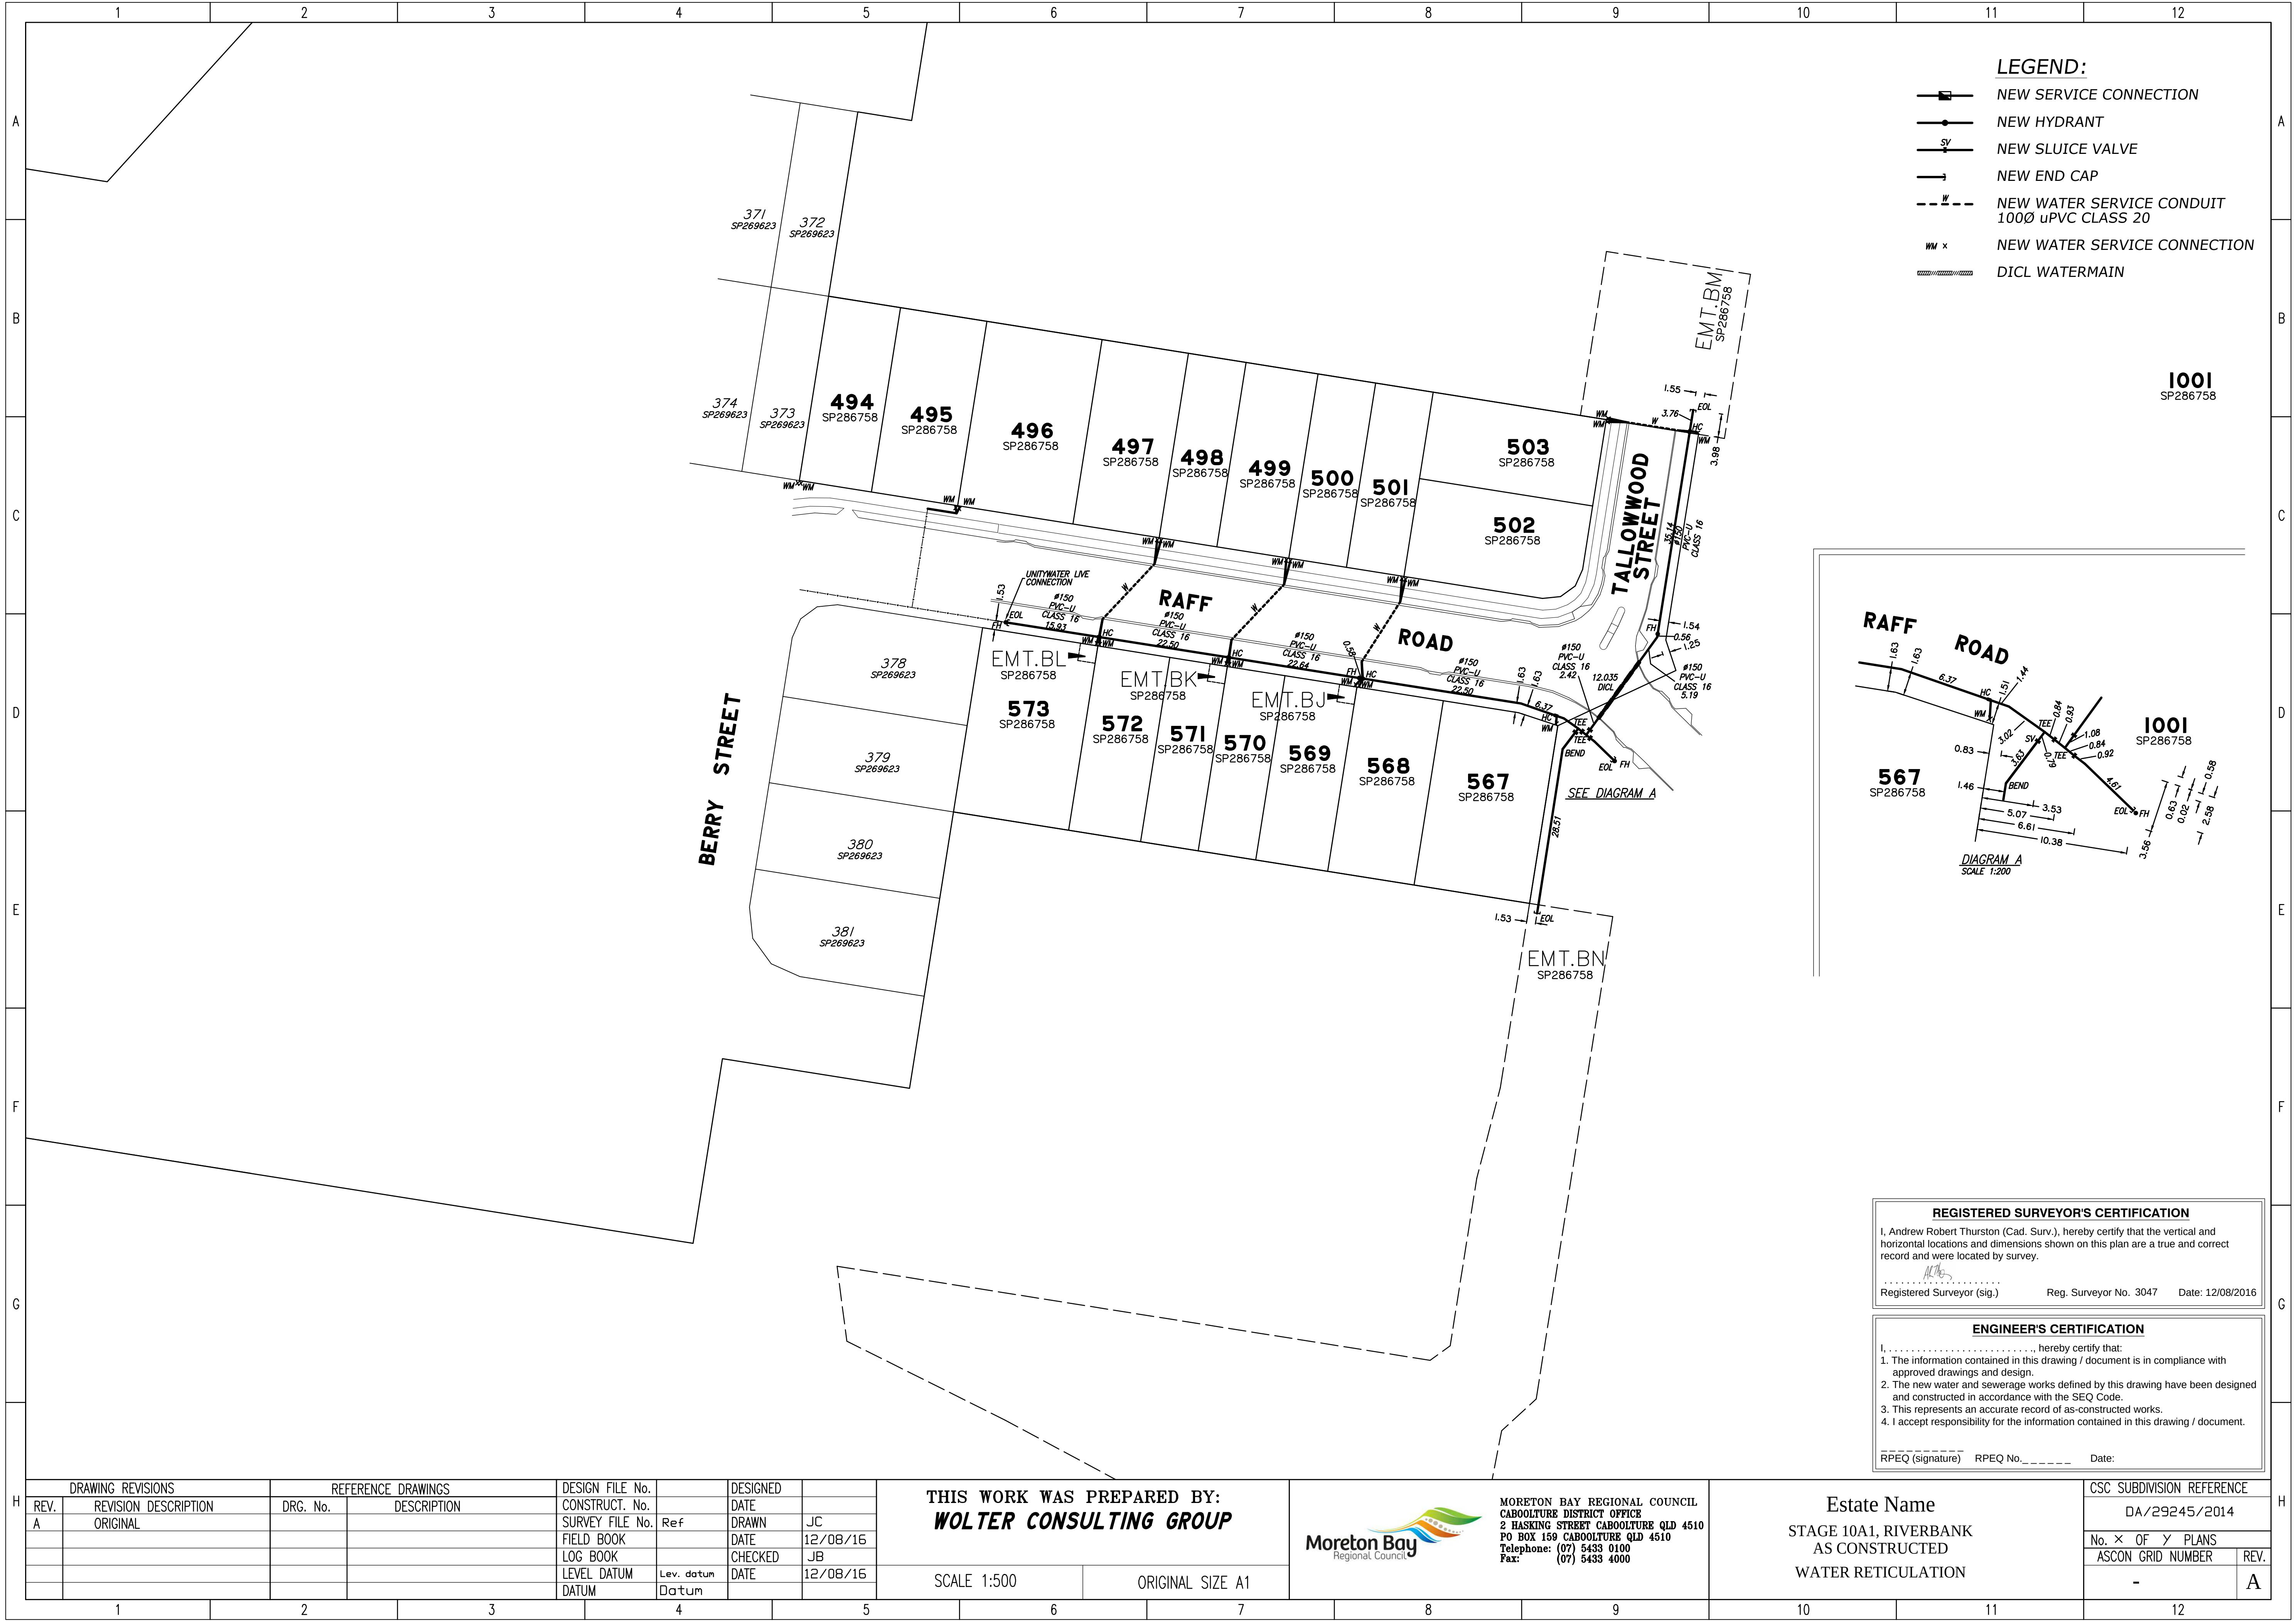

- LEGEND:**
- NEW SERVICE CONNECTION
  - NEW HYDRANT
  - NEW SLUICE VALVE
  - NEW END CAP
  - NEW WATER SERVICE CONDUIT 100Ø uPVC CLASS 20
  - NEW WATER SERVICE CONNECTION
  - DICL WATERMAIN

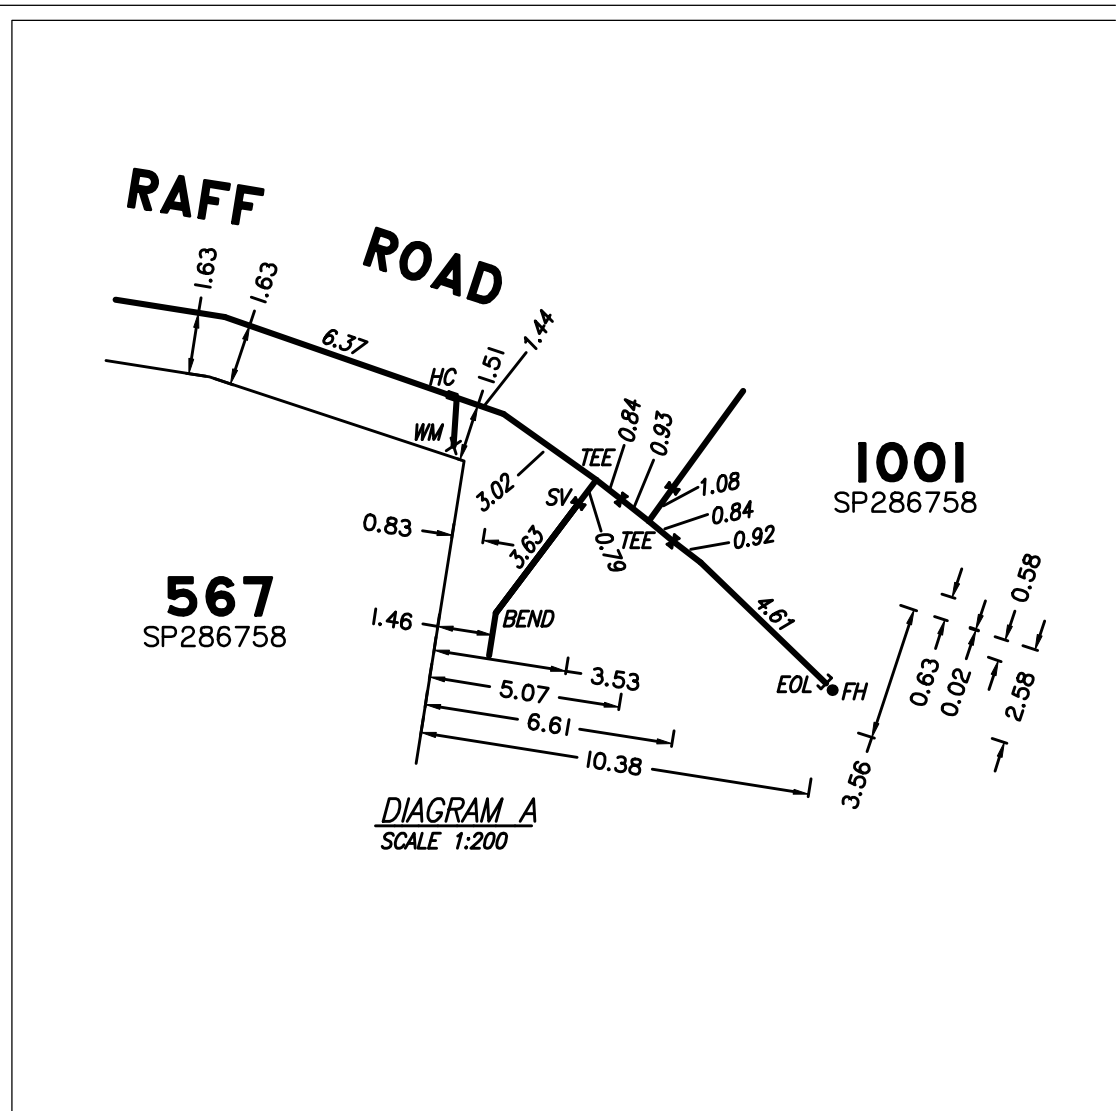

**REGISTERED SURVEYOR'S CERTIFICATION**

I, Andrew Robert Thurston (Cad. Surv.), hereby certify that the vertical and horizontal locations and dimensions shown on this plan are a true and correct record and were located by survey.

Registered Surveyor (sig.) \_\_\_\_\_ Reg. Surveyor No. 3047 Date: 12/08/2016

**ENGINEER'S CERTIFICATION**

I, \_\_\_\_\_, hereby certify that:

- The information contained in this drawing / document is in compliance with approved drawings and design.
- The new water and sewerage works defined by this drawing have been designed and constructed in accordance with the SEQ Code.
- This represents an accurate record of as-constructed works.
- I accept responsibility for the information contained in this drawing / document.

RPEQ (signature) \_\_\_\_\_ RPEQ No. \_\_\_\_\_ Date: \_\_\_\_\_

| DRAWING REVISIONS |                      | REFERENCE DRAWINGS |             | DESIGN FILE No. |     | DESIGNED |          |
|-------------------|----------------------|--------------------|-------------|-----------------|-----|----------|----------|
| REV.              | REVISION DESCRIPTION | DRG. No.           | DESCRIPTION | CONSTRUCT. No.  | Ref | DATE     | JC       |
| A                 | ORIGINAL             |                    |             | SURVEY FILE No. |     | 12/08/16 |          |
|                   |                      |                    |             | LOG BOOK        |     | CHECKED  | JB       |
|                   |                      |                    |             | LEVEL DATUM     |     | DATE     | 12/08/16 |
|                   |                      |                    |             | DATUM           |     |          |          |

THIS WORK WAS PREPARED BY:  
**WOLTER CONSULTING GROUP**

SCALE 1:500 ORIGINAL SIZE A1



MORETON BAY REGIONAL COUNCIL  
CABOOLTURE DISTRICT OFFICE  
2 HASKING STREET CABOOLTURE QLD 4510  
PO BOX 159 CABOOLTURE QLD 4510  
Telephone: (07) 5433 0100  
Fax: (07) 5433 4000

Estate Name  
STAGE 10A1, RIVERBANK  
AS CONSTRUCTED  
WATER RETICULATION

| CSC SUBDIVISION REFERENCE |      |
|---------------------------|------|
| DA/29245/2014             |      |
| No. × OF Y PLANS          | REV. |
| ASCON GRID NUMBER         |      |
| -                         | A    |



