



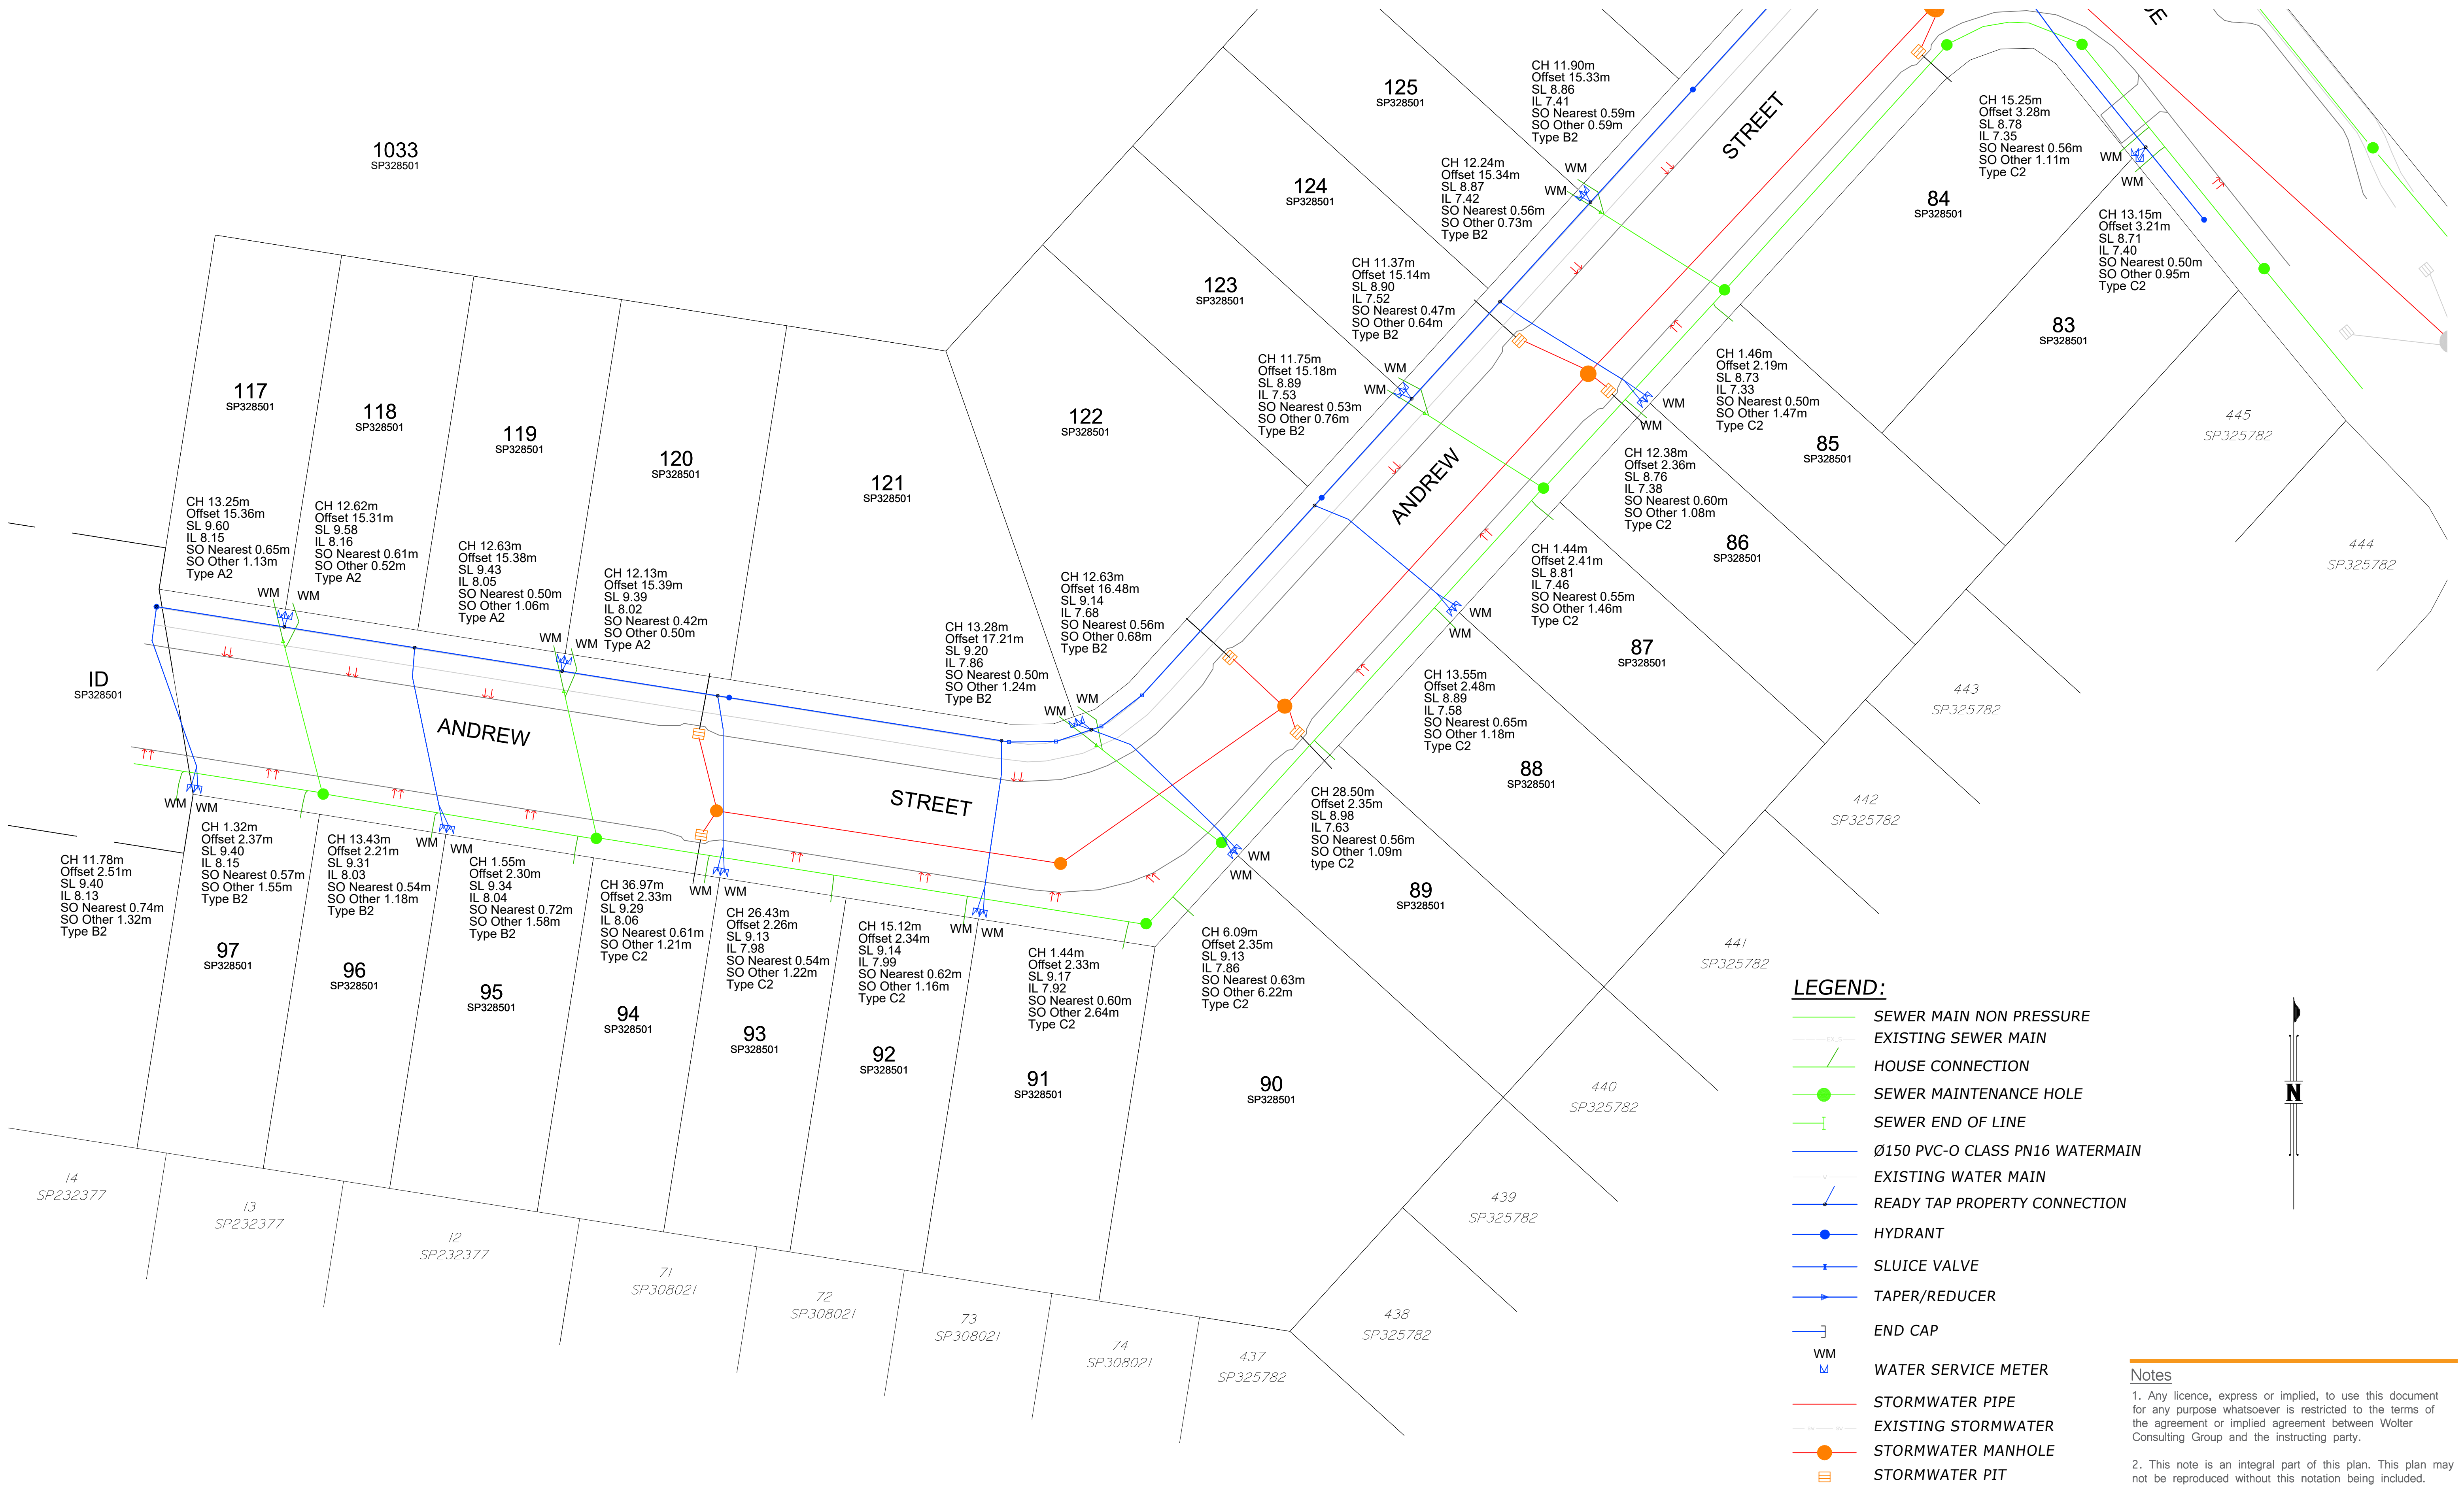

LEGEND:

- SEWER MAIN NON PRESSURE
- EXISTING SEWER MAIN
- HOUSE CONNECTION
- SEWER MAINTENANCE HOLE
- SEWER END OF LINE
- Ø150 PVC-O CLASS PN16 WATERMAIN
- EXISTING WATER MAIN
- READY TAP PROPERTY CONNECTION
- HYDRANT
- SLUICE VALVE
- TAPER/REDUCER
- END CAP
- WM
- WATER SERVICE METER
- STORMWATER PIPE
- EXISTING STORMWATER
- STORMWATER MANHOLE
- STORMWATER PIT

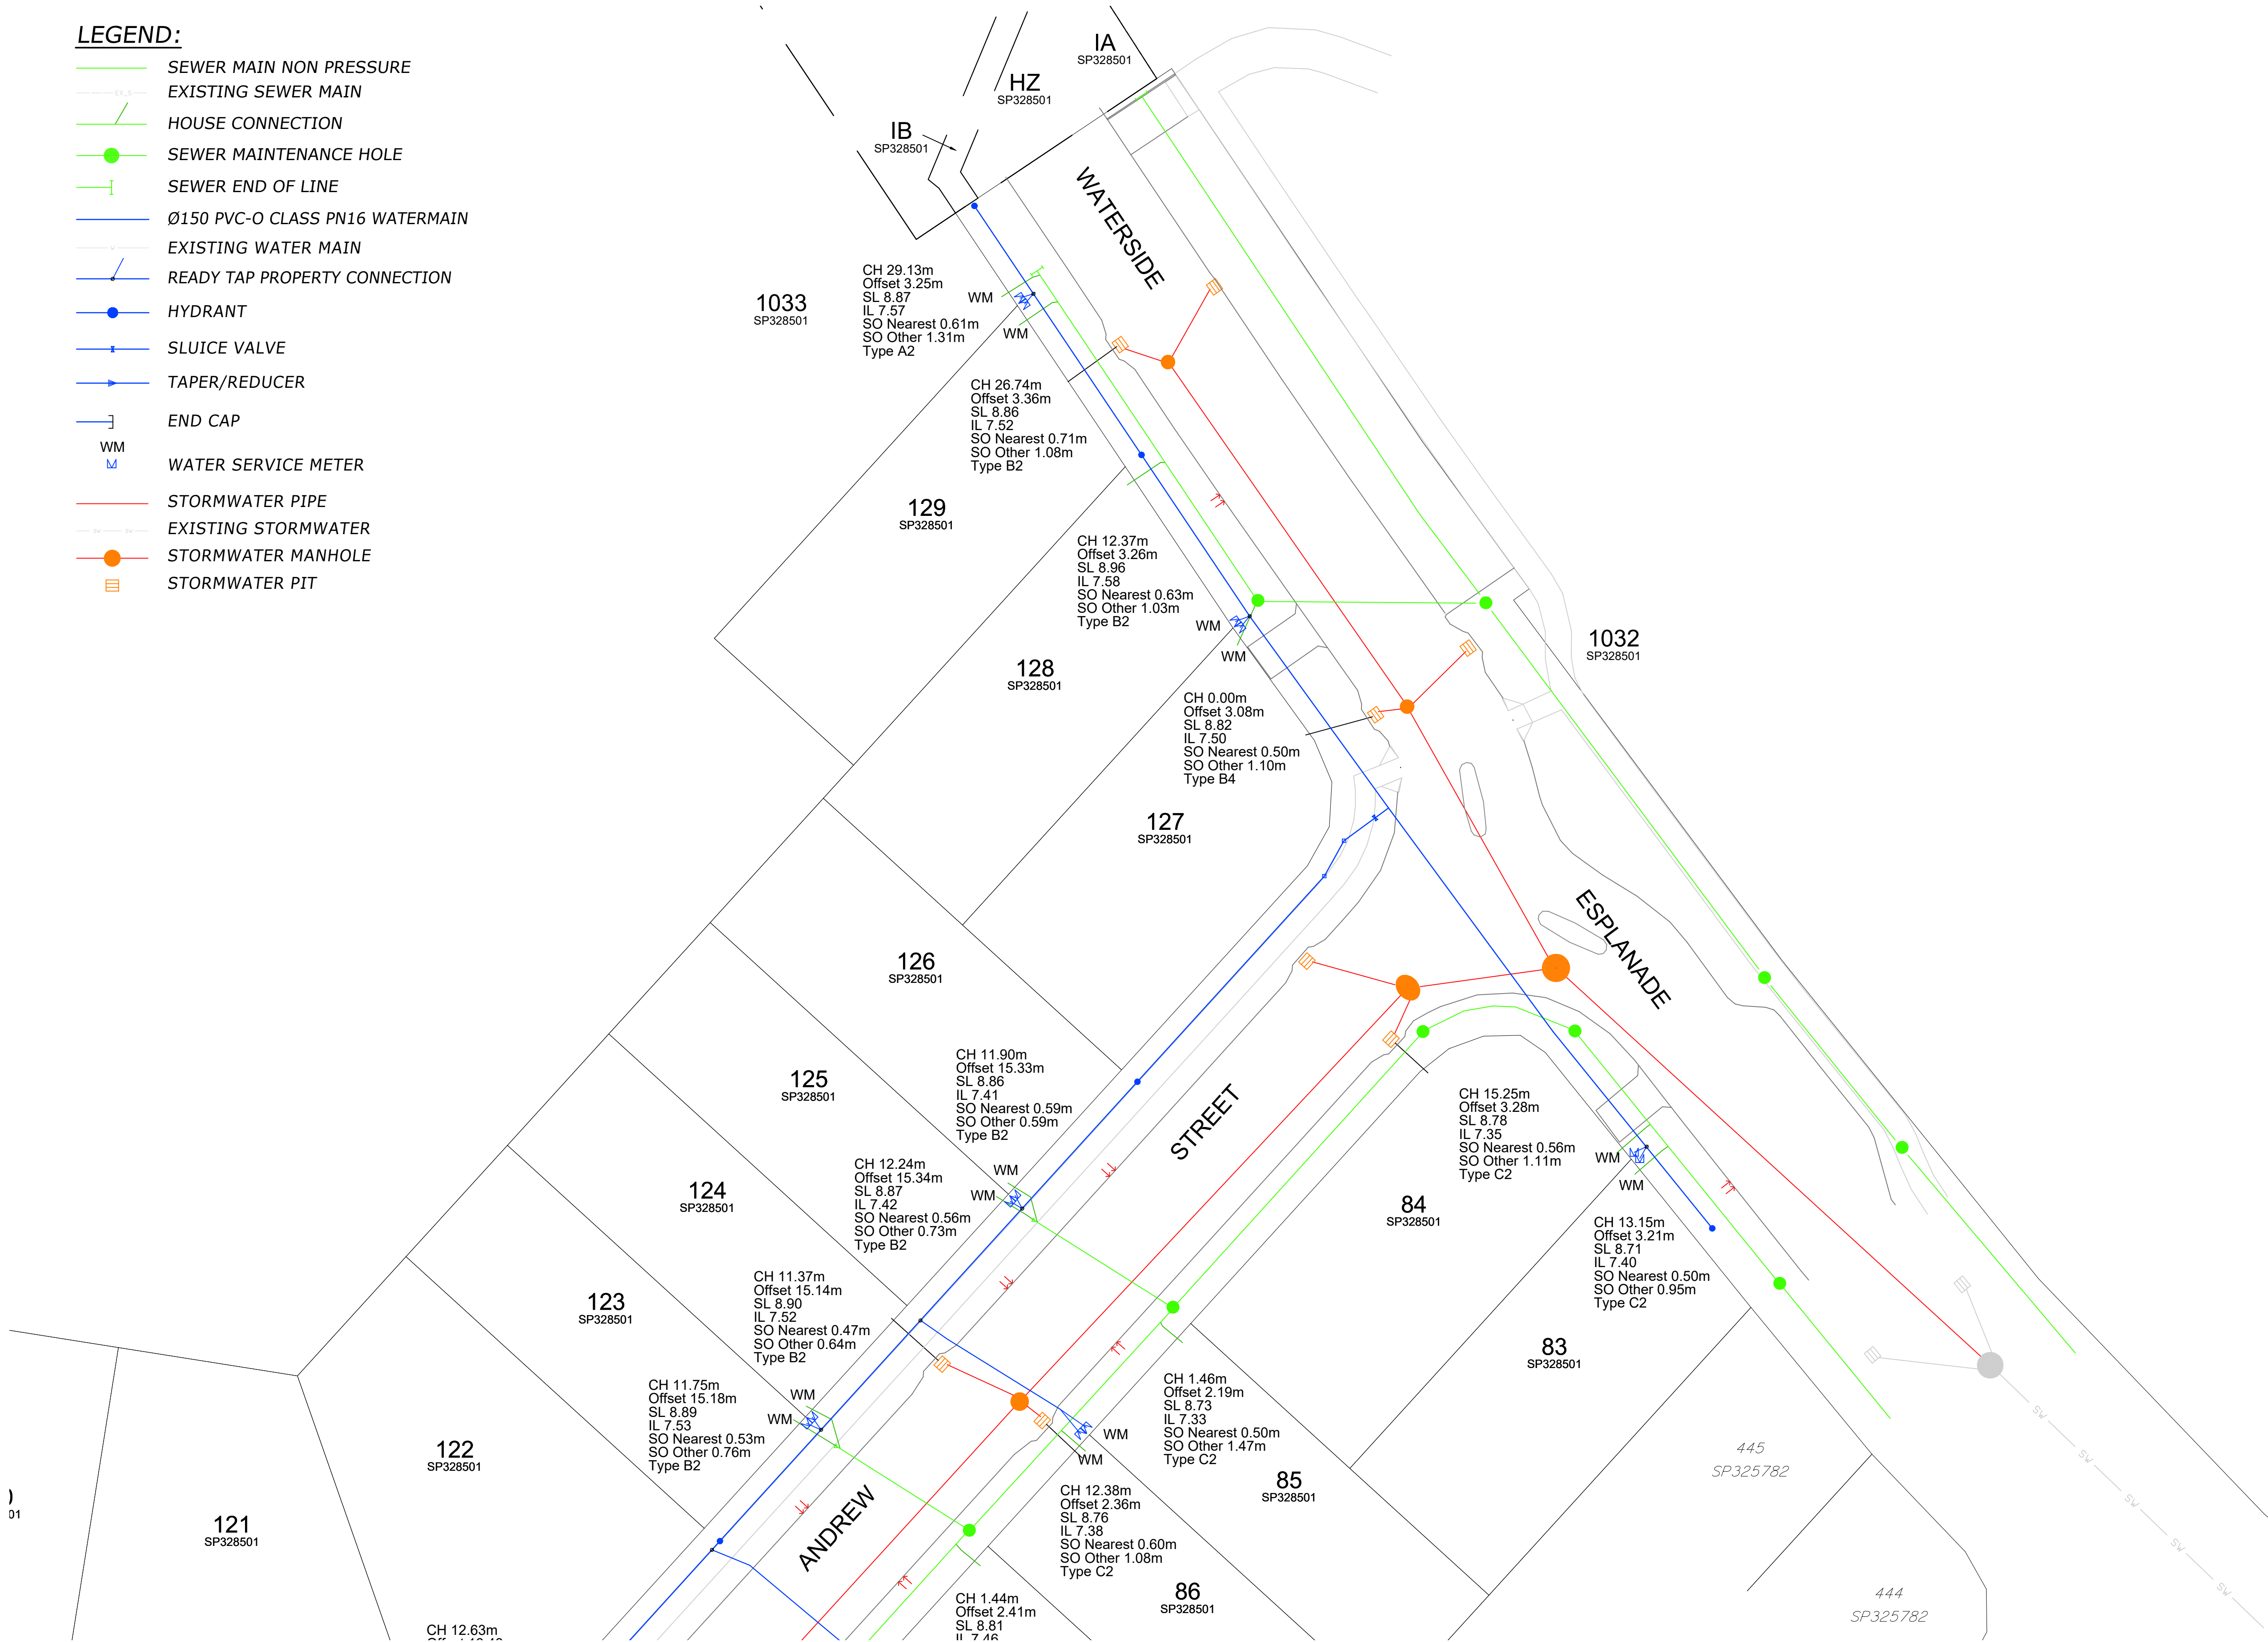

Notes

1. Any licence, express or implied, to use this document for any purpose whatsoever is restricted to the terms of the agreement or implied agreement between Wolter Consulting Group and the instructing party.

2. This note is an integral part of this plan. This plan may not be reproduced without this notation being included.



Planning Urban Design Landscape Environment Surveying

Scale 1:250 @ A1 - Lengths are in metres.

As Constructed Builders Issue
Market Drive, Cabbolture South
Local Authority Moreton Bay City

DRAWING NO. SB3594S/2B-101-AC-A
VERSION A

DATE DRAWN 17-11-2023
SHEET NO. 2 of 2