












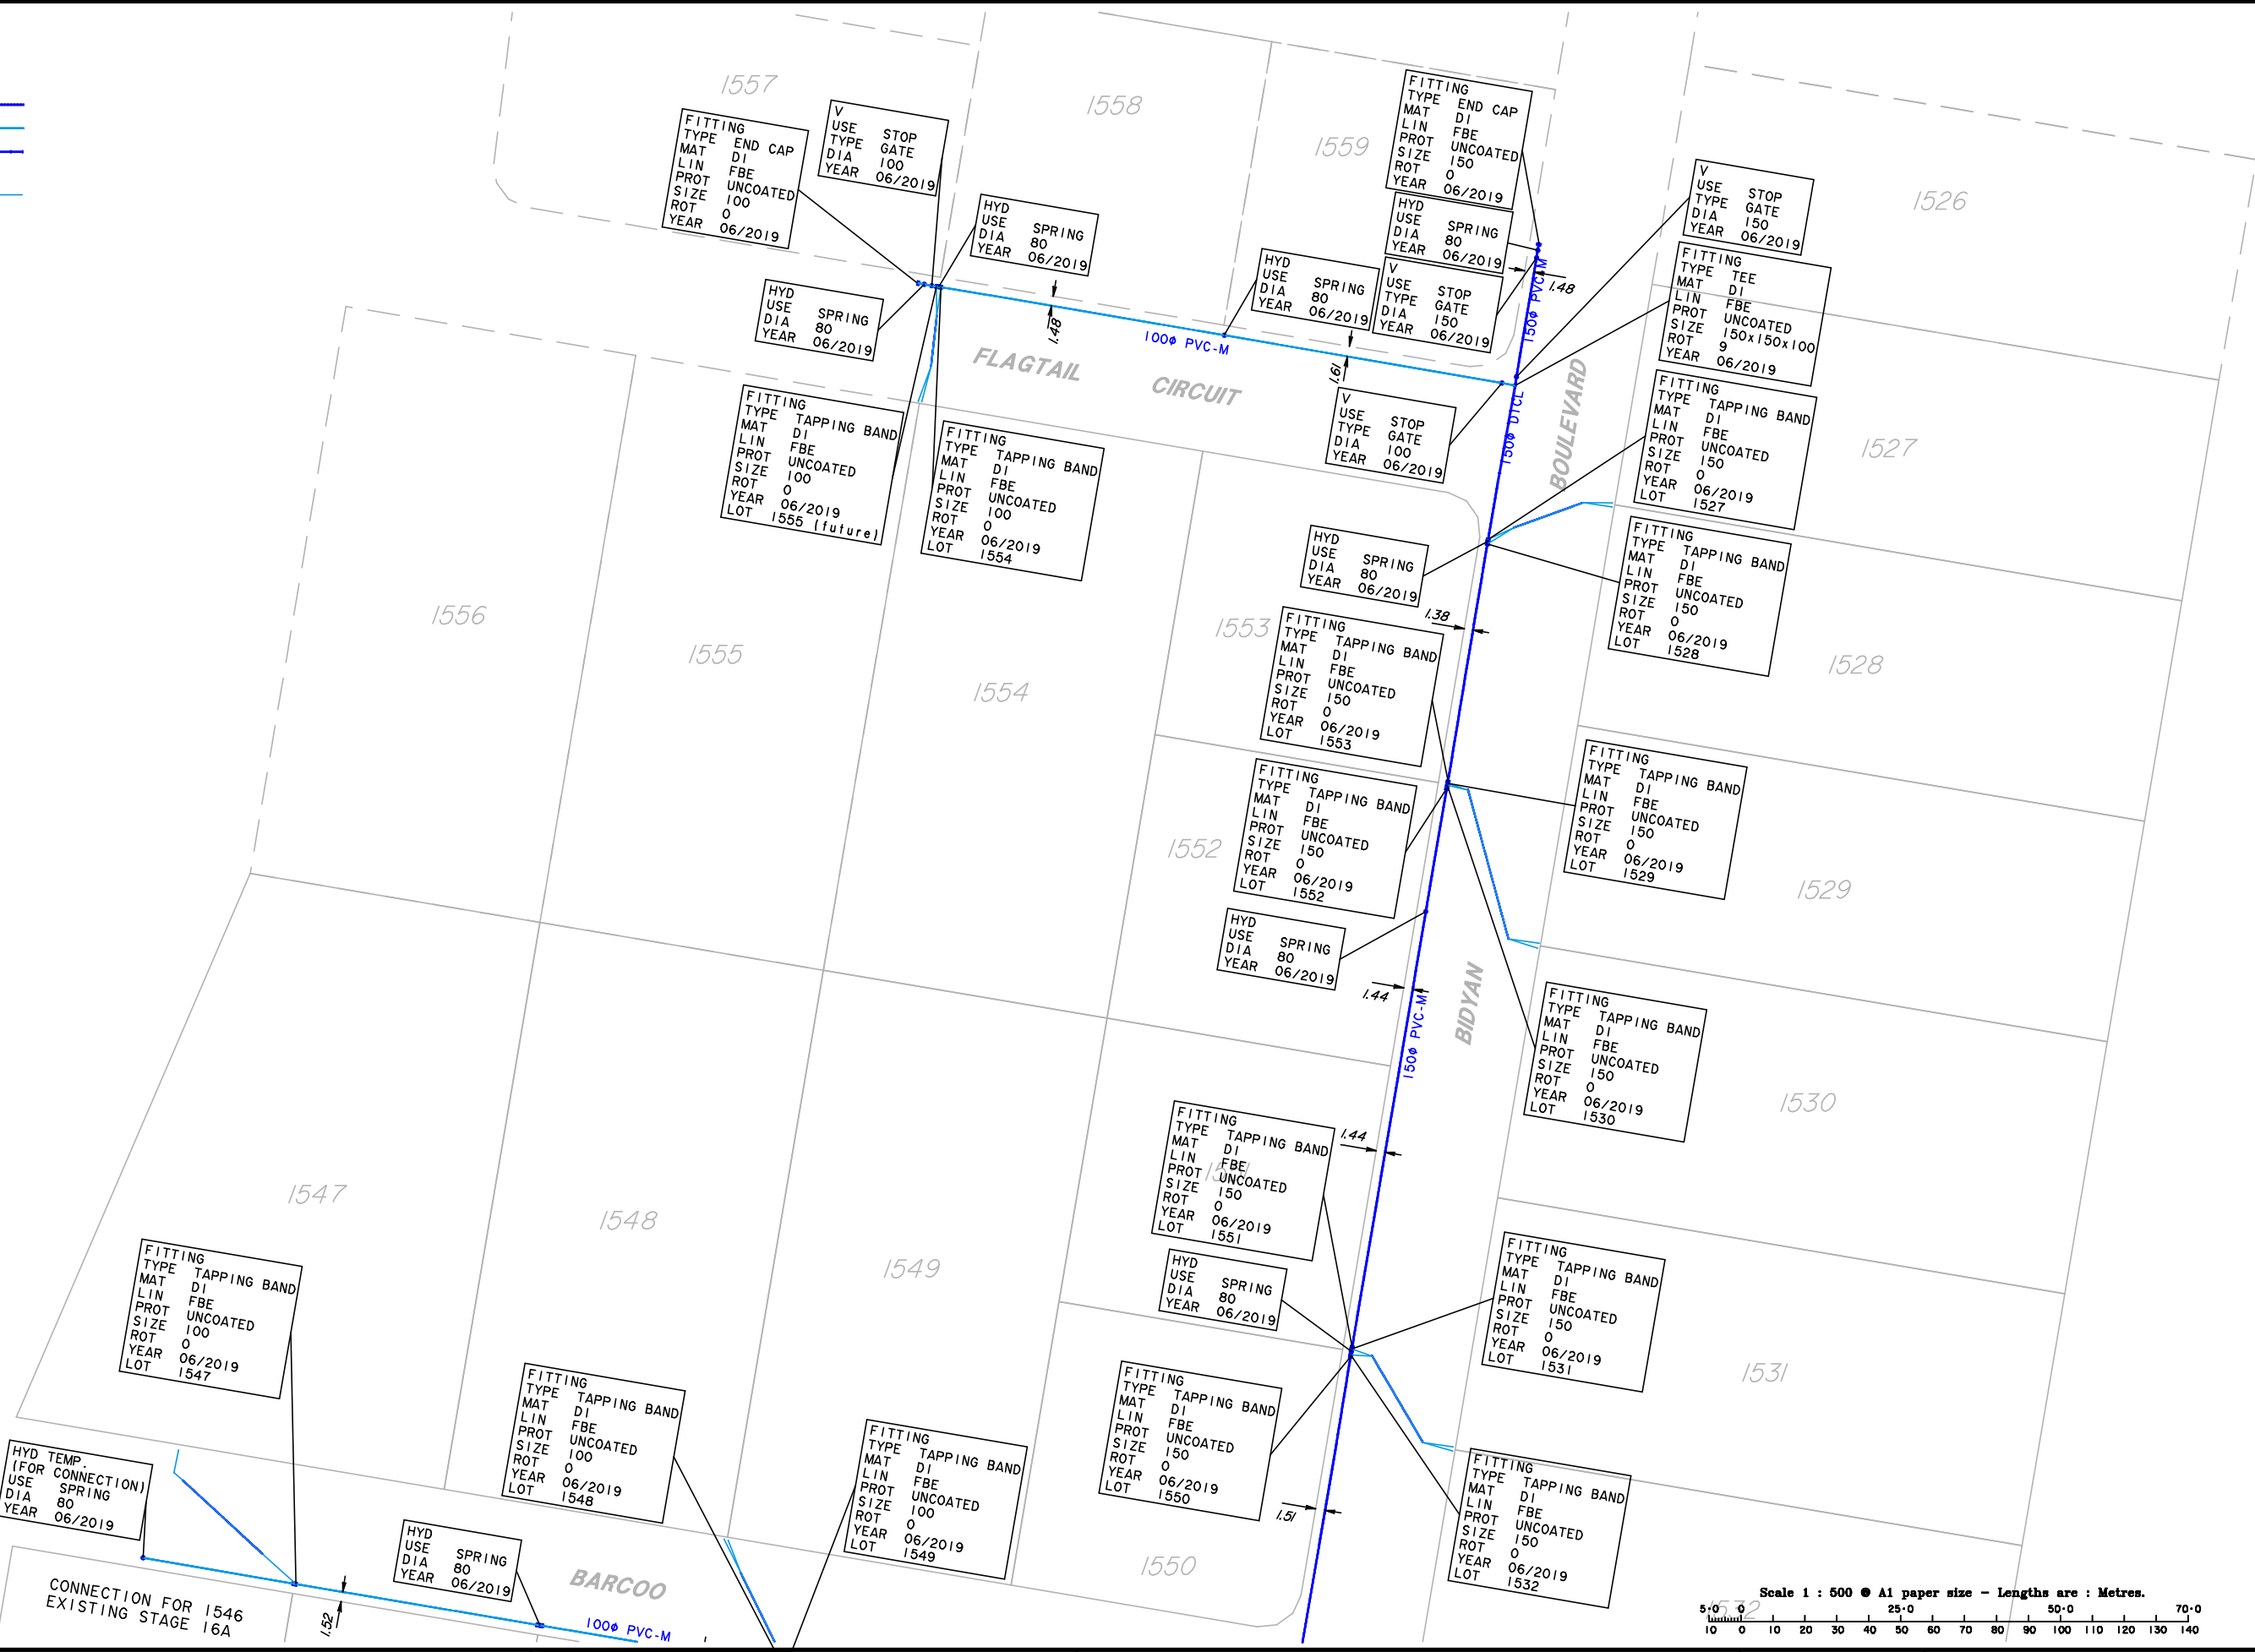


- LEGEND:**
- New Water 150 PVC-M CL16 
 - New Water 100 PVC-M CL16 
 - New Water 150 DICL PN35 
 - New Water 100 DICL PN35 
 - New Water 63 PE 
 - Fire Hydrant 
 - Stop Valve 
 - Tee Junction 
 - Pipe Reducer 
 - End Cap 
 - 11.25 Bend 
 - 22.5 Bend 
 - House Connection 

OOOEVTF@



Scale 1 : 500 @ A1 paper size - Lengths are : Metres.
 0 10 20 30 40 50 60 70 80 90 100 110 120 130 140

REVISIONS	DATE	BY	CHKD

IMPORTANT NOTE.
 This Plan has been prepared for Logan City Council for the purpose of recording the As Constructed details of a new service constructed under specific Council Approval and should not be used for any other purpose. No report is made on any other service/s, nor any service/s that may exist before or be constructed after, the time of survey, or constructed under any other approval. The property boundaries, easements and lot numbers shown hereon may be proposed only and subject to registration by the Department of Natural Resources & Mines. All property information should be determined from the registered Survey Plans.
 THIS NOTE IS AN INTEGRAL PART OF THIS PLAN.

SCHLENCKER SURVEYING (QLD)
 Queensland Surveyors, Engineers & Draftsmen
 Rockhampton Brisbane Gold Coast
 AGPS 20 000 000 001
 100 Years of
 Surveying
 1914-2014
 100 Years of
 Surveying
 1914-2014

Registered Surveyor's Certification :
 I, Bruce Victor DALTON hereby certify that the vertical and horizontal locations, and dimensions shown on this plan are a true and correct record of the As Constructed information.
 Signed Date 21/6/2019
 For and on behalf of Schlencker Surveying (Qld) Pty. Ltd.

Consulting Engineer's Certification :
 1. I state the works described on this drawing have been constructed under my supervision, and I or my authorised representatives have inspected the works at all stages of construction.
 2. I certify that the works have been constructed in accordance with the development approval, the approved drawings, the Logan Planning Scheme 2006 and any relevant planning scheme policies and standards specifications.
 :Signature Date

3. I certify the approved drawings have been carefully compared with the site works as to line, levels and dimensions, and this drawing has been accurately amended : all respects as to constitute a true record of the works.
 Project Name: SPRING MOUNTAIN STAGE 15A.....
 Company: KN.GROUP.PTY.LTD.....
 Consultant: GEOFFREY GREENHALGH.....
 RPEQ/CPENG Membership No.: 1988.....
 :Signature Date

SURVEYOR : PAN
 DRAWN BY : SPR
 JOB NO : 15159
 LOCAL AUTHORITY : LOGAN
 PARISH : STAPYLTON
 COUNTY : STANLEY
 LEVEL DATUM : AHD Der
 LEVEL ORIGIN : PM61324
 RL : 69.322

AS CONSTRUCTED WATER
 Spring Mountain Estate, Stage 15A
 GREENBANK
 OW / 334 / 2018
 RL / 44 / 2008 / E
 SCALE: 1:500 (A1)
 PLAN NO: 15159-68
 SHEET : 2 OF 2