



- LEGEND:**
- New Water
 - Existing water
 - Conduit 150 ϕ uPVC CL16
 - Fire Hydrant
 - Stop Valve
 - Tee Junction
 - Pipe Reducer
 - End Cap
 - 11.25 Bend
 - 22.5 Bend
 - 45 Bend
 - 90 Bend

Scale 1 : 500 @ A1 paper size - Lengths are : Metres.

<p>AS CONSTRUCTED WATER Spring Mountain Estate, Stage 11A GREENBANK RL / 94 / 2008 / A OW / 218 / 2010</p>		<p>SURVEYOR : PAN DRAWN BY : SPR LOCAL AUTHORITY : LOGAN PARISH : STANLEY COUNTY : STANLEY LEVEL DATUM : AHD Der LEVEL ORIGIN : RL98.148</p>		<p>SCALE: 1:500 (A1) PLAN NO: 14030-13</p>	
<p>3. I certify the approved drawings have been carefully checked and the dimensions and locations are correct and this drawing has been amended; all respects as to constitute a true record of the works.</p>		<p>Consulting Engineer's Certification: 1. I state the works described on this drawing have been constructed under my supervision, and I or my authorised representatives have inspected the works at all stages of construction. 2. I certify that the works have been constructed in accordance with the Logan Planning Scheme 2006 and any relevant planning scheme policies and standards specifications.</p>		<p>Project Name Consultant RPEQ/CPEng Membership No. Date Date Date</p>	
<p>REGISTERED SURVEYOR'S CERTIFICATION: Bruce Victor DALTON hereby certify that the vertical and horizontal locations, and dimensions shown on this plan are a true and correct record of the As Constructed information.</p>		<p>REGISTERED SURVEYOR'S CERTIFICATION: 1. I state the works described on this drawing have been constructed under my supervision, and I or my authorised representatives have inspected the works at all stages of construction. 2. I certify that the works have been constructed in accordance with the Logan Planning Scheme 2006 and any relevant planning scheme policies and standards specifications.</p>		<p>Signed Date Date Date</p>	
<p>SCHLENCKER SURVEYING (QLD) CONSULTANTS & ENGINEERS ROCKHAMPTON - BIRBAIRRA - GOLD COAST ABN: 55 809 833 411 BIRBAIRRA QLD 4215 BIRBAIRRA QLD 4215 BIRBAIRRA QLD 4215</p>		<p>IMPORTANT NOTE: This plan has been prepared for Logan City Council for the purpose of recording the As Constructed details of a new service constructed under specific Council Approval and should not be used for any other purpose. No report is made on any other service/s, nor any service/s that may exist before or be constructed after, the time of survey, or constructed under any other approval. The property boundaries, easements and lot number shown hereon may be proposed, amended, or subject to registration by the Department of Natural Resources & Mines. All property information should be determined from the registered Survey Plans.</p>		<p>THIS NOTE IS AN INTEGRAL PART OF THIS PLAN.</p>	
<p>REVISIONS</p>		<p>DATE BY CHKD</p>		<p>27/15 BYD</p>	

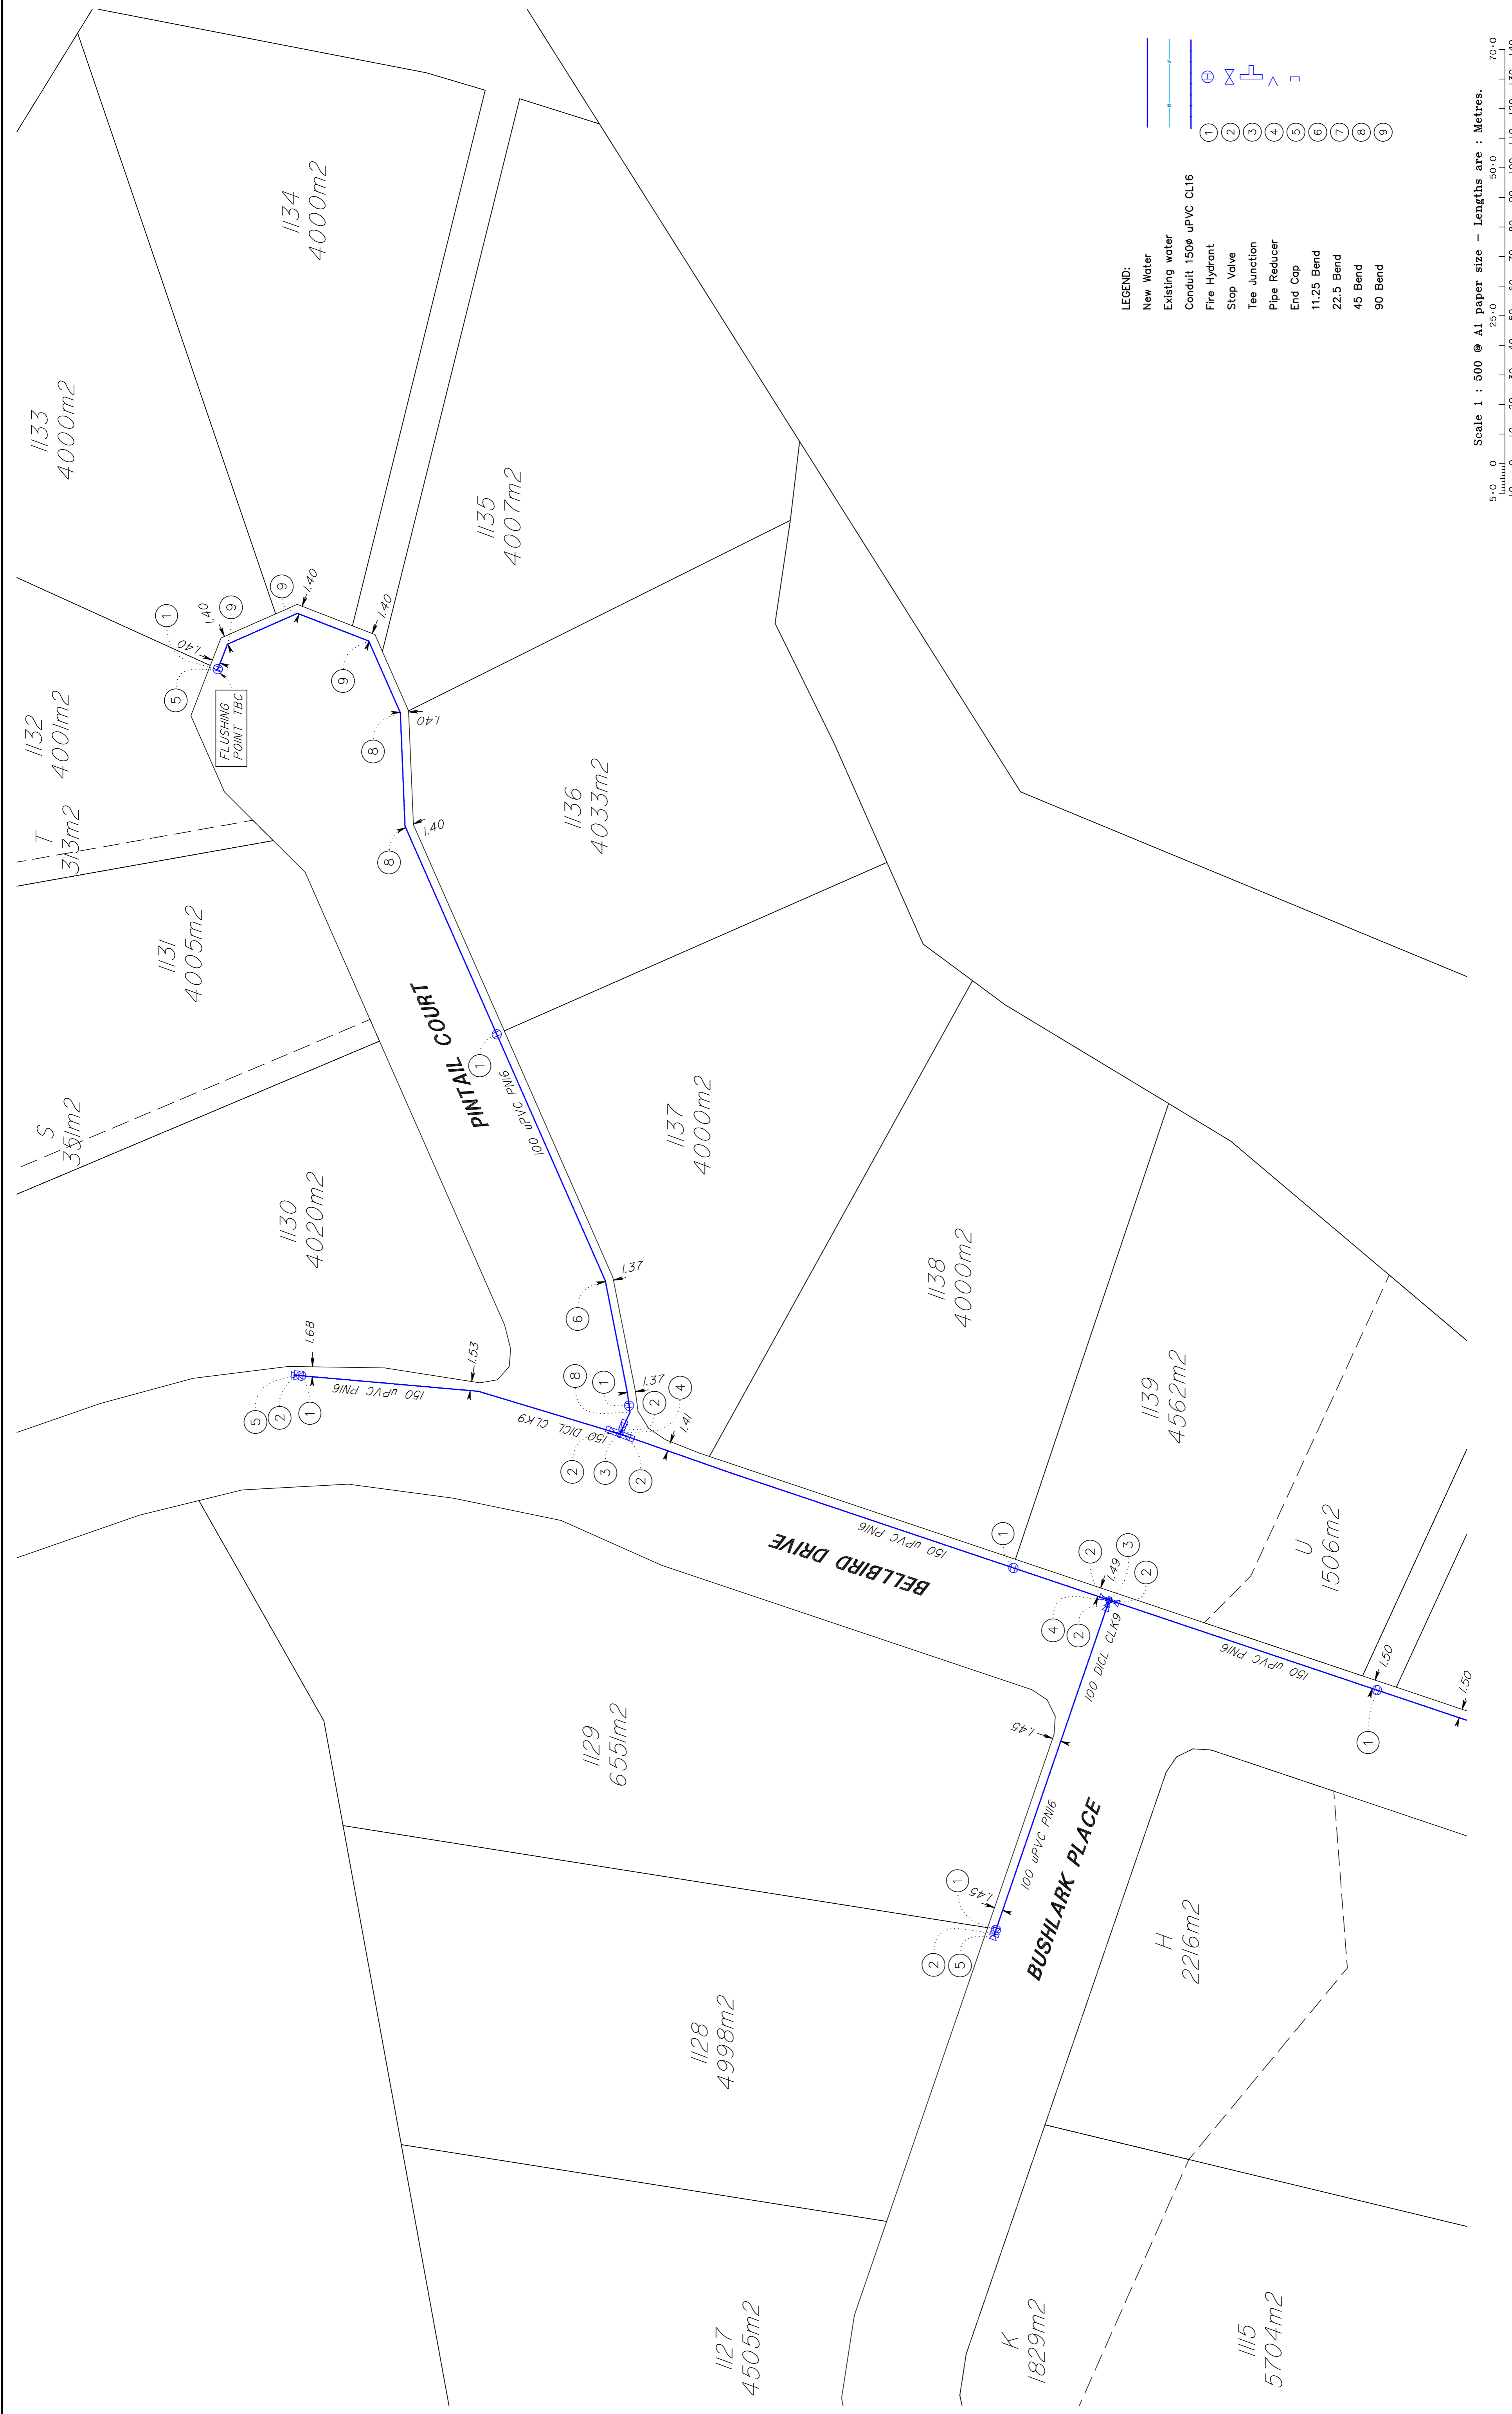

- LEGEND:**
- New Water
 - Existing water
 - Conduit 150uPVC CL16
 - Fire Hydrant
 - Stop Valve
 - Tee Junction
 - Pipe Reducer
 - End Cap
 - 11.25 Bend
 - 22.5 Bend
 - 45 Bend
 - 90 Bend

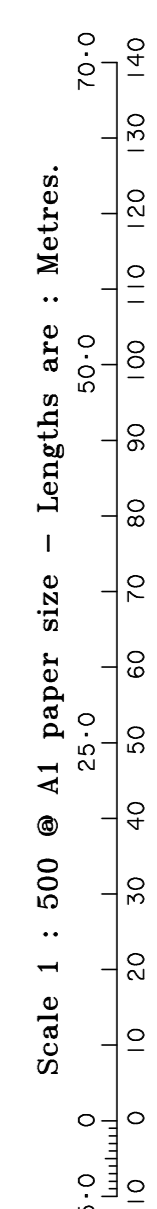

<p>IMPORTANT NOTE This plan has been prepared for Logan City Council for the purpose of recording the As Constructed details of a new service constructed under specific Council Approval and should not be used for any other purpose. No report is made on any other service/s, nor any service/s that may exist before or be constructed after, the time of survey, or constructed under any other approval. The property boundaries, easements and lot number shown hereon may be proposed, altered, amended and subject to registration by the Department of Natural Resources & Mines. All property information should be determined from the registered Survey Plans.</p>		<p>REGISTERED SURVEYOR'S CERTIFICATION : Bruce Victor DALTON hereby certify that the vertical and horizontal locations, and dimensions shown on this plan are a true and correct record of the As Constructed information.</p> <p>Signed: <i>B. Dalton</i> Date: 2/07/2015 For and on behalf of Schlencker Surveying (Qld) Pty. Ltd.</p>		<p>CONSULTING ENGINEER'S CERTIFICATION : 1. I state the the works described on this drawing have been constructed under my supervision, and I or my authorised representatives have inspected the works at all stages of construction. 2. I certify that the works have been constructed in accordance with the Logan Planning Scheme 2006 and any relevant planning scheme policies and standards specifications.</p> <p>Project Name: Consultant: RPEQ/CPENG Membership No.: Signature: Date:</p>		<p>SURVEYOR : PAN DRAWN BY : SPR LOCAL AUTHORITY : LOGAN PARISH : STANLEY COUNTY : STANLEY LEVEL DATUM : AHD De LEVEL ORIGIN : RL98148</p>		<p>AS CONSTRUCTED WATER Spring Mountain Estate, Stage 11A GREENBANK RL / 94 / 2008 / A OW / 218 / 2010</p>							
<p>REVISIONS</p> <table border="1"> <tr> <td>DATE</td> <td>BY</td> <td>CHKD</td> <td>BYD</td> </tr> <tr> <td>27/15</td> <td>BVD</td> <td>BVD</td> <td>BVD</td> </tr> </table>		DATE	BY	CHKD	BYD	27/15	BVD	BVD	BVD	<p>Scale: 1:500 (A1)</p>		<p>SHEET: 2 OF 2</p>		<p>PLAN NO: 4030-13</p>	
DATE	BY	CHKD	BYD												
27/15	BVD	BVD	BVD												