

PSM 201158
E: 506353.976
N: 7042428.644
RL: 12.944m

Electrical Engineers As Constructed Certification

I:
(electrical engineers name) (RPEQ number)

being a certified/registered engineer and duly authorised representative of:
.....
(consulting firm or company name)

Hereby

- certify the information contained in this drawing is an accurate as constructed representation of the works
- accept responsibility for the as constructed survey information contained in this drawing
- acknowledge the as constructed survey information contained in the drawing may be relied on by council and others

Certification of Stage: by On 17 / 07 / 2020.
(stage number) (signature) (date)

For
(consulting firm or company name)

Note: Where consulting firms, company name or stage numbers do not apply, complete with N/A for not applicable

Surveyors As Constructed Certification

I: Andrew Robert Thurston 03047
(surveyors name) (surveyors registration number)

being a certified/registered surveyor and duly authorised representative of:
The Wolter Consulting Group
(consulting firm or company name)


Hereby

- certify the information contained in this drawing is an accurate as constructed representation of the works
- accept responsibility for the as constructed survey information contained in this drawing
- acknowledge the as constructed survey information contained in the drawing may be relied on by council and others

Certification of Stage: 1 by On 17 / 07 / 2020.
(stage number) (signature) (date)

For **The Wolter Consulting Group**
(consulting firm or company name)

Note: Where consulting firms, company name or stage numbers do not apply, complete with N/A for not applicable

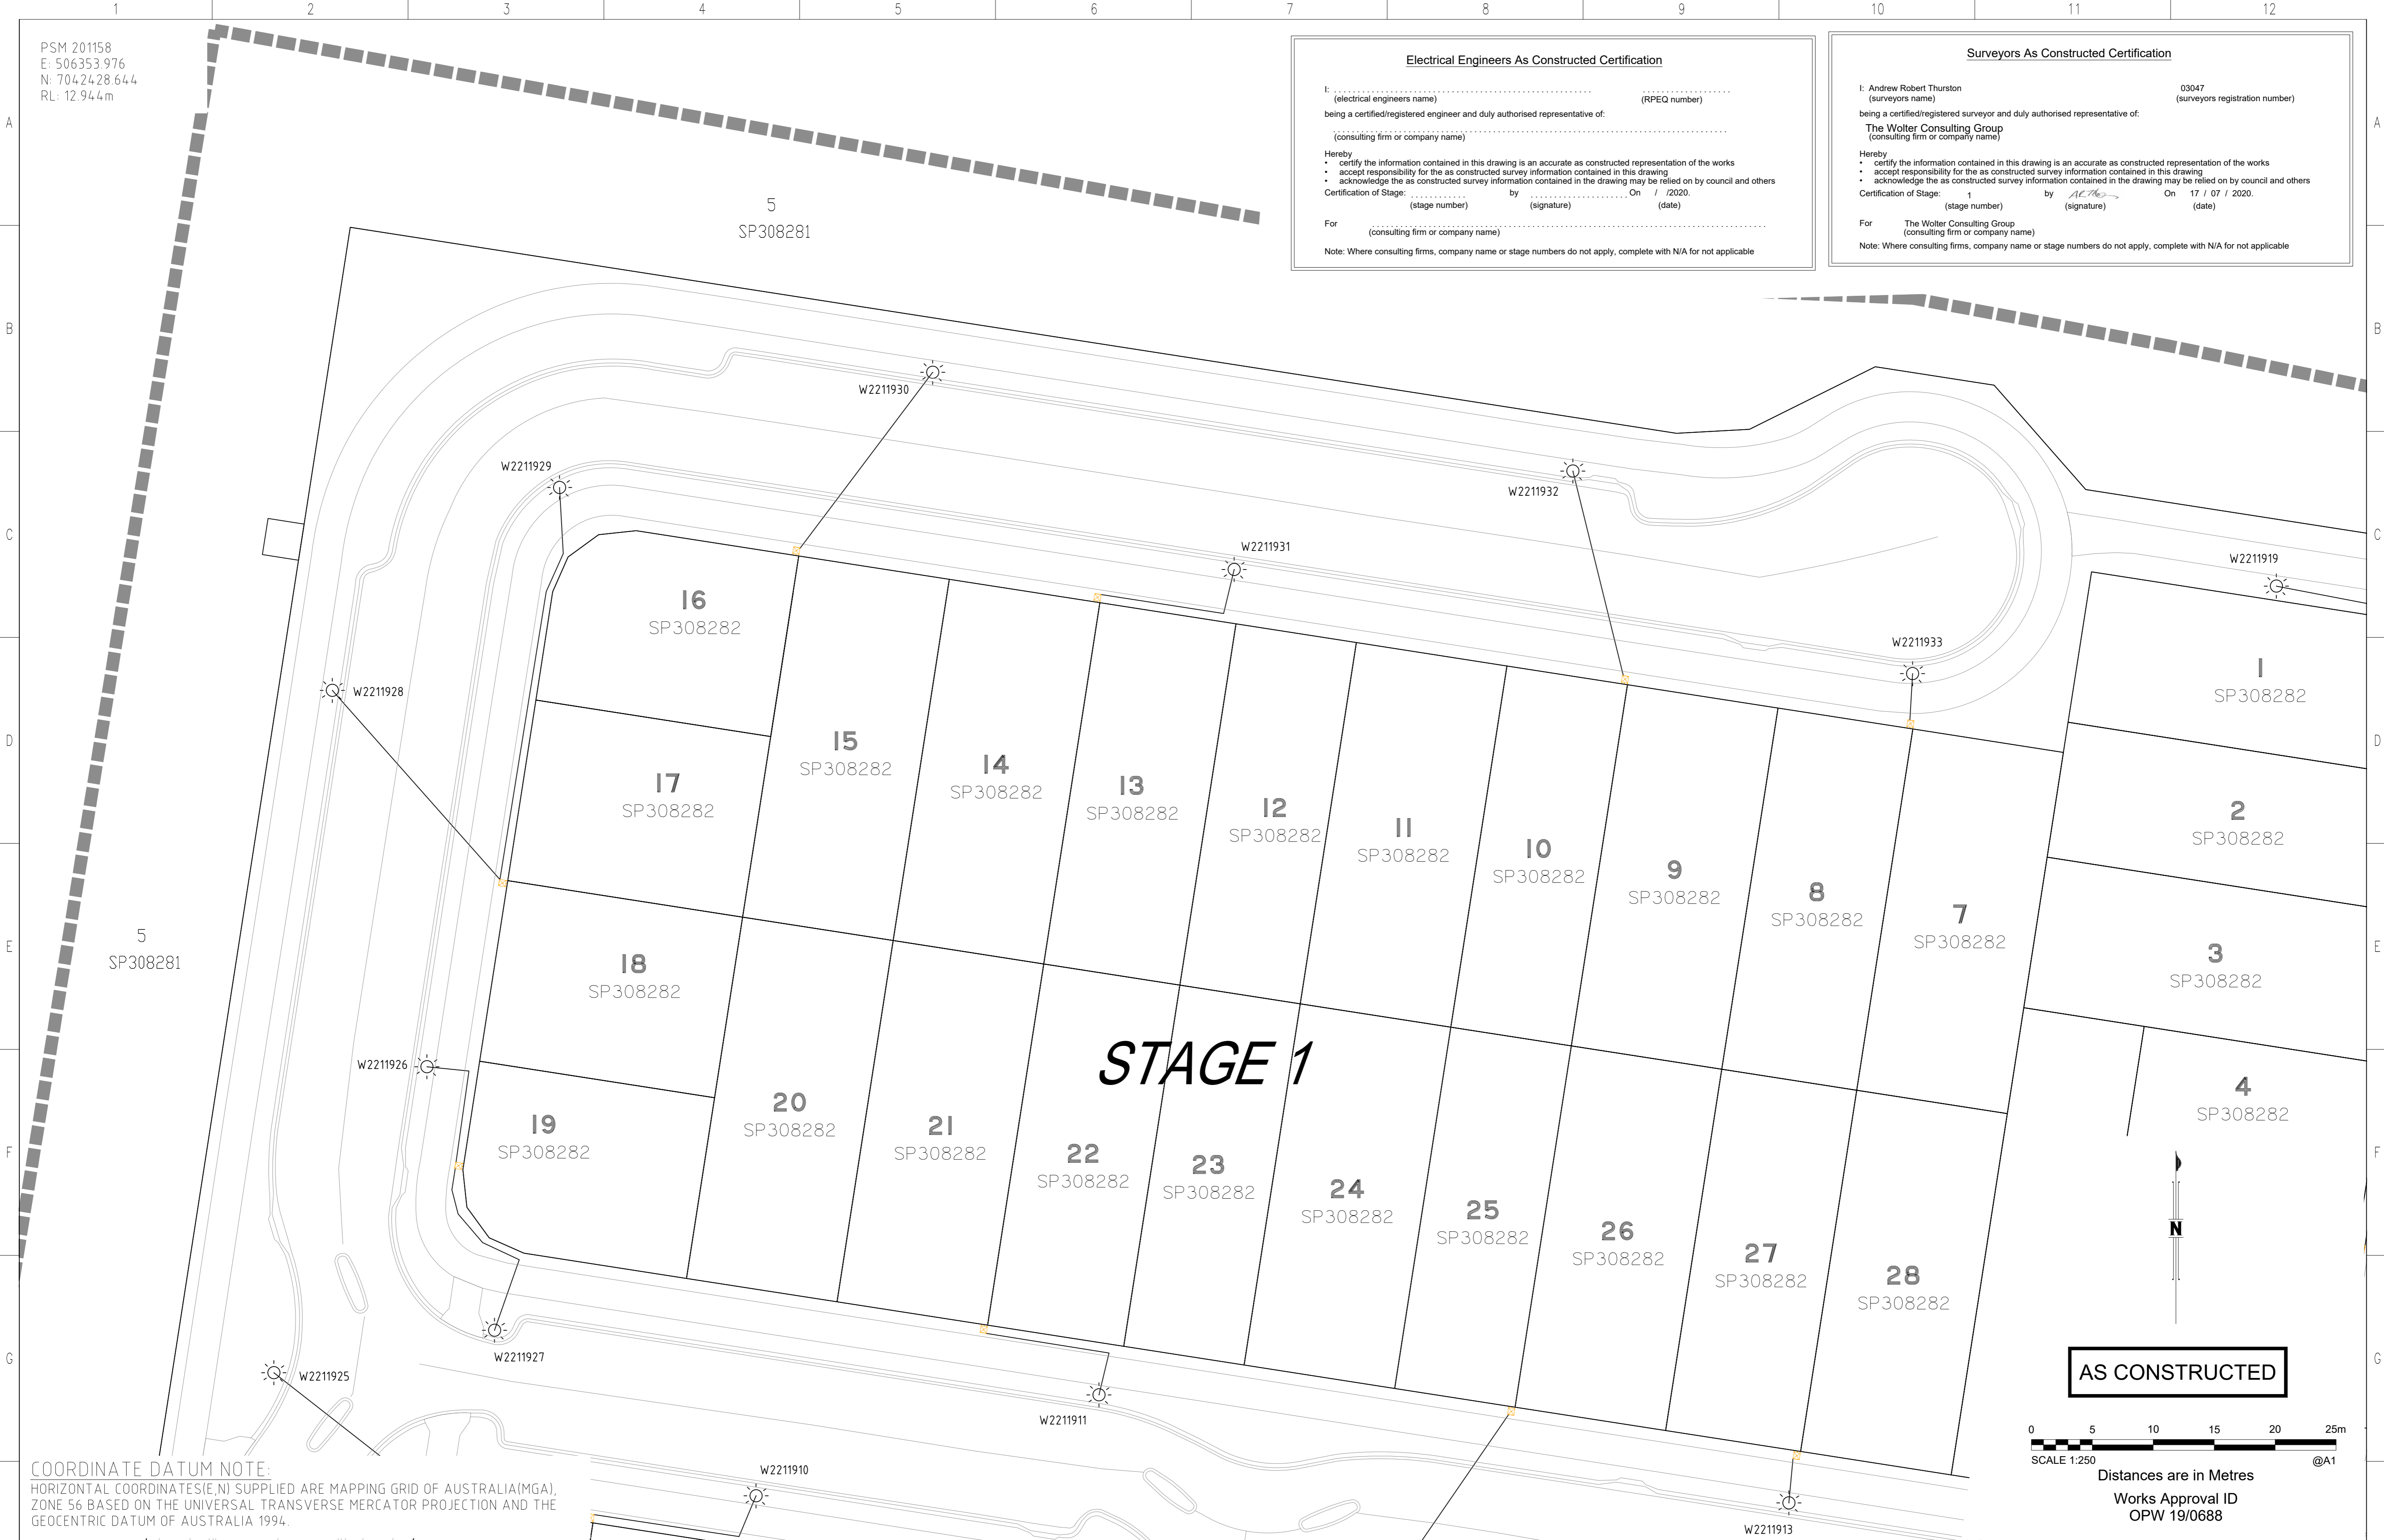

COORDINATE DATUM NOTE:
HORIZONTAL COORDINATES(E,N) SUPPLIED ARE MAPPING GRID OF AUSTRALIA(MGA),
ZONE 56 BASED ON THE UNIVERSAL TRANSVERSE MERCATOR PROJECTION AND THE
GEOCENTRIC DATUM OF AUSTRALIA 1994.

DRAWING REVISIONS		REFERENCE DRAWINGS		DESIGN FILE No.	DESIGNED DATE
REV.	REVISION DESCRIPTION	DRG. No.	DESCRIPTION	CONSTRUCT. No.	DATE
A	AS CONSTRUCTED			SS3787	17.07.2020
				FIELD BOOK	CHECKED A. Bahn-Harvey
				LOG BOOK	DATE 17.07.2020
				LEVEL DATUM	AHD
				DATUM	MGA56/GDA94

WOLTER consulting group

Planning Urban Design Landscape Environment Surveying

Brisbane: Level 2, 1 Breakfast Ck Road, Newstead, QLD 4006 Phone: (07) 3666 5200

SCALE 1:250 ORIGINAL SIZE A1

SUNSHINE COAST COUNCIL

CALOUNDRA OFFICE
1 OMRAH AVENUE, CALOUNDRA QLD 4551

MAROOCHYDORE OFFICE
10 FIRST AVENUE, MAROOCHYDORE QLD 4558

NAMBOUR OFFICE
Cnr CURRIE and BURY STREETS, NAMBOUR QLD 4560

LOCKED BAG 72, SUNSHINE COAST
MAIL CENTRE QLD 4560

Telephone: (07) 5475 7528
Fax: (07) 5475 7277

VILLAGE GREEN - PALMVIEW

**STAGE 1
AS CONSTRUCTED
RATE 3 LIGHTING**

SUBDIVISION REFERENCE	
RAL 18/0186	
No. 1 OF - PLANS	REV.
ASCON GRID NUMBER	A

PSM 201158
 E: 506353.976
 N: 7042428.644
 RL: 12.944m

Surveyors As Constructed Certification

I: Andrew Robert Thurston (surveyors name) 03047 (surveyors registration number)
 being a certified/registered surveyor and duly authorised representative of:
The Wolter Consulting Group (consulting firm or company name)

Hereby
 • certify the information contained in this drawing is an accurate as constructed representation of the works
 • accept responsibility for the as constructed survey information contained in this drawing
 • acknowledge the as constructed survey information contained in the drawing may be relied on by council and others

Certification of Stage: 1 (stage number) by *A.R.T.* (signature) On 17 / 07 / 2020. (date)

For The Wolter Consulting Group (consulting firm or company name)
 Note: Where consulting firms, company name or stage numbers do not apply, complete with N/A for not applicable

Electrical Engineers As Constructed Certification

I: (electrical engineers name) (RPEQ number)
 being a certified/registered engineer and duly authorised representative of:
 (consulting firm or company name)

Hereby
 • certify the information contained in this drawing is an accurate as constructed representation of the works
 • accept responsibility for the as constructed survey information contained in this drawing
 • acknowledge the as constructed survey information contained in the drawing may be relied on by council and others

Certification of Stage: (stage number) by (signature) On / / 2020. (date)

For (consulting firm or company name)
 Note: Where consulting firms, company name or stage numbers do not apply, complete with N/A for not applicable



COORDINATE DATUM NOTE:
 HORIZONTAL COORDINATES(E,N) SUPPLIED ARE MAPPING GRID OF AUSTRALIA(MGA),
 ZONE 56 BASED ON THE UNIVERSAL TRANSVERSE MERCATOR PROJECTION AND THE
 GEOCENTRIC DATUM OF AUSTRALIA 1994.

DRAWING REVISIONS		REFERENCE DRAWINGS		DESIGN FILE No.	DESIGNED	
REV.	REVISION DESCRIPTION	DRG. No.	DESCRIPTION	CONSTRUCT. No.	DATE	
A	AS CONSTRUCTED			SS3787	DRAWN	J Braga
					DATE	17.07.2020
					CHECKED	A. Bohn-Harvey
					DATE	17.07.2020
					LEVEL DATUM	AHD
					DATUM	MGA56/GDA94

WOLTER consulting group

Planning Urban Design Landscape Environment Surveying

Brisbane: Level 2, 1 Breakfast Ck Road, Newstead, QLD 4006 Phone: (07) 3666 5200

SCALE 1:250 ORIGINAL SIZE A1

SUNSHINE COAST COUNCIL

CALOUNDRA OFFICE
 1 OMRAH AVENUE, CALOUNDRA QLD 4551

MAROOCHYDORE OFFICE
 10 FIRST AVENUE, MAROOCHYDORE QLD 4558

NAMBOUR OFFICE
 Cnr CURRIE and BURY STREETS, NAMBOUR QLD 4560

LOCKED BAG 72, SUNSHINE COAST
 MAIL CENTRE QLD 4560
 Telephone: (07) 5475 7528
 Fax: (07) 5475 7277

VILLAGE GREEN - PALMVIEW

STAGE 1
 AS CONSTRUCTED
 RATE 3 LIGHTING

SUBDIVISION REFERENCE	
RAL 18/0186	
No. 1 OF - PLANS	
ASCON GRID NUMBER	REV.
	A



PSM 201158
 E: 506353.976
 N: 7042428.644
 RL: 12.944m

COORDINATE DATUM NOTE:
 HORIZONTAL COORDINATES(E,N) SUPPLIED ARE MAPPING GRID OF AUSTRALIA(MGA),
 ZONE 56 BASED ON THE UNIVERSAL TRANSVERSE MERCATOR PROJECTION AND THE
 GEOCENTRIC DATUM OF AUSTRALIA 1994.

STAGE 1

Surveyors As Constructed Certification

I: Andrew Robert Thurston (surveyors name) 03047 (surveyors registration number)
 being a certified/registered surveyor and duly authorised representative of:
The Wolter Consulting Group
 (consulting firm or company name)

Hereby
 • certify the information contained in this drawing is an accurate as constructed representation of the works
 • accept responsibility for the as constructed survey information contained in this drawing
 • acknowledge the as constructed survey information contained in the drawing may be relied on by council and others

Certification of Stage: 1 (stage number) by A.R.T. (signature) On 17 / 07 / 2020. (date)

For The Wolter Consulting Group (consulting firm or company name)

Note: Where consulting firms, company name or stage numbers do not apply, complete with N/A for not applicable

Electrical Engineers As Constructed Certification

I: (electrical engineers name) (RPEQ number)
 being a certified/registered engineer and duly authorised representative of:
 (consulting firm or company name)

Hereby
 • certify the information contained in this drawing is an accurate as constructed representation of the works
 • accept responsibility for the as constructed survey information contained in this drawing
 • acknowledge the as constructed survey information contained in the drawing may be relied on by council and others

Certification of Stage: (stage number) by (signature) On / / 2020. (date)

For (consulting firm or company name)

Note: Where consulting firms, company name or stage numbers do not apply, complete with N/A for not applicable

AS CONSTRUCTED

0 5 10 15 20 25m
 SCALE 1:250 Distances are in Metres @A1

North Arrow

DRAWING REVISIONS		REFERENCE DRAWINGS		DESIGN FILE No.	DESIGNED DATE
REV.	REVISION DESCRIPTION	DRG. No.	DESCRIPTION	CONSTRUCT. No.	DATE
A	AS CONSTRUCTED			SS3787	17.07.2020
				SURVEY FILE No.	J Braga
				FIELD BOOK	17.07.2020
				LOG BOOK	A. Bahn-Harvey
				LEVEL DATUM	17.07.2020
				DATUM	AHD


WOLTER
 consulting group
 Planning Urban Design Landscape Environment Surveying
 Brisbane: Level 2, 1 Breakfast Ck Road, Newstead, QLD 4006 Phone: (07) 3666 5200

SCALE 1:250 ORIGINAL SIZE A1

SUNSHINE COAST COUNCIL
 CALOUNDRA OFFICE
 1 OMRAH AVENUE, CALOUNDRA QLD 4551
 MAROOCHYDORE OFFICE
 10 FIRST AVENUE, MAROOCHYDORE QLD 4558
 NAMBOUR OFFICE
 CAR CURRIE and BURY STREETS, NAMBOUR QLD 4560
 LOCKED BAG 72, SUNSHINE COAST
 MAIL CENTRE QLD 4560
 Telephone: (07) 5475 7528
 Fax: (07) 5475 7277

VILLAGE GREEN - PALMVIEW
 STAGE 1
 AS CONSTRUCTED
 RATE 3 LIGHTING

SUBDIVISION REFERENCE	
RAL 18/0186	
No. 1 OF - PLANS	
ASCON GRID NUMBER	REV.
	A

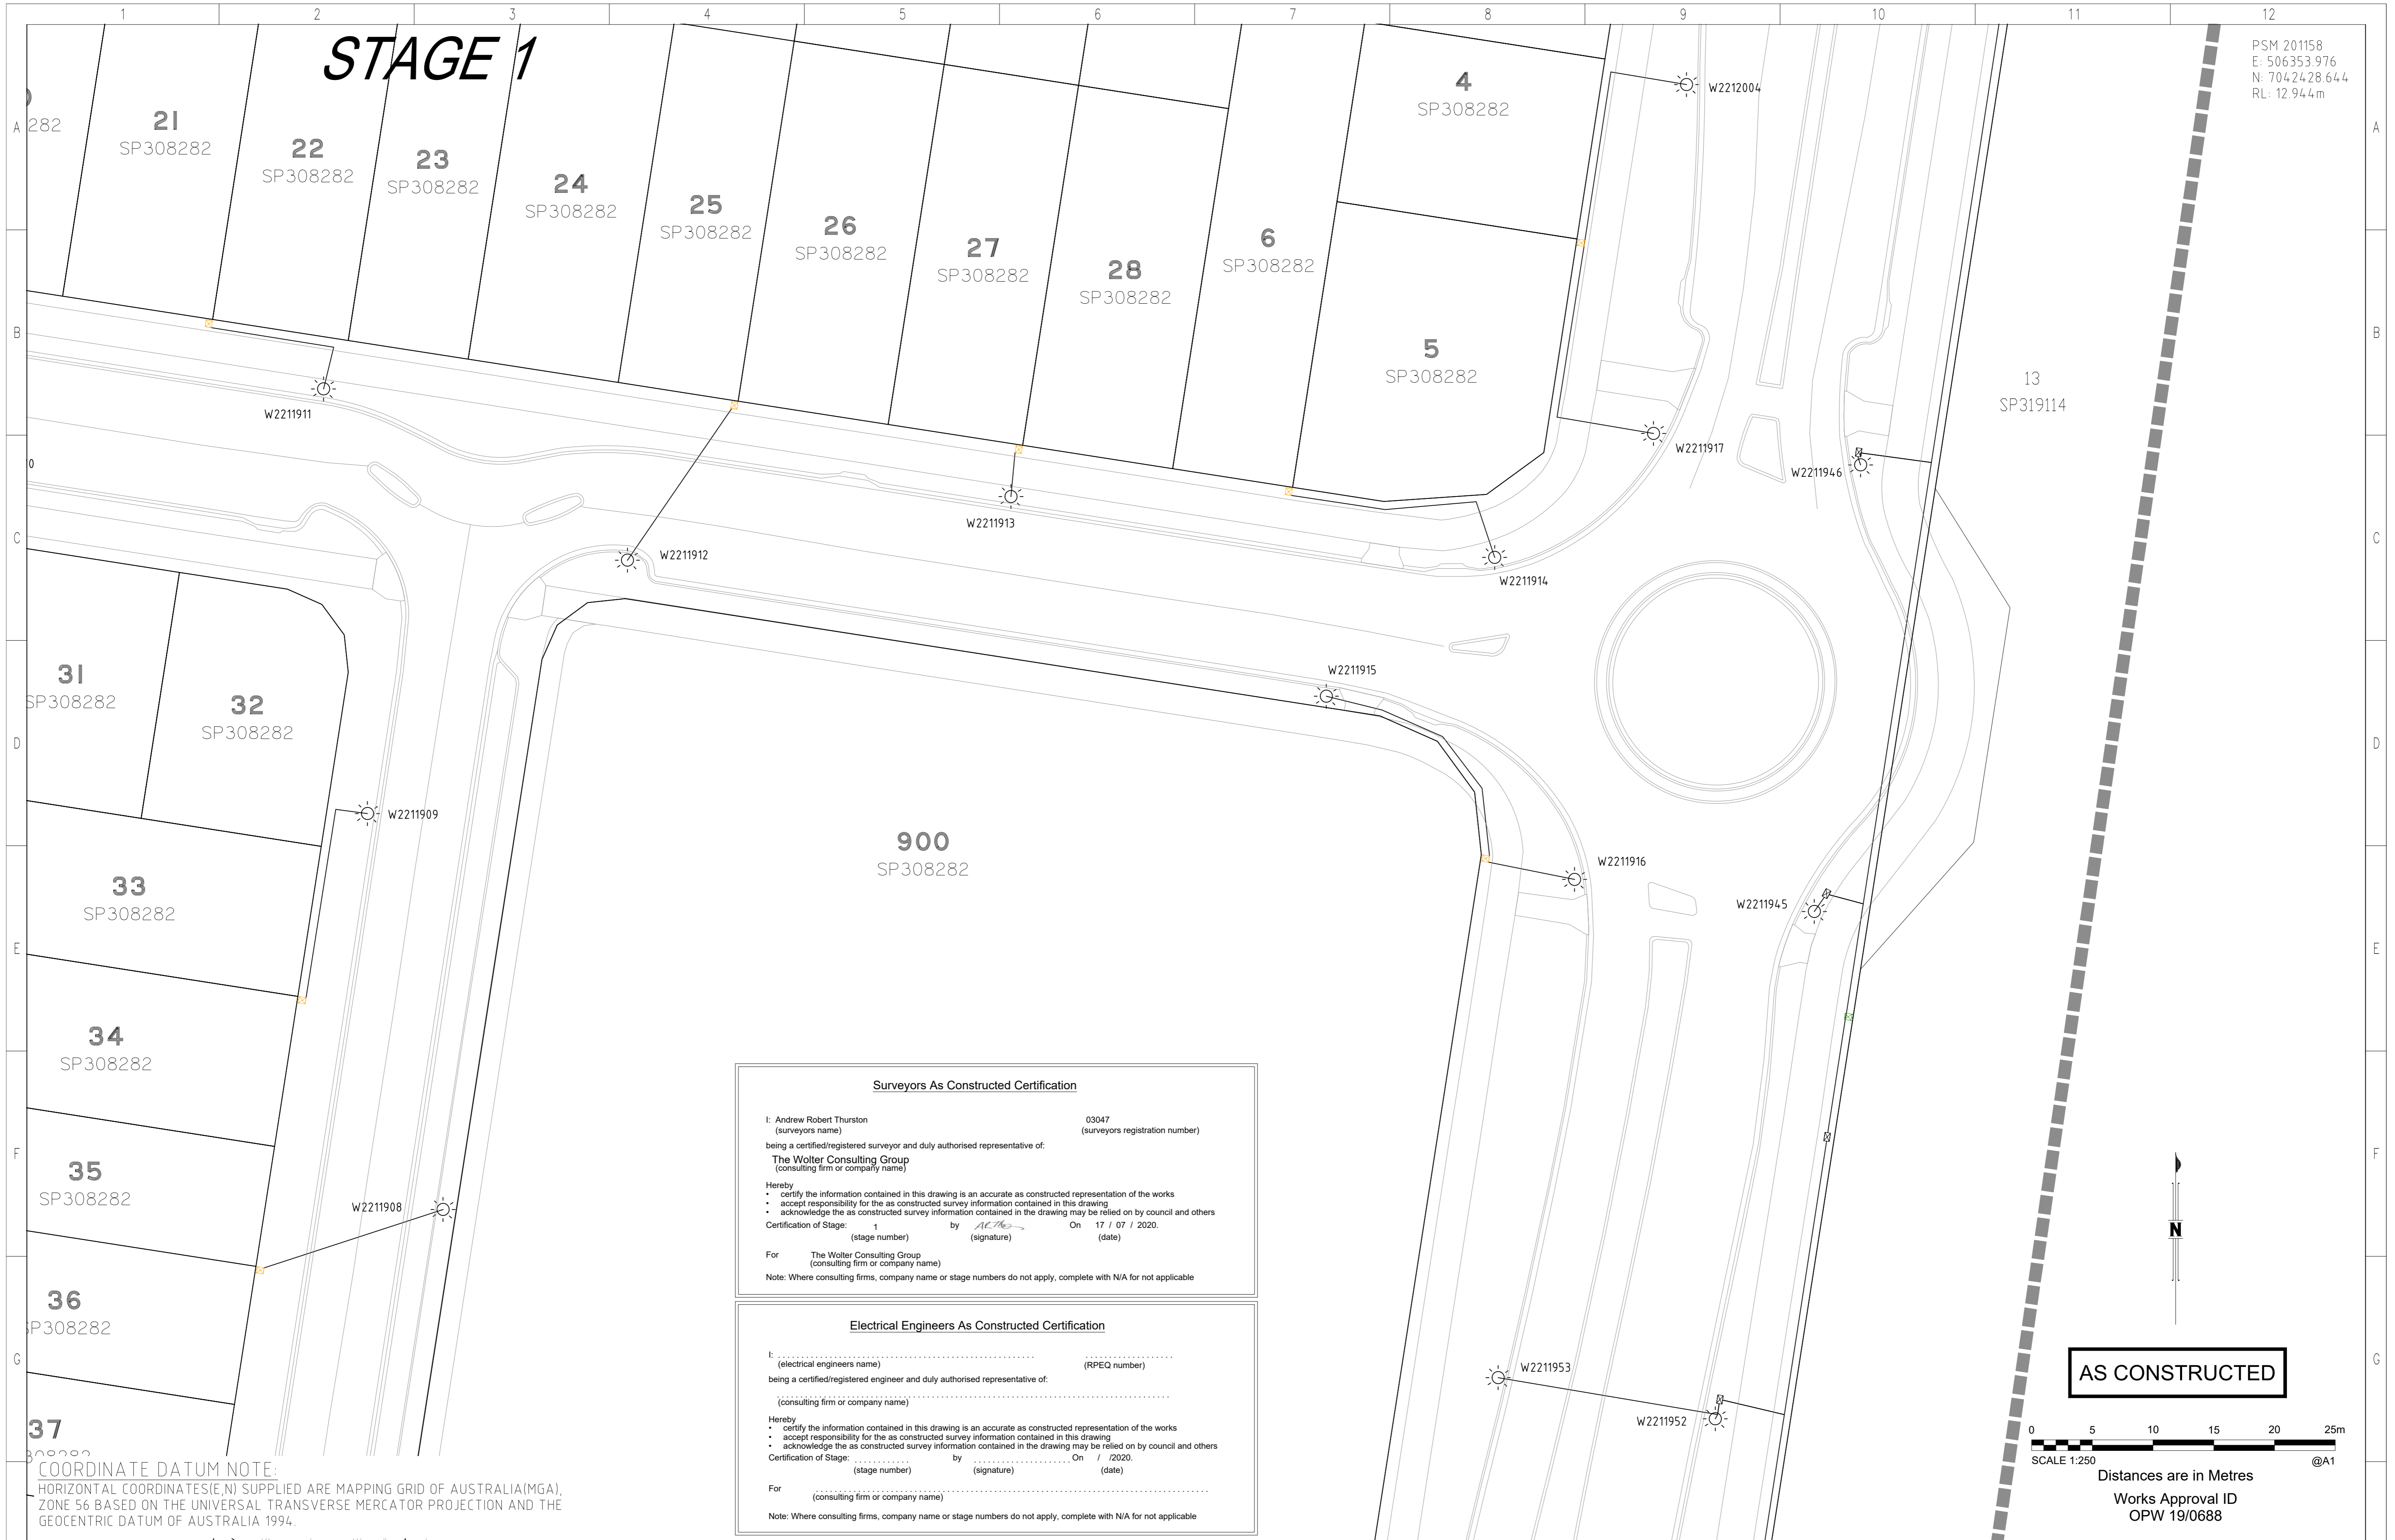

PSM 201158
 E: 506353.976
 N: 7042428.644
 RL: 12.944m

Surveyors As Constructed Certification

I: Andrew Robert Thurston (surveyors name) 03047 (surveyors registration number)
 being a certified/registered surveyor and duly authorised representative of:
The Wolter Consulting Group
 (consulting firm or company name)

Hereby
 • certify the information contained in this drawing is an accurate as constructed representation of the works
 • accept responsibility for the as constructed survey information contained in this drawing
 • acknowledge the as constructed survey information contained in the drawing may be relied on by council and others

Certification of Stage: 1 (stage number) by A. Bohn-Harvey (signature) On 17 / 07 / 2020. (date)

For The Wolter Consulting Group (consulting firm or company name)
 Note: Where consulting firms, company name or stage numbers do not apply, complete with N/A for not applicable

Electrical Engineers As Constructed Certification

I: (electrical engineers name) (RPEQ number)
 being a certified/registered engineer and duly authorised representative of:
 (consulting firm or company name)

Hereby
 • certify the information contained in this drawing is an accurate as constructed representation of the works
 • accept responsibility for the as constructed survey information contained in this drawing
 • acknowledge the as constructed survey information contained in the drawing may be relied on by council and others

Certification of Stage: (stage number) by (signature) On / / 2020. (date)

For (consulting firm or company name)
 Note: Where consulting firms, company name or stage numbers do not apply, complete with N/A for not applicable

COORDINATE DATUM NOTE:
 HORIZONTAL COORDINATES(E,N) SUPPLIED ARE MAPPING GRID OF AUSTRALIA(MGA),
 ZONE 56 BASED ON THE UNIVERSAL TRANSVERSE MERCATOR PROJECTION AND THE
 GEOCENTRIC DATUM OF AUSTRALIA 1994.

DRAWING REVISIONS		REFERENCE DRAWINGS		DESIGN FILE No.	DESIGNED
REV.	REVISION DESCRIPTION	DRG. No.	DESCRIPTION	CONSTRUCT. No.	DATE
A	AS CONSTRUCTED			SS3787	17.07.2020

DESIGNED	CHECKED	DRAWN
J Braga	A. Bohn-Harvey	J Braga
17.07.2020	17.07.2020	17.07.2020

WOLTER
 consulting group
 Planning Urban Design Landscape Environment Surveying
 Brisbane: Level 2, 1 Breakfast Ck Road, Newstead, QLD 4006 Phone: (07) 3666 5200

SCALE 1:250 ORIGINAL SIZE A1

SUNSHINE COAST COUNCIL
 CALOUNDRA OFFICE
 1 OMRAH AVENUE, CALOUNDRA QLD 4551
 MAROOCHYDORE OFFICE
 10 FIRST AVENUE, MAROOCHYDORE QLD 4558
 NAMBOUR OFFICE
 Cnr CURRIE and BURY STREETS, NAMBOUR QLD 4560
 LOCKED BAG 72, SUNSHINE COAST
 MAIL CENTRE QLD 4560
 Telephone: (07) 5475 7528
 Fax: (07) 5475 7277

VILLAGE GREEN - PALMVIEW
 STAGE 1
 AS CONSTRUCTED
 RATE 3 LIGHTING

SUBDIVISION REFERENCE	
RAL 18/0186	
No. 1 OF - PLANS	REV.
ASCON GRID NUMBER	A



Surveyors As Constructed Certification

I: Andrew Robert Thurston (surveyors name) 03047 (surveyors registration number)
 being a certified/registered surveyor and duly authorised representative of:
The Wolter Consulting Group (consulting firm or company name)

Hereby
 • certify the information contained in this drawing is an accurate as constructed representation of the works
 • accept responsibility for the as constructed survey information contained in this drawing
 • acknowledge the as constructed survey information contained in the drawing may be relied on by council and others

Certification of Stage: 1 (stage number) by *ALB* (signature) On 17 / 07 / 2020. (date)

For The Wolter Consulting Group (consulting firm or company name)
 Note: Where consulting firms, company name or stage numbers do not apply, complete with N/A for not applicable

Electrical Engineers As Constructed Certification


I: (electrical engineers name) (RPEQ number)
 being a certified/registered engineer and duly authorised representative of:
 (consulting firm or company name)

Hereby
 • certify the information contained in this drawing is an accurate as constructed representation of the works
 • accept responsibility for the as constructed survey information contained in this drawing
 • acknowledge the as constructed survey information contained in the drawing may be relied on by council and others

Certification of Stage: (stage number) by (signature) On / / 2020. (date)

For (consulting firm or company name)
 Note: Where consulting firms, company name or stage numbers do not apply, complete with N/A for not applicable

COORDINATE DATUM NOTE:
 HORIZONTAL COORDINATES(E,N) SUPPLIED ARE MAPPING GRID OF AUSTRALIA(MGA), ZONE 56 BASED ON THE UNIVERSAL TRANSVERSE MERCATOR PROJECTION AND THE GEOCENTRIC DATUM OF AUSTRALIA 1994.

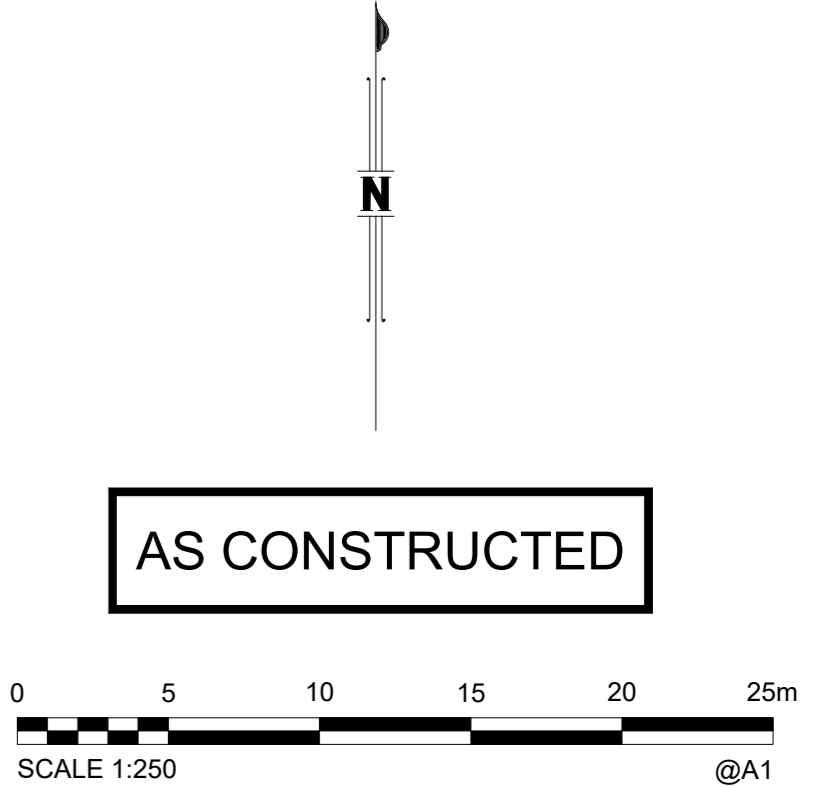

DRAWING REVISIONS		REFERENCE DRAWINGS		DESIGN FILE No.	DESIGNED DATE
REV.	REVISION DESCRIPTION	DRG. No.	DESCRIPTION	CONSTRUCT. No.	DATE
A	AS CONSTRUCTED			SS3787	17.07.2020

WOLTER consulting group
 Planning Urban Design Landscape Environment Surveying
 Brisbane: Level 2, 1 Breakfast Ck Road, Newstead, QLD 4006 Phone: (07) 3666 5200


SCALE 1:250 ORIGINAL SIZE A1

SUNSHINE COAST COUNCIL
 CALOUNDRA OFFICE
 1 OMRAH AVENUE, CALOUNDRA QLD 4551
 MAROOCHYDORE OFFICE
 10 FIRST AVENUE, MAROOCHYDORE QLD 4558
 NAMBOUR OFFICE
 Cnr CURRIE and BURY STREETS, NAMBOUR QLD 4560
 LOCKED BAG 72, SUNSHINE COAST
 MAIL CENTRE QLD 4560
 Telephone: (07) 5475 7528
 Fax: (07) 5475 7277

VILLAGE GREEN - PALMVIEW
 STAGE 1
 AS CONSTRUCTED
 RATE 3 LIGHTING

SUBDIVISION REFERENCE	
RAL 18/0186	
No. 1 OF - PLANS	
ASCON GRID NUMBER	REV.
	A

PSM 201158
 E: 506353.976
 N: 7042428.644
 RL: 12.944m

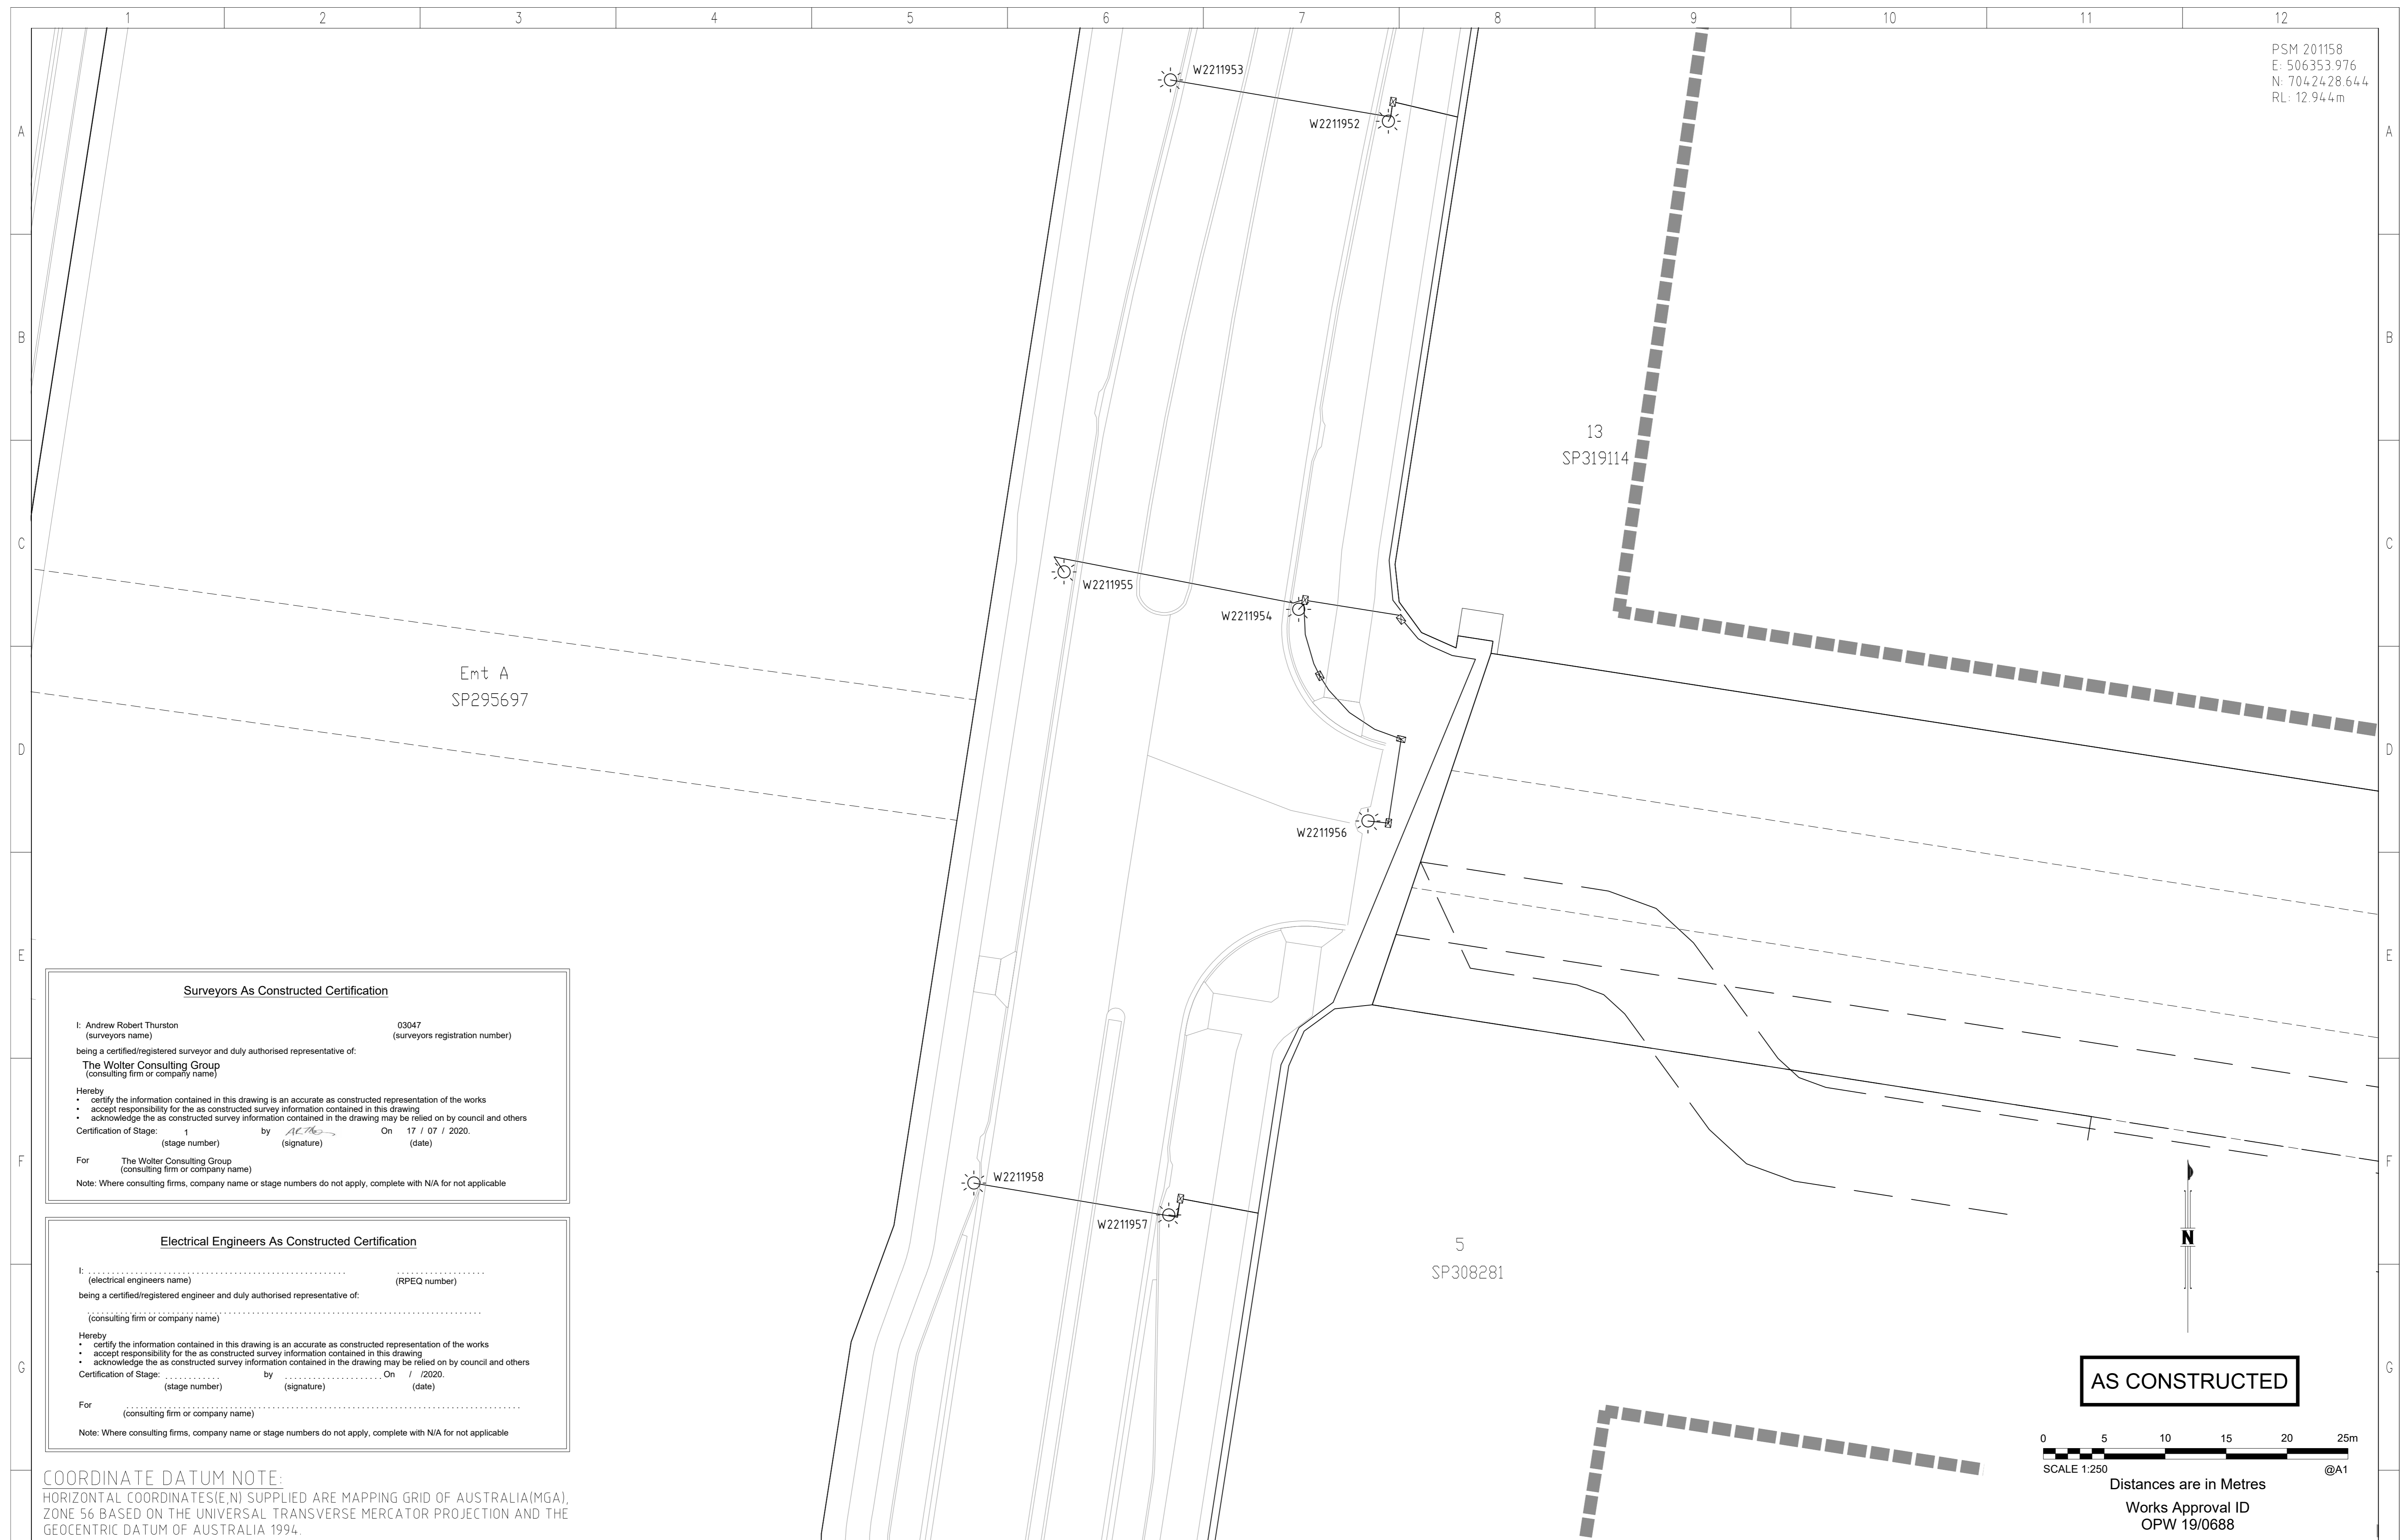

Surveyors As Constructed Certification

I: Andrew Robert Thurston (surveyors name) 03047 (surveyors registration number)
 being a certified/registered surveyor and duly authorised representative of:
The Wolter Consulting Group (consulting firm or company name)

Hereby
 • certify the information contained in this drawing is an accurate as constructed representation of the works
 • accept responsibility for the as constructed survey information contained in this drawing
 • acknowledge the as constructed survey information contained in the drawing may be relied on by council and others

Certification of Stage: 1 (stage number) by *ACT* (signature) On 17 / 07 / 2020. (date)

For The Wolter Consulting Group (consulting firm or company name)
 Note: Where consulting firms, company name or stage numbers do not apply, complete with N/A for not applicable

Electrical Engineers As Constructed Certification

I: (electrical engineers name) (RPEQ number)
 being a certified/registered engineer and duly authorised representative of:
 (consulting firm or company name)

Hereby
 • certify the information contained in this drawing is an accurate as constructed representation of the works
 • accept responsibility for the as constructed survey information contained in this drawing
 • acknowledge the as constructed survey information contained in the drawing may be relied on by council and others

Certification of Stage: (stage number) by (signature) On / / 2020. (date)

For (consulting firm or company name)
 Note: Where consulting firms, company name or stage numbers do not apply, complete with N/A for not applicable

COORDINATE DATUM NOTE:
 HORIZONTAL COORDINATES(E,N) SUPPLIED ARE MAPPING GRID OF AUSTRALIA(MGA), ZONE 56 BASED ON THE UNIVERSAL TRANSVERSE MERCATOR PROJECTION AND THE GEOCENTRIC DATUM OF AUSTRALIA 1994.

DRAWING REVISIONS		REFERENCE DRAWINGS		DESIGN FILE No.	DESIGNED
REV.	REVISION DESCRIPTION	DRG. No.	DESCRIPTION	CONSTRUCT. No.	DATE
A	AS CONSTRUCTED			SS3787	17.07.2020
				SURVEY FILE No.	J Braga
				FIELD BOOK	17.07.2020
				LOG BOOK	CHECKED
				LEVEL DATUM	A. Bahn-Harvey
				DATUM	17.07.2020
				AHD	
				MGA56/GDA94	

WOLTER consulting group

Planning Urban Design Landscape Environment Surveying

Brisbane: Level 2, 1 Breakfast Ck Road, Newstead, QLD 4006 Phone: (07) 3666 5200

SCALE 1:250 ORIGINAL SIZE A1

SUNSHINE COAST COUNCIL

CALOUNDRA OFFICE
 1 OMRAH AVENUE, CALOUNDRA QLD 4551

MAROOCHYDORE OFFICE
 10 FIRST AVENUE, MAROOCHYDORE QLD 4558

NAMBOUR OFFICE
 Cnr CURRIE and BURY STREETS, NAMBOUR QLD 4560

LOCKED BAG 72, SUNSHINE COAST
 MAIL CENTRE QLD 4560
 Telephone: (07) 5475 7528
 Fax: (07) 5475 7277

VILLAGE GREEN - PALMVIEW

STAGE 1
 AS CONSTRUCTED
 RATE 3 LIGHTING

SUBDIVISION REFERENCE

RAL 18/0186

No. 1 OF - PLANS

ASCON GRID NUMBER	REV.
	A

PSM 201158
E: 506353.976
N: 7042428.644
RL: 12.944m

Surveyors As Constructed Certification

I, Andrew Robert Thurston (surveyors name) 03047 (surveyors registration number)
being a certified/registered surveyor and duly authorised representative of:
The Wolter Consulting Group (consulting firm or company name)

Hereby
 • certify the information contained in this drawing is an accurate as constructed representation of the works
 • accept responsibility for the as constructed survey information contained in this drawing
 • acknowledge the as constructed survey information contained in the drawing may be relied on by council and others

Certification of Stage: 1 (stage number) by *A.R.T.* (signature) On 17 / 07 / 2020. (date)

For The Wolter Consulting Group (consulting firm or company name)

Note: Where consulting firms, company name or stage numbers do not apply, complete with N/A for not applicable

Electrical Engineers As Constructed Certification

I, (electrical engineers name) (RPEQ number)
being a certified/registered engineer and duly authorised representative of:
..... (consulting firm or company name)

Hereby
 • certify the information contained in this drawing is an accurate as constructed representation of the works
 • accept responsibility for the as constructed survey information contained in this drawing
 • acknowledge the as constructed survey information contained in the drawing may be relied on by council and others

Certification of Stage: (stage number) by (signature) On / / 2020. (date)

For (consulting firm or company name)

Note: Where consulting firms, company name or stage numbers do not apply, complete with N/A for not applicable



COORDINATE DATUM NOTE:
HORIZONTAL COORDINATES(E,N) SUPPLIED ARE MAPPING GRID OF AUSTRALIA(MGA), ZONE 56 BASED ON THE UNIVERSAL TRANSVERSE MERCATOR PROJECTION AND THE GEOCENTRIC DATUM OF AUSTRALIA 1994.

AS CONSTRUCTED


0 5 10 15 20 25m
SCALE 1:250 Distances are in Metres @A1

VILLAGE GREEN - PALMVIEW
STAGE 1
AS CONSTRUCTED
RATE 3 LIGHTING
Works Approval ID
OPW 19/0688


DRAWING REVISIONS		REFERENCE DRAWINGS		DESIGN FILE No.	DESIGNED DATE
REV.	REVISION DESCRIPTION	DRG. No.	DESCRIPTION	CONSTRUCT. No.	DATE
A	AS CONSTRUCTED			SS3787	17.07.2020
				SURVEY FILE No.	J Braga
				FIELD BOOK	17.07.2020
				LOG BOOK	A. Bahn-Harvey
				LEVEL DATUM	17.07.2020
				DATUM	AHD
					MGA56/GDA94


WOLTER
 consulting group
 Planning Urban Design Landscape Environment Surveying
 Brisbane: Level 2, 1 Breakfast Ck Road, Newstead, QLD 4006 Phone: (07) 3666 5200

SCALE 1:250 ORIGINAL SIZE A1


SUNSHINE COAST COUNCIL
 CALOUNDRA OFFICE
 1 OMRAH AVENUE, CALOUNDRA QLD 4551
 MAROOCHYDORE OFFICE
 10 FIRST AVENUE, MAROOCHYDORE QLD 4558
 NAMBOUR OFFICE
 Cnr CURRIE and BURY STREETS, NAMBOUR QLD 4560
 LOCKED BAG 72, SUNSHINE COAST
 MAIL CENTRE QLD 4560
 Telephone: (07) 5475 7528
 Fax: (07) 5475 7277

SUBDIVISION REFERENCE	
RAL 18/0186	
No. 1 OF - PLANS	
ASCON GRID NUMBER	REV.
	A

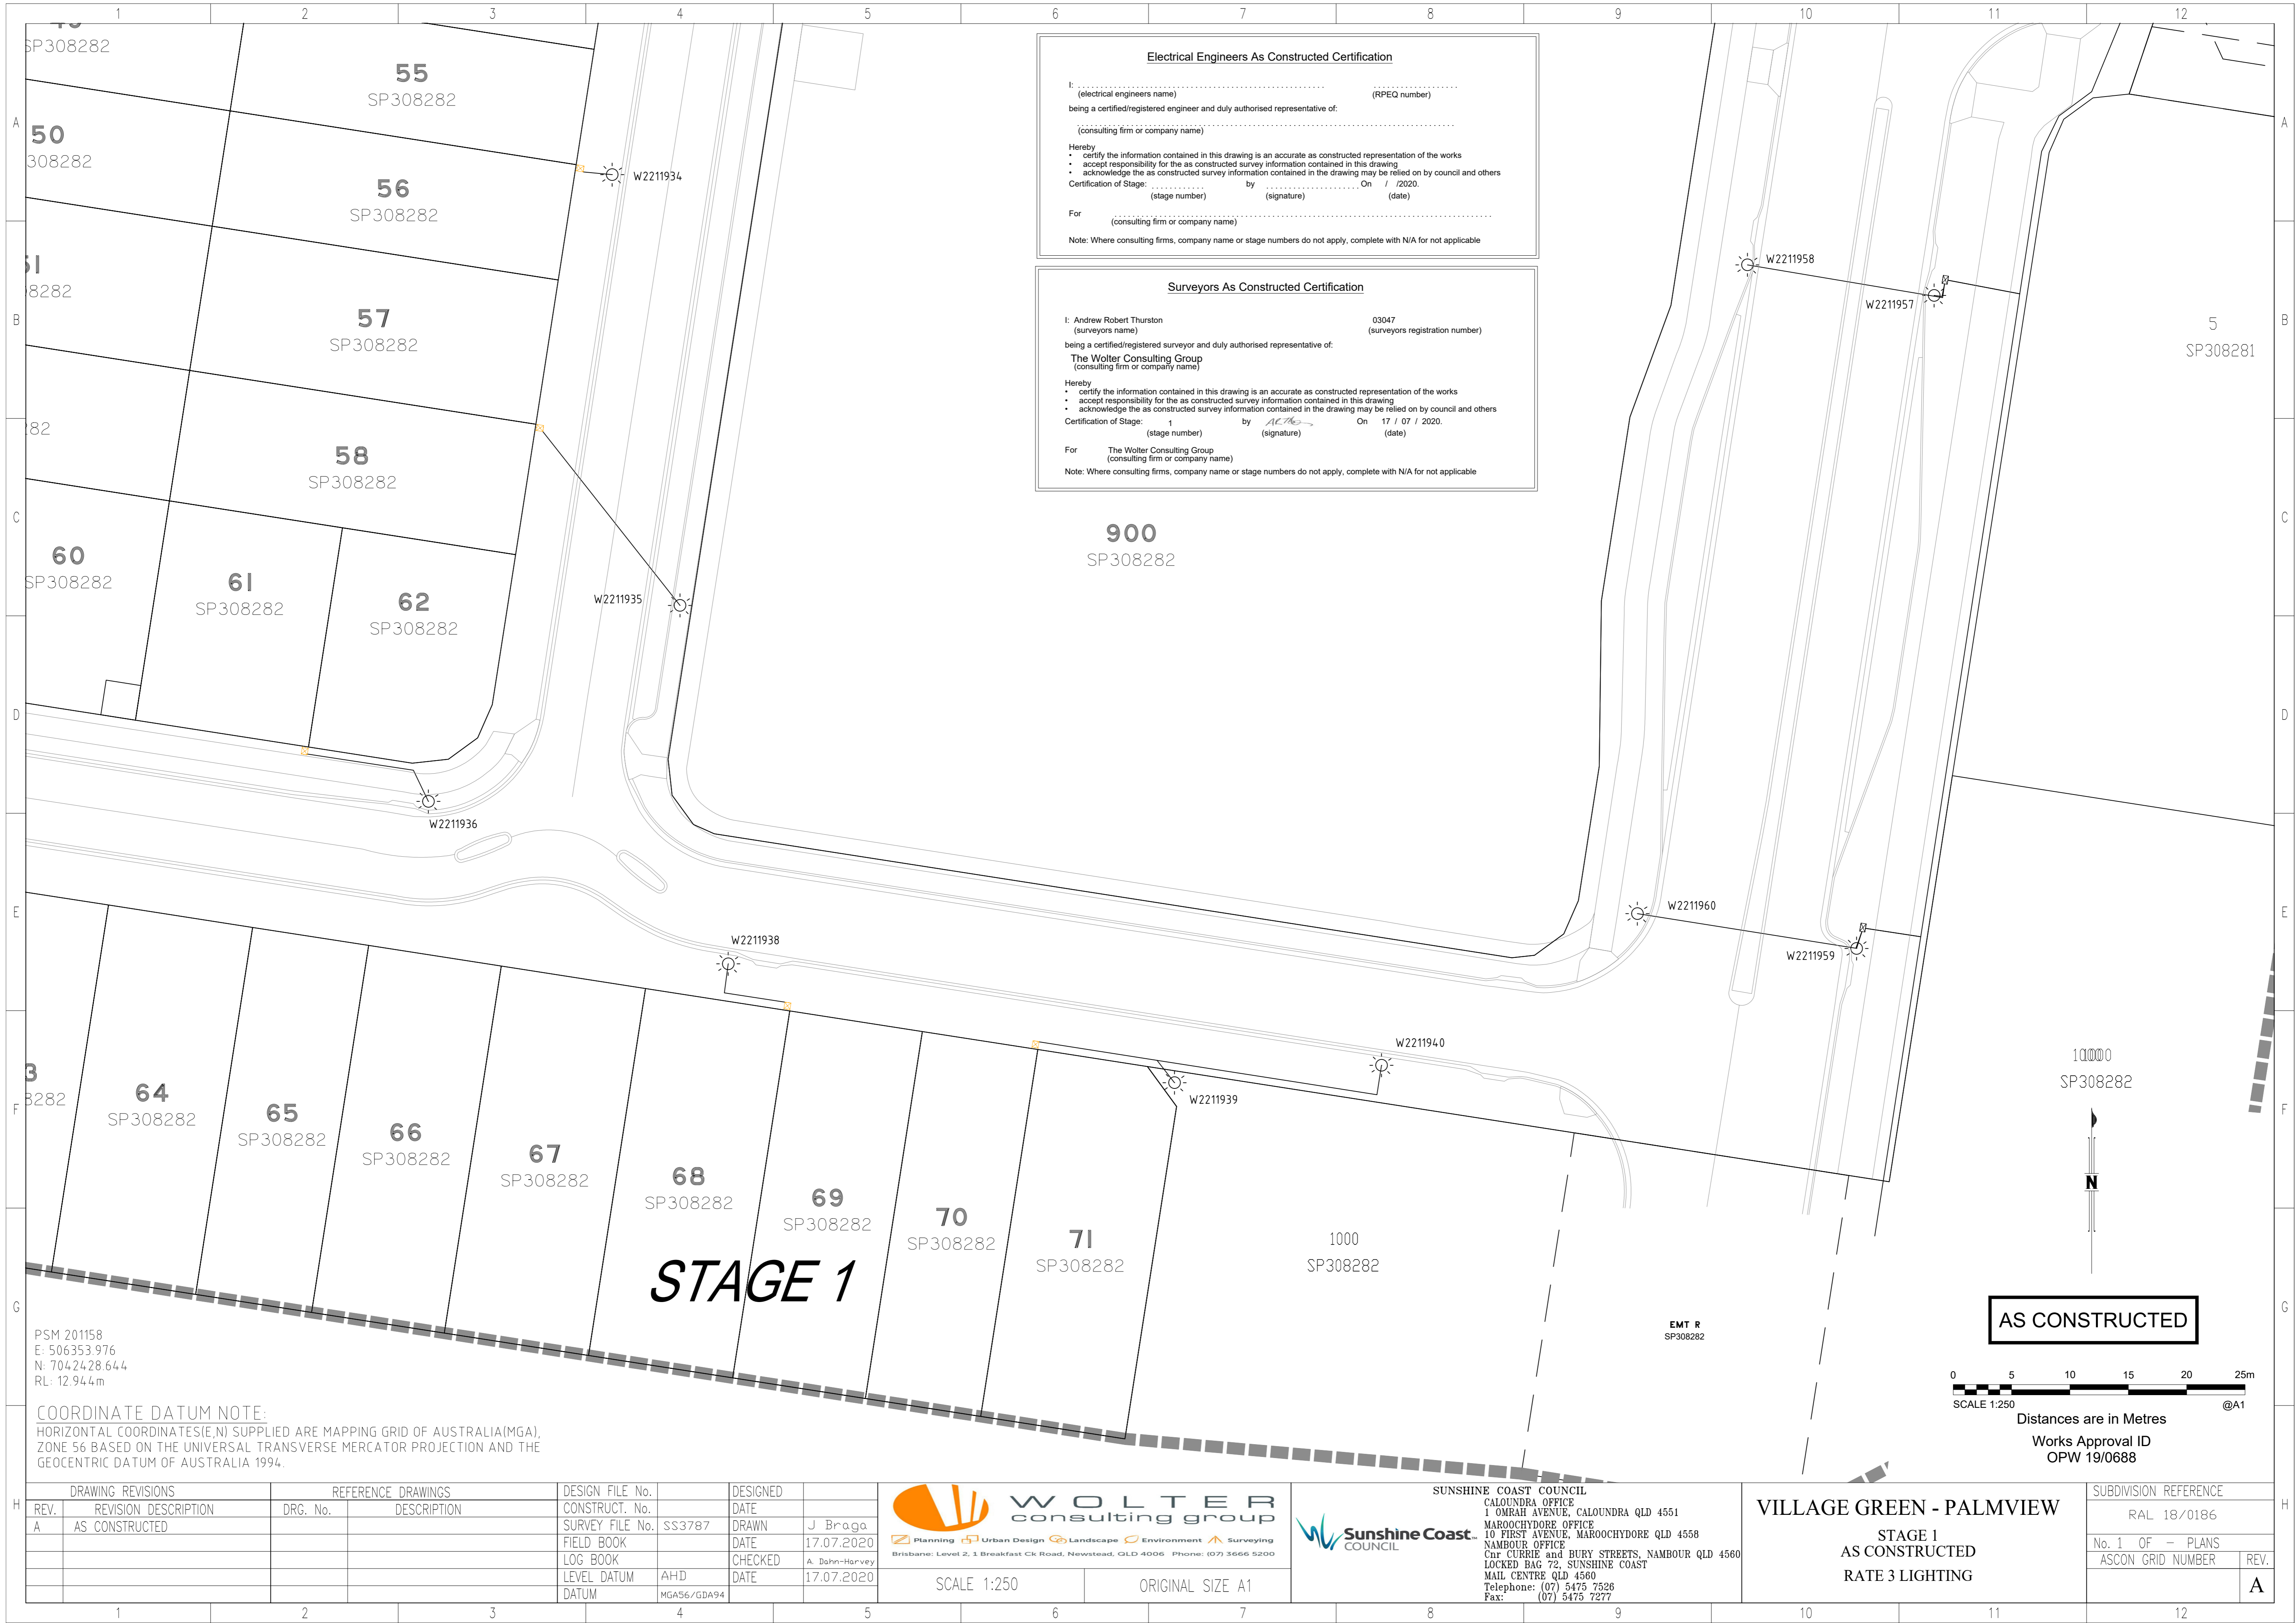

Electrical Engineers As Constructed Certification

I:
 (electrical engineers name) (RPEQ number)
 being a certified/registered engineer and duly authorised representative of:

 (consulting firm or company name)

Hereby
 • certify the information contained in this drawing is an accurate as constructed representation of the works
 • accept responsibility for the as constructed survey information contained in this drawing
 • acknowledge the as constructed survey information contained in the drawing may be relied on by council and others

Certification of Stage: by On / / 2020.
 (stage number) (signature) (date)

For
 (consulting firm or company name)

Note: Where consulting firms, company name or stage numbers do not apply, complete with N/A for not applicable

Surveyors As Constructed Certification

I: Andrew Robert Thurston 03047
 (surveyors name) (surveyors registration number)

being a certified/registered surveyor and duly authorised representative of:
The Wolter Consulting Group
 (consulting firm or company name)

Hereby
 • certify the information contained in this drawing is an accurate as constructed representation of the works
 • accept responsibility for the as constructed survey information contained in this drawing
 • acknowledge the as constructed survey information contained in the drawing may be relied on by council and others

Certification of Stage: 1 by *ACTG* On 17 / 07 / 2020.
 (stage number) (signature) (date)

For The Wolter Consulting Group
 (consulting firm or company name)

Note: Where consulting firms, company name or stage numbers do not apply, complete with N/A for not applicable

PSM 201158
 E: 506353 976
 N: 7042428.644
 RL: 12.944m

COORDINATE DATUM NOTE:
 HORIZONTAL COORDINATES(E,N) SUPPLIED ARE MAPPING GRID OF AUSTRALIA(MGA),
 ZONE 56 BASED ON THE UNIVERSAL TRANSVERSE MERCATOR PROJECTION AND THE
 GEOCENTRIC DATUM OF AUSTRALIA 1994.

10000
 SP308282

N

AS CONSTRUCTED

0 5 10 15 20 25m
 SCALE 1:250 Distances are in Metres @A1

DRAWING REVISIONS		REFERENCE DRAWINGS		DESIGN FILE No.	DESIGNED
REV.	REVISION DESCRIPTION	DRG. No.	DESCRIPTION	CONSTRUCT. No.	DATE
A	AS CONSTRUCTED			SS3787	17.07.2020
				SURVEY FILE No.	J Braga
				FIELD BOOK	DATE 17.07.2020
				LOG BOOK	CHECKED A. Bahn-Harvey
				LEVEL DATUM	DATE 17.07.2020
				DATUM	MGA56/GDA94

WOLTER
 consulting group
 Planning Urban Design Landscape Environment Surveying
 Brisbane: Level 2, 1 Breakfast Ck Road, Newstead, QLD 4006 Phone: (07) 3666 5200

SCALE 1:250 ORIGINAL SIZE A1

SUNSHINE COAST COUNCIL
 CALOUNDRA OFFICE
 1 OMRAH AVENUE, CALOUNDRA QLD 4551
 MAROOCHYDORE OFFICE
 10 FIRST AVENUE, MAROOCHYDORE QLD 4558
 NAMBOUR OFFICE
 Cnr CURRIE and BURY STREETS, NAMBOUR QLD 4560
 LOCKED BAG 72, SUNSHINE COAST
 MAIL CENTRE QLD 4560
 Telephone: (07) 5475 7528
 Fax: (07) 5475 7277

VILLAGE GREEN - PALMVIEW
 STAGE 1
 AS CONSTRUCTED
 RATE 3 LIGHTING

SUBDIVISION REFERENCE	
RAL 18/0186	
No. 1 OF - PLANS	
ASCON GRID NUMBER	REV.
	A