

PSM 201158
 E: 506353.976
 N: 7042428.644
 RL: 12.944m

Surveyors As Constructed Certification

I: Andrew Robert Thurston (surveyors name) 03047 (surveyors registration number)
 being a certified/registered surveyor and duly authorised representative of:
 The Wotter Consulting Group (consulting firm or company name)
 Hereby certify the information contained in this drawing is an accurate as constructed representation of the works
 • accept responsibility for the as constructed survey information contained in this drawing
 • acknowledge the as constructed survey information contained in the drawing may be relied on by council and others
 Certification of Stage: Stage 5 by [Signature] On 16 / 08 / 2021.
 (stage number) (signature) (date)
 For The Wotter Consulting Group (consulting firm or company name)
 Note: Where consulting firms, company name or stage numbers do not apply, complete with N/A for not applicable


Engineers As Constructed Certification

I: (engineers name) (RPEQ number)
 being a certified/registered engineer and duly authorised representative of:
 (consulting firm or company name)
 Hereby certify the information contained in this drawing is an accurate as constructed representation of the works
 • accept responsibility for the as constructed survey information contained in this drawing
 • acknowledge the as constructed survey information contained in the drawing may be relied on by council and others
 Certification of Stage: Stage 5 by [Signature] On /2020.
 (stage number) (signature) (date)
 For (consulting firm or company name)
 Note: Where consulting firms, company name or stage numbers do not apply, complete with N/A for not applicable


LEGEND:

- STORMWATER LINE
- EXISTING STORMWATER LINE
- STORMWATER MANHOLE
- STORMWATER MANHOLE EXTENDED
- STORMWATER PIT
- STORMWATER GULLY PIT
- TOP OF BANK
- BOTTOM OF BANK
- CHANGE OF GRADE
- CONTOURS
- SPOT HEIGHT
- BARRIER CONTINUOUS
- BARRIER
- SIGN
- KERB LINE BACK OF KERB
- KERB LINE INVERT OF KERB
- KERB LINE LIP OF KERB
- ROAD CENTRE LINE
- SUB SOIL DRAIN
- RETAINING WALL BASE

COORDINATE DATUM NOTE:
 HORIZONTAL COORDINATES(E,N) SUPPLIED ARE MAPPING GRID OF AUSTRALIA(MGA),
 ZONE 56 BASED ON THE UNIVERSAL TRANSVERSE MERCATOR PROJECTION AND THE
 GEOCENTRIC DATUM OF AUSTRALIA 1994.

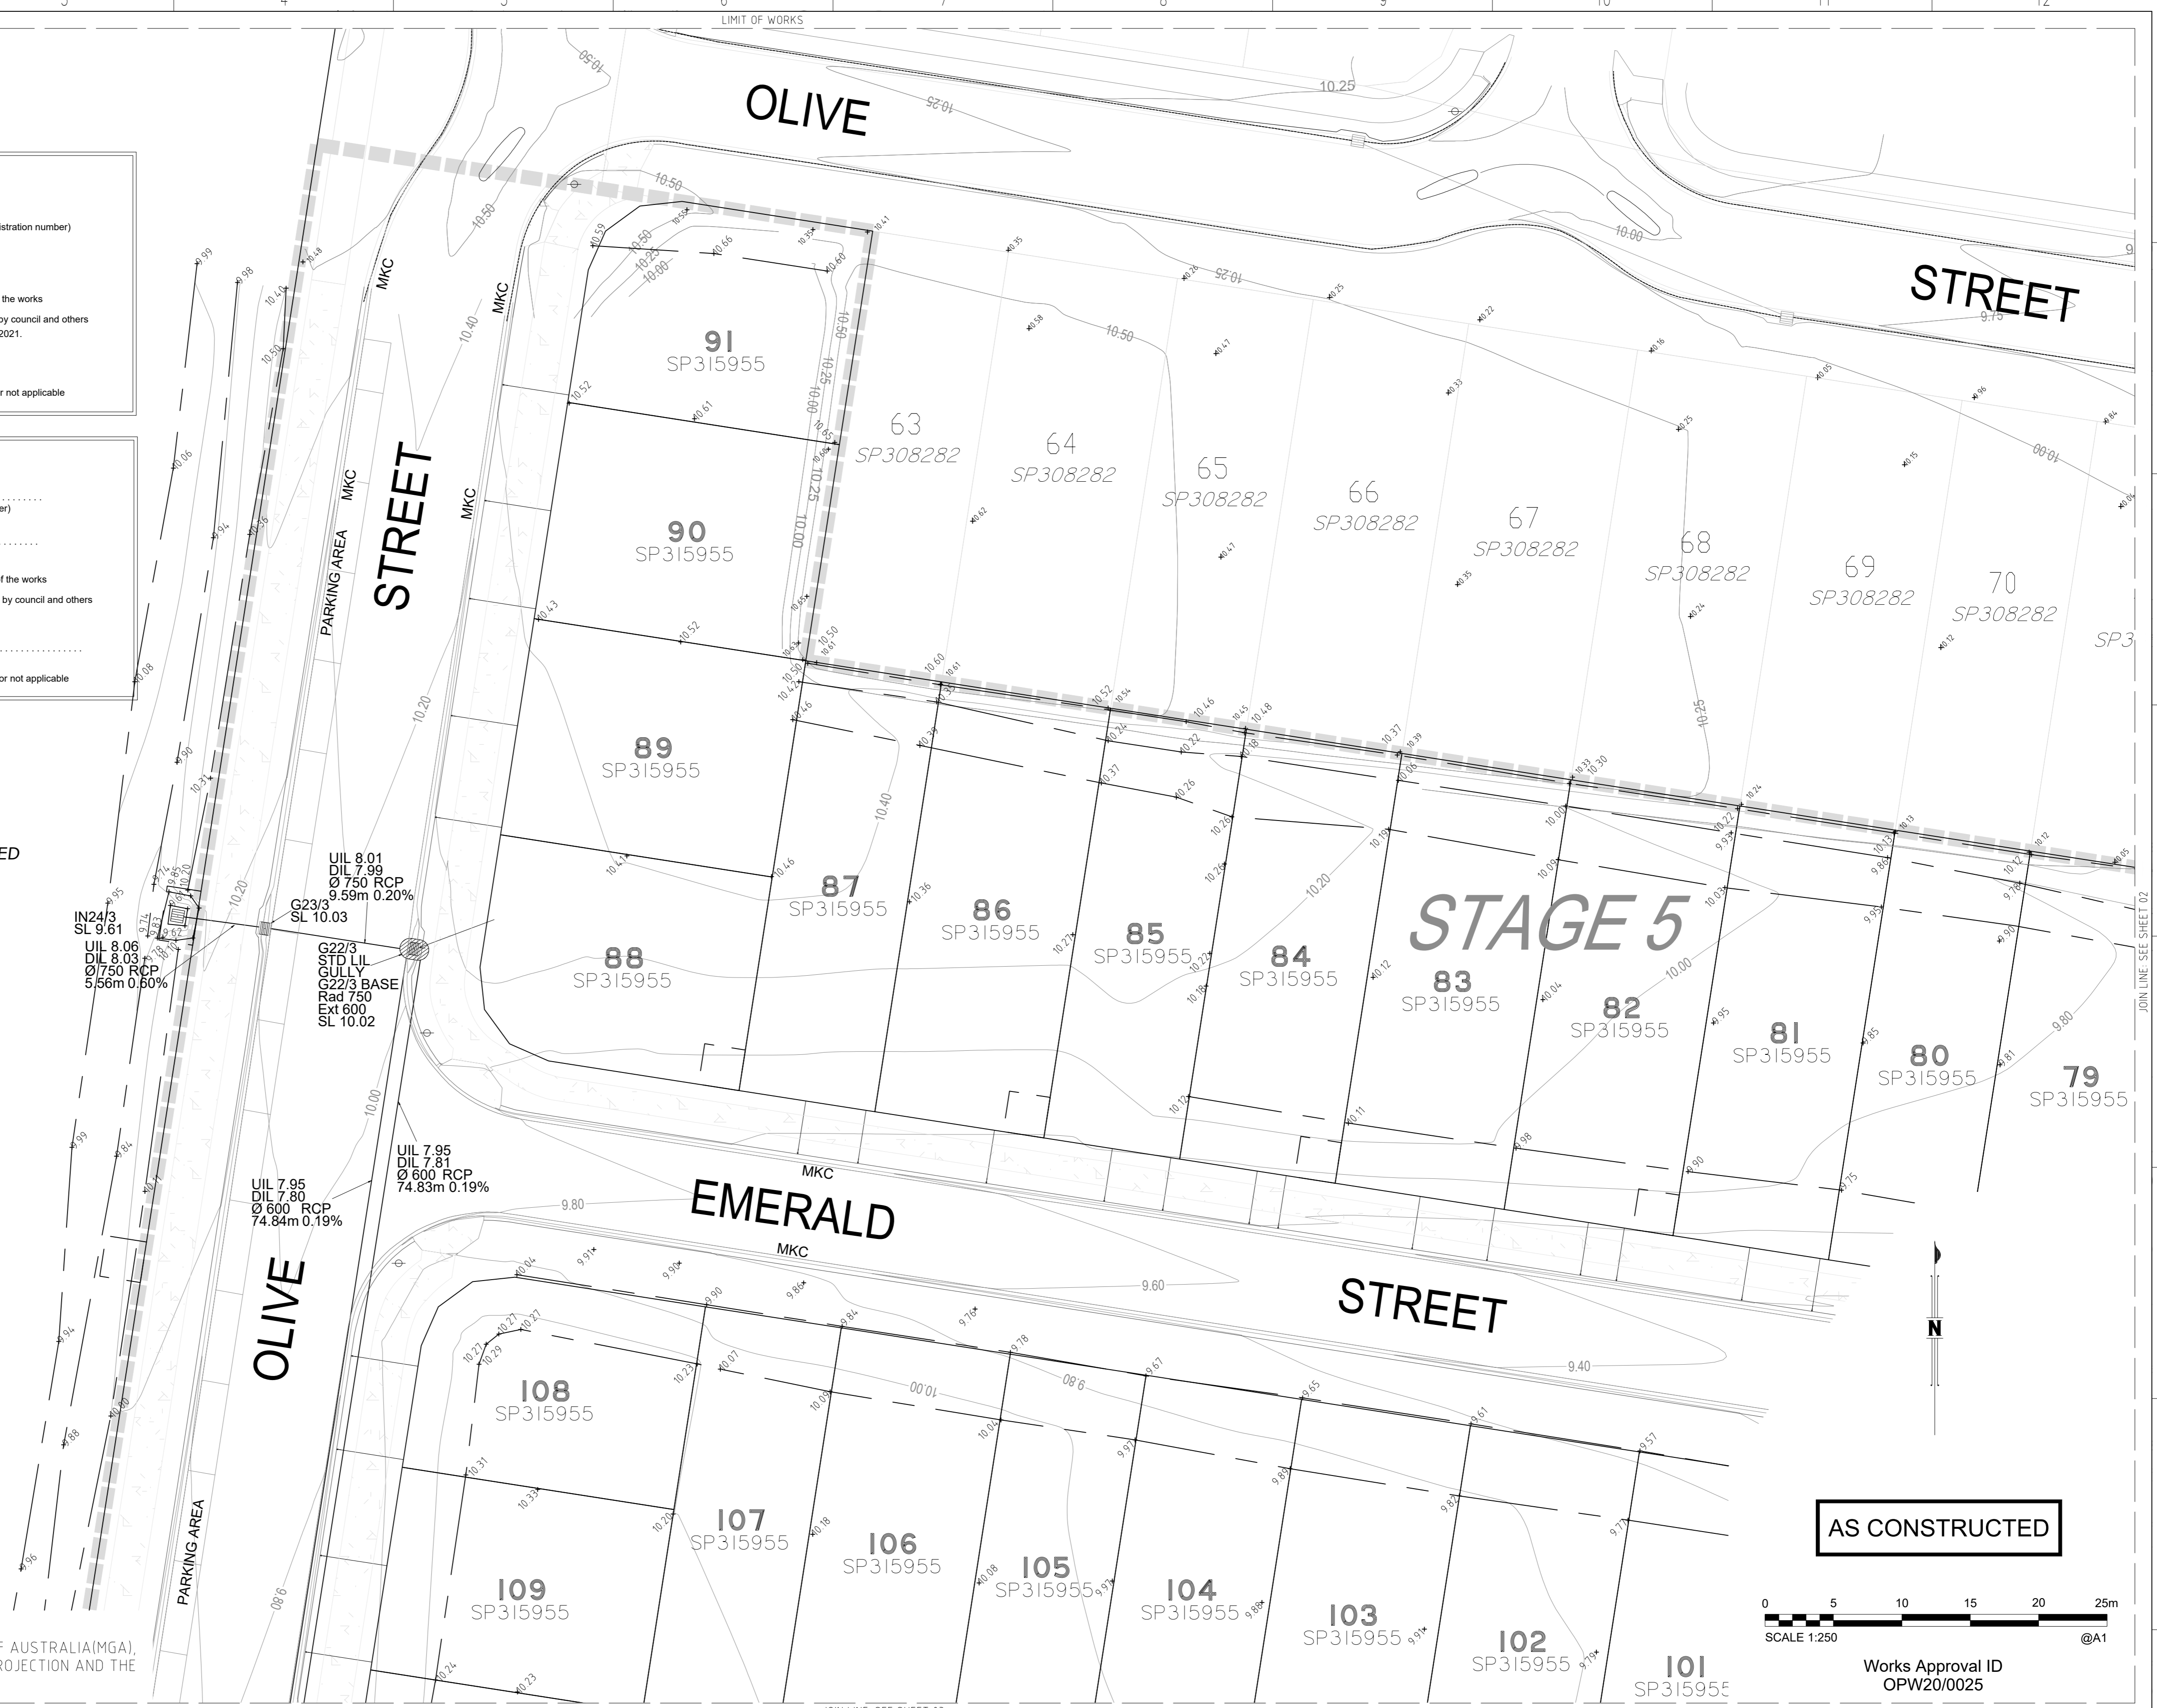

AS CONSTRUCTED

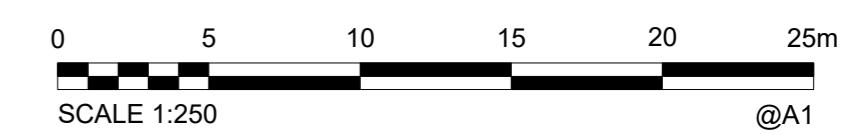

Works Approval ID
 OPW20/0025

DRAWING REVISIONS		REFERENCE DRAWINGS		DESIGN FILE No.	DESIGNED
REV.	REVISION DESCRIPTION	DRG. No.	DESCRIPTION	CONSTRUCT. No.	DATE
A	AS CONSTRUCTED			SS3787/5	JWB
				FIELD BOOK	DATE 16.08.2021
				LOG BOOK	CHECKED ADH
				LEVEL DATUM	DATE 16.08.2021
				DATUM	MGA-56

DESIGNED	JWB
DRAWN	JWB
CHECKED	ADH
DATE	16.08.2021

WOLTER consulting group
 Planning Urban Design Landscape Environment Surveying
 Brisbane: Level 2, 1 Breakfast Ck Road, Newstead, QLD 4006 Phone: (07) 3666 5200

SCALE 1:250 ORIGINAL SIZE A1

SUNSHINE COAST COUNCIL
 CALOUNDRA OFFICE
 1 OMRAH AVENUE, CALOUNDRA QLD 4551
 MAROOCHYDORE OFFICE
 10 FIRST AVENUE, MAROOCHYDORE QLD 4558
 NAMBOUR OFFICE
 Chr CURRIE and BURY STREETS, NAMBOUR QLD 4560
 LOCKED BAG 72, SUNSHINE COAST
 MAIL CENTRE QLD 4560
 Telephone: (07) 5475 7528
 Fax: (07) 5475 7277

VILLAGE GREEN
 STAGE 5
 AS CONSTRUCTED
 ROADS, DRAINAGE AND SURFACE

SUBDIVISION REFERENCE	
RAL 20/0025 SCC	
No. 1 OF 9 PLANS	
ASCON GRID NUMBER	REV.
	A



Surveyors As Constructed Certification

I: Andrew Robert Thurston (surveyors name) 03047 (surveyors registration number)
 being a certified/registered surveyor and duly authorised representative of:
 The Wolter Consulting Group (consulting firm or company name)

Hereby
 • certify the information contained in this drawing is an accurate as constructed representation of the works
 • accept responsibility for the as constructed survey information contained in this drawing
 • acknowledge the as constructed survey information contained in the drawing may be relied on by council and others

Certification of Stage: Stage 5 by A.R.T. On 16 / 08 / 2021.
 (stage number) (signature) (date)

For The Wolter Consulting Group (consulting firm or company name)

Note: Where consulting firms, company name or stage numbers do not apply, complete with N/A for not applicable

Engineers As Constructed Certification

I: (engineers name) (RPEQ number)
 being a certified/registered engineer and duly authorised representative of:
 (consulting firm or company name)



Hereby
 • certify the information contained in this drawing is an accurate as constructed representation of the works
 • accept responsibility for the as constructed survey information contained in this drawing
 • acknowledge the as constructed survey information contained in the drawing may be relied on by council and others

Certification of Stage: (stage number) by (signature) On (date)

For (consulting firm or company name)

Note: Where consulting firms, company name or stage numbers do not apply, complete with N/A for not applicable

- LEGEND:**
- STORMWATER LINE
 - EXISTING STORMWATER LINE
 - STORMWATER MANHOLE
 - STORMWATER MANHOLE EXTENDED
 - STORMWATER PIT
 - STORMWATER GULLY PIT
 - TOP OF BANK
 - BOTTOM OF BANK
 - CHANGE OF GRADE
 - CONTOURS
 - SPOT HEIGHT
 - BARRIER CONTINUOUS
 - BARRIER
 - SIGN
 - KERB LINE BACK OF KERB
 - KERB LINE INVERT OF KERB
 - KERB LINE LIP OF KERB
 - ROAD CENTRE LINE
 - SUB SOIL DRAIN
 - RETAINING WALL BASE

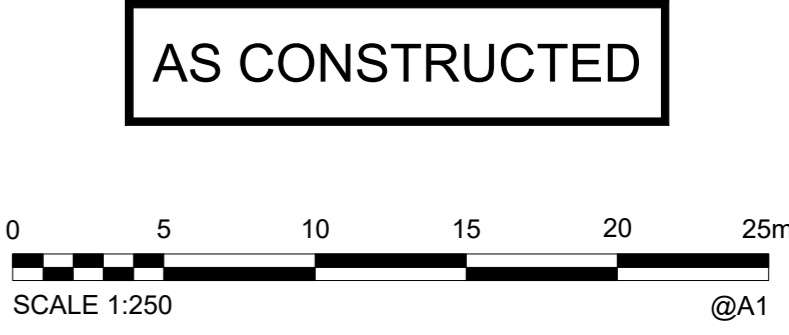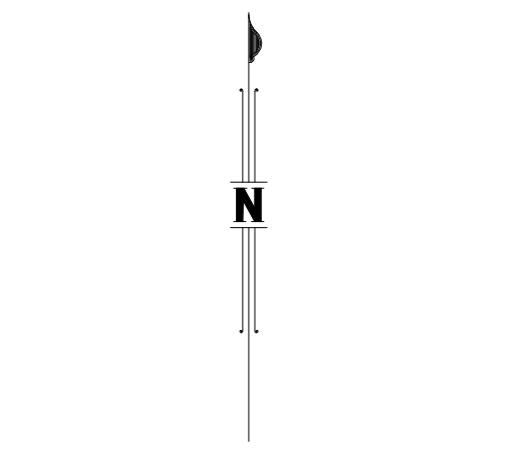

Works Approval ID
OPW20/0025

COORDINATE DATUM NOTE:
 HORIZONTAL COORDINATES(E,N) SUPPLIED ARE MAPPING GRID OF AUSTRALIA(MGA), ZONE 56 BASED ON THE UNIVERSAL TRANSVERSE MERCATOR PROJECTION AND THE GEOCENTRIC DATUM OF AUSTRALIA 1994.

DRAWING REVISIONS		REFERENCE DRAWINGS		DESIGN FILE No.	DESIGNED DATE
REV.	REVISION DESCRIPTION	DRG. No.	DESCRIPTION	CONSTRUCT. No.	DATE
A	AS CONSTRUCTED			SS3787/5	JWB
				FIELD BOOK	16.08.2021
				LOG BOOK	CHECKED ADH
				LEVEL DATUM	DATE 16.08.2021
				DATUM	MGA-56

WOLTER consulting group

Planning Urban Design Landscape Environment Surveying

Brisbane: Level 2, 1 Breakfast Ck Road, Newstead, QLD 4006 Phone: (07) 3666 5200

SCALE 1:250 ORIGINAL SIZE A1

SUNSHINE COAST COUNCIL

CALOUNDRA OFFICE
1 OMRAH AVENUE, CALOUNDRA QLD 4551

MAROOCHYDORE OFFICE
10 FIRST AVENUE, MAROOCHYDORE QLD 4558

NAMBOUR OFFICE
CHR CURRIE and BURY STREETS, NAMBOUR QLD 4560

LOCKED BAG 72, SUNSHINE COAST
MAIL CENTRE QLD 4560

Telephone: (07) 5475 7528
Fax: (07) 5475 7277

VILLAGE GREEN


STAGE 5
AS CONSTRUCTED
ROADS, DRAINAGE AND SURFACE

SUBDIVISION REFERENCE	
RAL 20/0025 SCC	
No. 2 OF 9 PLANS	
ASCON GRID NUMBER	REV.
	A

PSM 201158
 E: 506353.976
 N: 7042428.644
 RL: 12.944m

JOIN LINE: SEE SHEET 01

JOIN LINE: SEE SHEET 04

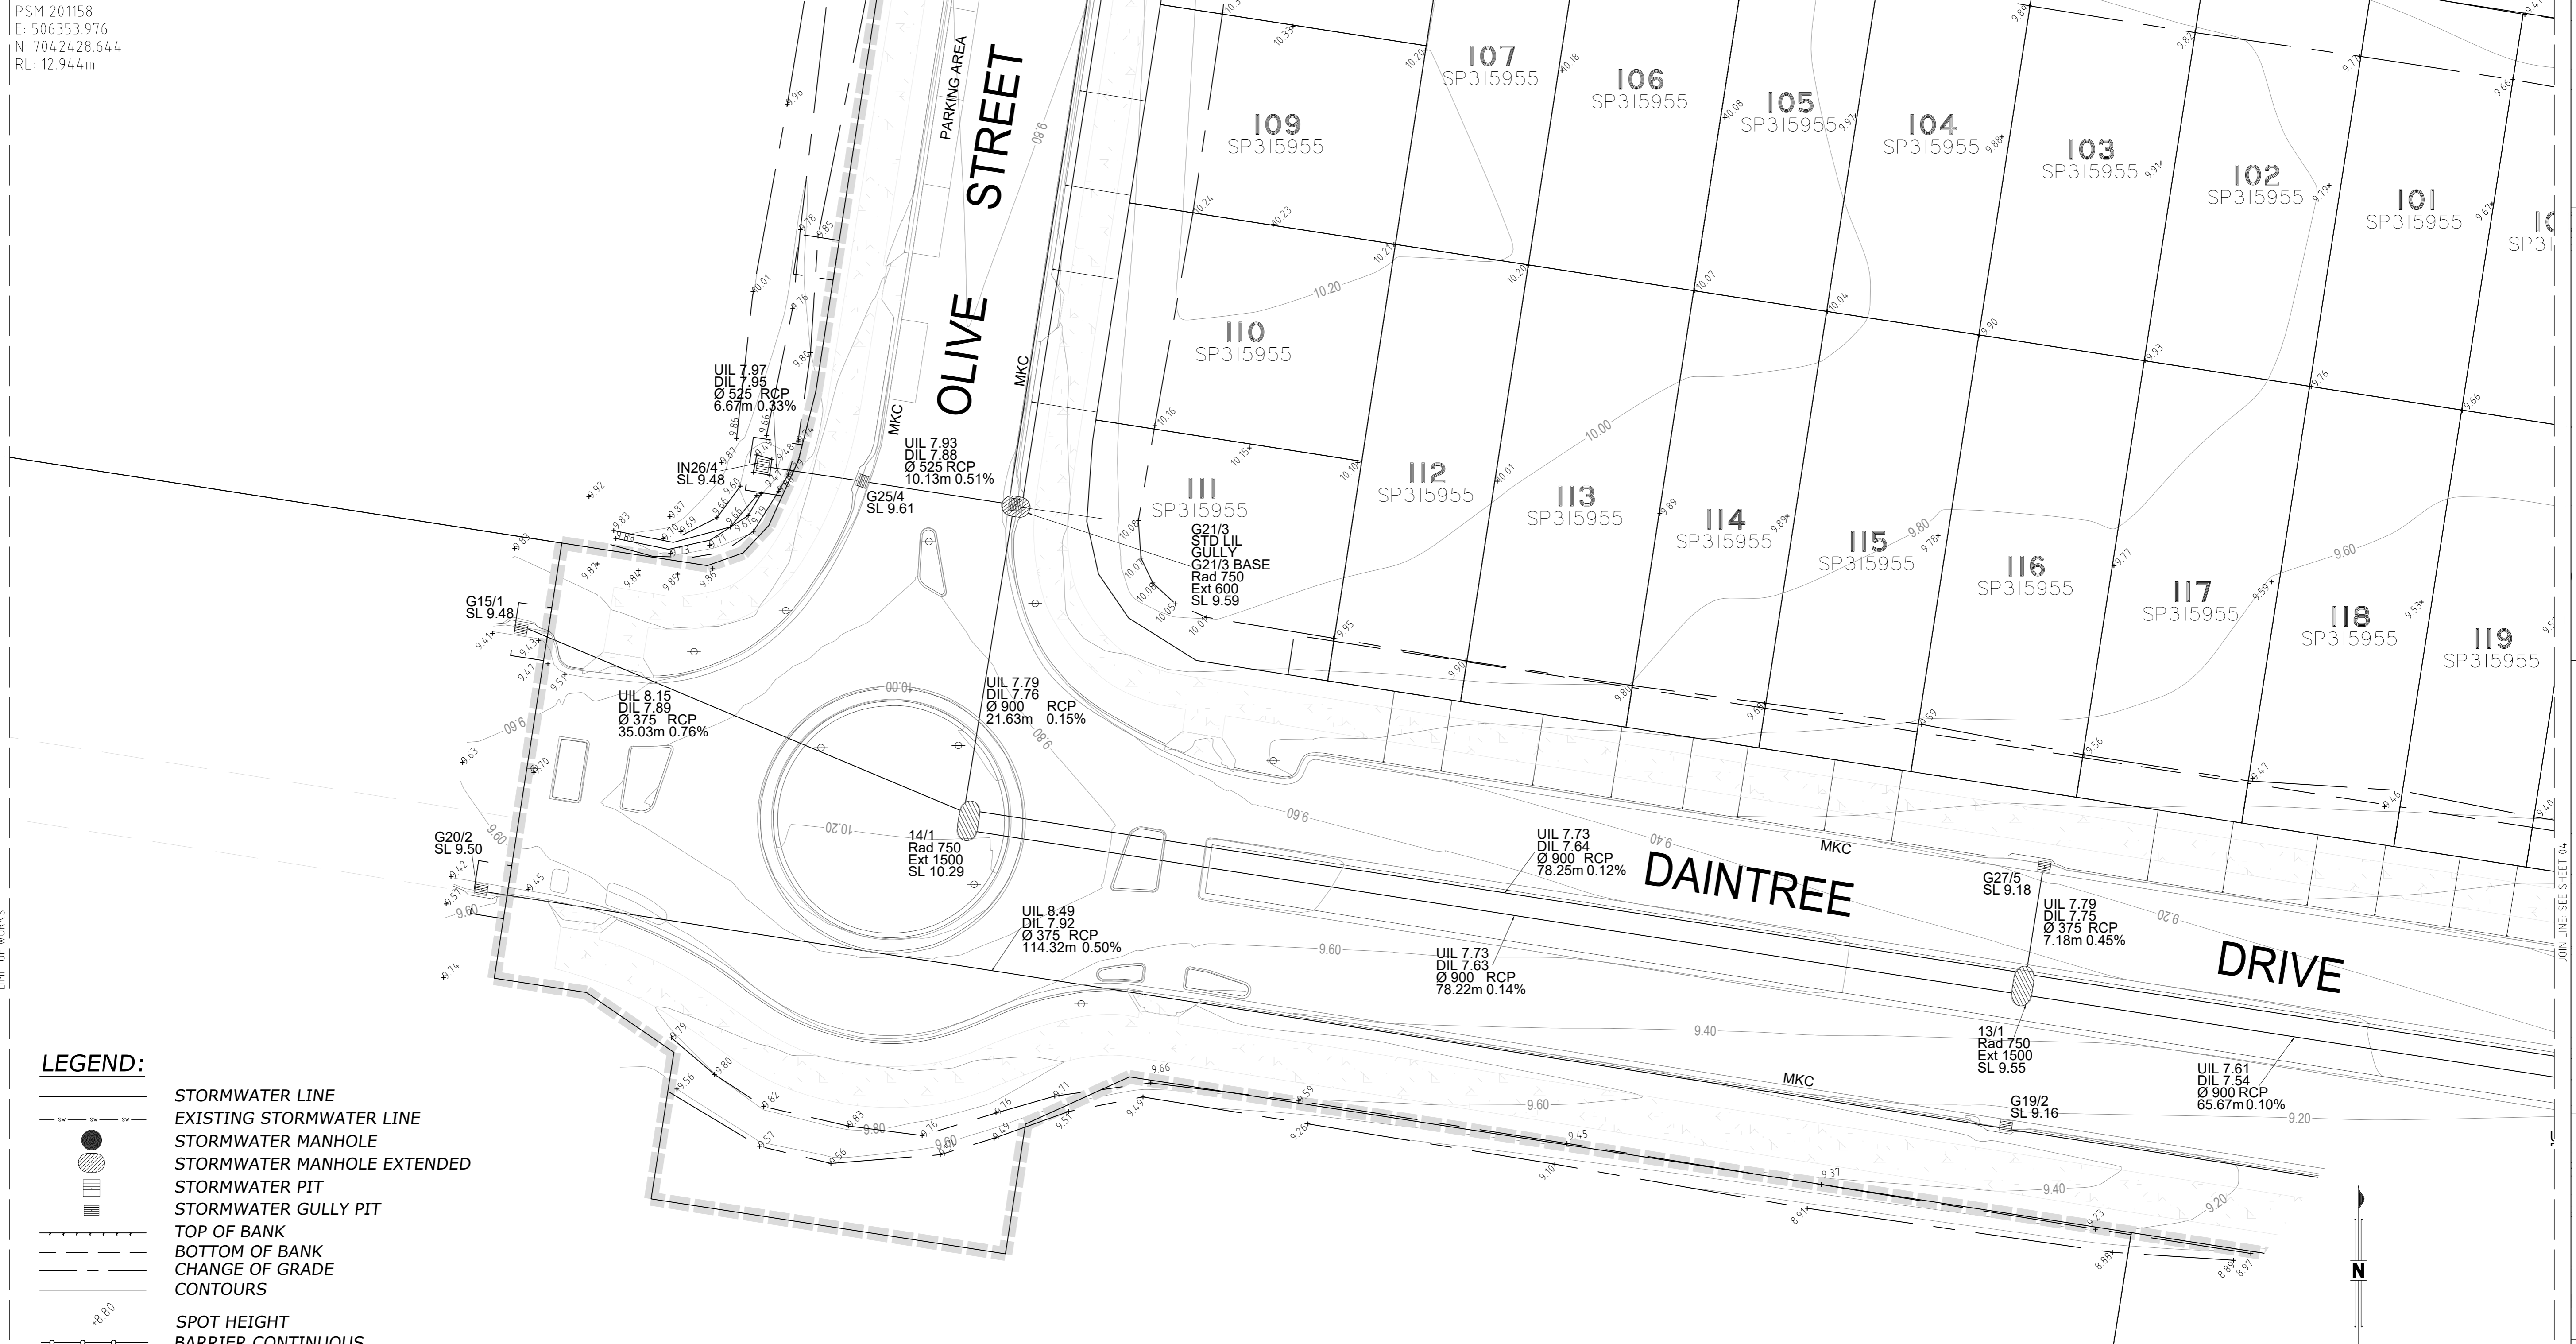

LEGEND:

- STORMWATER LINE
- EXISTING STORMWATER LINE
- STORMWATER MANHOLE
- STORMWATER MANHOLE EXTENDED
- STORMWATER PIT
- STORMWATER GULLY PIT
- TOP OF BANK
- BOTTOM OF BANK
- CHANGE OF GRADE
- CONTOURS
- SPOT HEIGHT
- BARRIER CONTINUOUS
- BARRIER
- SIGN
- KERB LINE BACK OF KERB
- KERB LINE INVERT OF KERB
- KERB LINE LIP OF KERB
- ROAD CENTRE LINE
- SUB SOIL DRAIN
- RETAINING WALL BASE

COORDINATE DATUM NOTE:
 HORIZONTAL COORDINATES(E,N) SUPPLIED ARE MAPPING GRID OF AUSTRALIA(MGA),
 ZONE 56 BASED ON THE UNIVERSAL TRANSVERSE MERCATOR PROJECTION AND THE
 GEOCENTRIC DATUM OF AUSTRALIA 1994.

Surveyors As Constructed Certification

I, Andrew Robert Thurston (surveyors name) 03047 (surveyors registration number)
 being a certified/registered surveyor and duly authorised representative of:
 The Wolter Consulting Group (consulting firm or company name)

Hereby
 • certify the information contained in this drawing is an accurate as constructed representation of the works
 • accept responsibility for the as constructed survey information contained in this drawing
 • acknowledge the as constructed survey information contained in the drawing may be relied on by council and others

Certification of Stage: Stage 5 by *ACT* On 16 / 08 / 2021.
 (stage number) (signature) (date)

For The Wolter Consulting Group (consulting firm or company name)
 Note: Where consulting firms, company name or stage numbers do not apply, complete with N/A for not applicable

Engineers As Constructed Certification


I, (engineers name) (RPEQ number)
 being a certified/registered engineer and duly authorised representative of:
 (consulting firm or company name)

Hereby
 • certify the information contained in this drawing is an accurate as constructed representation of the works
 • accept responsibility for the as constructed survey information contained in this drawing
 • acknowledge the as constructed survey information contained in the drawing may be relied on by council and others

Certification of Stage: by On / / 2020.
 (stage number) (signature) (date)

For (consulting firm or company name)
 Note: Where consulting firms, company name or stage numbers do not apply, complete with N/A for not applicable

AS CONSTRUCTED

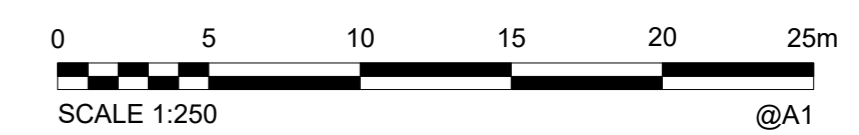

Works Approval ID
 OPW20/0025

DRAWING REVISIONS		REFERENCE DRAWINGS		DESIGN FILE No.	DESIGNED	
REV.	REVISION DESCRIPTION	DRG. No.	DESCRIPTION	CONSTRUCT. No.	DATE	
A	AS CONSTRUCTED			SS3787/5	16.08.2021	JWB
				FIELD BOOK	CHECKED	ADH
				LOG BOOK	DATE	16.08.2021
				LEVEL DATUM	AHD	
				DATUM	MGA-56	


WOLTER
 consulting group
 Planning Urban Design Landscape Environment Surveying
 Brisbane: Level 2, 1 Breakfast Ck Road, Newstead, QLD 4006 Phone: (07) 3666 5200

SCALE 1:250 ORIGINAL SIZE A1

SUNSHINE COAST COUNCIL
 CALOUNDRA OFFICE
 1 OMRAH AVENUE, CALOUNDRA QLD 4551
 MAROOCHYDORE OFFICE
 10 FIRST AVENUE, MAROOCHYDORE QLD 4558
 NAMBOUR OFFICE
 CAR CURRIE and BURY STREETS, NAMBOUR QLD 4560
 LOCKED BAG 72, SUNSHINE COAST
 MAIL CENTRE QLD 4560
 Telephone: (07) 5475 7528
 Fax: (07) 5475 7277

VILLAGE GREEN
 STAGE 5
 AS CONSTRUCTED
 ROADS, DRAINAGE AND SURFACE

SUBDIVISION REFERENCE	
RAL 20/0025 SCC	
No. 3 OF 9 PLANS	
ASCON GRID NUMBER	REV.
	A

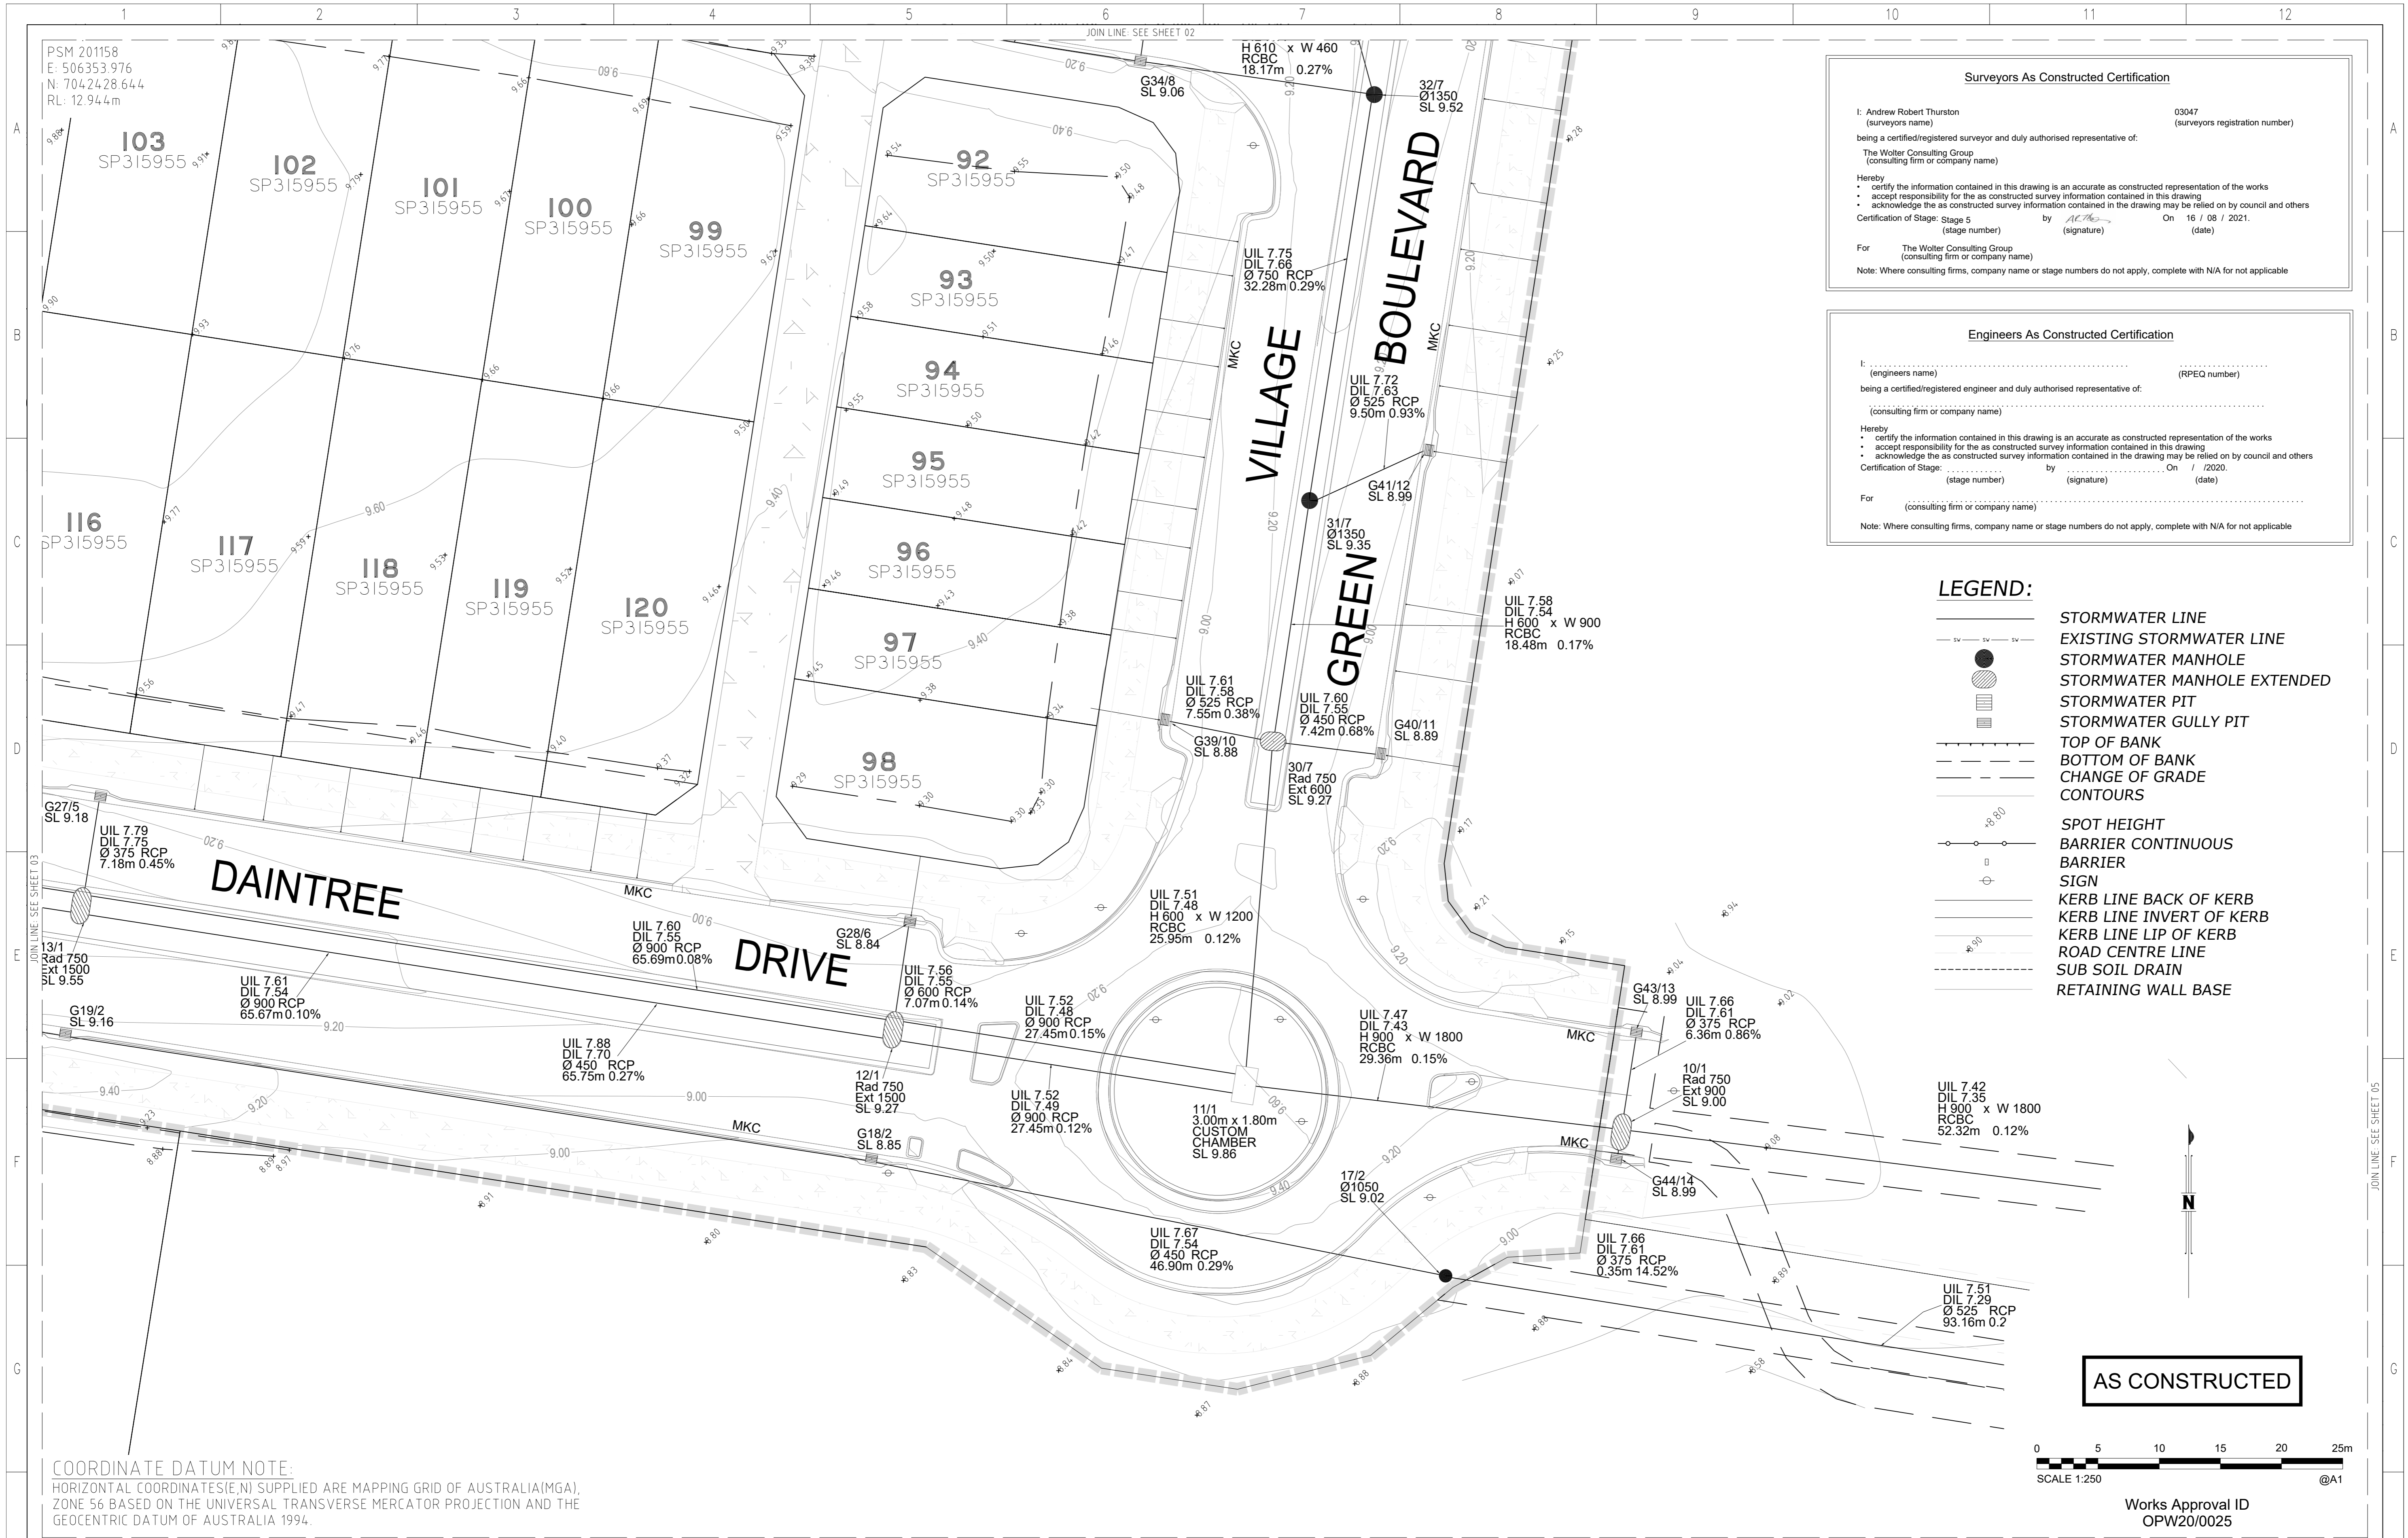

Surveyors As Constructed Certification

I: Andrew Robert Thurston (surveyors name) 03047 (surveyors registration number)
 being a certified/registered surveyor and duly authorised representative of:
 The Wotter Consulting Group (consulting firm or company name)

Herby
 • certify the information contained in this drawing is an accurate as constructed representation of the works
 • accept responsibility for the as constructed survey information contained in this drawing
 • acknowledge the as constructed survey information contained in the drawing may be relied on by council and others

Certification of Stage: Stage 5 by *ATG* On 16 / 08 / 2021.
 (stage number) (signature) (date)

For The Wotter Consulting Group (consulting firm or company name)
 Note: Where consulting firms, company name or stage numbers do not apply, complete with N/A for not applicable

Engineers As Constructed Certification

I: (engineers name) (RPEQ number)
 being a certified/registered engineer and duly authorised representative of:
 (consulting firm or company name)


Herby
 • certify the information contained in this drawing is an accurate as constructed representation of the works
 • accept responsibility for the as constructed survey information contained in this drawing
 • acknowledge the as constructed survey information contained in the drawing may be relied on by council and others

Certification of Stage: (stage number) by (signature) On (date) / 2021.

For (consulting firm or company name)
 Note: Where consulting firms, company name or stage numbers do not apply, complete with N/A for not applicable

- LEGEND:**
- STORMWATER LINE
 - EXISTING STORMWATER LINE
 - STORMWATER MANHOLE
 - STORMWATER MANHOLE EXTENDED
 - STORMWATER PIT
 - STORMWATER GULLY PIT
 - TOP OF BANK
 - BOTTOM OF BANK
 - CHANGE OF GRADE
 - CONTOURS
 - SPOT HEIGHT
 - BARRIER CONTINUOUS
 - BARRIER
 - SIGN
 - KERB LINE BACK OF KERB
 - KERB LINE INVERT OF KERB
 - KERB LINE LIP OF KERB
 - ROAD CENTRE LINE
 - SUB SOIL DRAIN
 - RETAINING WALL BASE

AS CONSTRUCTED

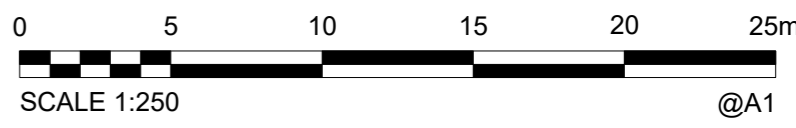

Works Approval ID
OPW20/0025

COORDINATE DATUM NOTE:
 HORIZONTAL COORDINATES(E,N) SUPPLIED ARE MAPPING GRID OF AUSTRALIA(MGA),
 ZONE 56 BASED ON THE UNIVERSAL TRANSVERSE MERCATOR PROJECTION AND THE
 GEOCENTRIC DATUM OF AUSTRALIA 1994.

DRAWING REVISIONS		REFERENCE DRAWINGS		DESIGN FILE No.	DESIGNED	
REV.	REVISION DESCRIPTION	DRG. No.	DESCRIPTION	CONSTRUCT. No.	DATE	
A	AS CONSTRUCTED			SS3787/5	DRAWN	JWB
					DATE	16.08.2021
					CHECKED	ADH
					DATE	16.08.2021
				LEVEL DATUM	AHD	
				DATUM	MGA-56	

WOLTER
consulting group

Planning Urban Design Landscape Environment Surveying

Brisbane: Level 2, 1 Breakfast Ck Road, Newstead, QLD 4006 Phone: (07) 3666 5200

SCALE 1:250 ORIGINAL SIZE A1

SUNSHINE COAST COUNCIL

CALOUNDRA OFFICE
1 OMRAH AVENUE, CALOUNDRA QLD 4551

MAROOCHYDORE OFFICE
10 FIRST AVENUE, MAROOCHYDORE QLD 4558

NAMBOUR OFFICE
Cnr CURRIE and BURY STREETS, NAMBOUR QLD 4560


LOCKED BAG 72, SUNSHINE COAST
MAIL CENTRE QLD 4560

Telephone: (07) 5475 7528
Fax: (07) 5475 7277

VILLAGE GREEN

STAGE 5
AS CONSTRUCTED
ROADS, DRAINAGE AND SURFACE

SUBDIVISION REFERENCE	
RAL 20/0025 SCC	
No. 4 OF 9 PLANS	
ASCON GRID NUMBER	REV.
	A

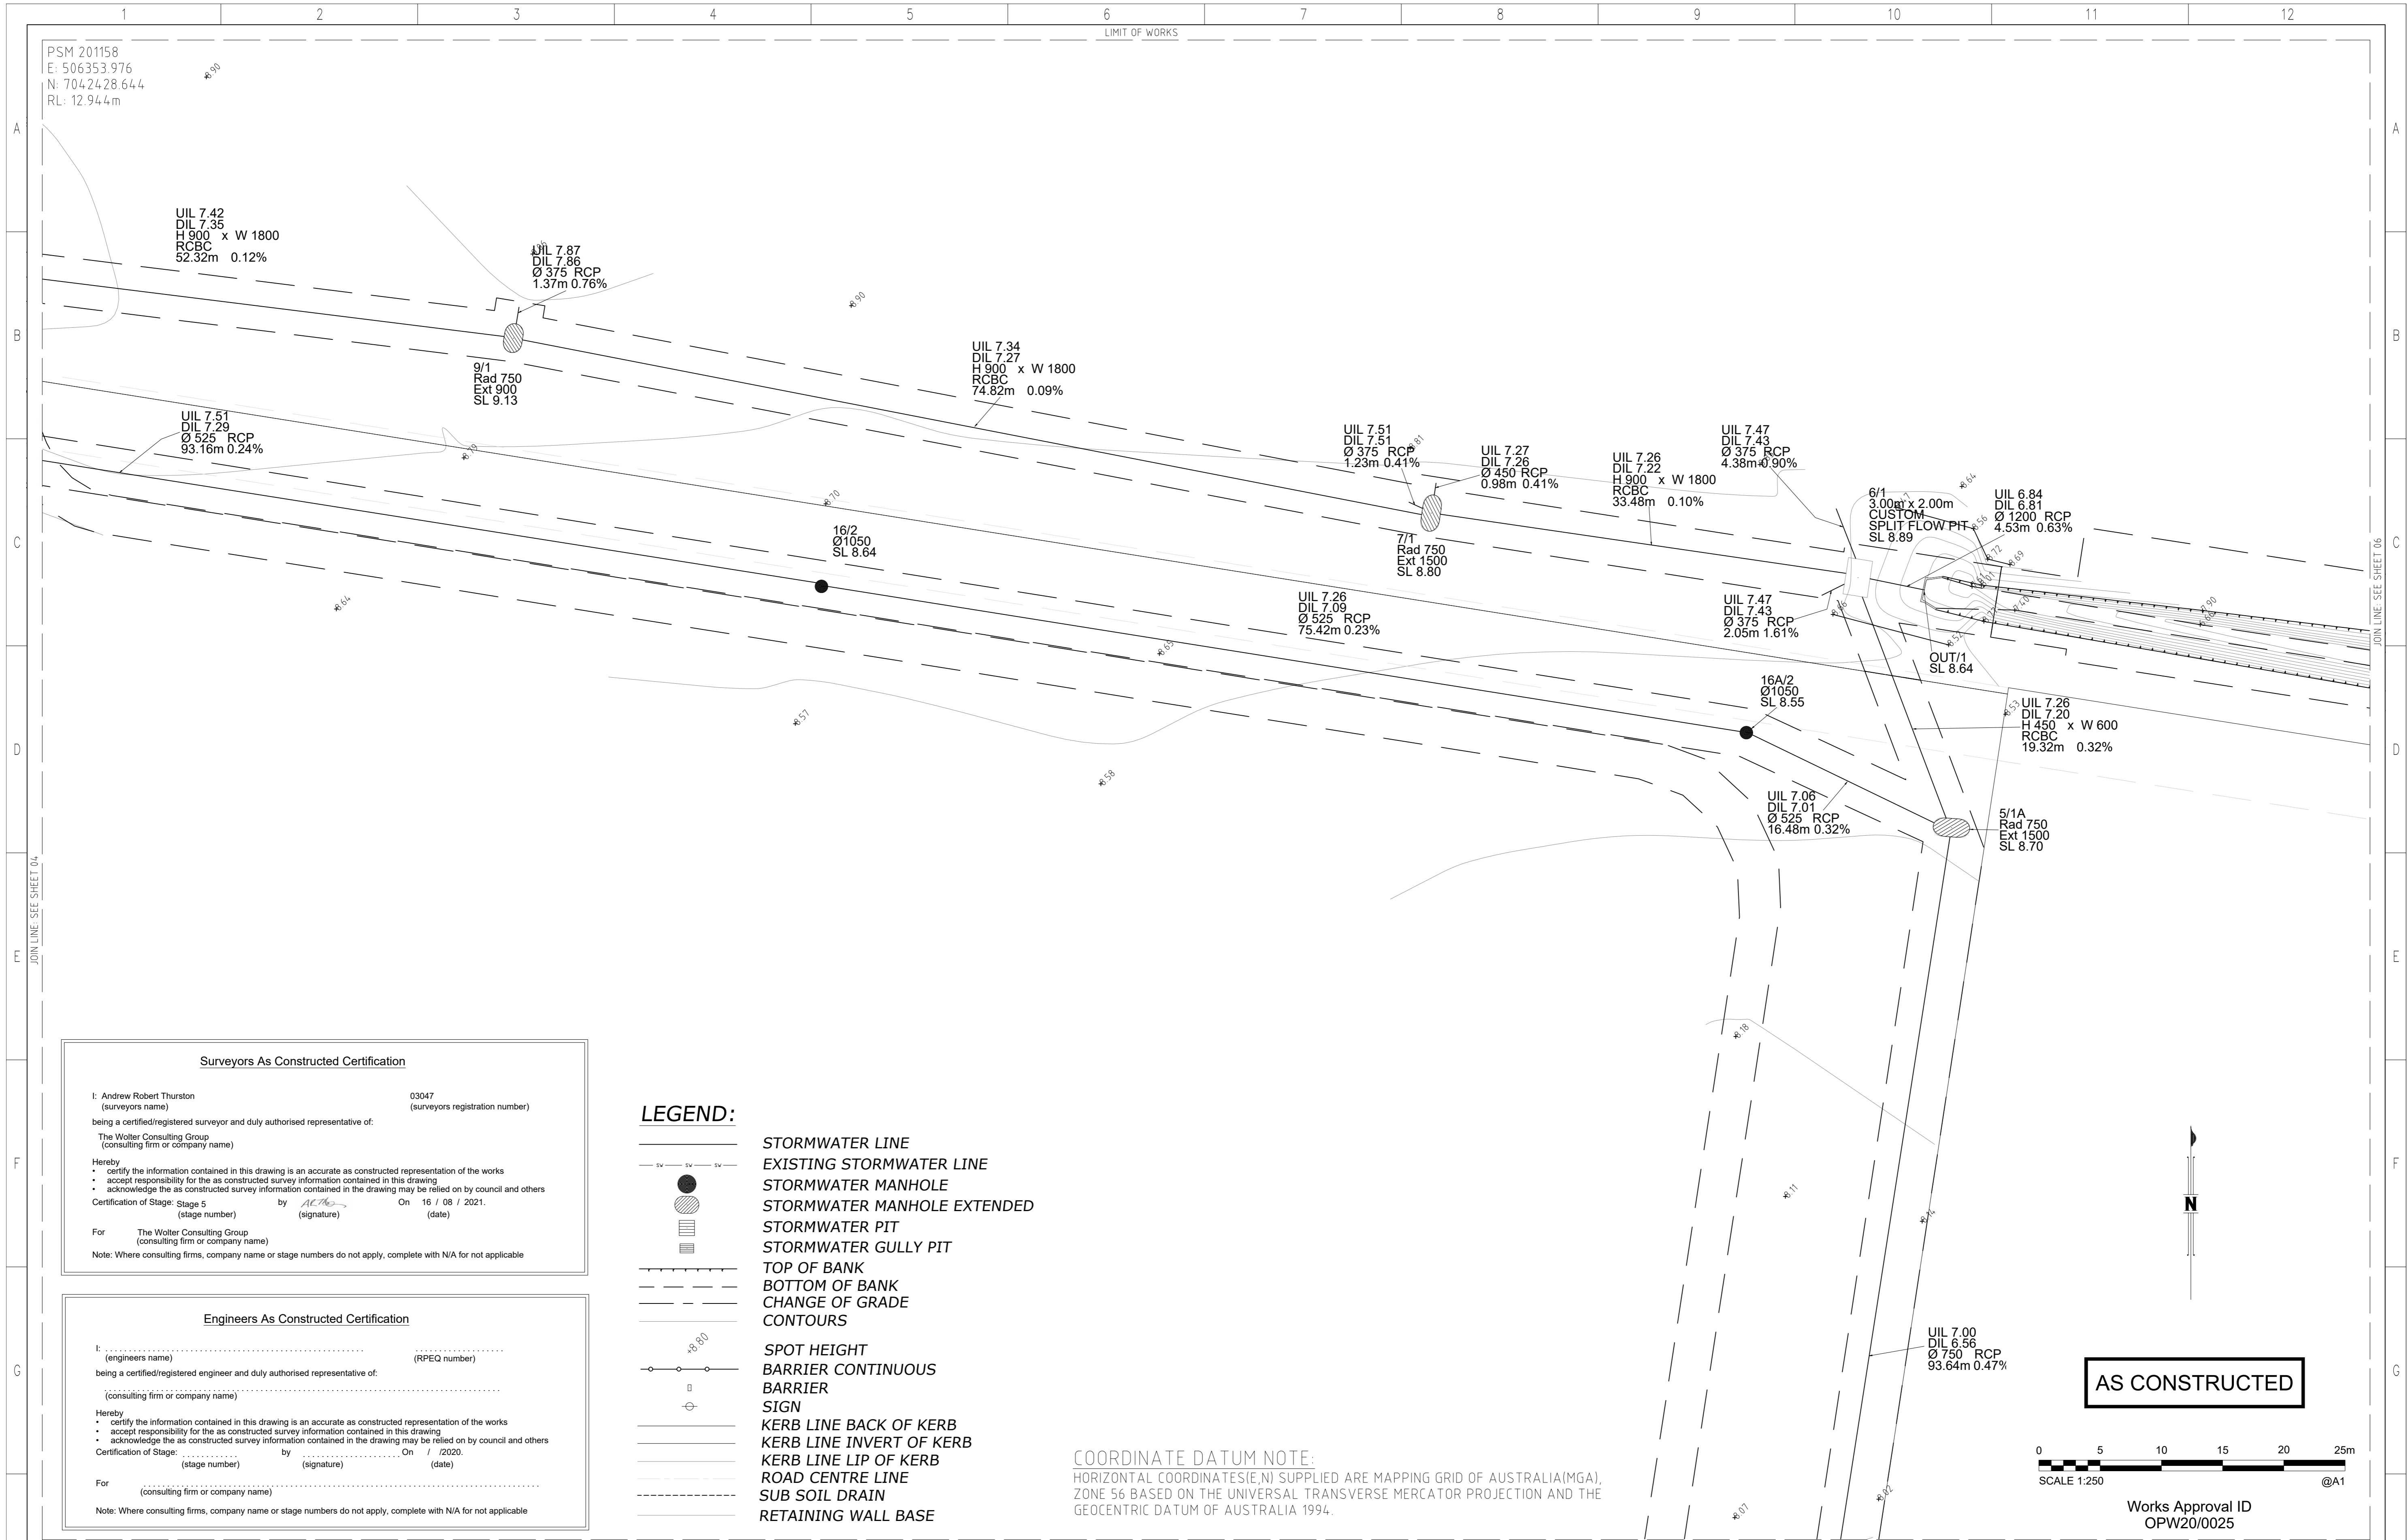

Surveyors As Constructed Certification

I: Andrew Robert Thurston (surveyors name) 03047 (surveyors registration number)
being a certified/registered surveyor and duly authorised representative of:
The Wolter Consulting Group (consulting firm or company name)

Hereby
• certify the information contained in this drawing is an accurate as constructed representation of the works
• accept responsibility for the as constructed survey information contained in this drawing
• acknowledge the as constructed survey information contained in the drawing may be relied on by council and others

Certification of Stage: Stage 5 (stage number) by [Signature] (signature) On 16 / 08 / 2021. (date)

For The Wolter Consulting Group (consulting firm or company name)
Note: Where consulting firms, company name or stage numbers do not apply, complete with N/A for not applicable

Engineers As Constructed Certification

I: [Name] (engineers name) [RPEQ number] (RPEQ number)
being a certified/registered engineer and duly authorised representative of:
[Name] (consulting firm or company name)

Hereby
• certify the information contained in this drawing is an accurate as constructed representation of the works
• accept responsibility for the as constructed survey information contained in this drawing
• acknowledge the as constructed survey information contained in the drawing may be relied on by council and others

Certification of Stage: [Stage] (stage number) by [Signature] (signature) On [Date] (date)

For [Name] (consulting firm or company name)
Note: Where consulting firms, company name or stage numbers do not apply, complete with N/A for not applicable

DRAWING REVISIONS		REFERENCE DRAWINGS		DESIGN FILE No.	DESIGNED	
REV.	REVISION DESCRIPTION	DRG. No.	DESCRIPTION	CONSTRUCT. No.	DATE	
A	AS CONSTRUCTED					
				SURVEY FILE No. SS3787/5	DRAWN	JWB
				FIELD BOOK	DATE	16.08.2021
				LOG BOOK	CHECKED	ADH
				LEVEL DATUM	DATE	16.08.2021
				DATUM		MGA-56

WOLTER consulting group

Planning Urban Design Landscape Environment Surveying

Brisbane: Level 2, 1 Breakfast Ck Road, Newstead, QLD 4006 Phone: (07) 3666 5200

SCALE 1:250 ORIGINAL SIZE A1

SUNSHINE COAST COUNCIL

CALOUNDRA OFFICE
1 OMRAH AVENUE, CALOUNDRA QLD 4551

MAROOCHYDORE OFFICE
10 FIRST AVENUE, MAROOCHYDORE QLD 4558

NAMBOUR OFFICE
Chr CURRIE and BURY STREETS, NAMBOUR QLD 4560

LOCKED BAG 72, SUNSHINE COAST
MAIL CENTRE QLD 4560
Telephone: (07) 5475 7528
Fax: (07) 5475 7277

VILLAGE GREEN

STAGE 5
AS CONSTRUCTED
ROADS, DRAINAGE AND SURFACE

SUBDIVISION REFERENCE

RAL 20/0025 SCC

No. 5 OF 9 PLANS

ASCON GRID NUMBER	REV.
	A

PSM 201158
 E: 506353.976
 N: 7042428.644
 RL: 12.944m

Surveyors As Constructed Certification

I: Andrew Robert Thurston (surveyors name) 03047 (surveyors registration number)
 being a certified/registered surveyor and duly authorised representative of:
 The Walter Consulting Group (consulting firm or company name)

Hereby:

- certify the information contained in this drawing is an accurate as constructed representation of the works
- accept responsibility for the as constructed survey information contained in this drawing
- acknowledge the as constructed survey information contained in the drawing may be relied on by council and others

Certification of Stage: Stage 5 (stage number) by A.R. Thurston (signature) On 16 / 08 / 2021. (date)

For The Walter Consulting Group (consulting firm or company name)

Note: Where consulting firms, company name or stage numbers do not apply, complete with N/A for not applicable

Engineers As Constructed Certification

I: (engineers name) (RPEQ number)
 being a certified/registered engineer and duly authorised representative of:
 (consulting firm or company name)

Hereby:

- certify the information contained in this drawing is an accurate as constructed representation of the works
- accept responsibility for the as constructed survey information contained in this drawing
- acknowledge the as constructed survey information contained in the drawing may be relied on by council and others

Certification of Stage: (stage number) by (signature) On / / 2020. (date)

For (consulting firm or company name)

Note: Where consulting firms, company name or stage numbers do not apply, complete with N/A for not applicable

- LEGEND:**
- STORMWATER LINE
 - EXISTING STORMWATER LINE
 - STORMWATER MANHOLE
 - STORMWATER MANHOLE EXTENDED
 - STORMWATER PIT
 - STORMWATER GULLY PIT
 - TOP OF BANK
 - BOTTOM OF BANK
 - CHANGE OF GRADE
 - CONTOURS
 - SPOT HEIGHT
 - BARRIER CONTINUOUS
 - BARRIER
 - SIGN
 - KERB LINE BACK OF KERB
 - KERB LINE INVERT OF KERB
 - KERB LINE LIP OF KERB
 - ROAD CENTRE LINE
 - SUB SOIL DRAIN
 - RETAINING WALL BASE


U/L 6.84
 D/L 6.81
 Ø 1200 RCP
 4.53m 0.63%

U/L 7.26
 D/L 7.20
 H 450 x W 600
 RCBC
 19.32m 0.32%

5/1A
 Rad 750
 Ext 1500
 SL 8.70

COORDINATE DATUM NOTE:
 HORIZONTAL COORDINATES (E, N) SUPPLIED ARE MAPPING GRID OF AUSTRALIA (MGA), ZONE 56 BASED ON THE UNIVERSAL TRANSVERSE MERCATOR PROJECTION AND THE GEOCENTRIC DATUM OF AUSTRALIA 1994.

AS CONSTRUCTED

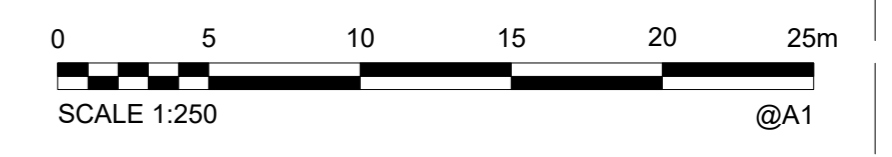

Works Approval ID
 OPW20/0025

DRAWING REVISIONS		REFERENCE DRAWINGS		DESIGN FILE No.	DESIGNED	
REV.	REVISION DESCRIPTION	DRG. No.	DESCRIPTION	CONSTRUCT. No.	DATE	
A	AS CONSTRUCTED					

DESIGN FILE No.	SS3787/5
SURVEY FILE No.	
FIELD BOOK	DATE 16.08.2021
LOG BOOK	CHECKED ADH
LEVEL DATUM	DATE 16.08.2021
DATUM	AHD
	MGA-56

WOLTER consulting group

Planning Urban Design Landscape Environment Surveying

Brisbane: Level 2, 1 Breakfast Ck Road, Newstead, QLD 4006 Phone: (07) 3666 5200

SUNSHINE COAST COUNCIL

CALOUNDRA OFFICE
 1 OMRAH AVENUE, CALOUNDRA QLD 4551

MAROOCHYDORE OFFICE
 10 FIRST AVENUE, MAROOCHYDORE QLD 4558


NAMBOUR OFFICE
 Cnr CURRIE and BURY STREETS, NAMBOUR QLD 4560

LOCKED BAG 72, SUNSHINE COAST
 MAIL CENTRE QLD 4560
 Telephone: (07) 5475 7528
 Fax: (07) 5475 7277

VILLAGE GREEN

STAGE 5
 AS CONSTRUCTED
 ROADS, DRAINAGE AND SURFACE

SUBDIVISION REFERENCE	
RAL 20/0025 SCC	
No. 6 OF 9 PLANS	
ASCON GRID NUMBER	REV.
	A

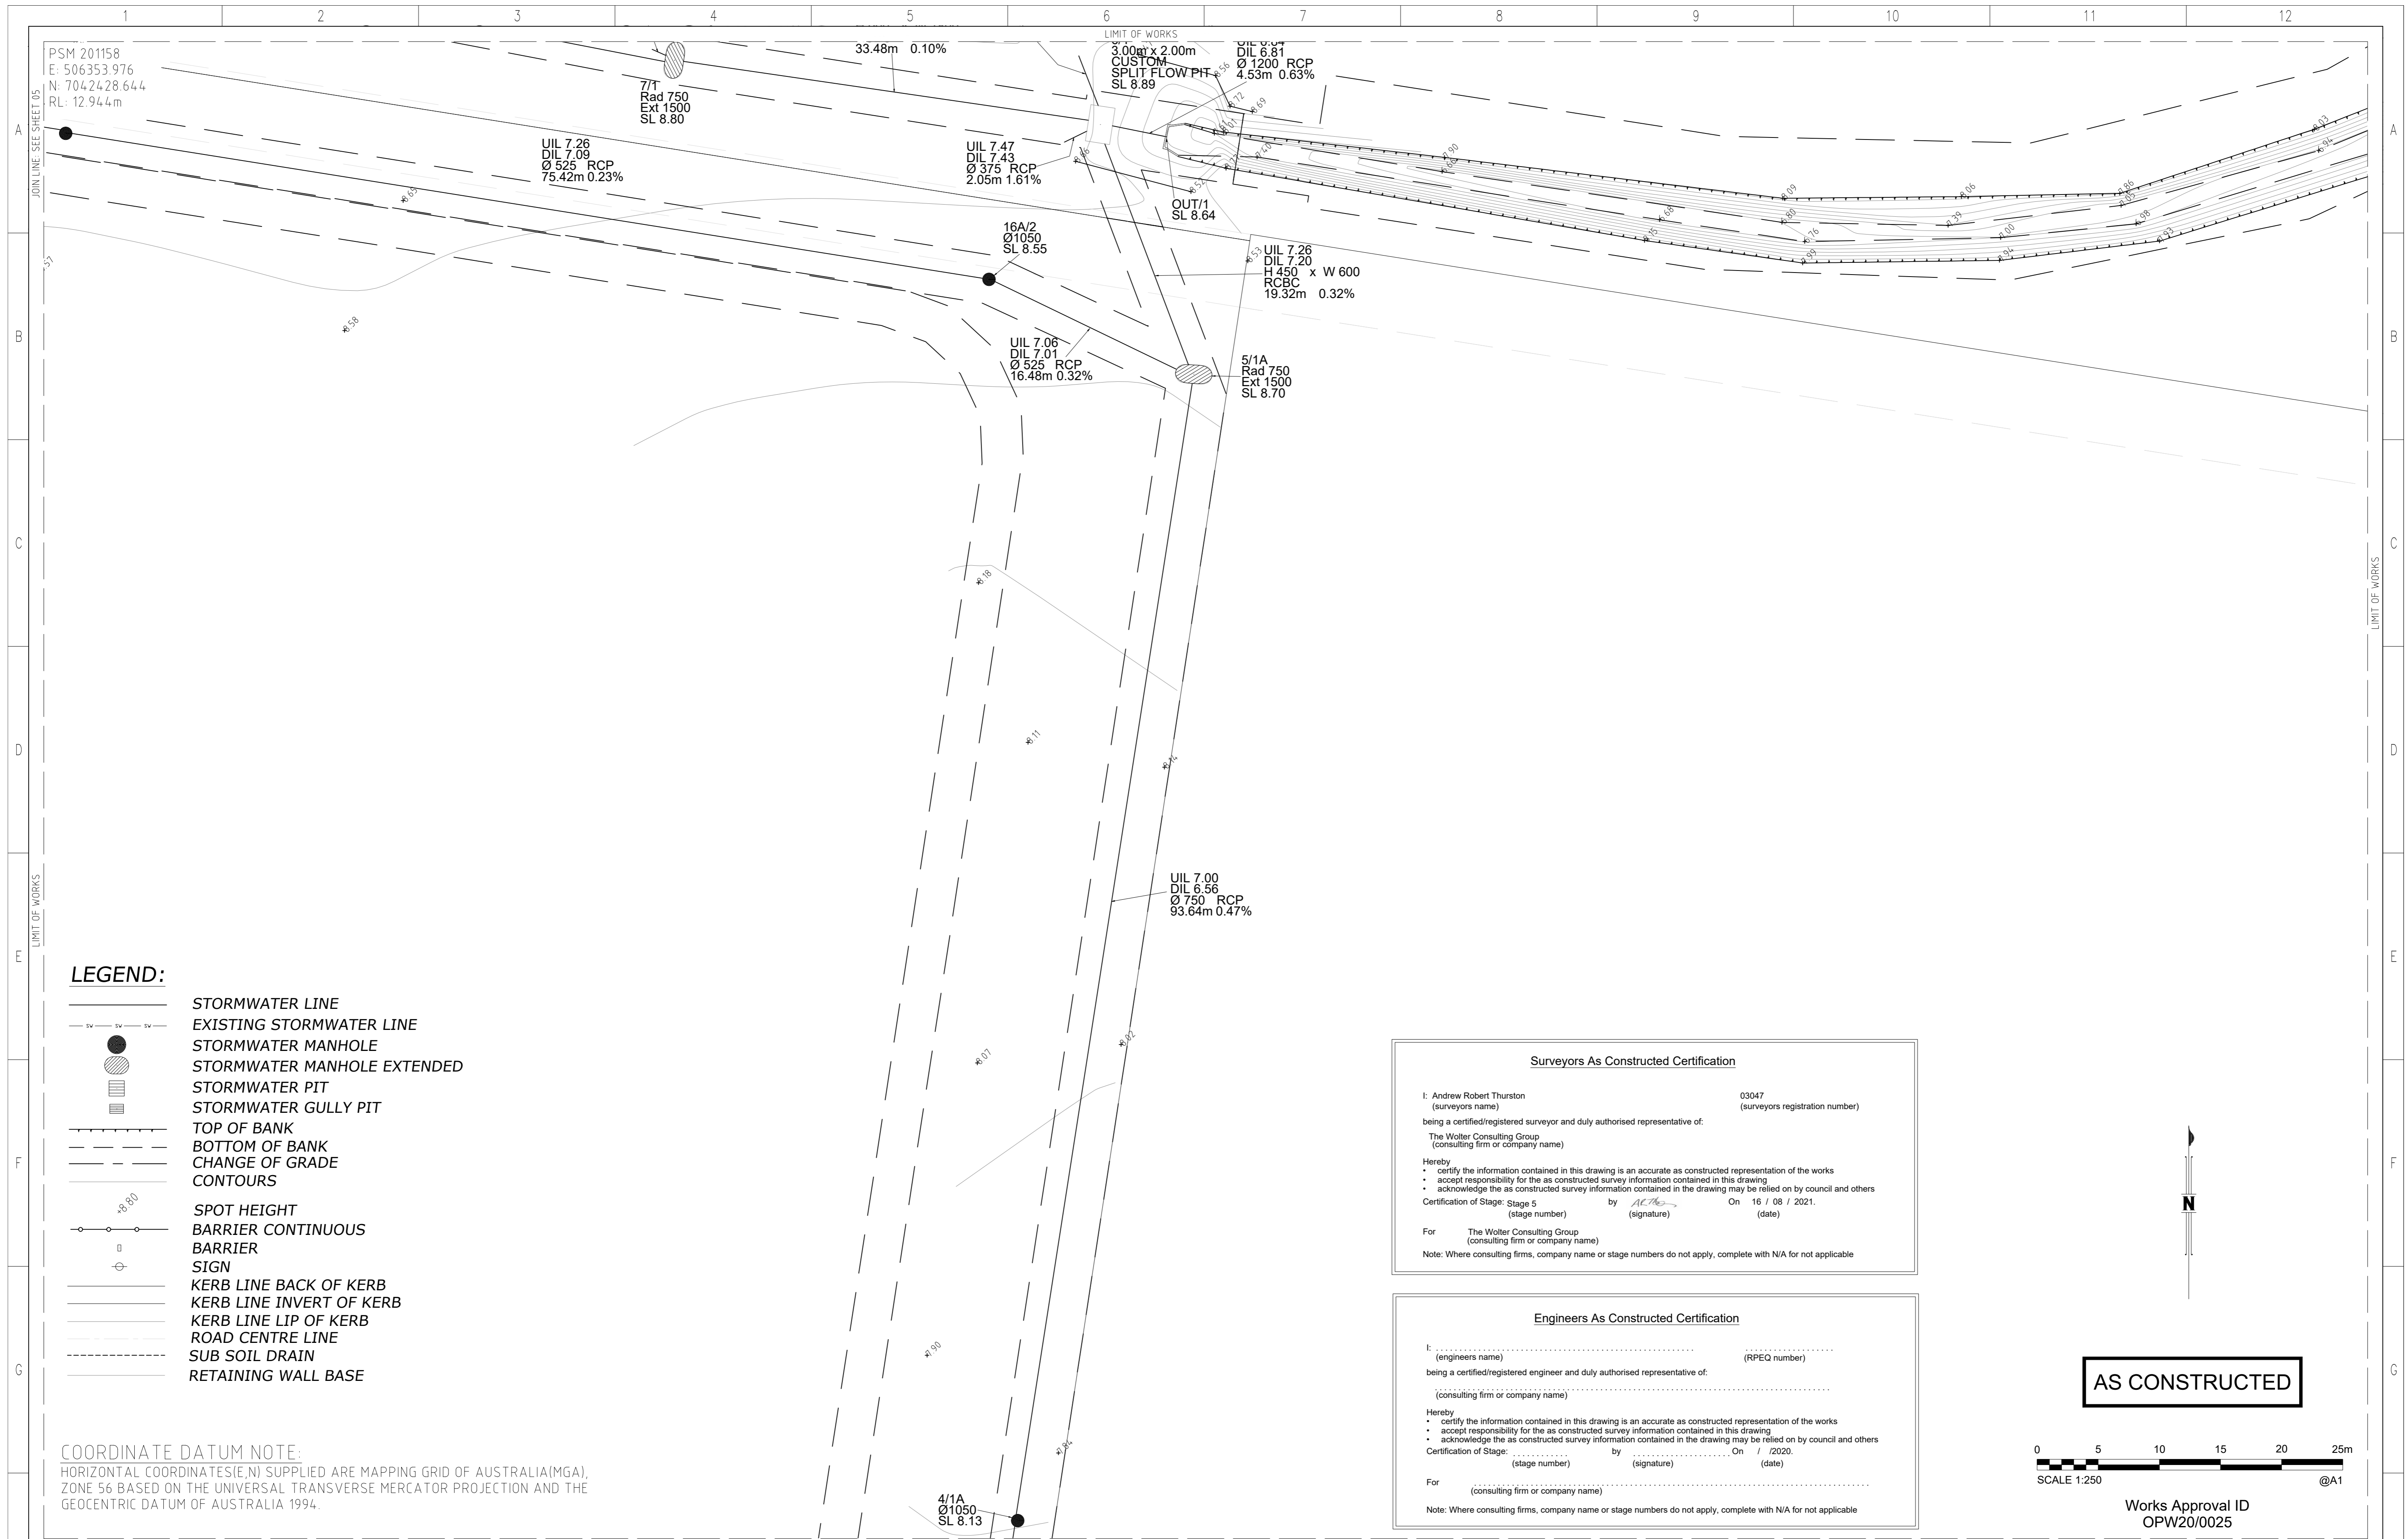

PSM 201158
 E: 506353.976
 N: 7042428.644
 RL: 12.944m

- LEGEND:**
- STORMWATER LINE
 - EXISTING STORMWATER LINE
 - STORMWATER MANHOLE
 - STORMWATER MANHOLE EXTENDED
 - STORMWATER PIT
 - STORMWATER GULLY PIT
 - TOP OF BANK
 - BOTTOM OF BANK
 - CHANGE OF GRADE
 - CONTOURS
 - SPOT HEIGHT
 - BARRIER CONTINUOUS
 - BARRIER
 - SIGN
 - KERB LINE BACK OF KERB
 - KERB LINE INVERT OF KERB
 - KERB LINE LIP OF KERB
 - ROAD CENTRE LINE
 - SUB SOIL DRAIN
 - RETAINING WALL BASE

COORDINATE DATUM NOTE:
 HORIZONTAL COORDINATES(E,N) SUPPLIED ARE MAPPING GRID OF AUSTRALIA(MGA),
 ZONE 56 BASED ON THE UNIVERSAL TRANSVERSE MERCATOR PROJECTION AND THE
 GEOCENTRIC DATUM OF AUSTRALIA 1994.

Surveyors As Constructed Certification

I: Andrew Robert Thurston (surveyors name) 03047 (surveyors registration number)
 being a certified/registered surveyor and duly authorised representative of:
 The Wolter Consulting Group (consulting firm or company name)

Hereby
 • certify the information contained in this drawing is an accurate as constructed representation of the works
 • accept responsibility for the as constructed survey information contained in this drawing
 • acknowledge the as constructed survey information contained in the drawing may be relied on by council and others

Certification of Stage: Stage 5 by *A.R.T.* On 16 / 08 / 2021.
 (stage number) (signature) (date)

For The Wolter Consulting Group (consulting firm or company name)
 Note: Where consulting firms, company name or stage numbers do not apply, complete with N/A for not applicable

Engineers As Constructed Certification


I: (engineers name) (RPEQ number)
 being a certified/registered engineer and duly authorised representative of:
 (consulting firm or company name)

Hereby
 • certify the information contained in this drawing is an accurate as constructed representation of the works
 • accept responsibility for the as constructed survey information contained in this drawing
 • acknowledge the as constructed survey information contained in the drawing may be relied on by council and others

Certification of Stage: by On / / 2020.
 (stage number) (signature) (date)

For (consulting firm or company name)
 Note: Where consulting firms, company name or stage numbers do not apply, complete with N/A for not applicable

AS CONSTRUCTED

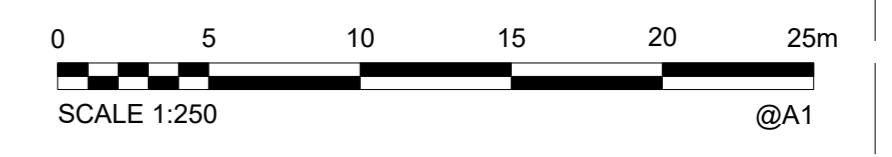

Works Approval ID
 OPW20/0025

DRAWING REVISIONS		REFERENCE DRAWINGS		DESIGN FILE No.	DESIGNED		
REV.	REVISION DESCRIPTION	DRG. No.	DESCRIPTION	CONSTRUCT. No.	DATE		
A	AS CONSTRUCTED				16.08.2021	JWB	
				SURVEY FILE No.	16.08.2021	ADH	
				FIELD BOOK	16.08.2021		
				LOG BOOK			
				LEVEL DATUM	AHD		
				DATUM	MGA-56		

WOLTER
consulting group

Planning Urban Design Landscape Environment Surveying

Brisbane: Level 2, 1 Breakfast Ck Road, Newstead, QLD 4006 Phone: (07) 3666 5200

SCALE 1:250 ORIGINAL SIZE A1

SUNSHINE COAST COUNCIL
 CALOUNDRA OFFICE
 1 OMAHA AVENUE, CALOUNDRA QLD 4551
 MAROOCHYDORE OFFICE
 10 FIRST AVENUE, MAROOCHYDORE QLD 4558
 NAMBOUR OFFICE
 Cnr CURRIE and BURY STREETS, NAMBOUR QLD 4560
 LOCKED BAG 72, SUNSHINE COAST
 MAIL CENTRE QLD 4560
 Telephone: (07) 5475 7528
 Fax: (07) 5475 7277


VILLAGE GREEN
 STAGE 5
 AS CONSTRUCTED
 ROADS, DRAINAGE AND SURFACE

SUBDIVISION REFERENCE
 RAL 20/0025 SCC

No. 7 OF 9 PLANS
 ASCON GRID NUMBER REV.
 A

PSM 201158
 E: 506353.976
 N: 7042428.644
 RL: 12.944m

JOIN LINE: SEE SHEET 08

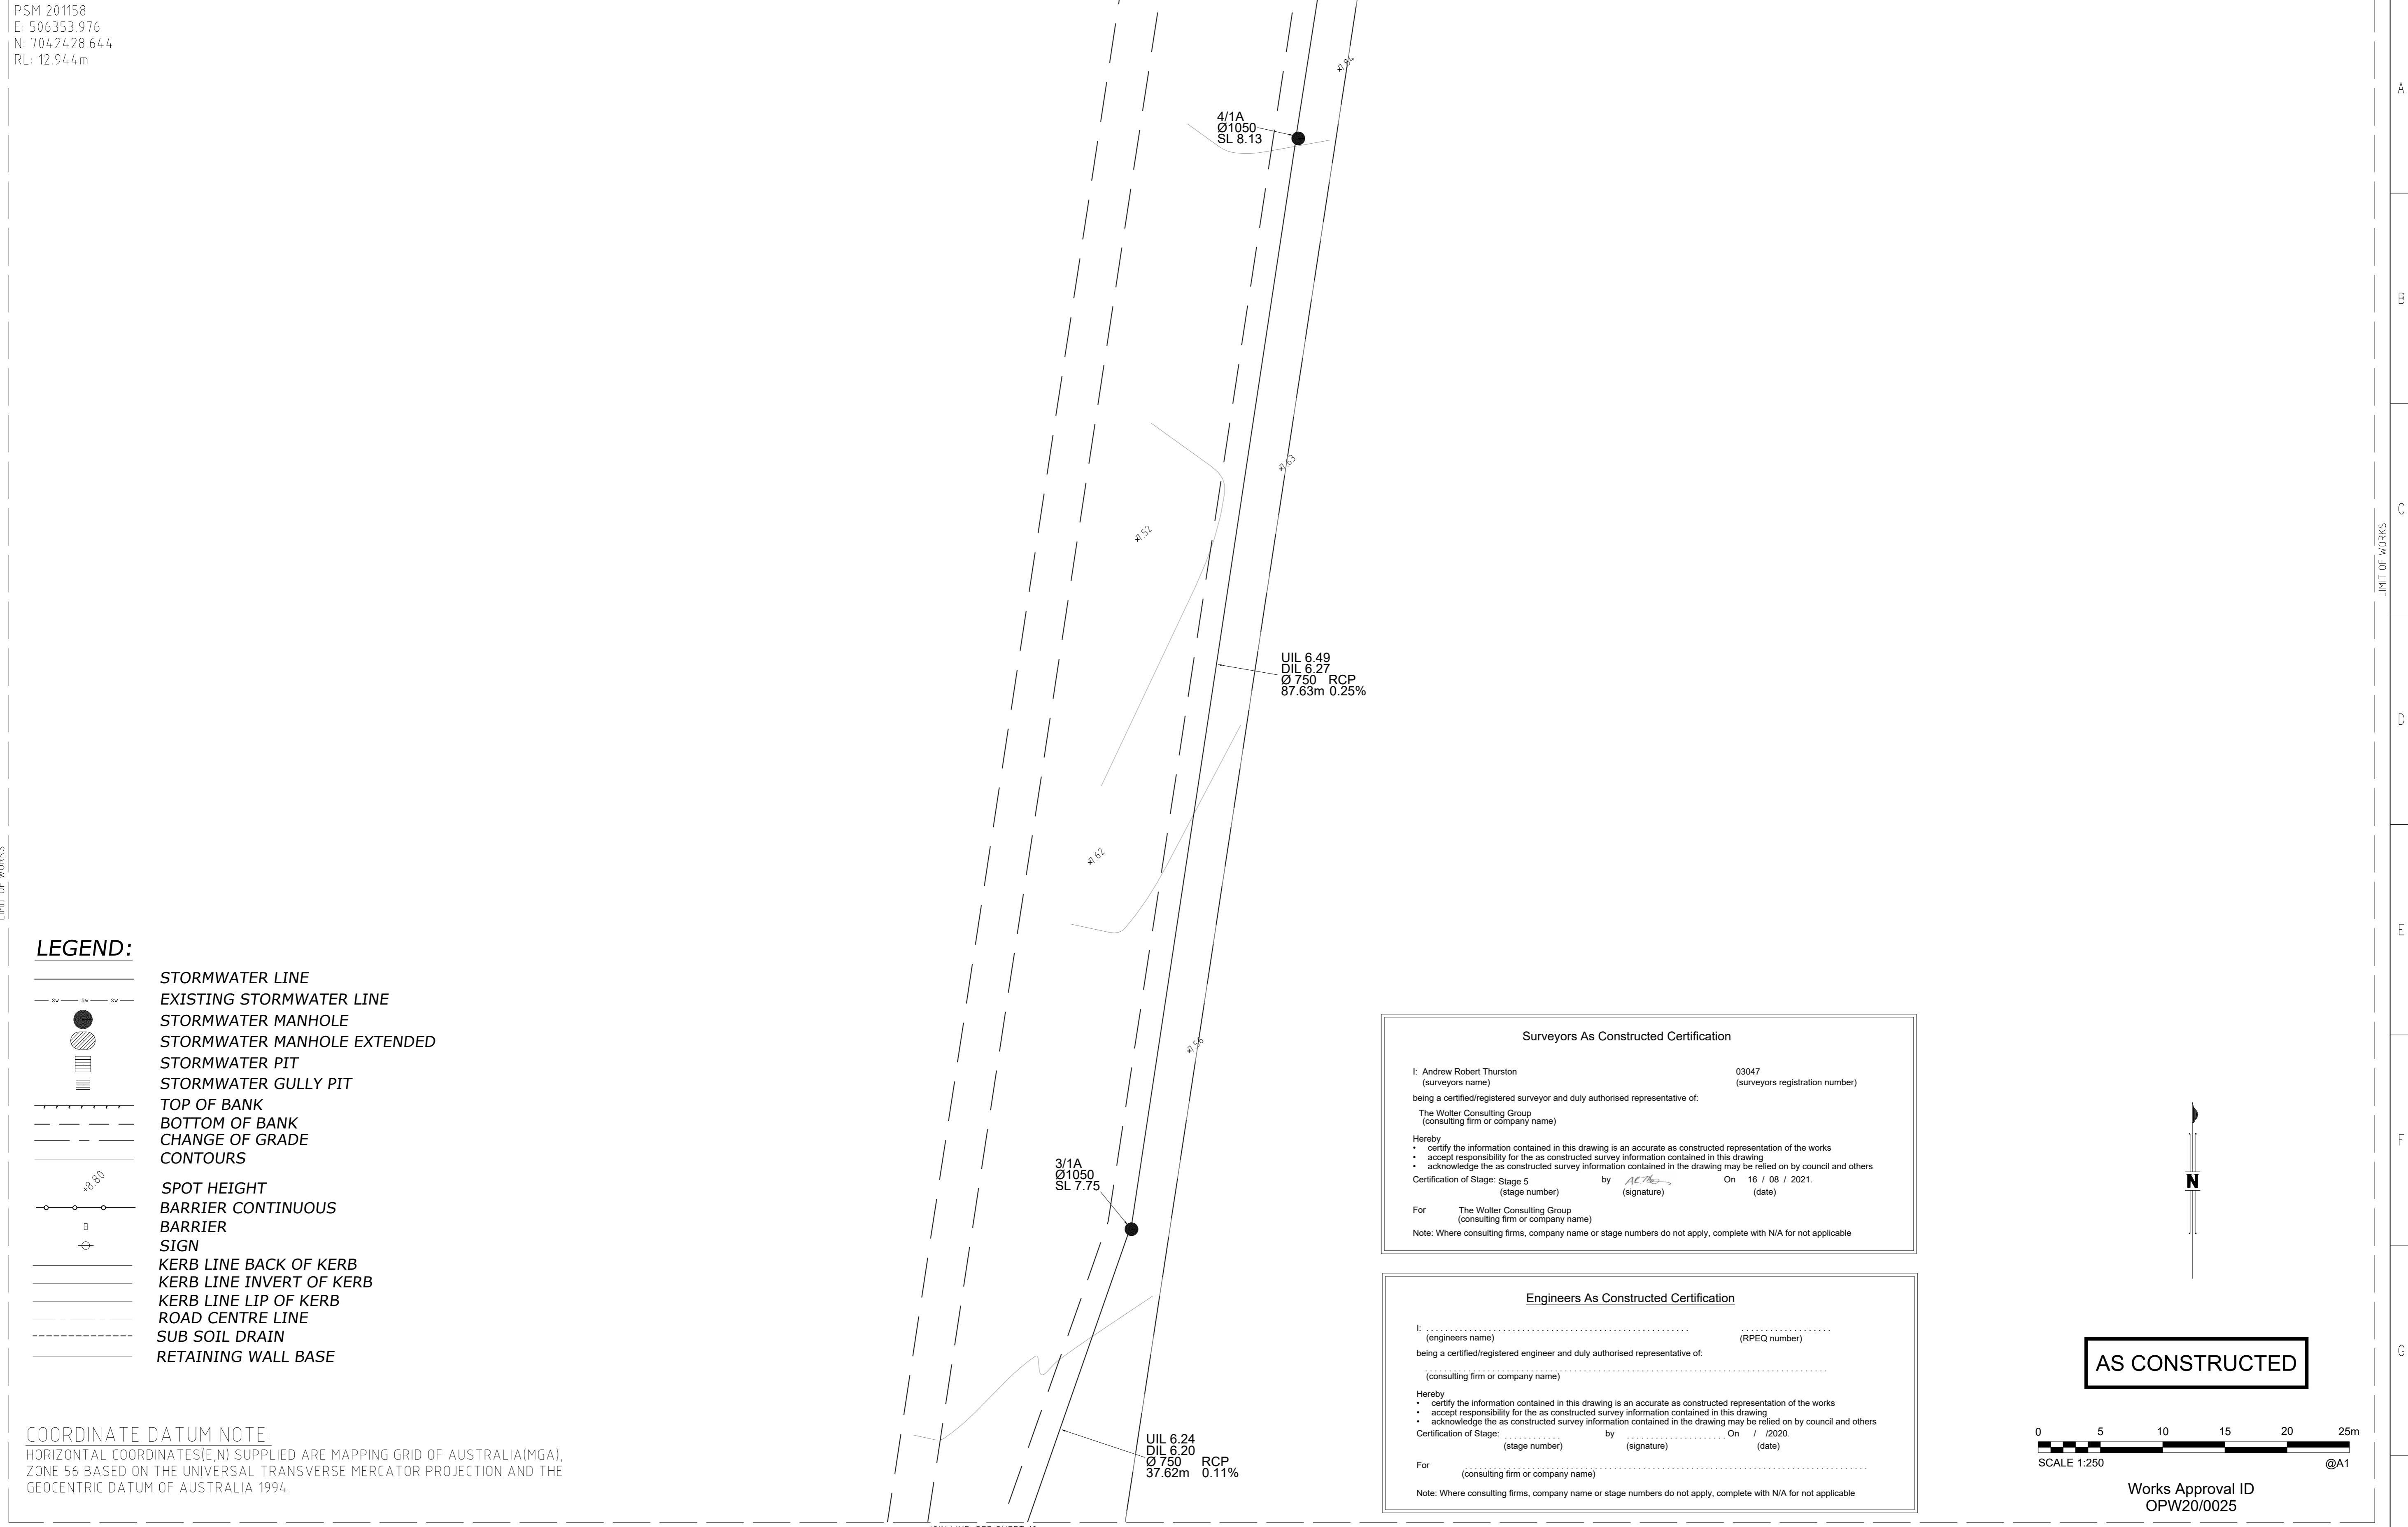

- LEGEND:**
- STORMWATER LINE
 - - - EXISTING STORMWATER LINE
 - STORMWATER MANHOLE
 - STORMWATER MANHOLE EXTENDED
 - ▨ STORMWATER PIT
 - ▩ STORMWATER GULLY PIT
 - TOP OF BANK
 - - - BOTTOM OF BANK
 - - - CHANGE OF GRADE
 - CONTOURS
 - SPOT HEIGHT
 - BARRIER CONTINUOUS
 - ▩ BARRIER
 - SIGN
 - KERB LINE BACK OF KERB
 - KERB LINE INVERT OF KERB
 - KERB LINE LIP OF KERB
 - ROAD CENTRE LINE
 - SUB SOIL DRAIN
 - RETAINING WALL BASE

COORDINATE DATUM NOTE:
 HORIZONTAL COORDINATES(E,N) SUPPLIED ARE MAPPING GRID OF AUSTRALIA(MGA), ZONE 56 BASED ON THE UNIVERSAL TRANSVERSE MERCATOR PROJECTION AND THE GEOCENTRIC DATUM OF AUSTRALIA 1994.

Surveyors As Constructed Certification

I: Andrew Robert Thurston (surveyors name) 03047 (surveyors registration number)
 being a certified/registered surveyor and duly authorised representative of:
 The Wolter Consulting Group (consulting firm or company name)

Hereby
 • certify the information contained in this drawing is an accurate as constructed representation of the works
 • accept responsibility for the as constructed survey information contained in this drawing
 • acknowledge the as constructed survey information contained in the drawing may be relied on by council and others

Certification of Stage: Stage 5 by [Signature] On 16 / 08 / 2021.
 (stage number) (signature) (date)

For The Wolter Consulting Group (consulting firm or company name)
 Note: Where consulting firms, company name or stage numbers do not apply, complete with N/A for not applicable

Engineers As Constructed Certification


I: (engineers name) (RPEQ number)
 being a certified/registered engineer and duly authorised representative of:
 (consulting firm or company name)

Hereby
 • certify the information contained in this drawing is an accurate as constructed representation of the works
 • accept responsibility for the as constructed survey information contained in this drawing
 • acknowledge the as constructed survey information contained in the drawing may be relied on by council and others

Certification of Stage: by On / / 2020.
 (stage number) (signature) (date)

For (consulting firm or company name)
 Note: Where consulting firms, company name or stage numbers do not apply, complete with N/A for not applicable

AS CONSTRUCTED

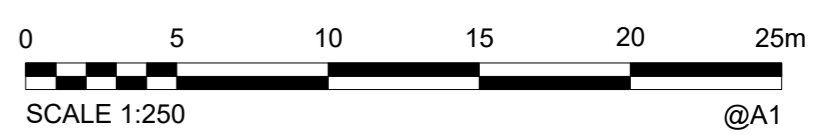

Works Approval ID
 OPW20/0025

DRAWING REVISIONS		REFERENCE DRAWINGS		DESIGN FILE No.	DESIGNED	
REV.	REVISION DESCRIPTION	DRG. No.	DESCRIPTION	CONSTRUCT. No.	DATE	
A	AS CONSTRUCTED			SS3787/5	DRAWN	JWB
					DATE	16.08.2021
					CHECKED	ADH
					DATE	16.08.2021
					DATUM	MGA-56

FIELD BOOK		
LOG BOOK		
LEVEL DATUM	AHD	
DATUM	MGA-56	

WOLTER consulting group
 Planning Urban Design Landscape Environment Surveying
 Brisbane: Level 2, 1 Breakfast Ck Road, Newstead, QLD 4006 Phone: (07) 3666 5200

SCALE 1:250 ORIGINAL SIZE A1


SUNSHINE COAST COUNCIL
 CALOUNDRA OFFICE
 1 OMRAH AVENUE, CALOUNDRA QLD 4551
 MAROOCHYDORE OFFICE
 10 FIRST AVENUE, MAROOCHYDORE QLD 4558
 NAMBOUR OFFICE
 Cnr CURRIE and BURY STREETS, NAMBOUR QLD 4560
 LOCKED BAG 72, SUNSHINE COAST
 MAIL CENTRE QLD 4560
 Telephone: (07) 5475 7528
 Fax: (07) 5475 7277

VILLAGE GREEN
 STAGE 5
 AS CONSTRUCTED
 ROADS, DRAINAGE AND SURFACE

SUBDIVISION REFERENCE	
RAL 20/0025 SCC	
No. 8 OF 9 PLANS	
ASCON GRID NUMBER	REV.
	A

PSM 201158
 E: 506353.976
 N: 7042428.644
 RL: 12.944m

JOIN LINE: SEE SHEET 09

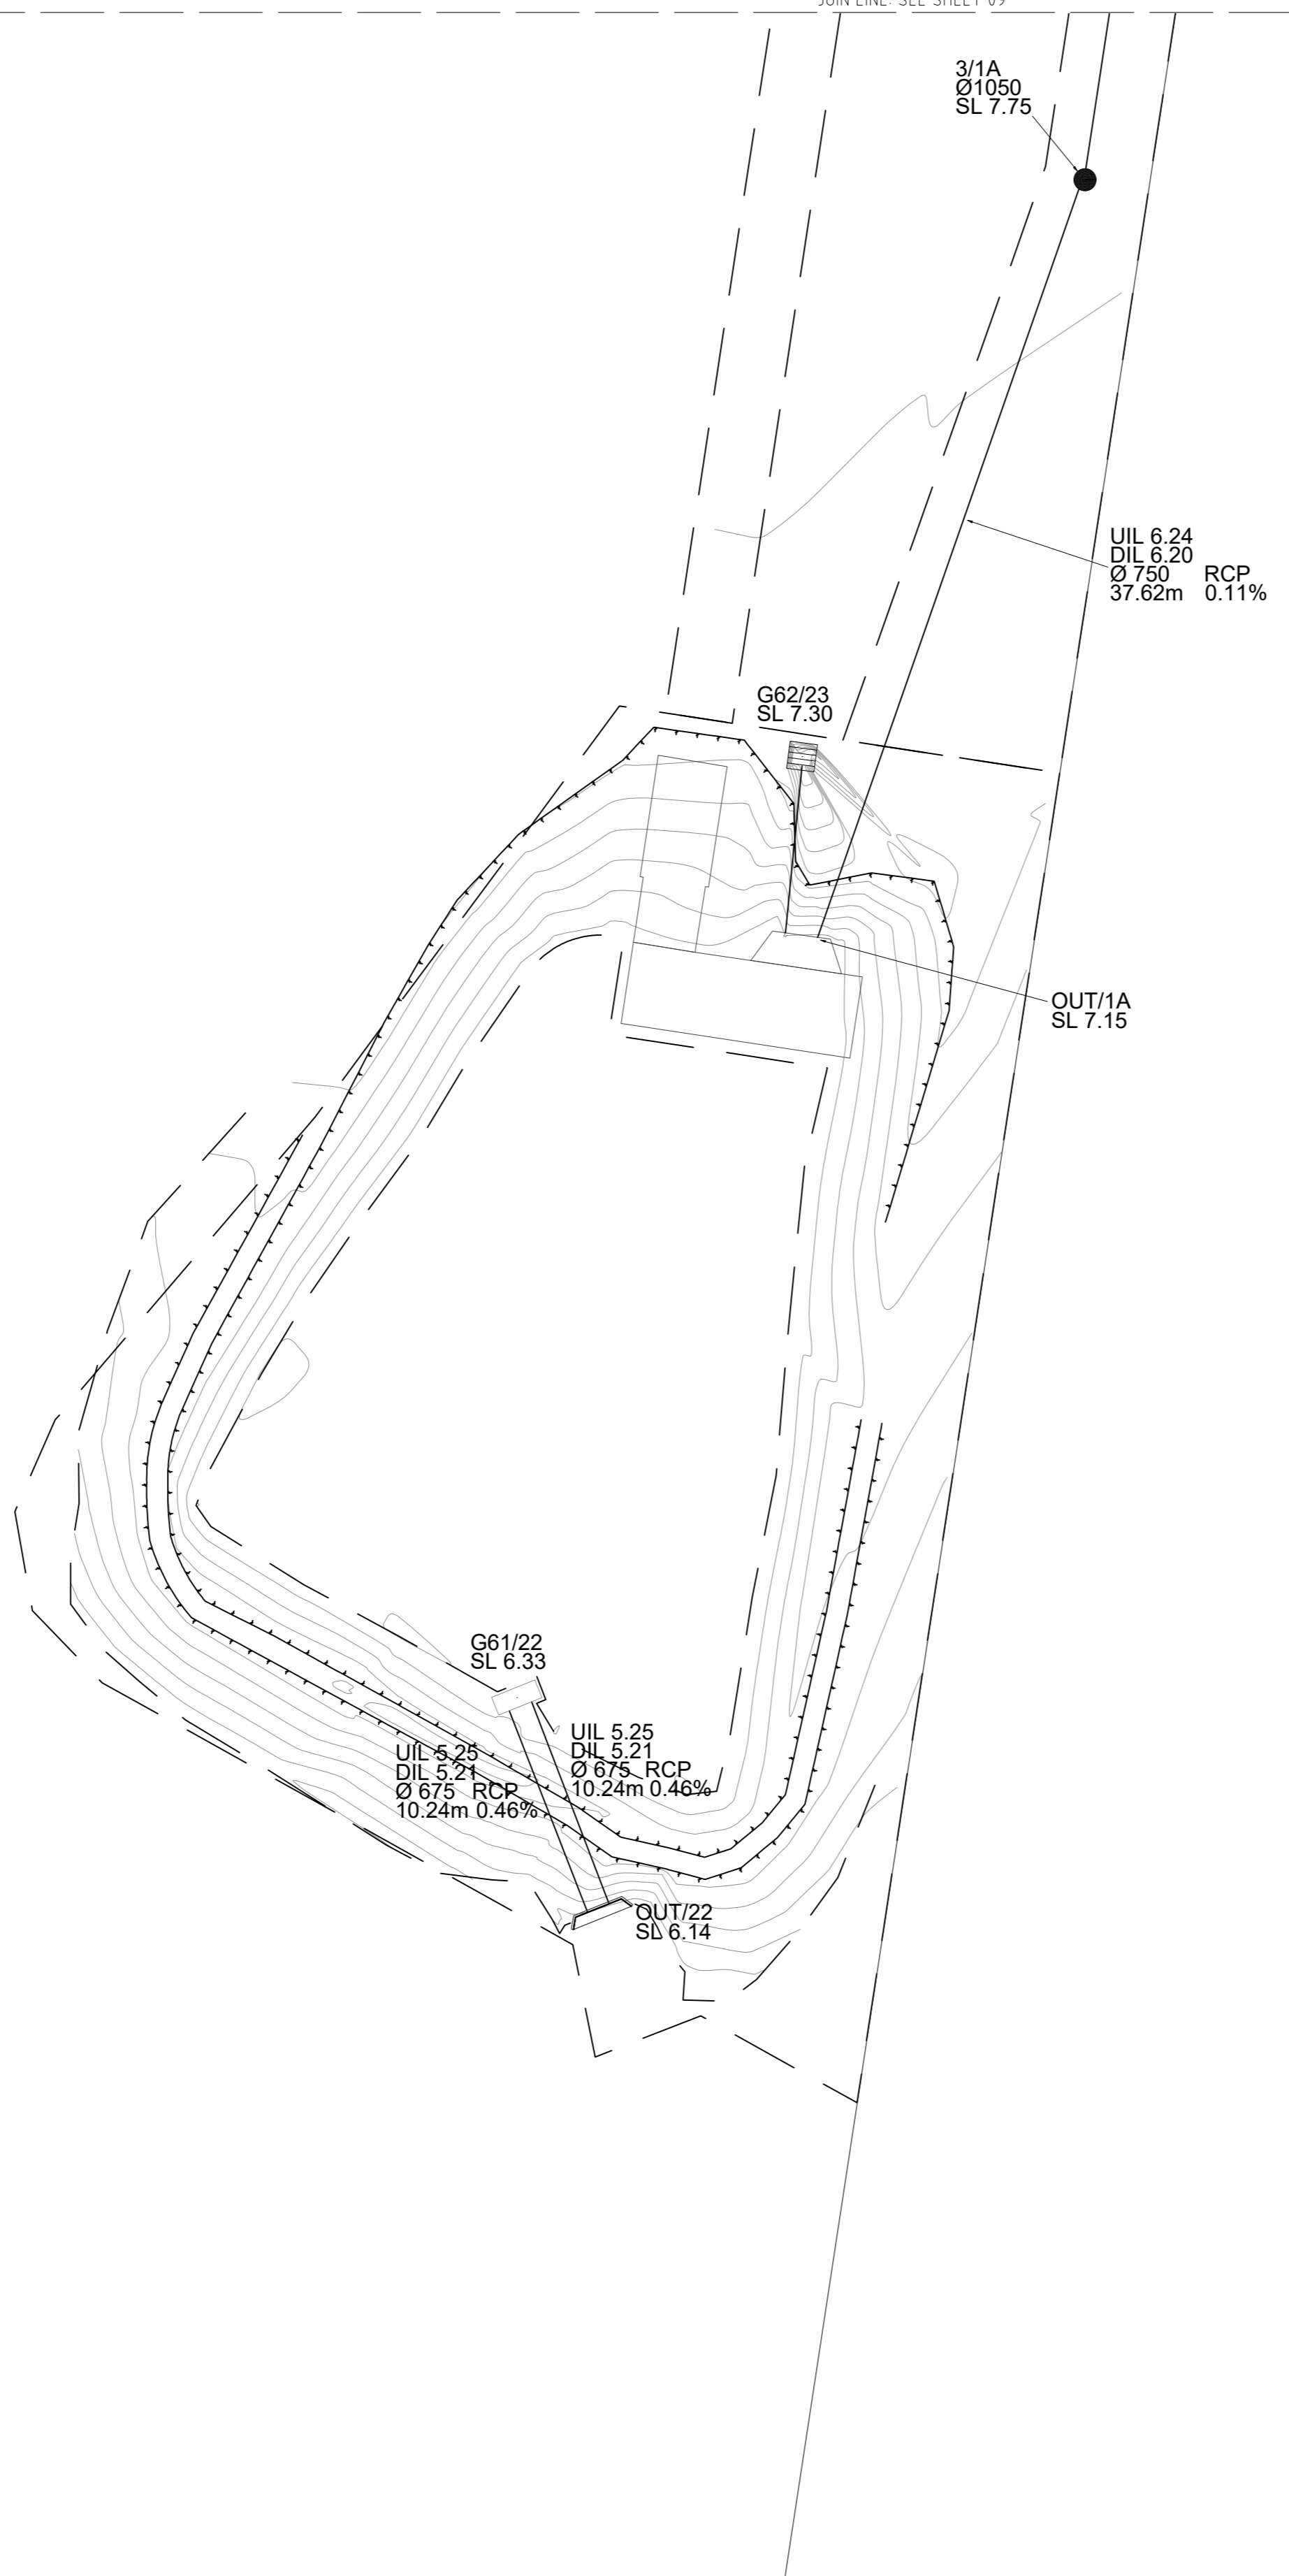

LEGEND:

- STORMWATER LINE
- EXISTING STORMWATER LINE
- STORMWATER MANHOLE
- STORMWATER MANHOLE EXTENDED
- STORMWATER PIT
- STORMWATER GULLY PIT
- TOP OF BANK
- BOTTOM OF BANK
- CHANGE OF GRADE
- CONTOURS
- SPOT HEIGHT
- BARRIER CONTINUOUS
- BARRIER
- SIGN
- KERB LINE BACK OF KERB
- KERB LINE INVERT OF KERB
- KERB LINE LIP OF KERB
- ROAD CENTRE LINE
- SUB SOIL DRAIN
- RETAINING WALL BASE

COORDINATE DATUM NOTE:
 HORIZONTAL COORDINATES(E,N) SUPPLIED ARE MAPPING GRID OF AUSTRALIA(MGA),
 ZONE 56 BASED ON THE UNIVERSAL TRANSVERSE MERCATOR PROJECTION AND THE
 GEOCENTRIC DATUM OF AUSTRALIA 1994.

Surveyors As Constructed Certification

I: Andrew Robert Thurston (surveyors name) 03047 (surveyors registration number)
 being a certified/registered surveyor and duly authorised representative of:
 The Wolter Consulting Group (consulting firm or company name)

Hereby
 • certify the information contained in this drawing is an accurate as constructed representation of the works
 • accept responsibility for the as constructed survey information contained in this drawing
 • acknowledge the as constructed survey information contained in the drawing may be relied on by council and others

Certification of Stage: Stage 5 by *A.R.T.* On 16 / 08 / 2021.
 (stage number) (signature) (date)

For The Wolter Consulting Group (consulting firm or company name)
 Note: Where consulting firms, company name or stage numbers do not apply, complete with N/A for not applicable


Engineers As Constructed Certification

I: (engineers name) (RPEQ number)
 being a certified/registered engineer and duly authorised representative of:
 (consulting firm or company name)


Hereby
 • certify the information contained in this drawing is an accurate as constructed representation of the works
 • accept responsibility for the as constructed survey information contained in this drawing
 • acknowledge the as constructed survey information contained in the drawing may be relied on by council and others

Certification of Stage: by On / / 2020.
 (stage number) (signature) (date)

For (consulting firm or company name)
 Note: Where consulting firms, company name or stage numbers do not apply, complete with N/A for not applicable

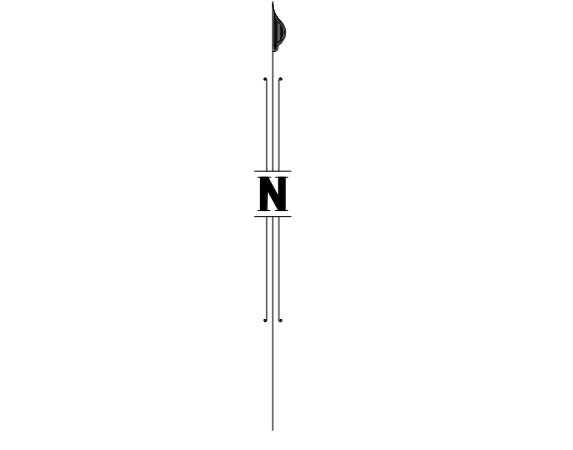

AS CONSTRUCTED

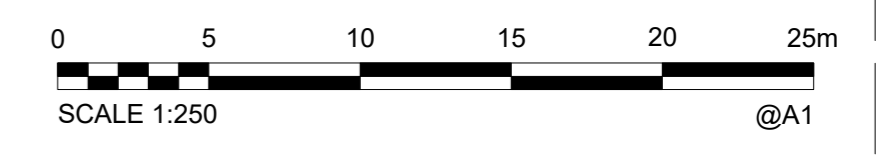

Works Approval ID
 OPW20/0025

DRAWING REVISIONS		REFERENCE DRAWINGS		DESIGN FILE No.	DESIGNED
REV.	REVISION DESCRIPTION	DRG. No.	DESCRIPTION	CONSTRUCT. No.	DATE
A	AS CONSTRUCTED			SS3787/5	JWB
				FIELD BOOK	DATE 16.08.2021
				LOG BOOK	CHECKED ADH
				LEVEL DATUM	DATE 16.08.2021
				DATUM	MGA-56

WOLTER
 consulting group

Planning Urban Design Landscape Environment Surveying
 Brisbane: Level 2, 1 Breakfast Ck Road, Newstead, QLD 4006 Phone: (07) 3666 5200

SCALE 1:250 ORIGINAL SIZE A1

SUNSHINE COAST COUNCIL

CALOUNDRA OFFICE
 1 OMRAH AVENUE, CALOUNDRA QLD 4551
 MAROOCHYDORE OFFICE
 10 FIRST AVENUE, MAROOCHYDORE QLD 4558
 NAMBOUR OFFICE
 Chr CURRIE and BURY STREETS, NAMBOUR QLD 4560
 LOCKED BAG 72, SUNSHINE COAST
 MAIL CENTRE QLD 4560
 Telephone: (07) 5475 7528
 Fax: (07) 5475 7277

VILLAGE GREEN
 STAGE 5
 AS CONSTRUCTED
 ROADS, DRAINAGE AND SURFACE

SUBDIVISION REFERENCE	
RAL 20/0025 SCC	
No. 9 OF 9 PLANS	
ASCON GRID NUMBER	REV.
	A