



AS CONSTRUCTED

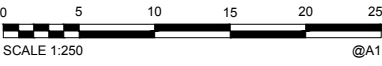

A1																																																																																																																																																																																																																																																																																																																																																																																																																																																																																																																																																																																																																																																																																																																																																																																																																																																																																																																																																																																																																																																																																																																																																																																																																																																																																																																																																																																																																				
----	--	--	

SUNBIRD DRIVE

SEE INSET

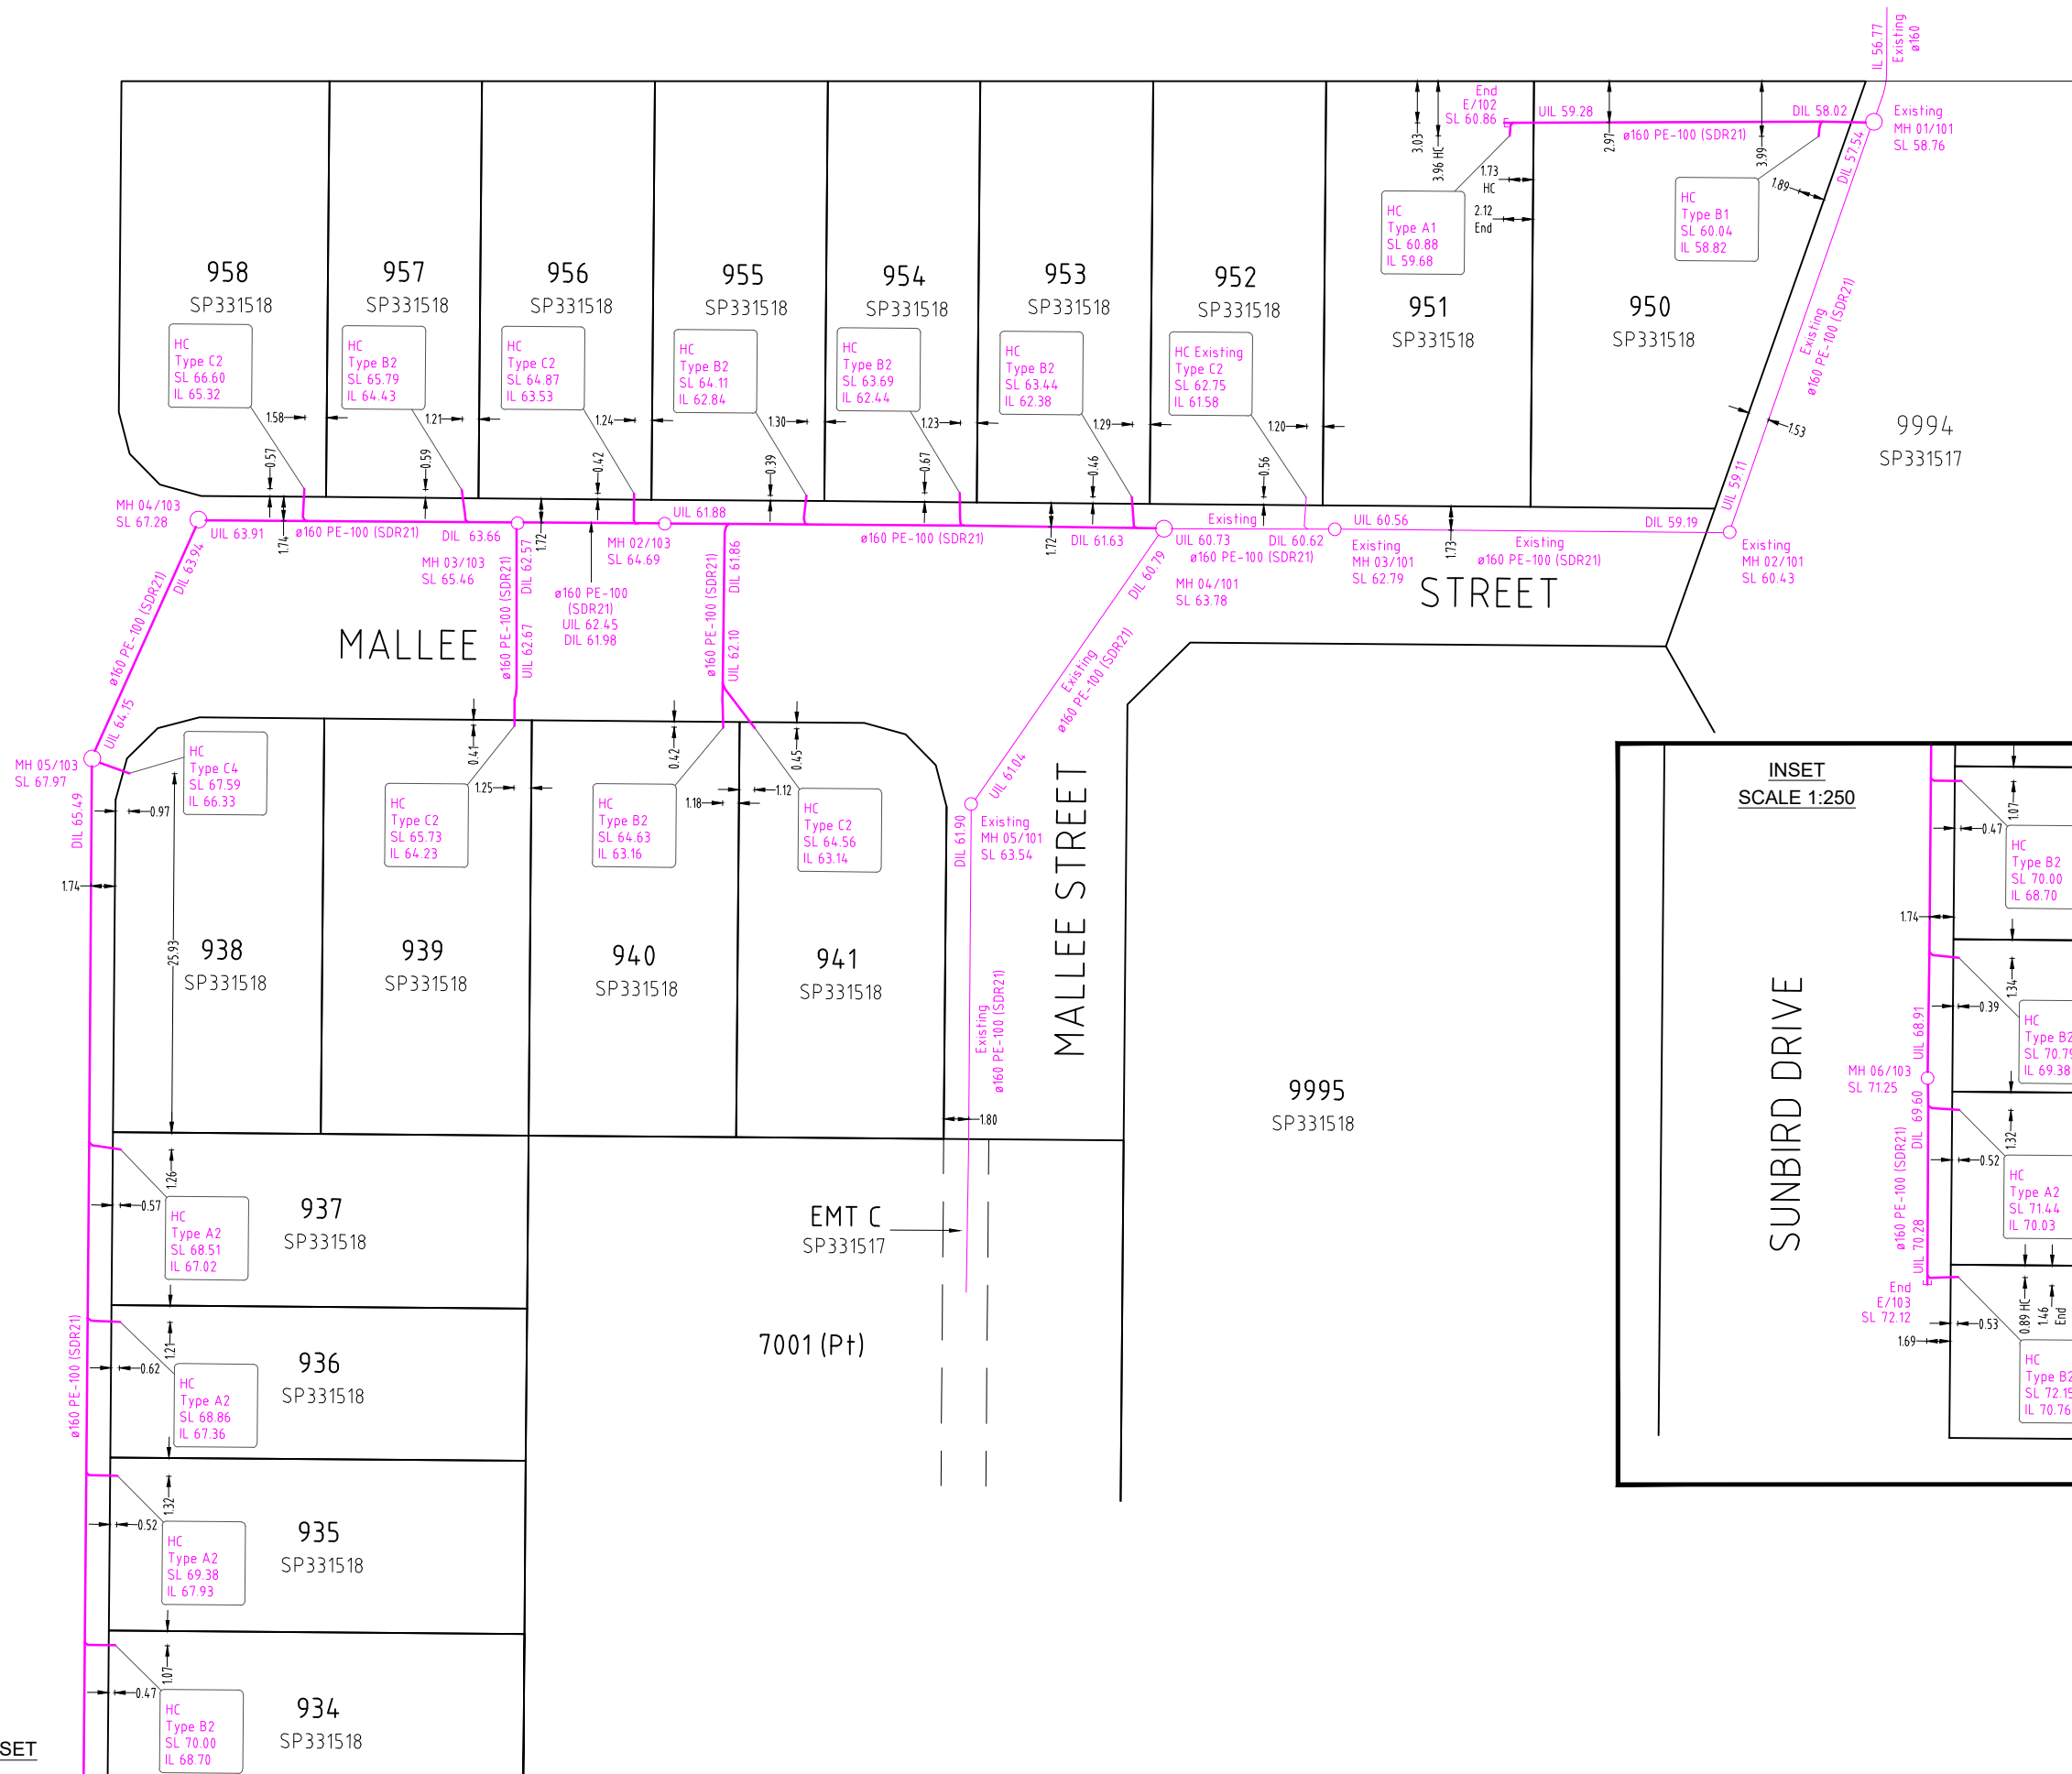


INSET
SCALE 1:250

SUNBIRD DRIVE

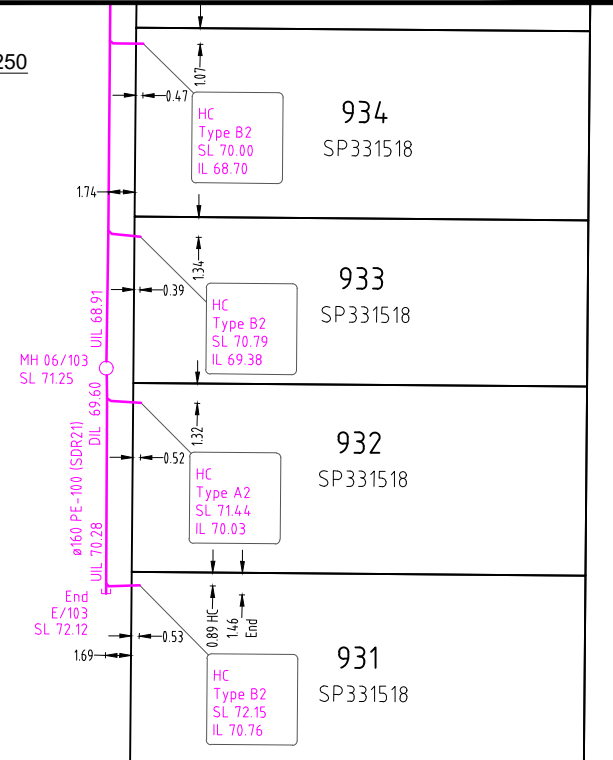

All house connections are Ø110
unless otherwise noted.

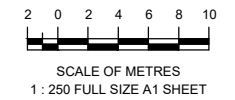

A1

REV NO	DATE	REVISION PURPOSE / DESCRIPTION	DRAWN	RPEQ	RPEQ No	INITIALS	DATE
B	13/09/2023	Minor Updates					
A	28/08/2023	Builders Issue					

DRAWN	TG	13/09/2023
CHECKED	MK	13/09/2023
APPROVED		


saunders havill group
Saunders Havill Group Pty Ltd ABN 54 144 572 543
head office 9 Thompson St Bowen Hills Q 4006
phone 0900 833 5145 web www.saundershavill.com
■ surveying ■ town planning ■ urban design ■ environmental management ■ landscape architecture

Drawing No: 9112 S 47 AC B



EDEN'S CROSSING ESTATE - STAGE 28
SUNBIRD DRIVE, REDBANK PLAINS
PLAN OF ADAC SURVEY DATA
SEWERAGE RETICULATION 22-PNT-55207

DRAWING STATUS AS CONSTRUCTED	
SHEET 1 OF 1 SHEETS	
DRAWING NO. 9112 S 47 AC B	REV. A

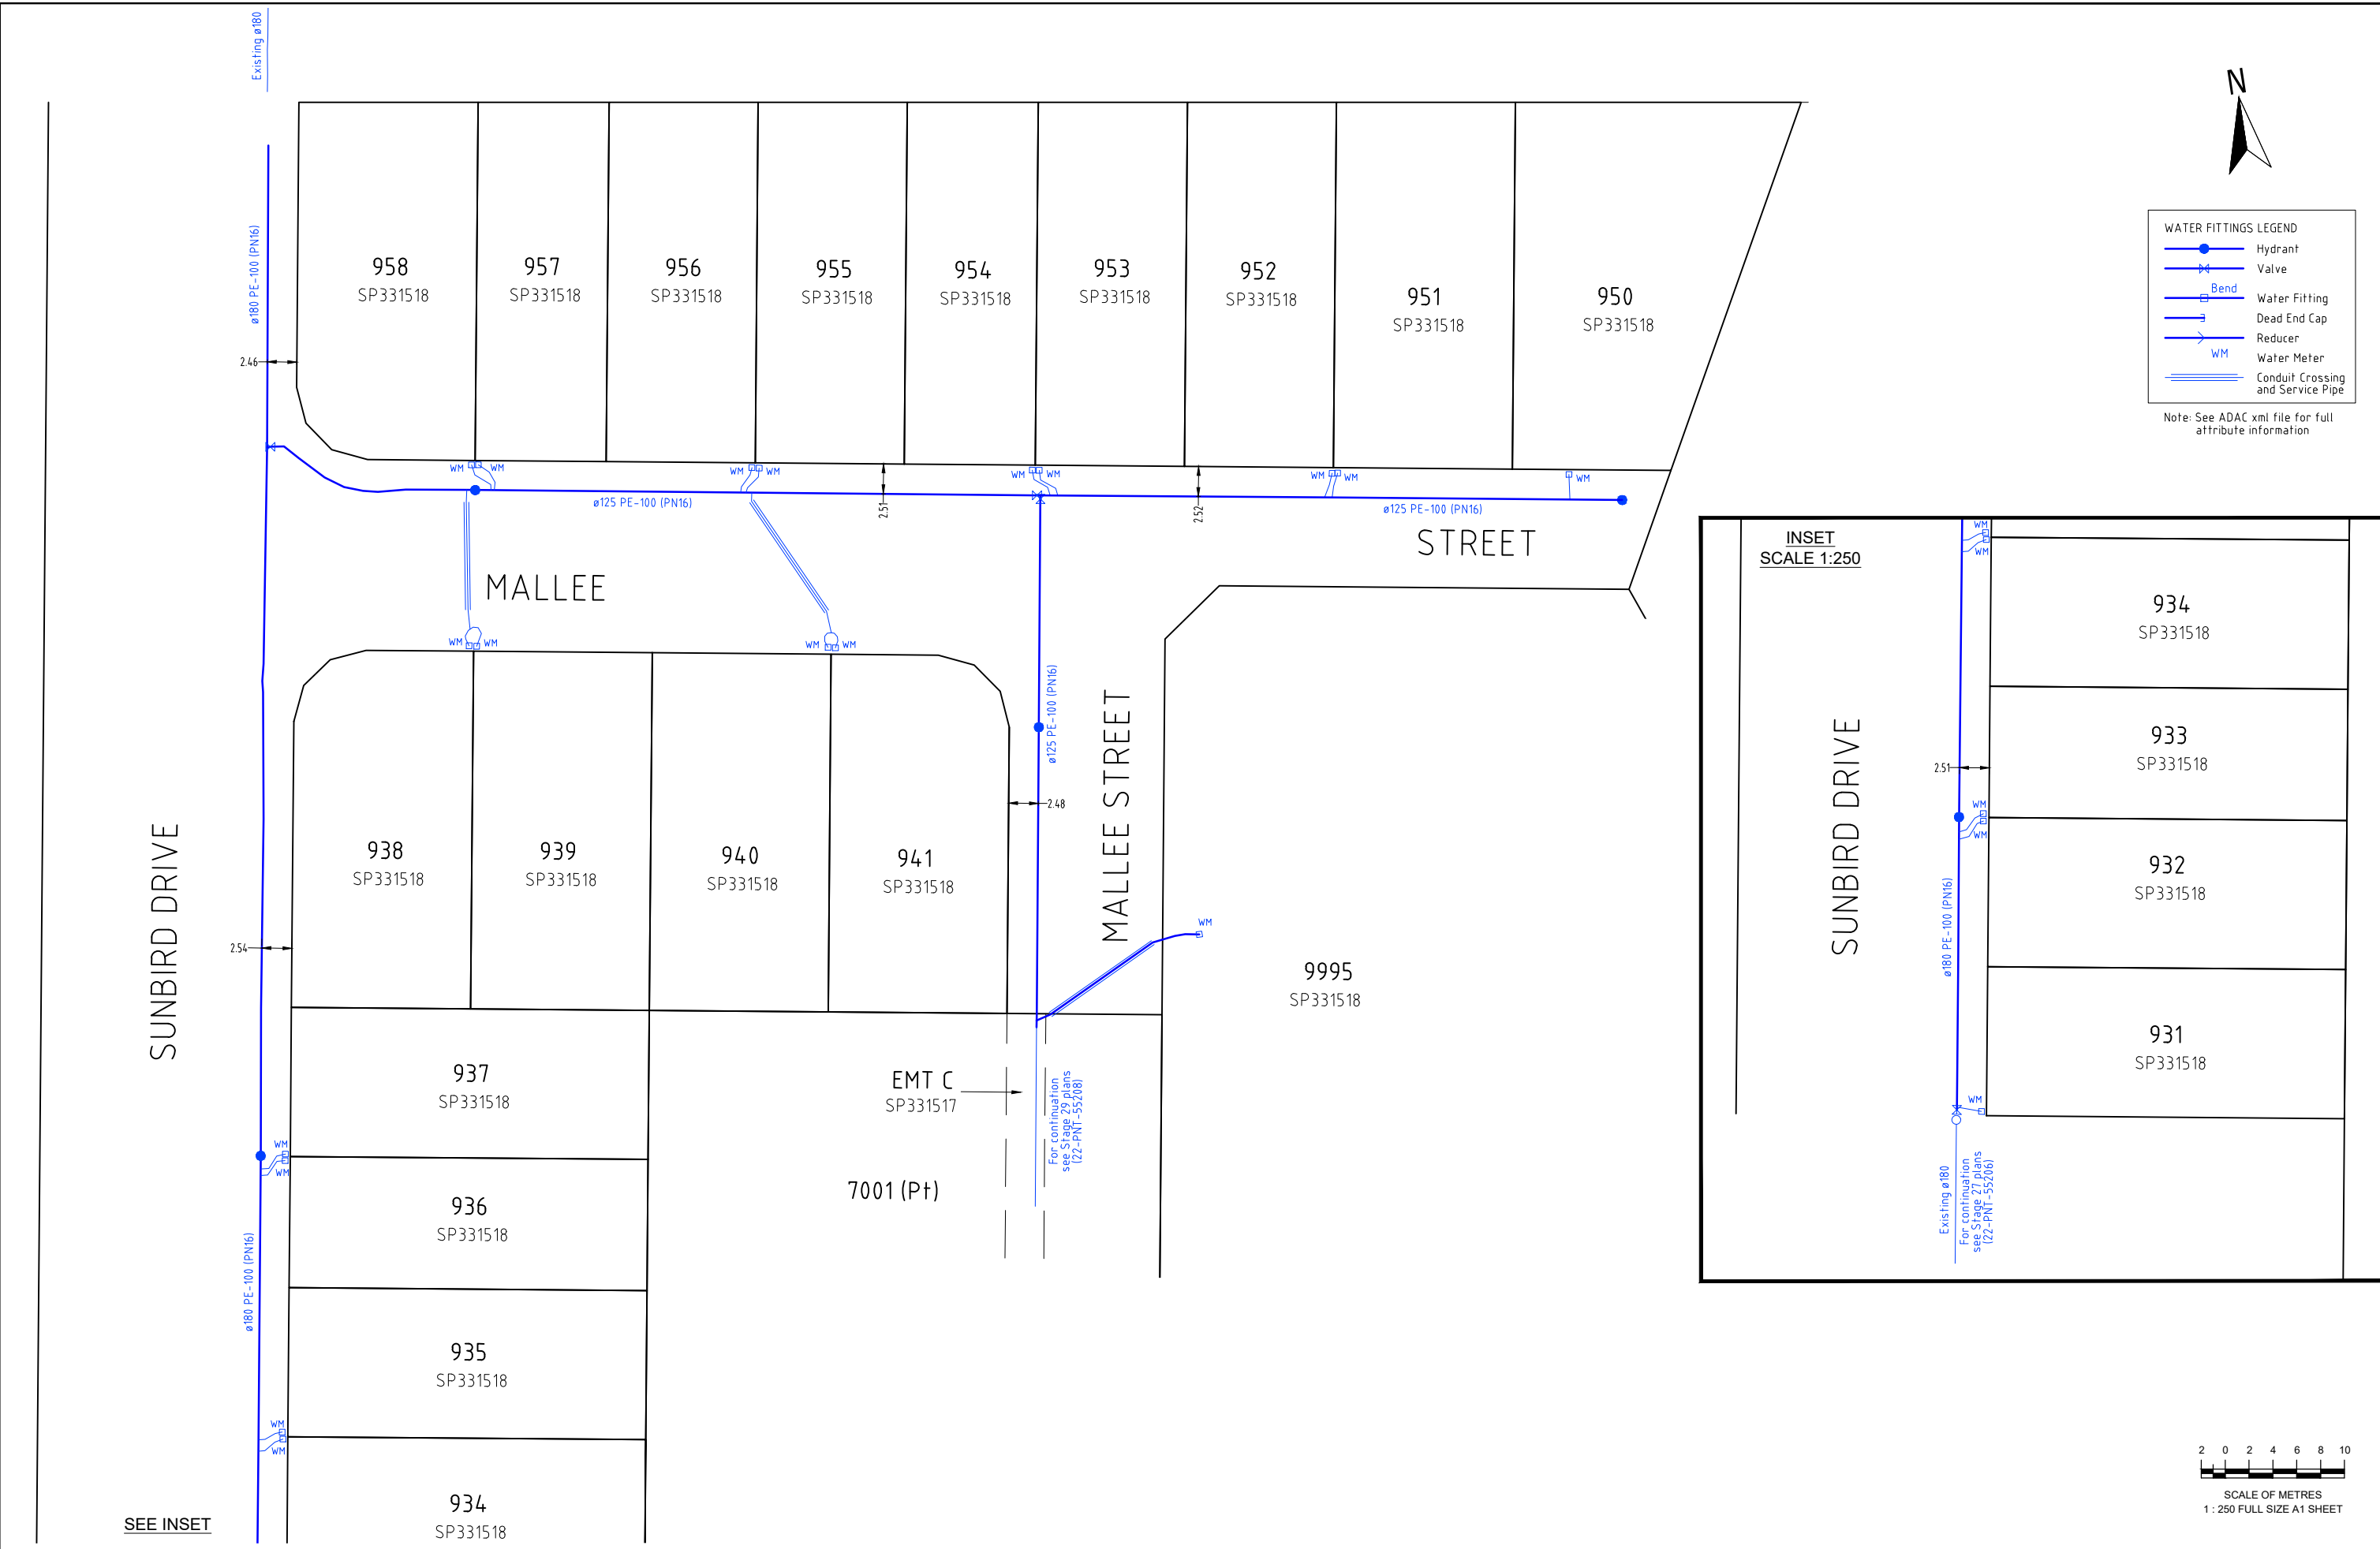

A1																																																																																																																																																																																																																																																																																																																																																																																																																																																																																																																																																																																																																																																																																																																																																																																																																																																																																																																																																																																																																																																																																																																																																																																																																																																																																																																																																																																																																				</
----	--	--	----