


PSM 191027
E 495937.616
N 7003052.339
RL 8.767m



UNITYWATER PROJECT NUMBER 20-000761.1

MARKET DRIVE, CABOOLTURE SOUTH

DN160/DN150 SEWER/WATER MAIN

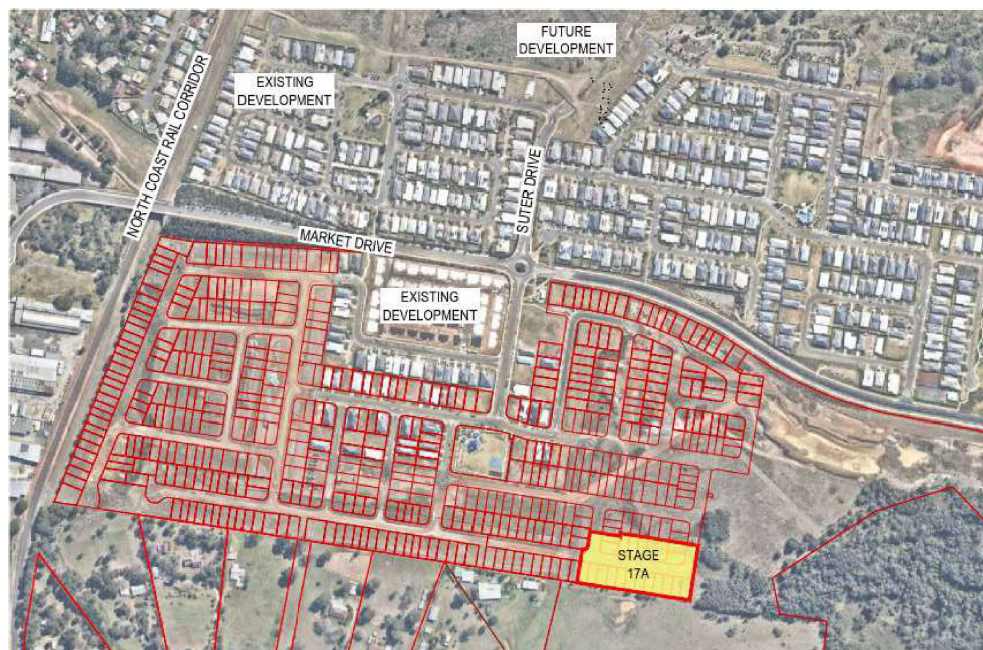

DRAWING INDEX		
DRAWING NUMBER	LOCALITY PLAN AND DRAWING INDEX	DESCRIPTION
U-2022-3972 Sheet 1		
U-2022-3972 Sheet 2	SEWER RETICULATION	
U-2022-3972 Sheet 3	WATER RETICULATION	

COORDINATE DATUM NOTE:
HORIZONTAL COORDINATES(E,N) SUPPLIED ARE MAPPING GRID OF AUSTRALIA(MGA),
ZONE 56 BASED ON THE UNIVERSAL TRANSVERSE MERCATOR PROJECTION AND THE
GEOCENTRIC DATUM OF AUSTRALIA 1994.

ENGINEER'S CERTIFICATION

I, mahdi farawati, hereby certify that:

- The information contained in this drawing / document is in compliance with approved drawings and design.
- The new water and sewerage works defined by this drawing have been designed and constructed in accordance with the SEO Code.
- This represents an accurate record of as-constructed works.
- I accept responsibility for the information contained in this drawing / document.

mahdi farawati
RPEQ (signature) RPEQ No. 219802 Date: 15-03-2023

REGISTERED SURVEYOR'S CERTIFICATION

I, Andrew Robert Thurston, hereby certify that the vertical and horizontal locations and dimensions shown on this plan are a true and correct record and were located by survey.

Andrew Robert Thurston
Registered Surveyor (sig) Reg. Surveyor No.03847 Date: 07/03/2023

AS CONSTRUCTED

A1	D	07.03.2023	AS CONSTRUCTED - SEWER UPDATES	JTC	AD	ART				 Unitywater	Unitywater 20-0007611 RIVERBANK STAGE 17A WATERSIDE ESPLANADE AS CONSTRUCTED	SHEET 1 OF 3 SHEETS	SCALE		
	C	27.02.2023	AS CONSTRUCTED - SEWER HC LEVELS UPDATED	JTC	AD	ART	DRAWN	JTC	07.03.2023			REVISION DATE	07.03.2023	REVISION	D
	B	21.12.2022	AS CONSTRUCTED-MINOR UPDATES TO SEWER AND WATER	JTC	AD	ART	CHECKED	AD	07.03.2023			DISCIPLINE CODE	C		
	A	01.12.2022	AS CONSTRUCTED	JTC	AD	ART	PASSED	ART	07.03.2023			DRAWING NO.	U-2022-3972		
	INDEX	DATE	REVISIONS	DRAWN	CHECKED	PASSED		INITIALS	DATE						

PSM 191027
E 495937.616
N 7003052.339
RL 8.767m
1358
SP321913

1356
SP321913

1354
SP321913

1355
SP321913

1352
SP321913

1351
SP321913

1350
SP321913

1349
SP321913

1348
SP321913

1347
SP321913

3000PT
SP324947

EMT HT
SP324947

STAGE 17A

I408
SP324947

I406
SP324947

I405
SP324947

I404
SP324947

I403
SP324947

I402
SP324947

I400
SP324947

I401
SP324947

I430
SP324947

I429
SP324947

I428
SP324947

I427
SP324947

I426
SP324947

I425
SP324947

I424
SP324947

I423
SP324947

I422
SP324947

I421
SP324947

I420
SP324947

I419
SP324947

LEGEND:

- Ø150 PVC-O CLASS PN16 WATERMAIN
— EXISTING WATER MAIN
— READY TAP PROPERTY CONNECTION
— HYDRANT
— SLUICE VALVE
— TAPER/REDUCER
— END CAP
— WATER SERVICE PIPE
— WATER SERVICE METER
— WATER SERVICE CONDUIT
— 1000 PVC-U CLASS PN9

ENGINEER'S CERTIFICATION

I, mahdi ferasat, hereby certify that:
1. The information contained in this drawing / document is in compliance with approved drawings and design.
2. The new water and sewerage works defined by this drawing have been designed and constructed in accordance with the SEQ Code.
3. This represents an accurate record of as-constructed works.
4. I accept responsibility for the information contained in this drawing / document.
RPEQ (signature) RPEQ No. 21992 Date: 15-03-2023

REGISTERED SURVEYOR'S CERTIFICATION

I, Andrew Roben Thurston, hereby certify that the vertical and horizontal locations and dimensions shown on this plan are a true and correct record and were located by me.
Registered Surveyor (sig.) Reg. Surveyor No. 83947 Date: 07.03.2023

COORDINATE DATUM NOTE:

HORIZONTAL COORDINATES(E,N) SUPPLIED ARE MAPPING GRID OF AUSTRALIA(MGA), ZONE 56 BASED ON THE UNIVERSAL TRANSVERSE MERCATOR PROJECTION AND THE GEODESIC DATUM OF AUSTRALIA 1994.

0 5 10 15 20 25m
SCALE 1:250 @A1

3000PT

SP324947

AS CONSTRUCTED

A1

INDEX	DATE	REVISIONS	DRAWN	CHECKED	PASSED	INITIALS	DATE
D	07.03.2023	AS CONSTRUCTED - SEWER UPDATES	JTC	AD	ART		
C	27.02.2023	AS CONSTRUCTED - SEWER HE LEVELS UPDATED	JTC	AD	ART	DRAWN	JTC 07.03.2023
B	21.12.2022	AS CONSTRUCTED-MINOR UPDATES TO SEWER AND WATER	JTC	AD	ART	CHECKED	AD 07.03.2023
A	01.12.2022	AS CONSTRUCTED	JTC	AD	ART	PASSED	ART 07.03.2023



Unitywater

20-0007611
RIVERBANK STAGE 17A
WATERSIDE ESPLANADE
WATER RETICULATION

SHEET 2 OF 3 SHEETS	SCALE 1:250
REVISION DATE 07.03.2023	REVISION D
DISCIPLINE CODE C	
DRAWING NO. U-2022-3972	

