


SEE SHEET 2

A1

| REV NO | DATE | REVISION PURPOSE / DESCRIPTION | DRAWN | RPEQ | RPEQ No | INITIALS | DATE |
|--------|------------|--------------------------------|-------|------|---------|----------|------|
| A | 05.06.2025 | Builders Issue | | | | | |



saunders havill group
Saunders Havill Group Pty Ltd ABN 24 144 572 543
head office 9 Thompson St Bowen Hills Q 4006
phone 0900 833 5145 web www.saundershavill.com
■ surveying ■ town planning ■ urban design ■ environmental management ■ landscape architecture

Drawing No: 9112 S 63 AC A



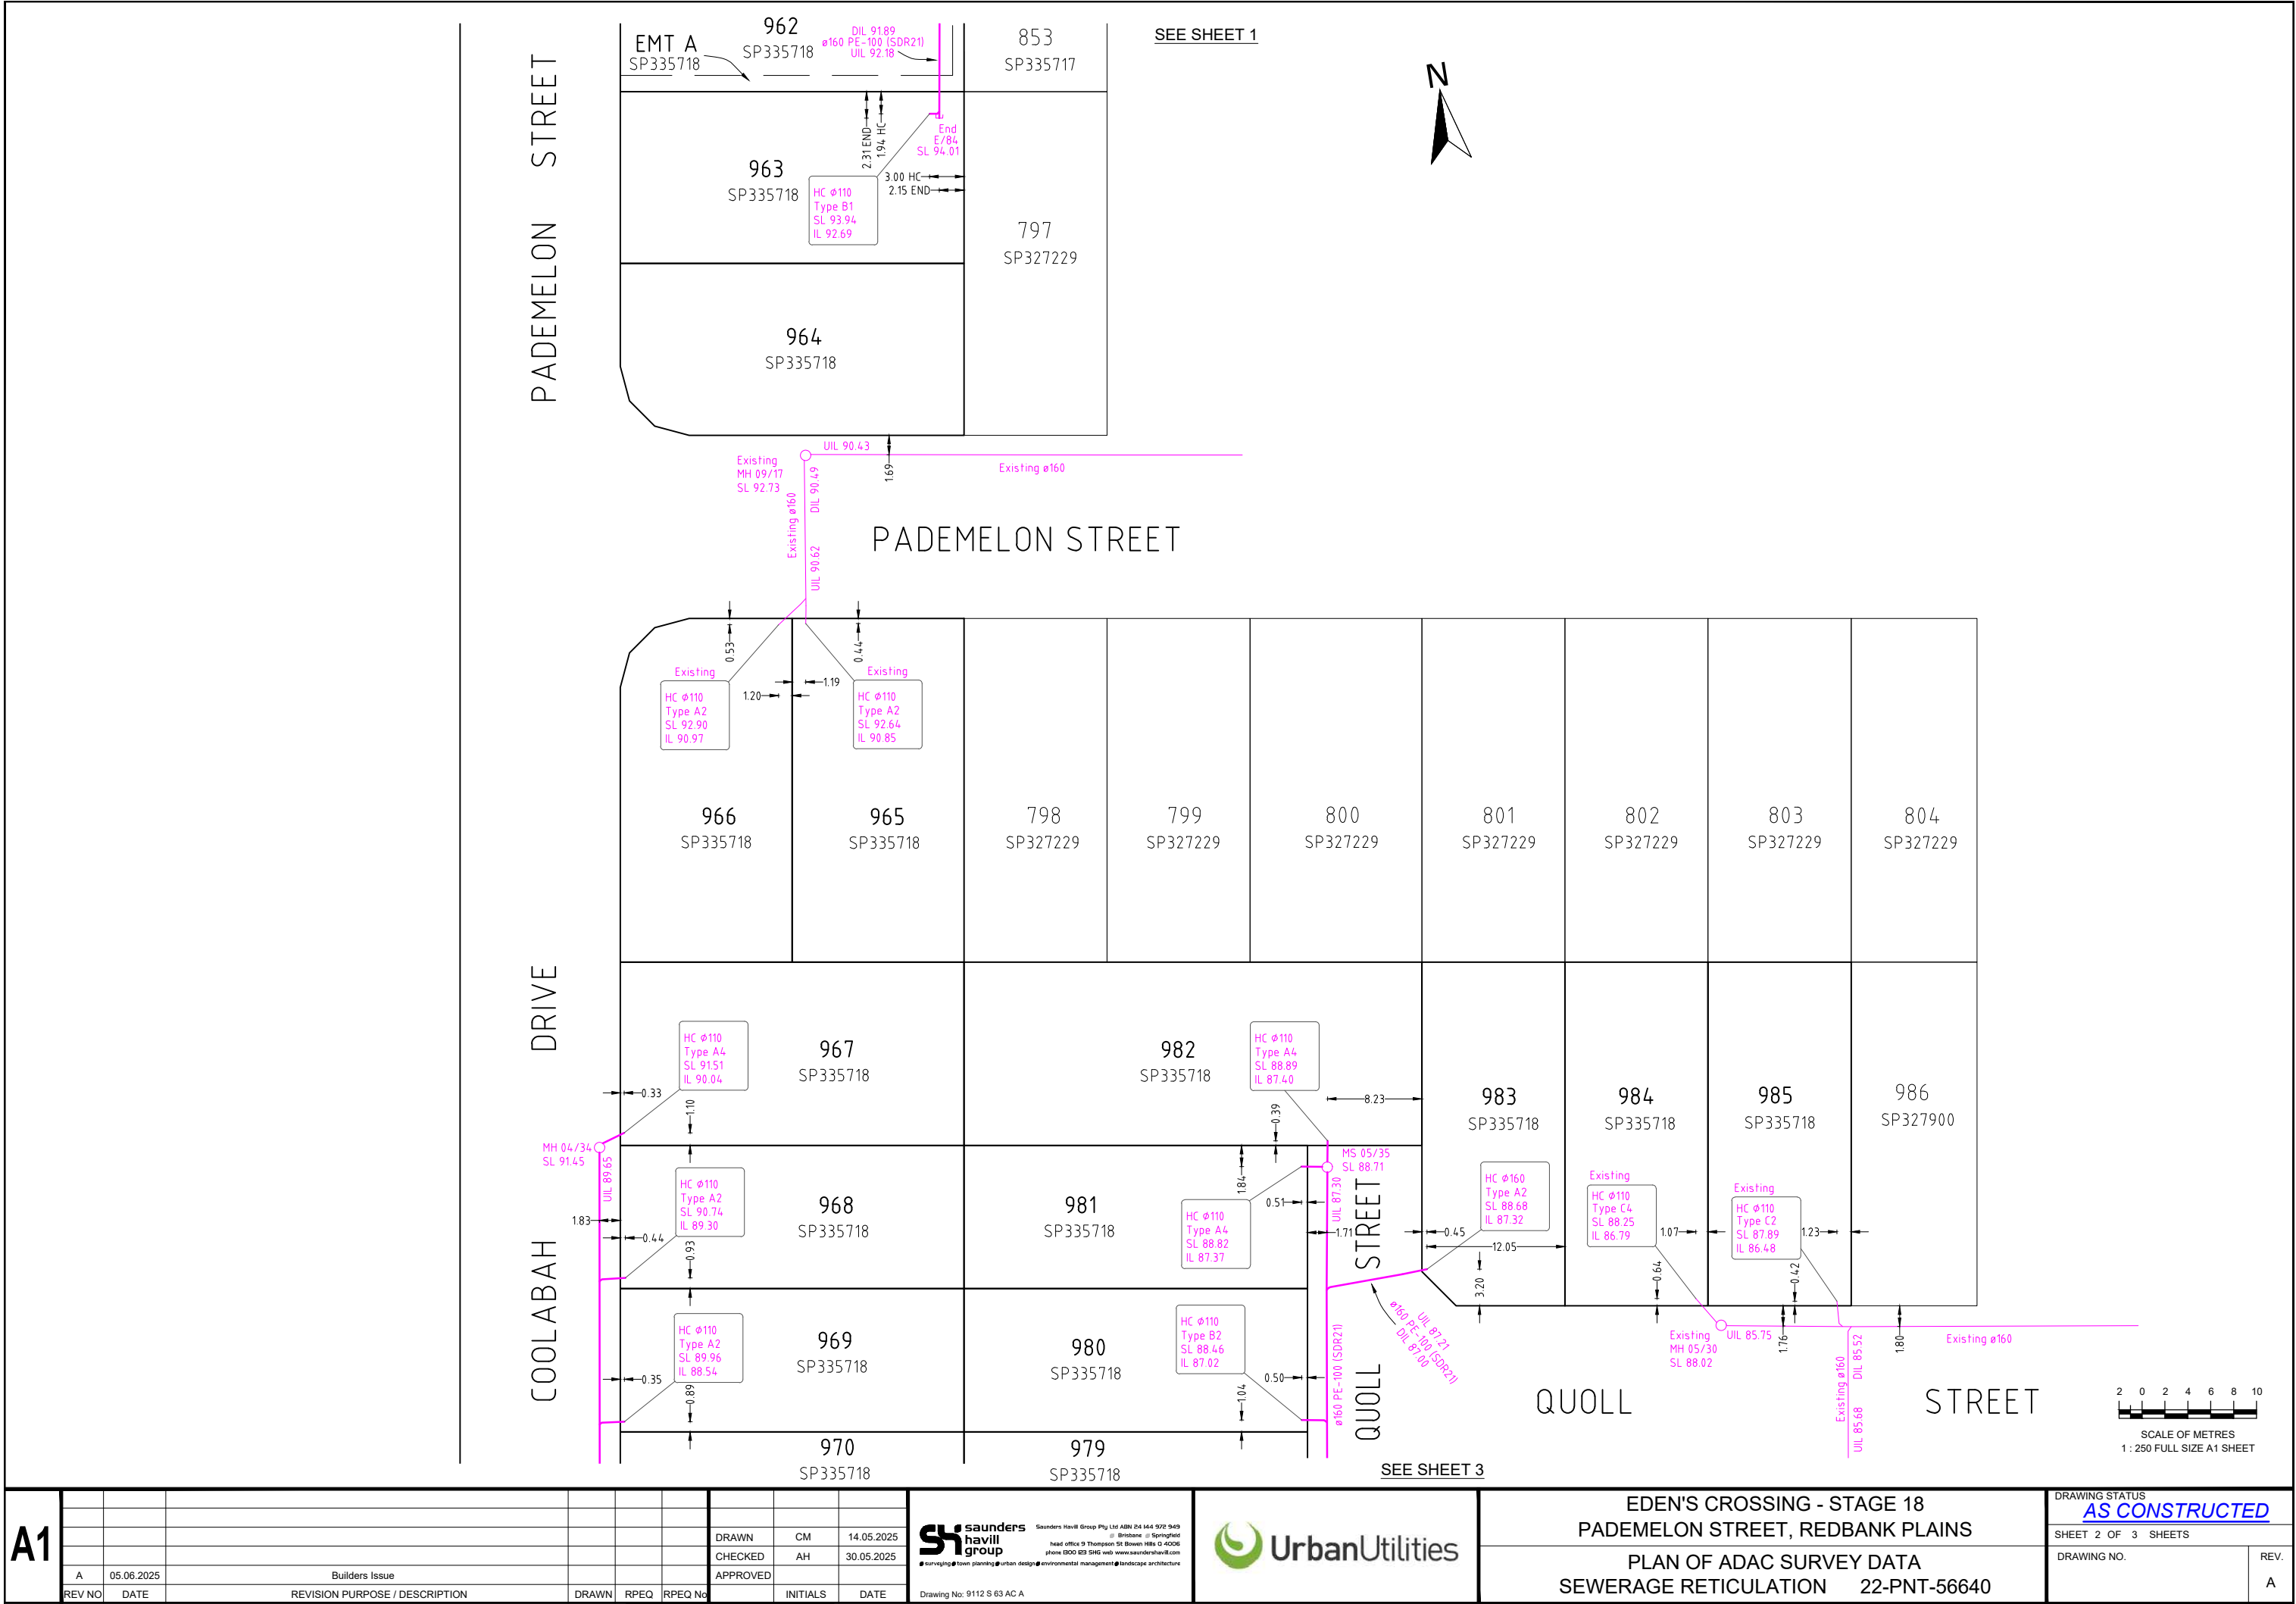
EDEN'S CROSSING - STAGE 18
PADEMELON STREET, REDBANK PLAINS

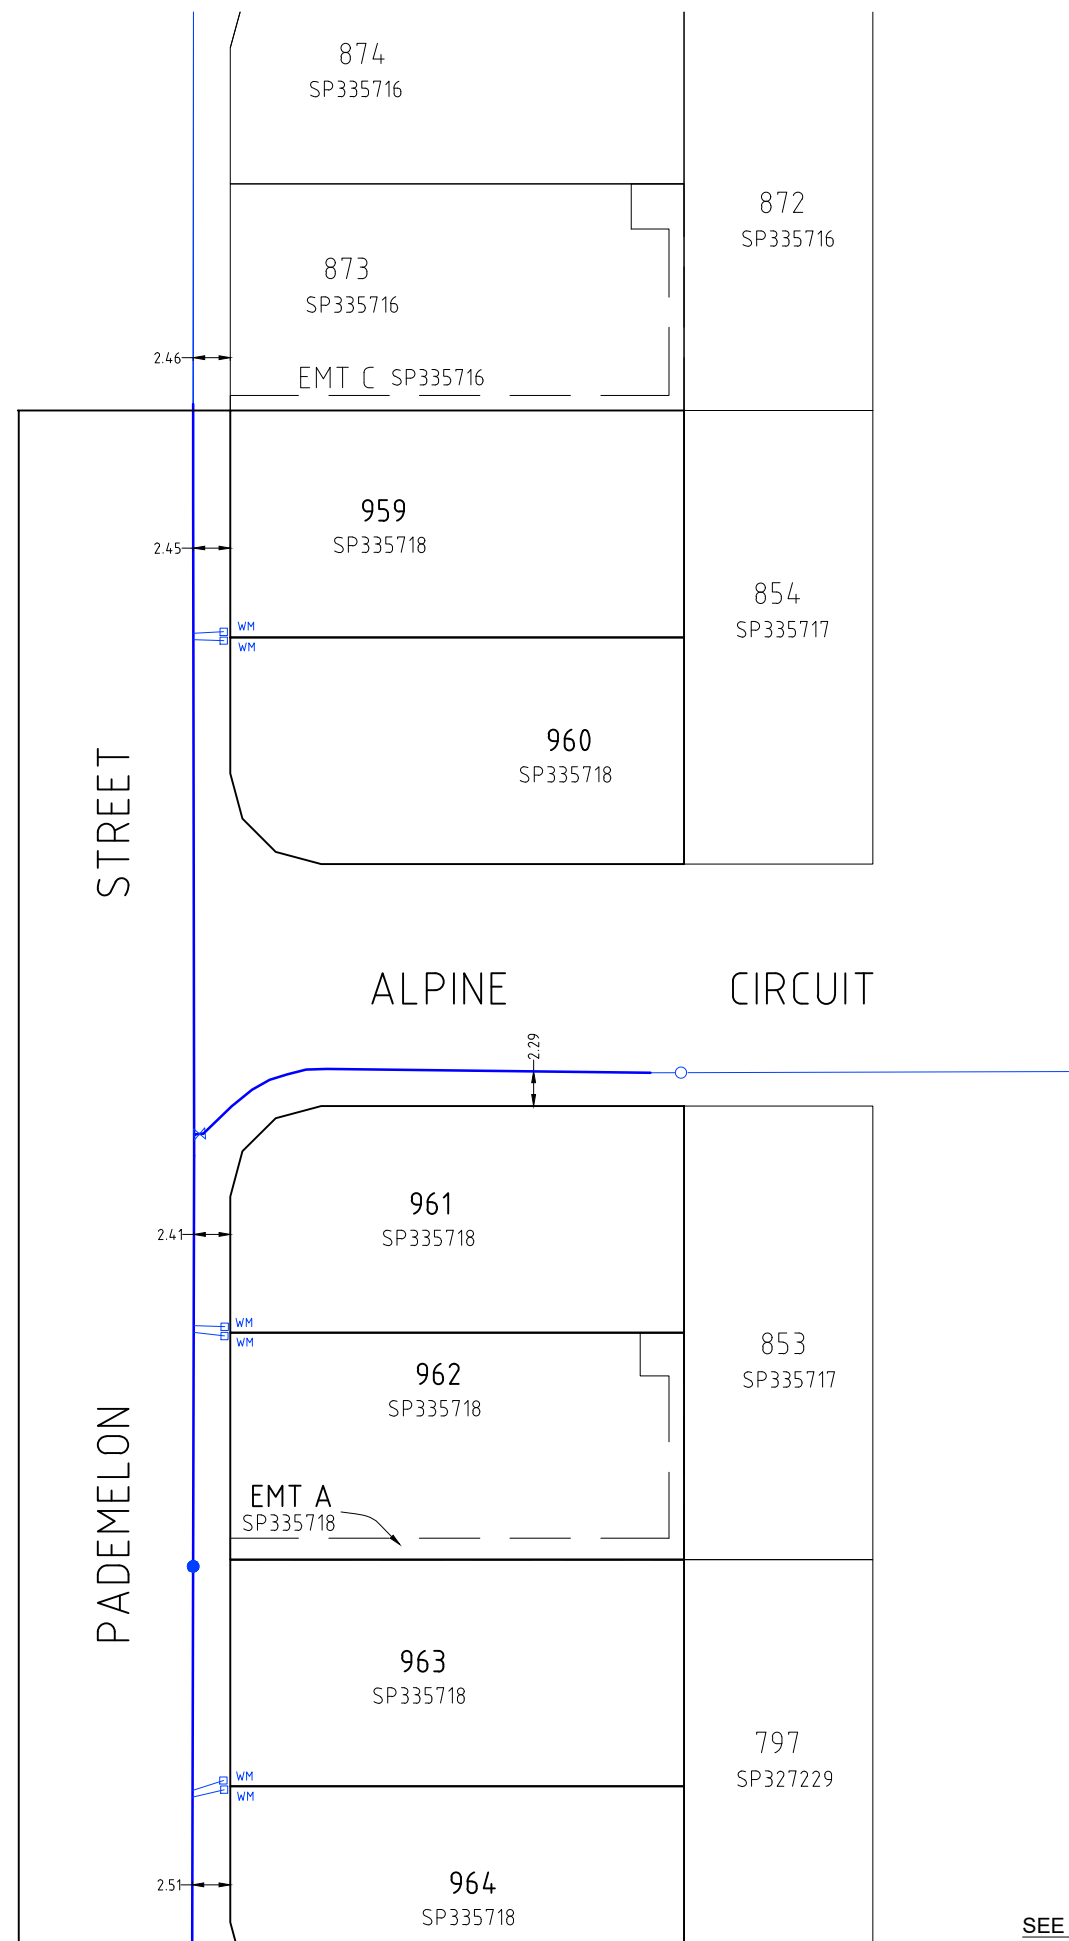
PLAN OF ADAC SURVEY DATA
SEWERAGE RETICULATION 22-PNT-56640

DRAWING STATUS
AS CONSTRUCTED


SHEET 1 OF 3 SHEETS

DRAWING NO. REV.
A





| WATER FITTINGS LEGEND | |
|-----------------------|-----------------------------------|
| | Hydrant |
| | Existing Hydrant |
| | Valve |
| | Existing Valve |
| | Water Fitting |
| | Dead End Cap |
| | Reducer |
| | Water Meter |
| | Conduit Crossing and Service Pipe |

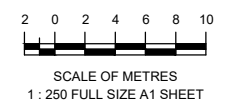

SEE SHEET 2

A1

| REV NO | DATE | REVISION PURPOSE / DESCRIPTION | DRAWN | RPEQ | RPEQ No | INITIALS | DATE |
|--------|------------|--------------------------------|-------|------|---------|----------|------|
| A | 05.06.2025 | Builders Issue | | | | | |


saunders havill group
Saunders Havill Group Pty Ltd ABN 54 144 572 943
head office 9 Thompson St Bowen Hills Q 4006
phone 0800 833 5115 web www.saundershavill.com


Drawing No: 9112 S 63 AC A



EDEN'S CROSSING - STAGE 18
PADEMELON STREET, REDBANK PLAINS
PLAN OF ADAC SURVEY DATA
WATER RETICULATION 22-PNT-56640

| DRAWING STATUS | |
|-----------------------|------|
| AS CONSTRUCTED | |
| SHEET 1 OF 3 SHEETS | |
| DRAWING NO. | REV. |
| | A |

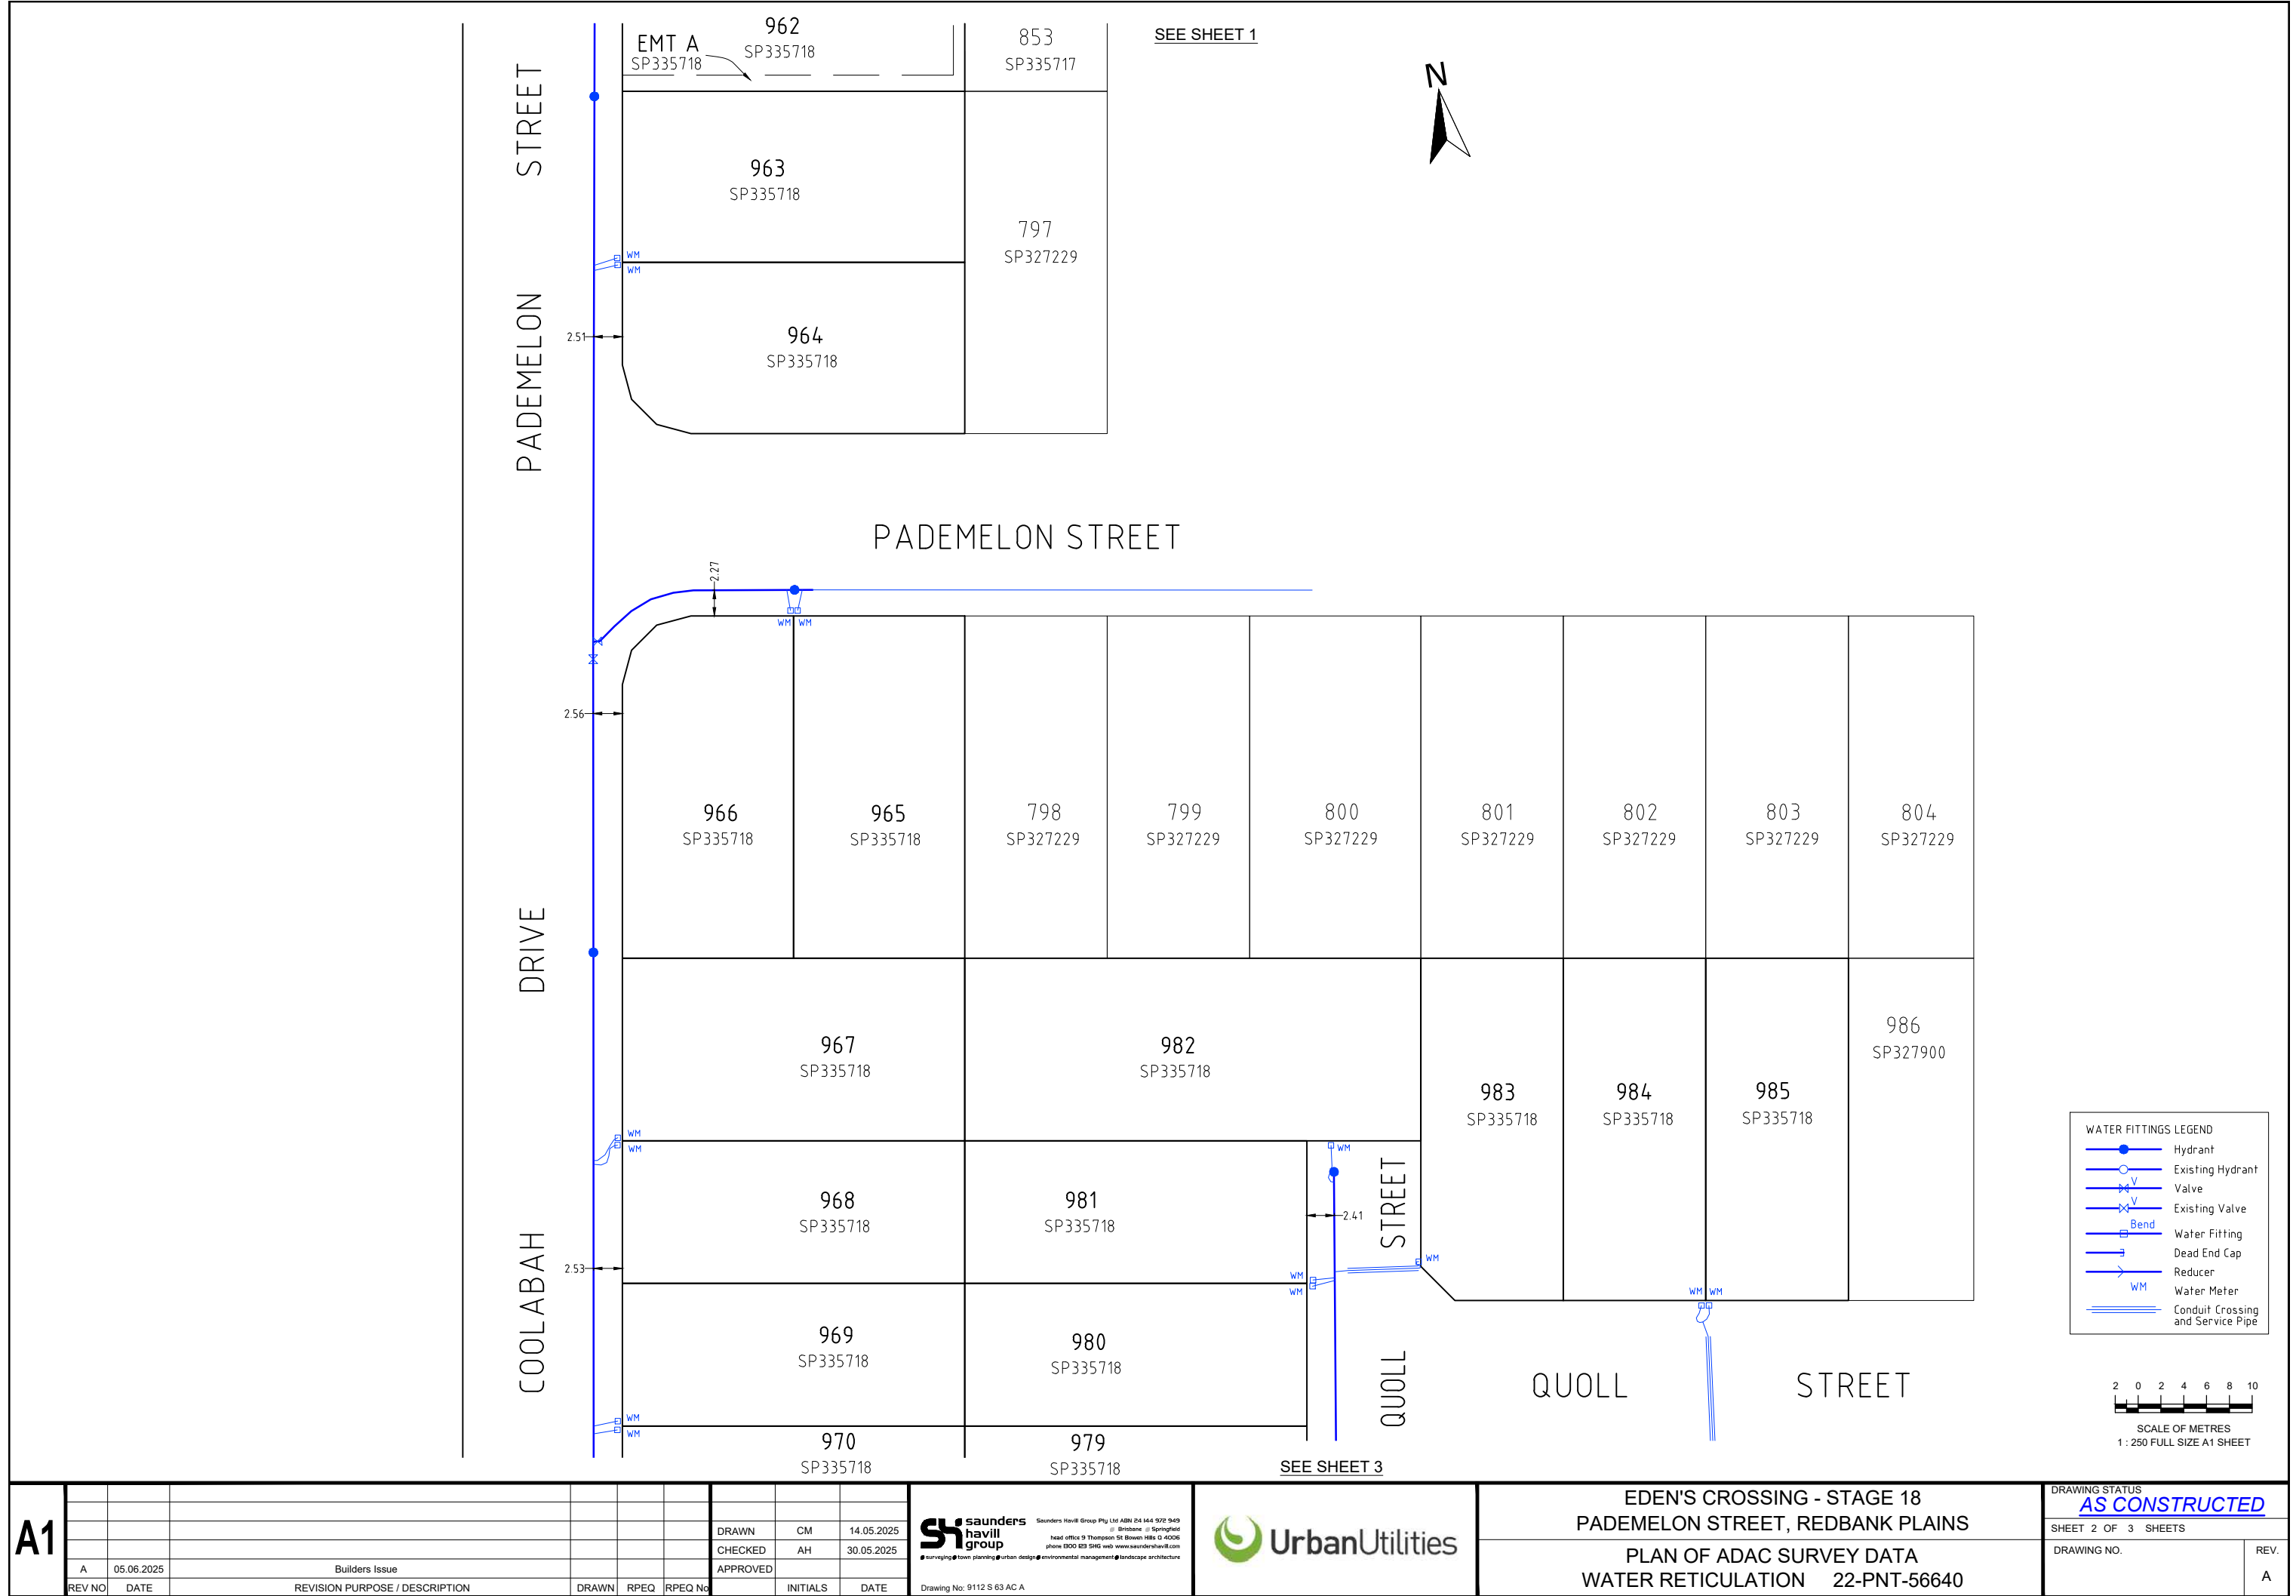

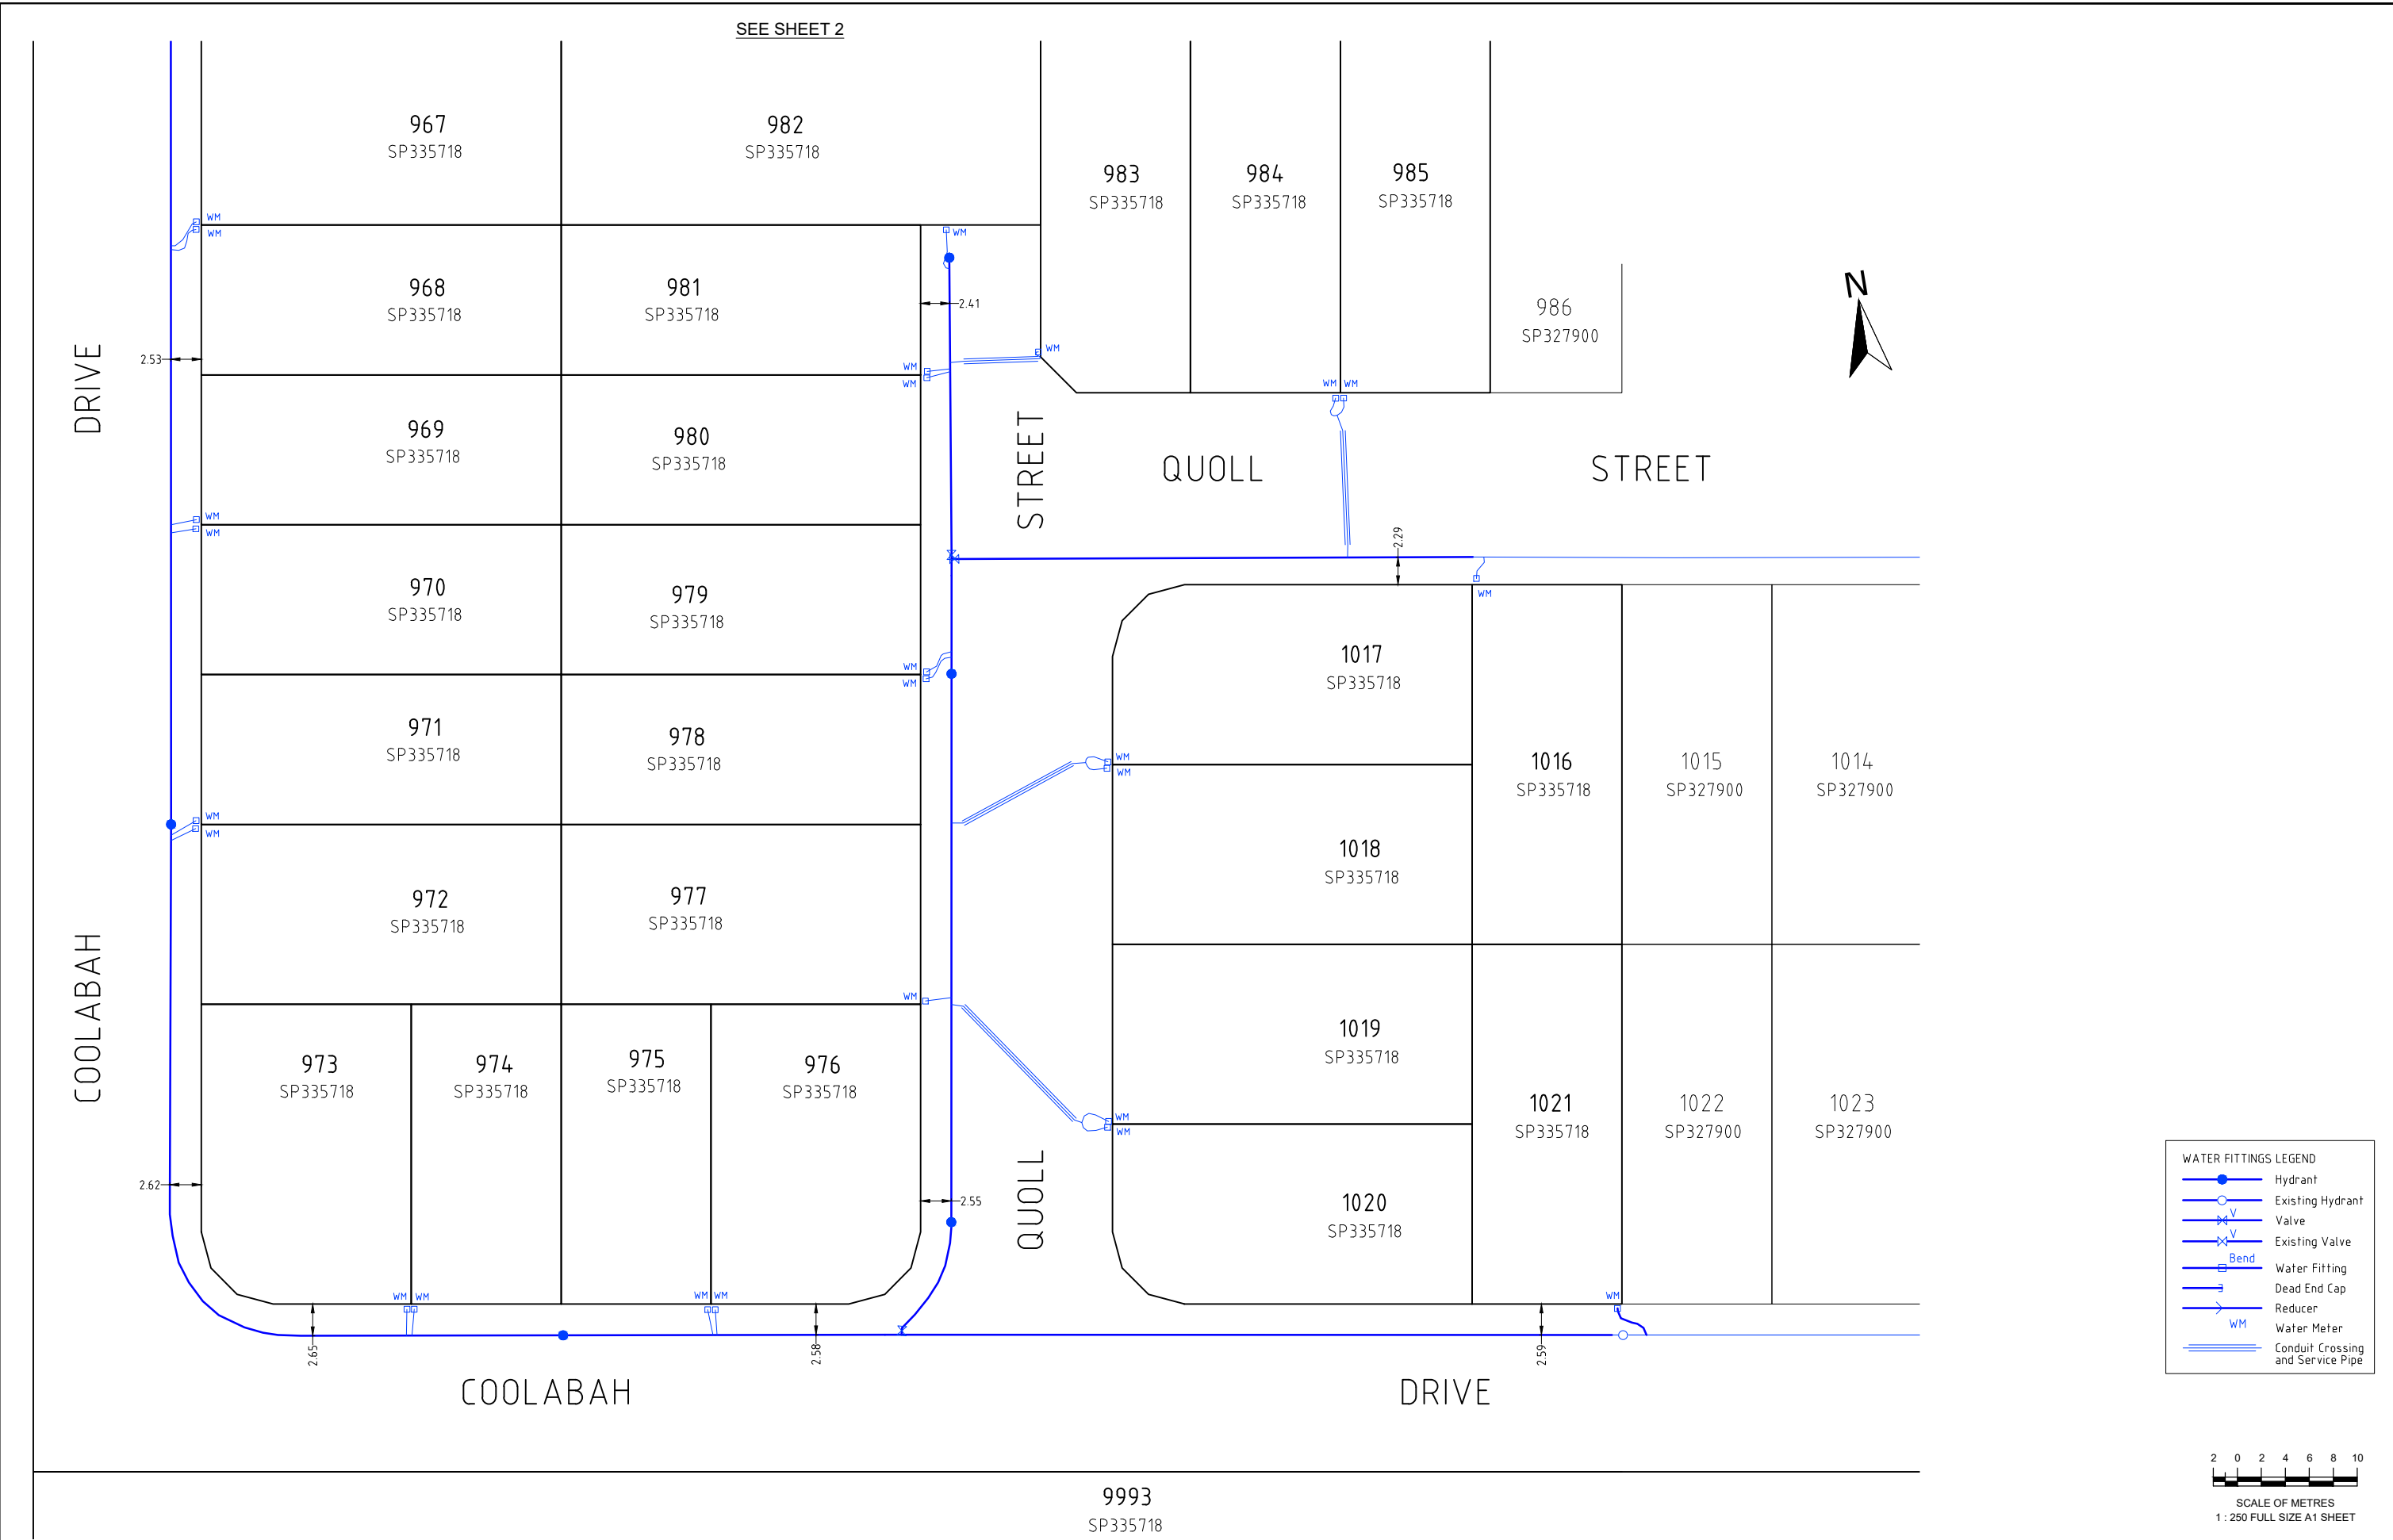

| |
|---|
| A1 | |
|---|