

<b>A1</b>	REV NO	DATE	REVISION PURPOSE / DESCRIPTION	DRAWN	RPEQ	RPEQ No
	A	05/03/26	Builders Issue			


DRAWN	CM	29.01.2026
CHECKED	CU	02.03.2026
APPROVED		
INITIALS		DATE

**Saunders Havill**  
BOWEN HILLS | SPRINGFIELD  
1300 123 744 | mail@saundershavill.com

**UrbanUtilities**

EDEN'S CROSSING - STAGE 30A  
VALE ST, REDBANK PLAINS  
AS CONSTRUCTED  
SEWERAGE RETICULATION 24-PNT-75139

DRAWING STATUS <b>AS CONSTRUCTED</b>	
SHEET 1 OF 2 SHEETS	
DRAWING NO.	REV.
	A

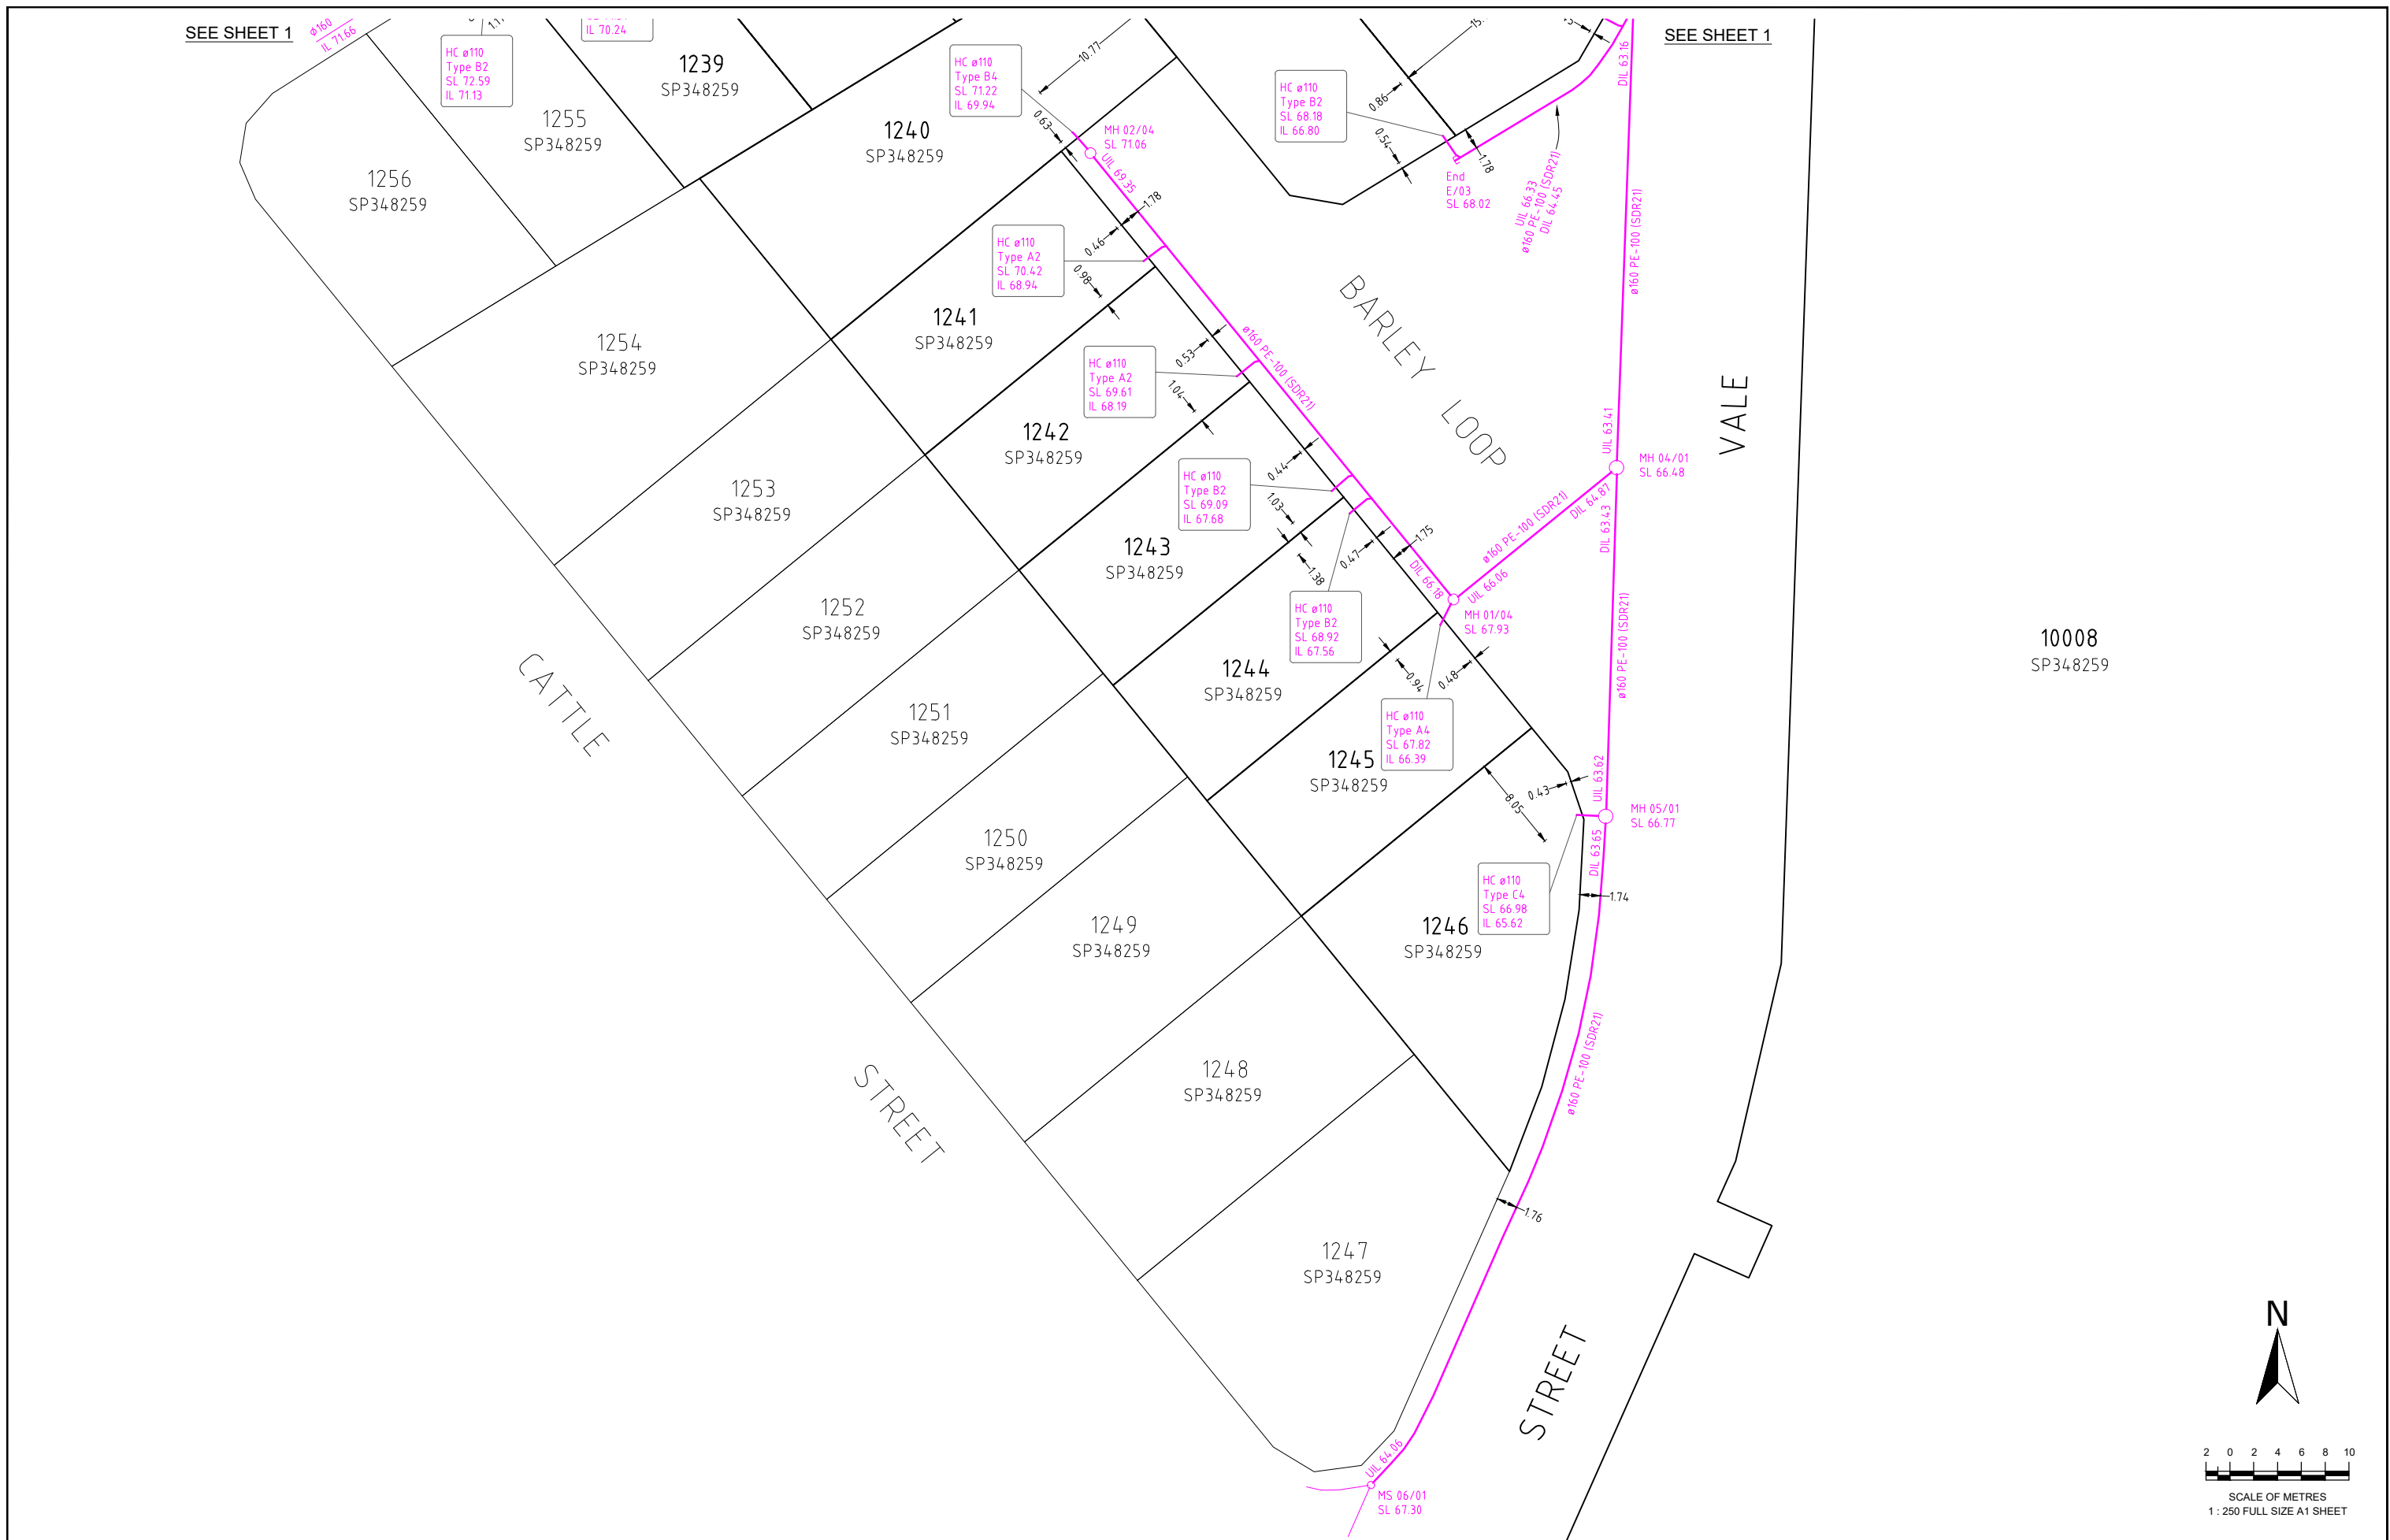

A1									
REV NO	DATE	REVISION PURPOSE / DESCRIPTION	DRAWN	RPEQ	RPEQ No	INITIALS	DATE		
A	05/03/26	Builders Issue							

DRAWN	CM	29.01.2026
CHECKED	CU	02.03.2026
APPROVED		

**Saunders Havill**  
BOWEN HILLS | SPRINGFIELD  
1300 123 744 | mail@saundershavill.com

**UrbanUtilities**

EDEN'S CROSSING - STAGE 30A  
VALE ST, REDBANK PLAINS  
AS CONSTRUCTED  
SEWERAGE RETICULATION 24-PNT-75139

DRAWING STATUS <b>AS CONSTRUCTED</b>	
SHEET 2 OF 2 SHEETS	
DRAWING NO.	REV.
	A



WATER FITTINGS LEGEND	
	Hydrant
	Valve
	Water Fitting
	Dead End Cap
	Reducer
	Water Meter
	Conduit Crossing and Service Pipe



**A1**

REV NO	DATE	REVISION PURPOSE / DESCRIPTION	DRAWN	RPEQ	RPEQ No
A	05/03/26	Builders Issue			

DRAWN	CM	29.01.2026
CHECKED	CU	02.03.2026
APPROVED		
INITIALS		DATE

**Saunders Havill**  
BOWEN HILLS | SPRINGFIELD  
1300 123 744 | mail@saundershavill.com

**UrbanUtilities**

EDEN'S CROSSING - STAGE 30A  
VALE ST, REDBANK PLAINS  
AS CONSTRUCTED  
WATER RETICULATION 24-PNT-75139

DRAWING STATUS <b>AS CONSTRUCTED</b>	
SHEET 2 OF 3 SHEETS	
DRAWING NO.	REV.
	A

**WATER FITTINGS LEGEND**

	Hydrant
	Valve
	Water Fitting
	Dead End Cap
	Reducer
	Water Meter
	Conduit Crossing and Service Pipe



SEE SHEET 2

**A1**

REV NO	DATE	REVISION PURPOSE / DESCRIPTION	DRAWN	RPEQ	RPEQ No	INITIALS	DATE
A	05/03/26	Builders Issue					

DRAWN	CM	29.01.2026
CHECKED	CU	02.03.2026
APPROVED		

**Saunders Havill**  
BOWEN HILLS | SPRINGFIELD  
1300 123 744 | mail@saundershavill.com

**UrbanUtilities**

EDEN'S CROSSING - STAGE 30A  
VALE ST, REDBANK PLAINS  
AS CONSTRUCTED  
WATER RETICULATION 24-PNT-75139

DRAWING STATUS <b>AS CONSTRUCTED</b>	
SHEET 3 OF 3 SHEETS	
DRAWING NO.	REV. A

Drawing No: 9919 S 16 AC A