


* The SL of house connections for lots in future stages are not final.

SEE SHEET 2

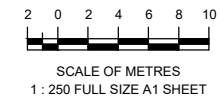

A1

REV NO	DATE	REVISION PURPOSE / DESCRIPTION	DRAWN	RPEQ	RPEQ No
A	05/03/2026	Builders Issue			



DRAWN	CM	25.02.2026
CHECKED	CU	27.02.2026
APPROVED		

Saunders Havill
BOWEN HILLS | SPRINGFIELD
1300 123 744 | mail@saundershavill.com

UrbanUtilities

EDEN'S CROSSING - STAGE 30B
VALE ST, REDBANK PLAINS
AS CONSTRUCTED
SEWERAGE RETICULATION 25-PNT-75133

DRAWING STATUS AS CONSTRUCTED	
SHEET 1 OF 2 SHEETS	
DRAWING NO.	REV. A

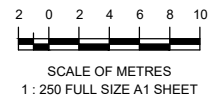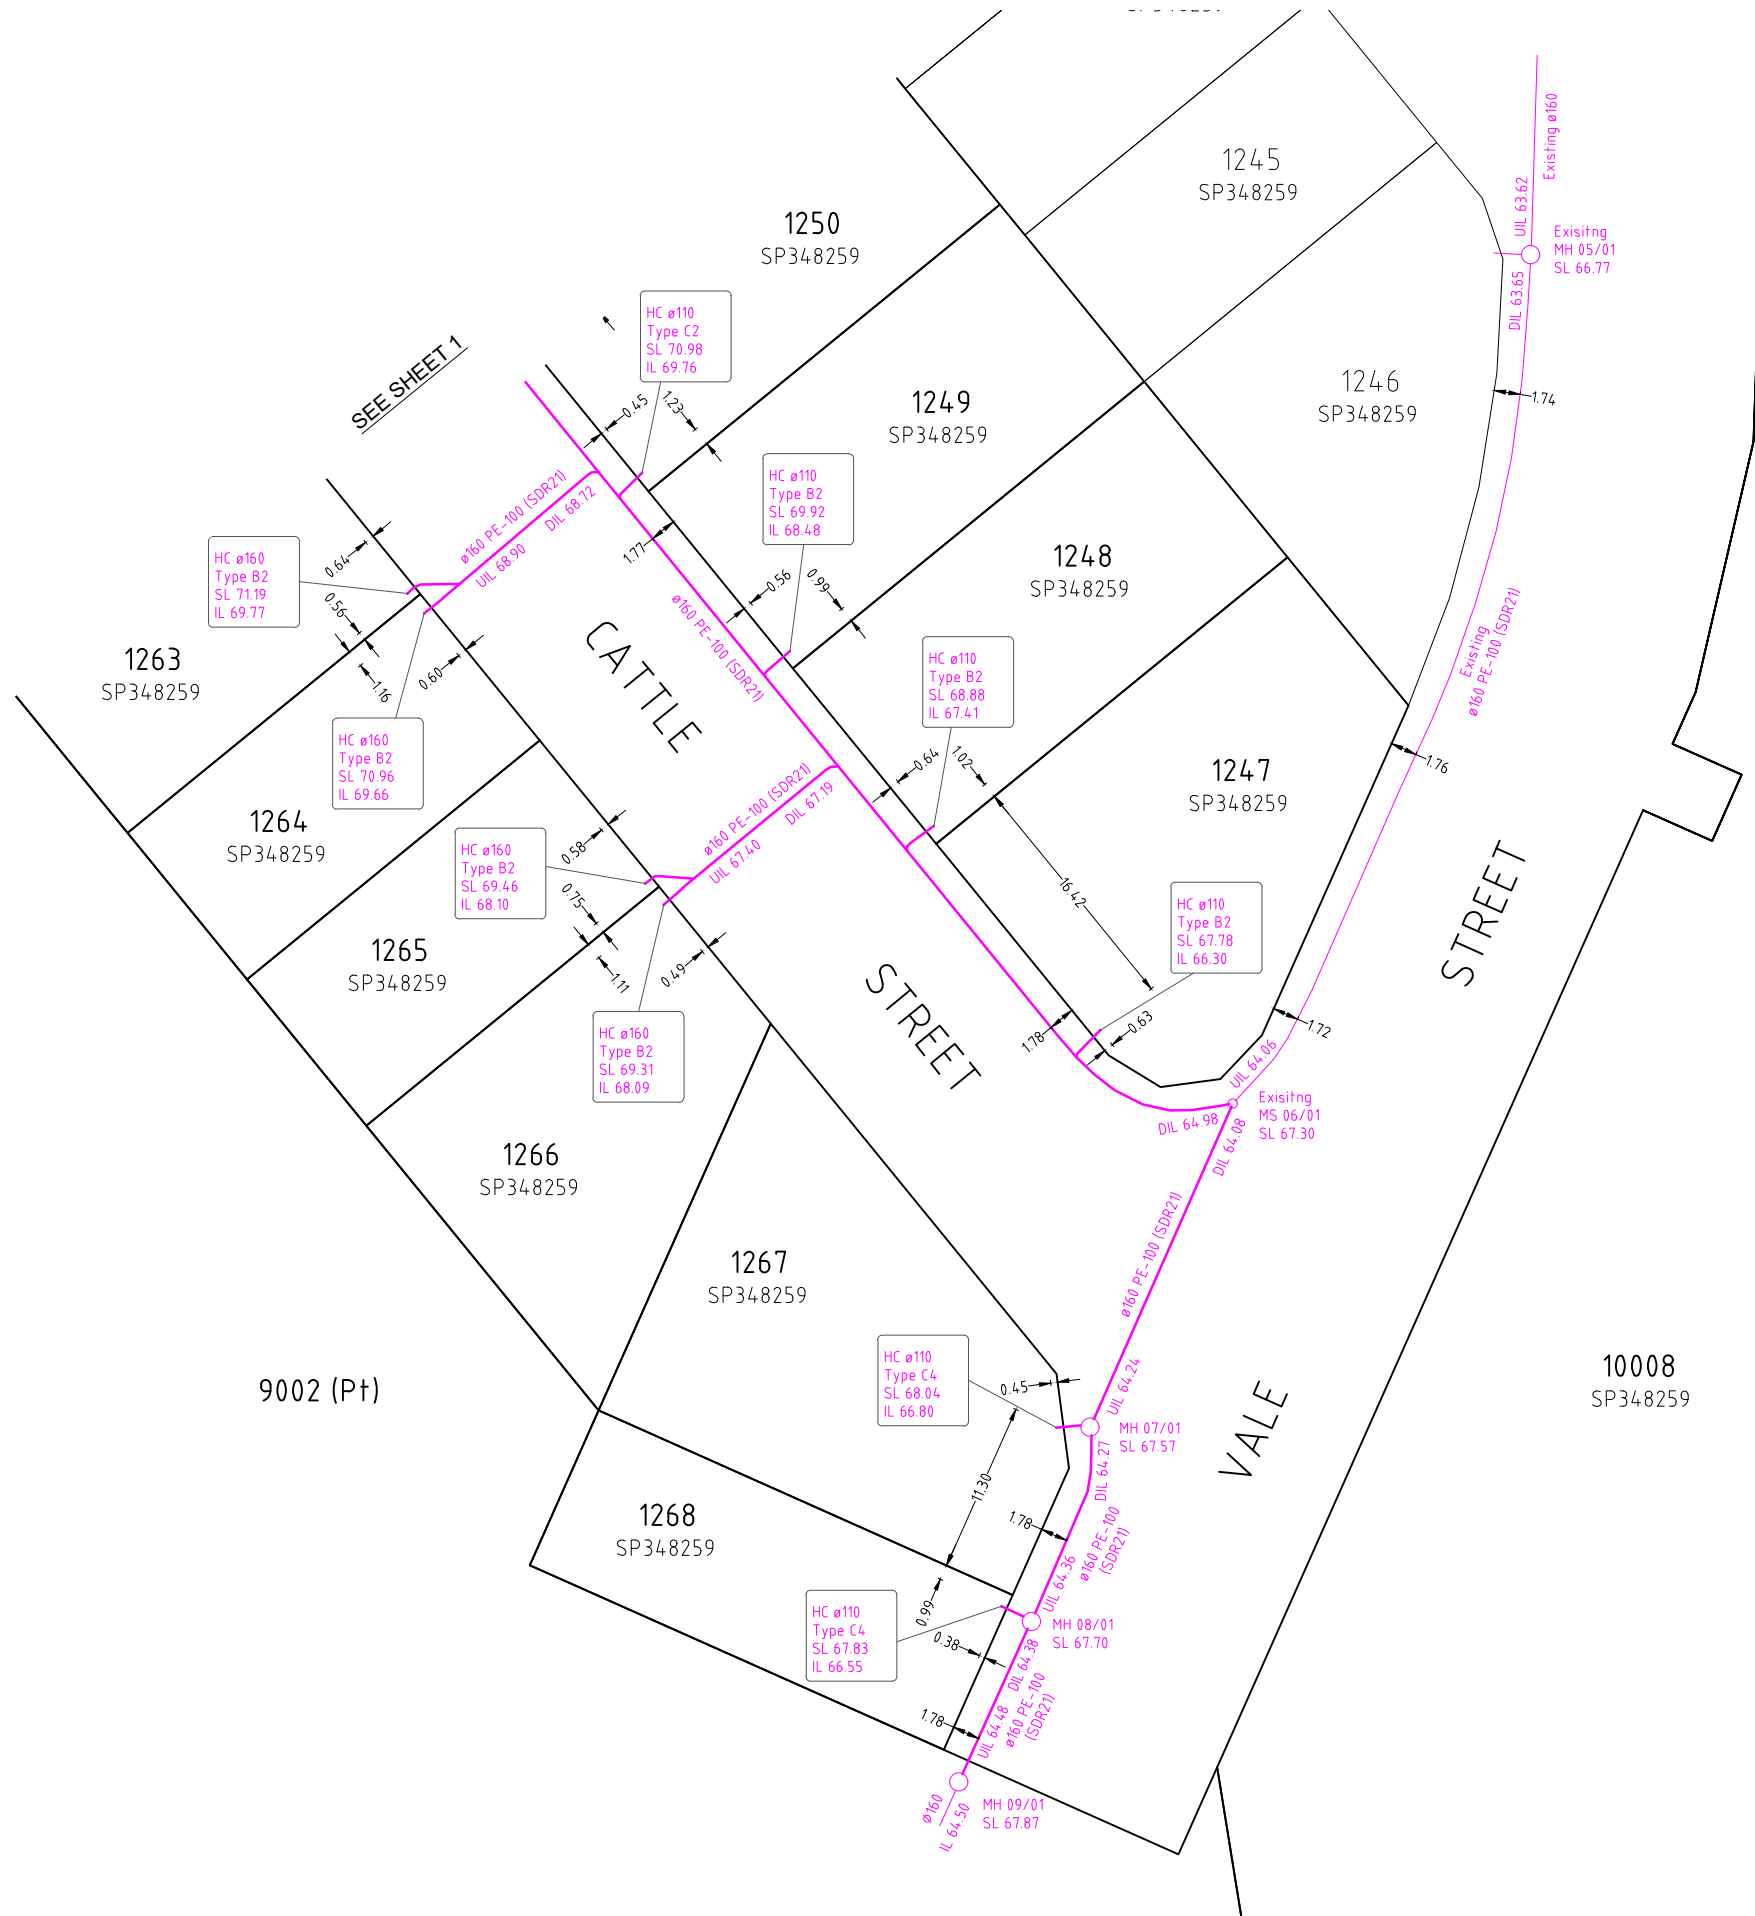

A1

REV NO	DATE	REVISION PURPOSE / DESCRIPTION	DRAWN	RPEQ	RPEQ No
A	05/03/2026	Builders Issue			

DRAWN	CM	25.02.2026
CHECKED	CU	27.02.2026
APPROVED		

Saunders Havill
BOWEN HILLS | SPRINGFIELD
1300 123 744 | mail@saundershavill.com

UrbanUtilities

EDEN'S CROSSING - STAGE 30B
VALE ST, REDBANK PLAINS
AS CONSTRUCTED
SEWERAGE RETICULATION 25-PNT-75133

DRAWING STATUS AS CONSTRUCTED	
SHEET 2 OF 2 SHEETS	
DRAWING NO.	REV. A

WATER FITTINGS LEGEND	
	Hydrant
	Valve
	Water Fitting
	Dead End Cap
	Reducer
	Water Meter
	Conduit Crossing and Service Pipe



A1

REV NO	DATE	REVISION PURPOSE / DESCRIPTION	DRAWN	RPEQ	RPEQ No	INITIALS	DATE
A	05/03/2026	Builders Issue					

DRAWN	CM	25.02.2026
CHECKED	CU	27.02.2026
APPROVED		

Saunders Havill
BOWEN HILLS | SPRINGFIELD
1300 123 744 | mail@saundershavill.com



UrbanUtilities

EDEN'S CROSSING - STAGE 30B
VALE ST, REDBANK PLAINS
AS CONSTRUCTED
WATER RETICULATION 25-PNT-75133

DRAWING STATUS AS CONSTRUCTED	
SHEET 1 OF 2 SHEETS	
DRAWING NO.	REV. A



WATER FITTINGS LEGEND	
	Hydrant
	Valve
	Water Fitting
	Dead End Cap
	Reducer
	Water Meter
	Conduit Crossing and Service Pipe

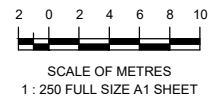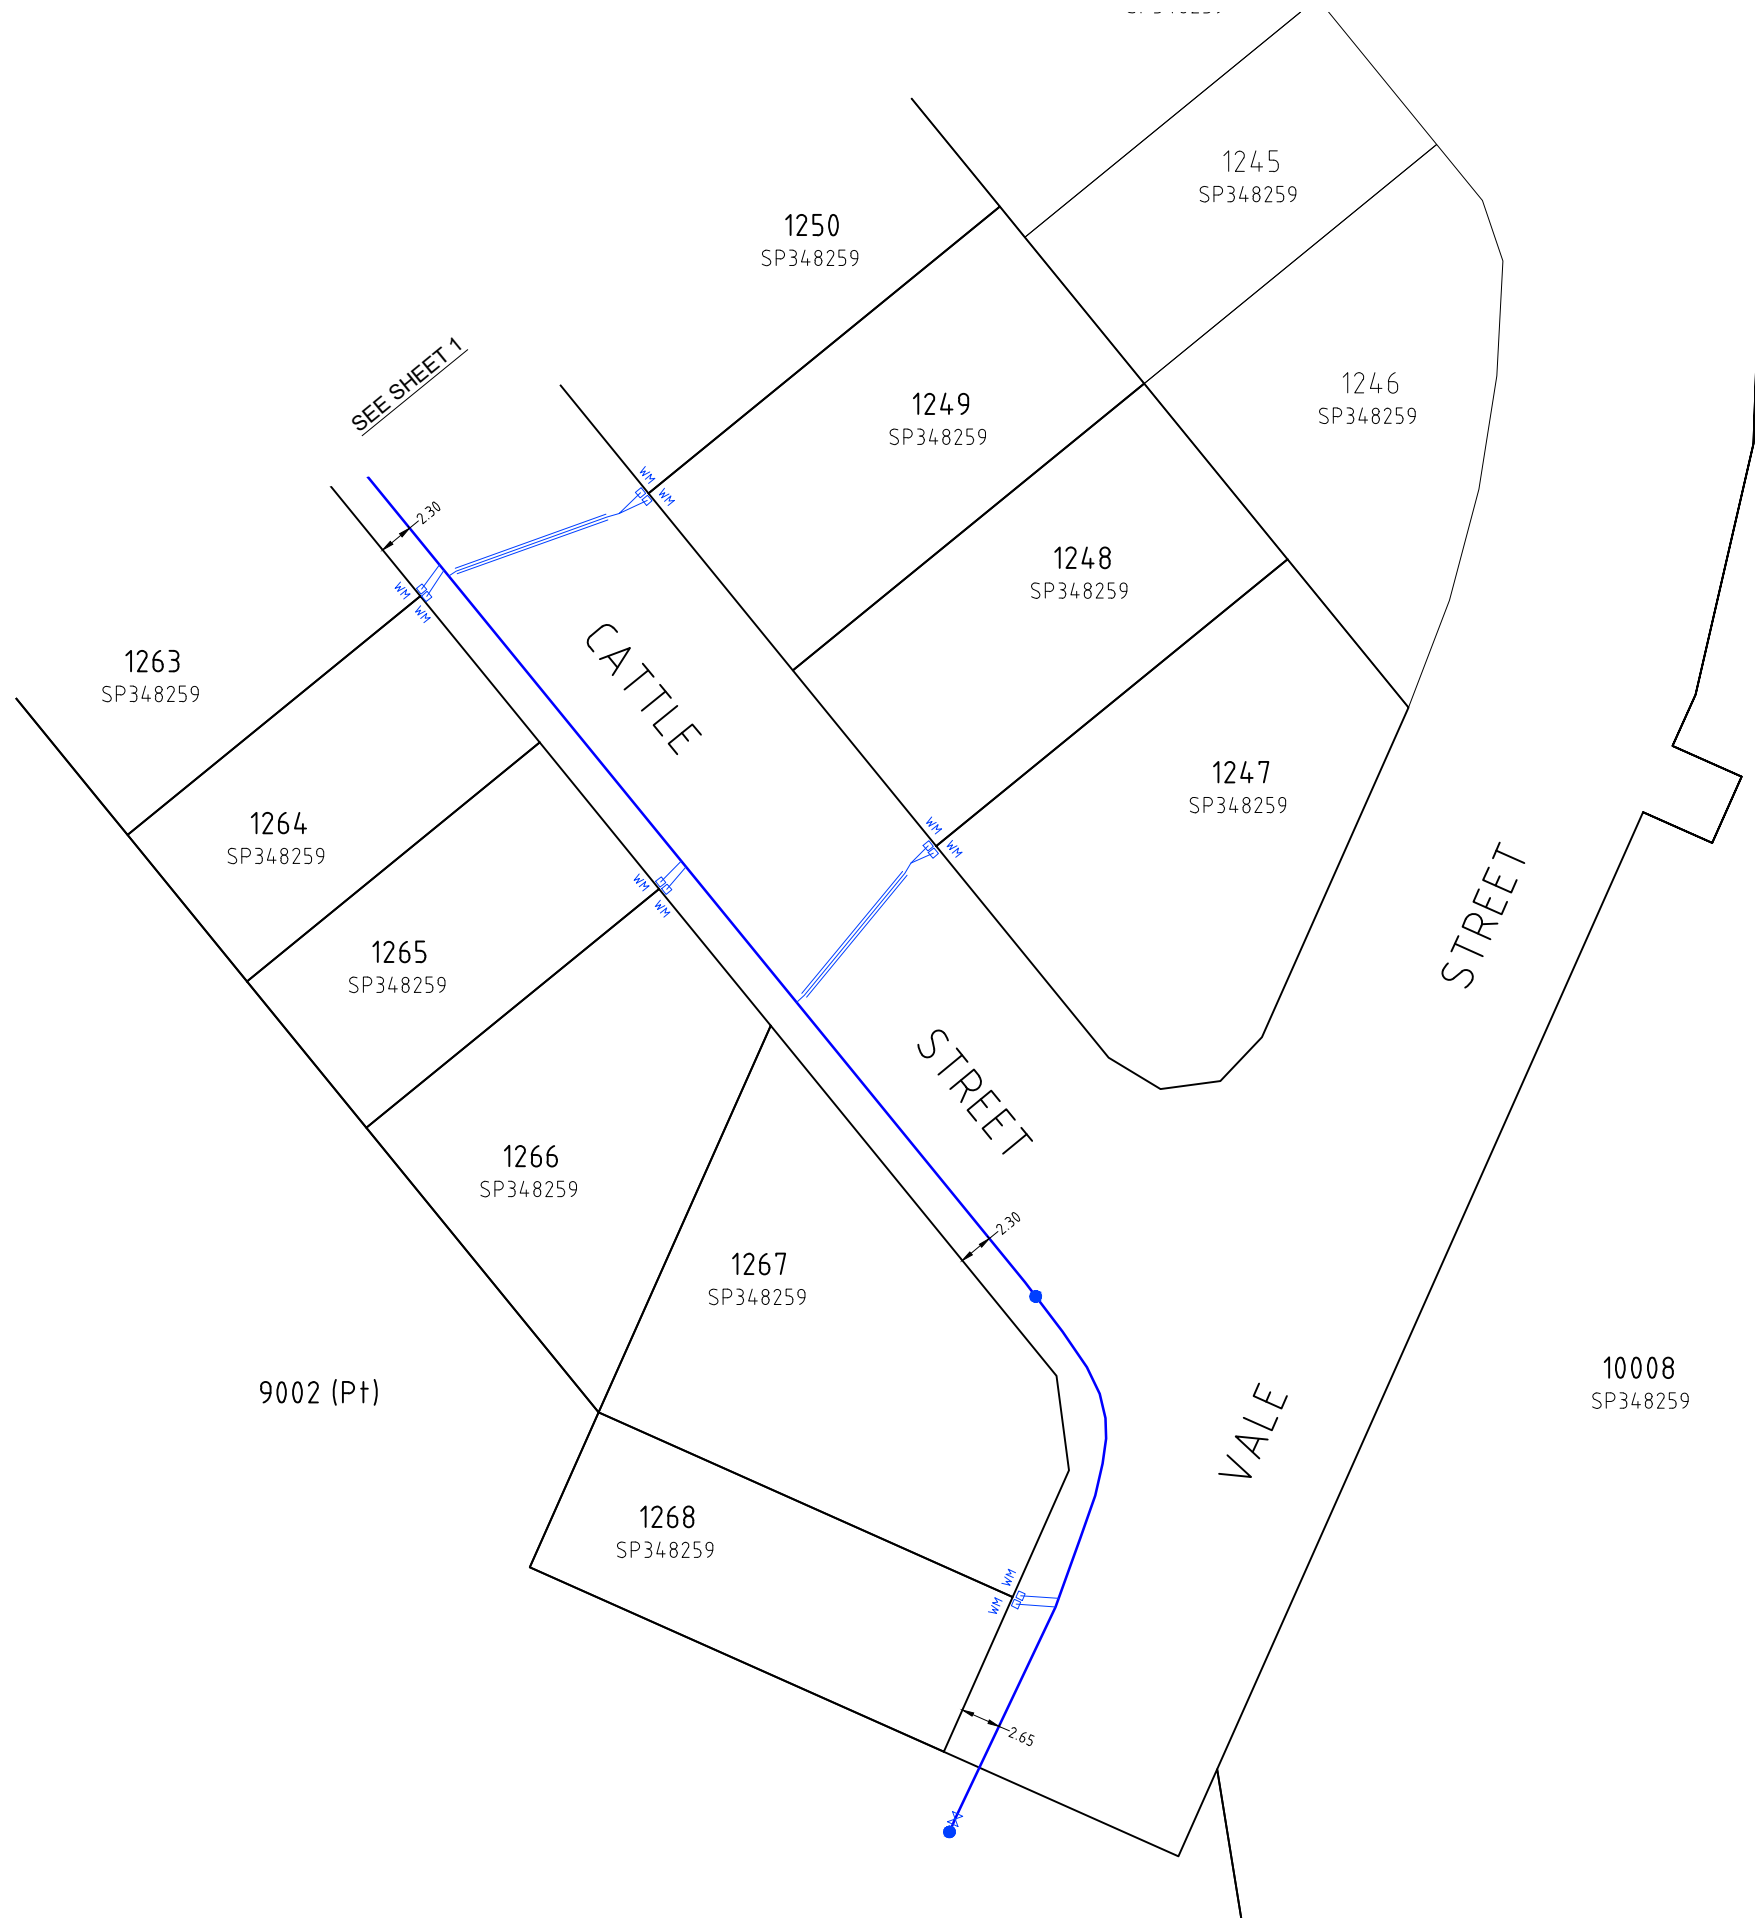

A1

REV NO	DATE	REVISION PURPOSE / DESCRIPTION	DRAWN	RPEQ	RPEQ No
A	05/03/2026	Builders Issue			

DRAWN	CM	25.02.2026
CHECKED	CU	27.02.2026
APPROVED		
INITIALS		DATE

BOWEN HILLS | SPRINGFIELD
1300 123 744 | mail@saundershavill.com

EDEN'S CROSSING - STAGE 30B
VALE ST, REDBANK PLAINS
AS CONSTRUCTED
WATER RETICULATION 25-PNT-75133

DRAWING STATUS AS CONSTRUCTED	
SHEET 2 OF 2 SHEETS	
DRAWING NO.	REV.
	A