


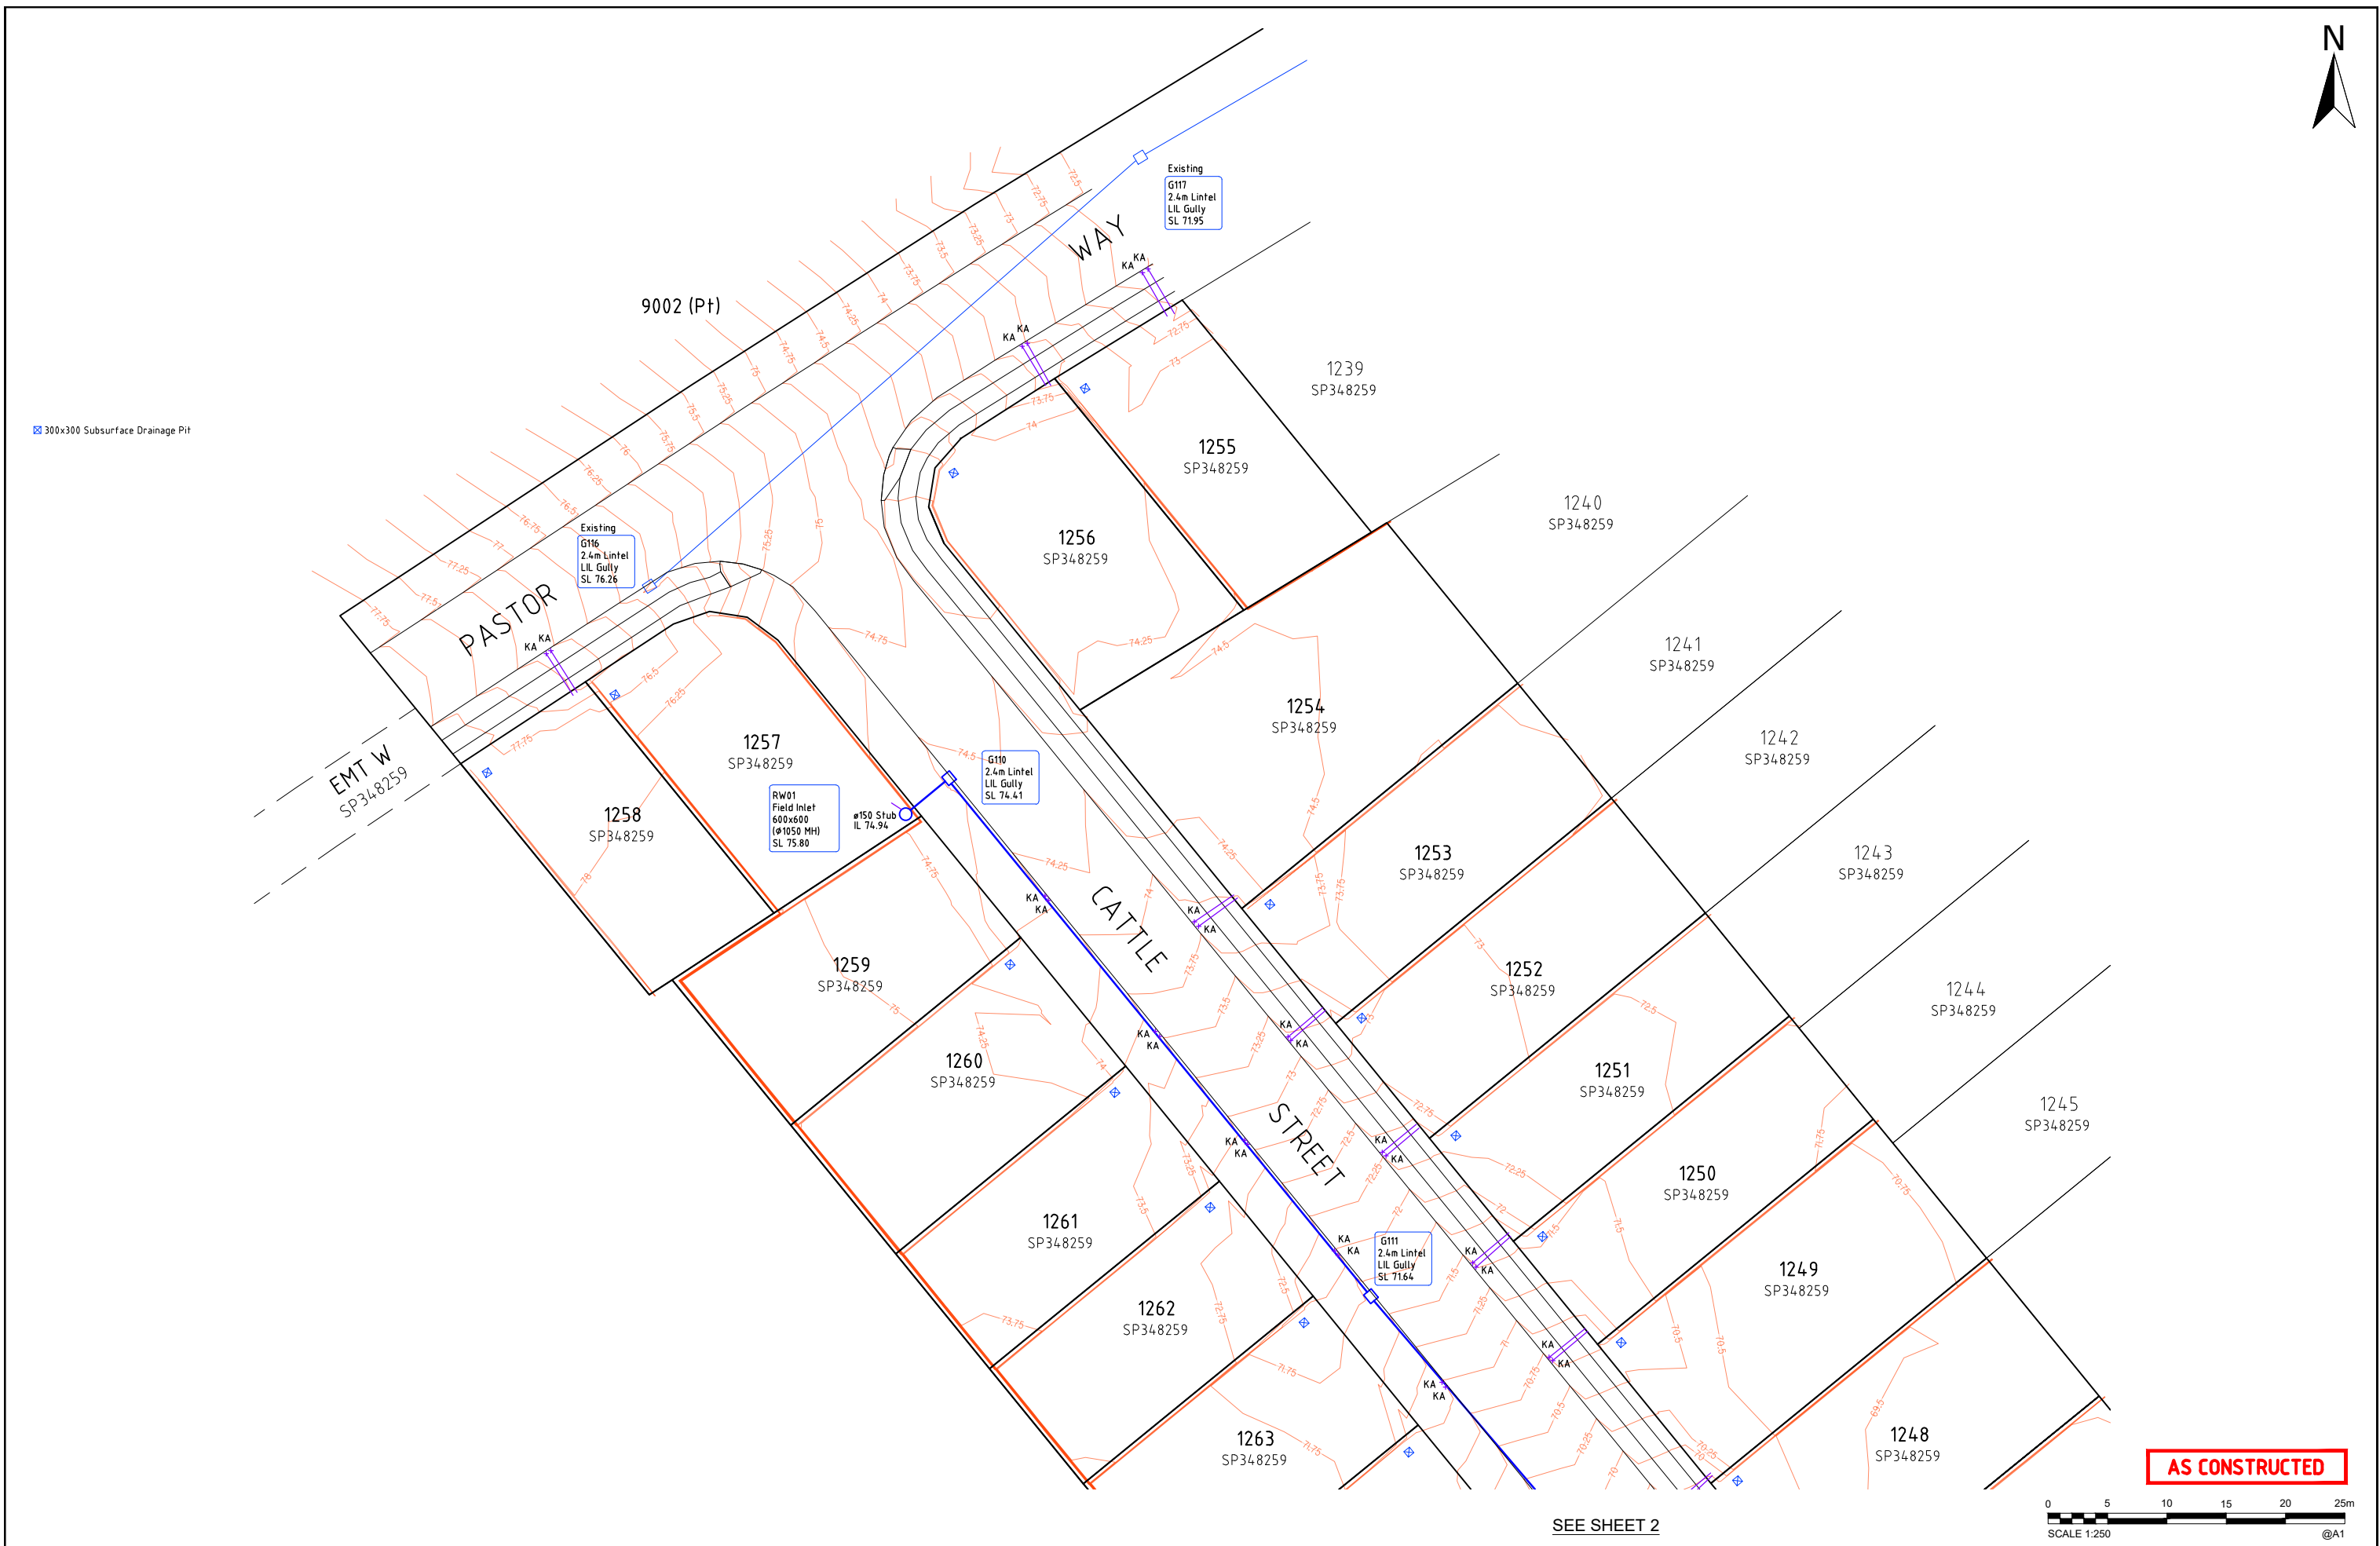

A1					
	A	25/06/2026	Builders Issue		
	INDEX	DATE	REVISIONS	DRAWN	CHECKED
			PASSED		

DRAWN	CM	06.03.2026
CHECKED	AH	11.03.2026
PASSED		
	INITIALS	DATE

BOWEN HILLS | SPRINGFIELD
1300 123 744 | mail@saundershavill.com
Drawing No: 9919 S 20 AC A

kngroup
L1, 62 Astor Terrace, Spring Hill, QLD 4000
www.knigroup.com.au | 07 3017 1900




AS CONSTRUCTED - ROADS & DRAINAGE
EDEN'S CROSSING - STAGE 30B
VALE ST, REDBANK PLAINS

12363/2024/0W


SCALE		1:250
SHEET 1 OF 2 SHEETS		
DRAWING NO.		
		A



SEE SHEET 1

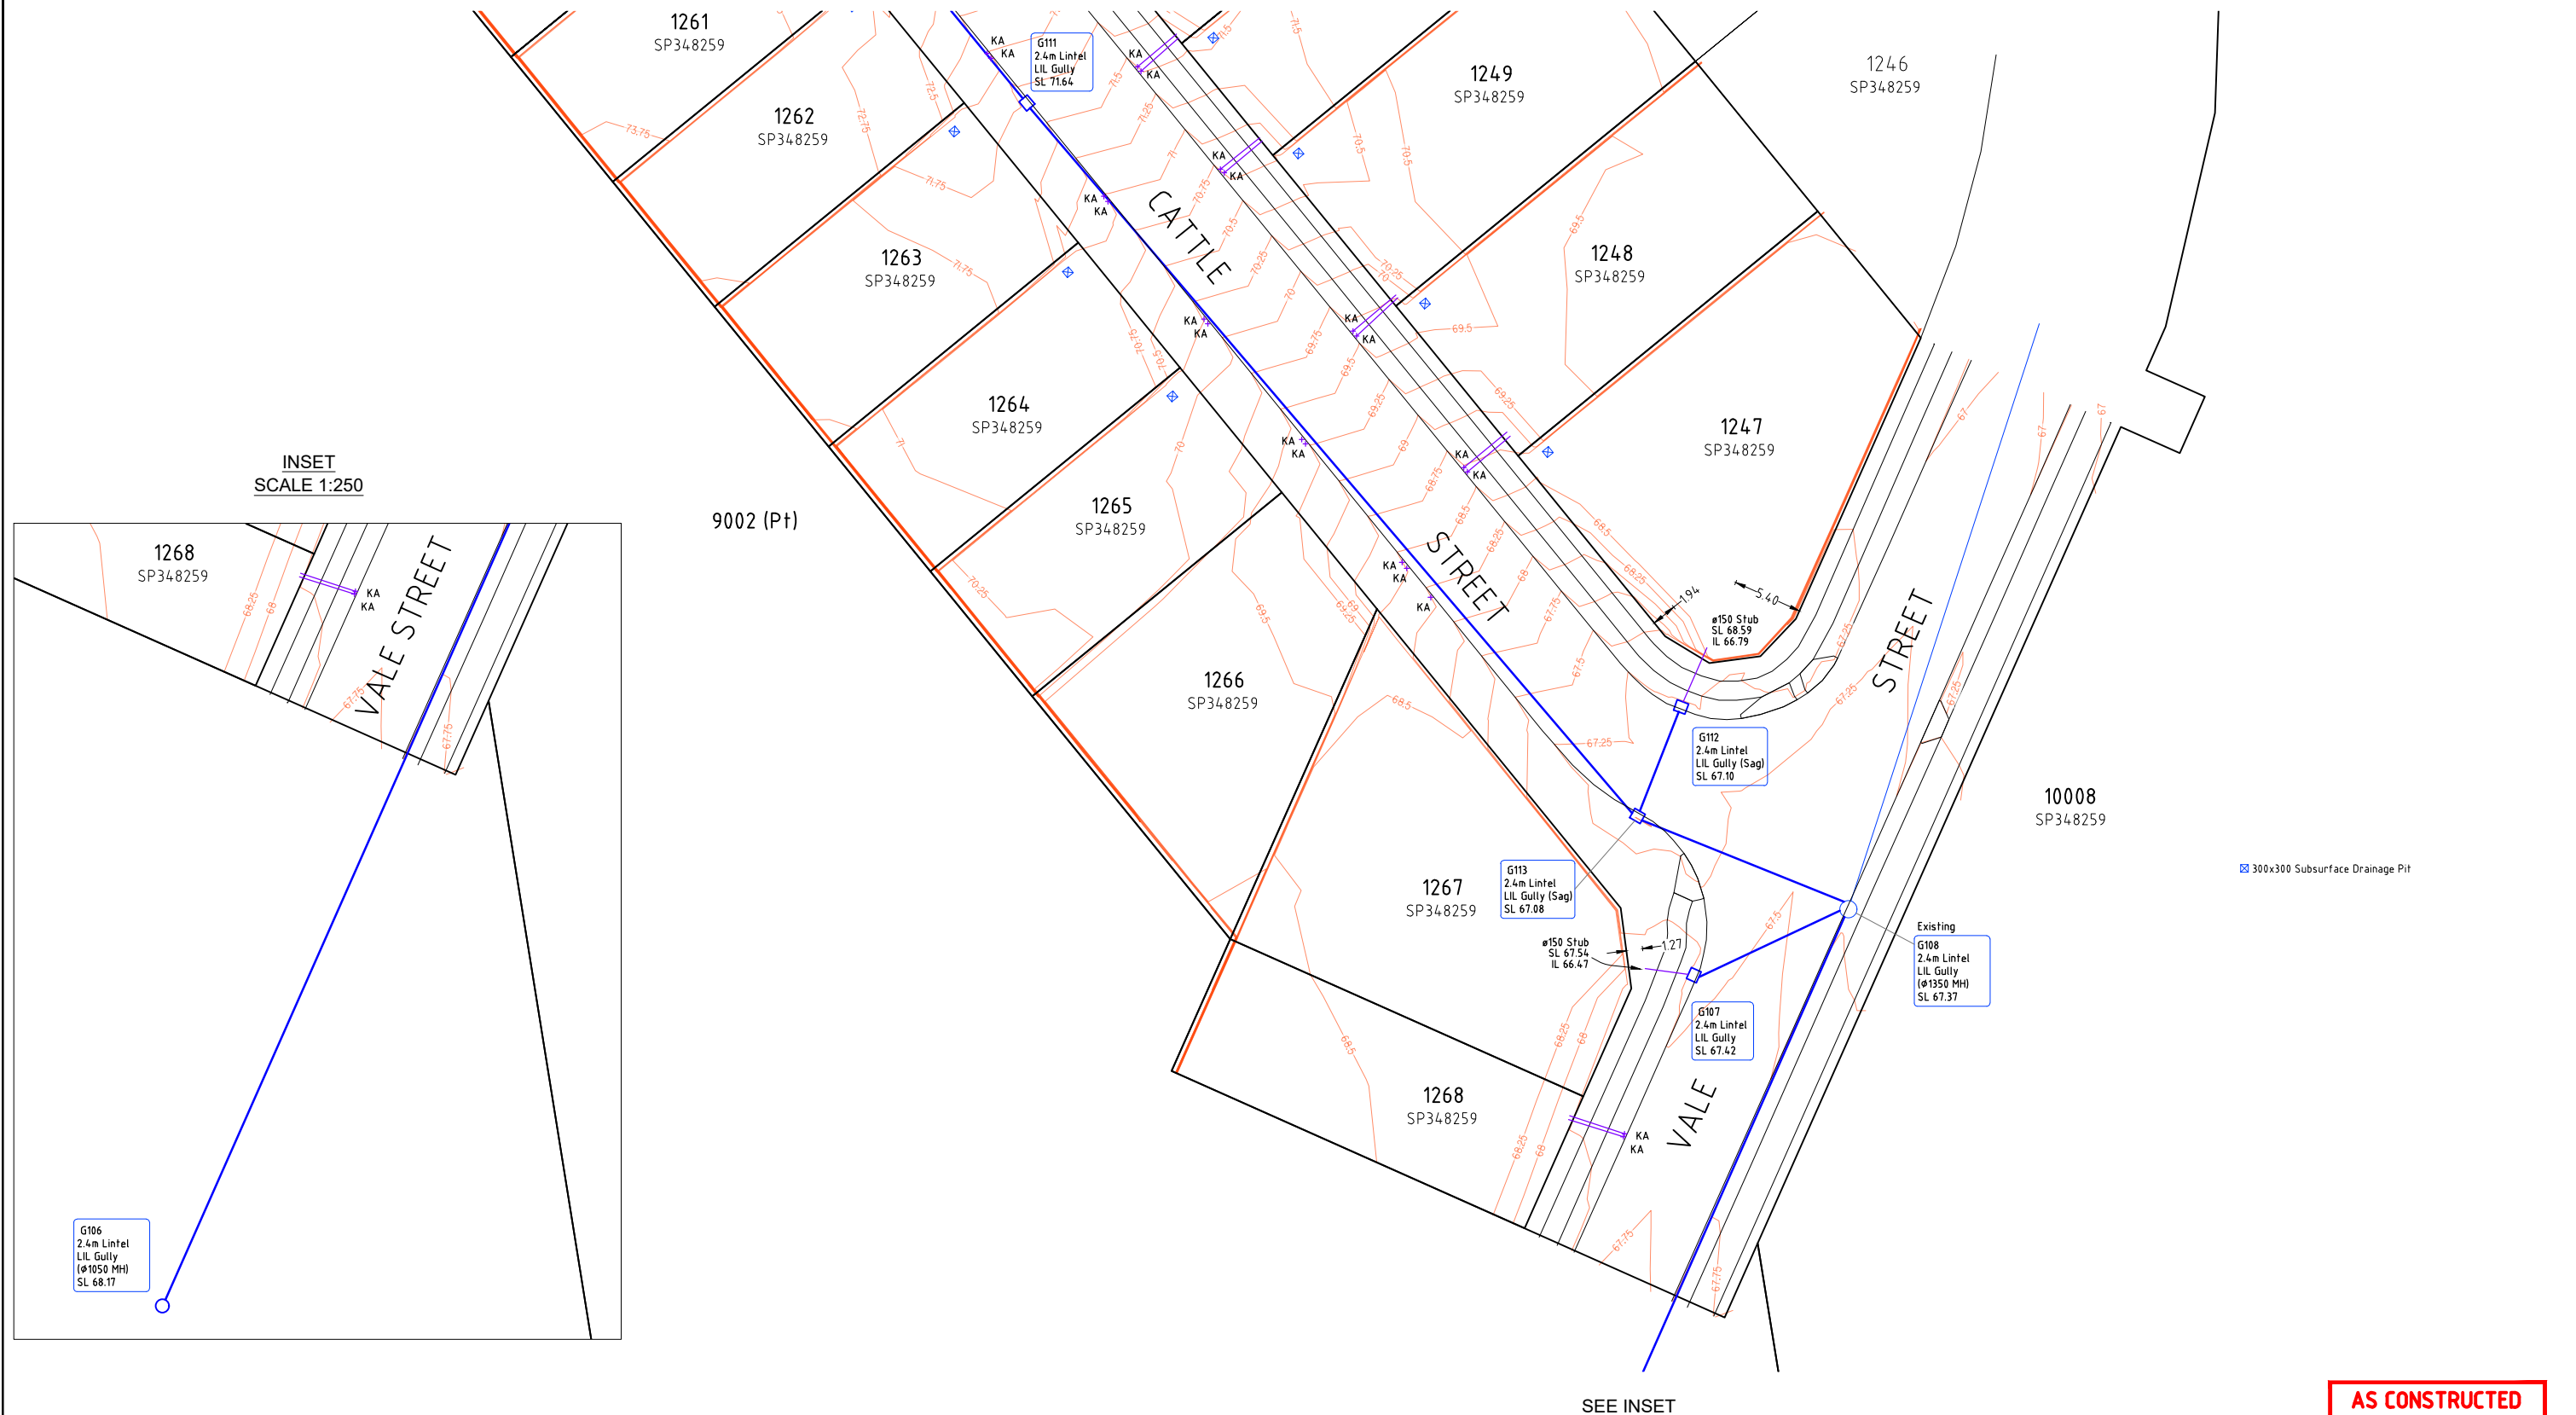

AS CONSTRUCTED

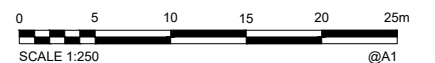

A1

A	25/06/2026	Builder's Issue				
INDEX	DATE	REVISIONS	DRAWN	CHECKED	PASSED	

DRAWN	CM	06.03.2026
CHECKED	AH	11.03.2026
PASSED		
	INITIALS	DATE

**Saunders
Havill**
BOWEN HILLS | SPRINGFIELD
1300 123 744 | mail@saundershavill.com
Drawing No: 9919 S 20 AC A

kn group
L1, 62 Astor Terrace, Spring Hill, QLD 4000
www.knigroup.com.au | 07 3017 1900



IPSWICH CITY COUNCIL

AS CONSTRUCTED - ROADS & DRAINAGE 25-PNT-75133
EDEN'S CROSSING - STAGE 30B
VALE ST, REDBANK PLAINS

12363/2024/OW

SCALE	1:250
SHEET 2 OF 2 SHEETS	
DRAWING NO.	