

REGISTERED SURVEYOR'S CERTIFICATION
 We, RPS AAP Consulting Pty Ltd, Registered Surveyor - Land, hereby certify that the horizontal and vertical locations, and dimensions shown on this plan are a true and correct record of the As Constructed survey information.

Registered Surveyor (sig.) *[Signature]* 7152 20/02/2026
 Reg. Surveyor No. Date

CONSULTING ENGINEER'S CERTIFICATION:

I, _____ (Company's representative Name) _____ (Signature)
 _____ (Date) _____ (RPEQ)
 Being a duly representative of- _____ (Company Name)

Hereby certify that
 The As Constructed information shown on this plan is a true and correct record of the sizes, types, materials, classes etc., and it corresponds with the relevant approved Engineering Drawings.

COORDINATE DATUM NOTE:
 HORIZONTAL COORDINATES (E,N) SUPPLIED ARE MAPPING GRID OF AUSTRALIA (MGA), ZONE 56 BASED ON THE UNIVERSAL TRANSVERSE MERCATOR PROJECTION AND THE GEOCENTRIC DATUM OF AUSTRALIA 2020.


LEGEND

- Sewer Line
- Lot Boundary
- Stage Boundary
- Manhole / Maintenance Structure
- Existing Manhole / Maintenance Structure
- Existing Sewer Line

ABBREVIATIONS - Sewer Main

Mat	Material
DSIL	Down stream invert level
USIL	Up stream invert level
SL	Surface level
L	Length of pipe from Manhole to Mahole

AS CONSTRUCTED

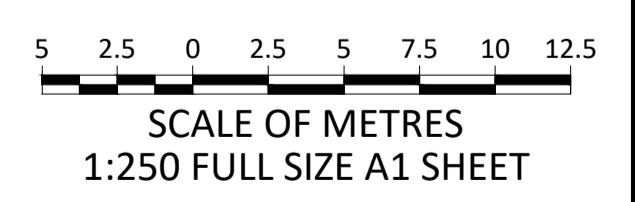

A1	INDEX	DATE	REVISIONS	DRAWN	CHECKED	PASSED
	A	18/02/2026	As Constructed	EC	-----	-----

Approved Operational Works Number:
 DEV/2012/403/7

DRAWN	EC	18/02/2026
CHECKED	DF	20/02/2026
PASSED	DJL	20/02/2026


RPS
 A TETRA TECH COMPANY

RPS AAP Consulting Pty Ltd
 ACN 117 883 173
 ABN 97 117 883 173
 Locked Bag 7801
 Suite A.02 Level 1
 114 Brisbane Street
 Ipswich QLD 4305
 T +61 7 3437 2000
 W rpsgroup.com



Logan City Council
 Flagstone
 Sewerage Reticulation As Constructed
 Stage 4J

SCALE 1:250
 SHEET 1 OF 4 SHEETS
 DRAWING NO.
TLX370977-27

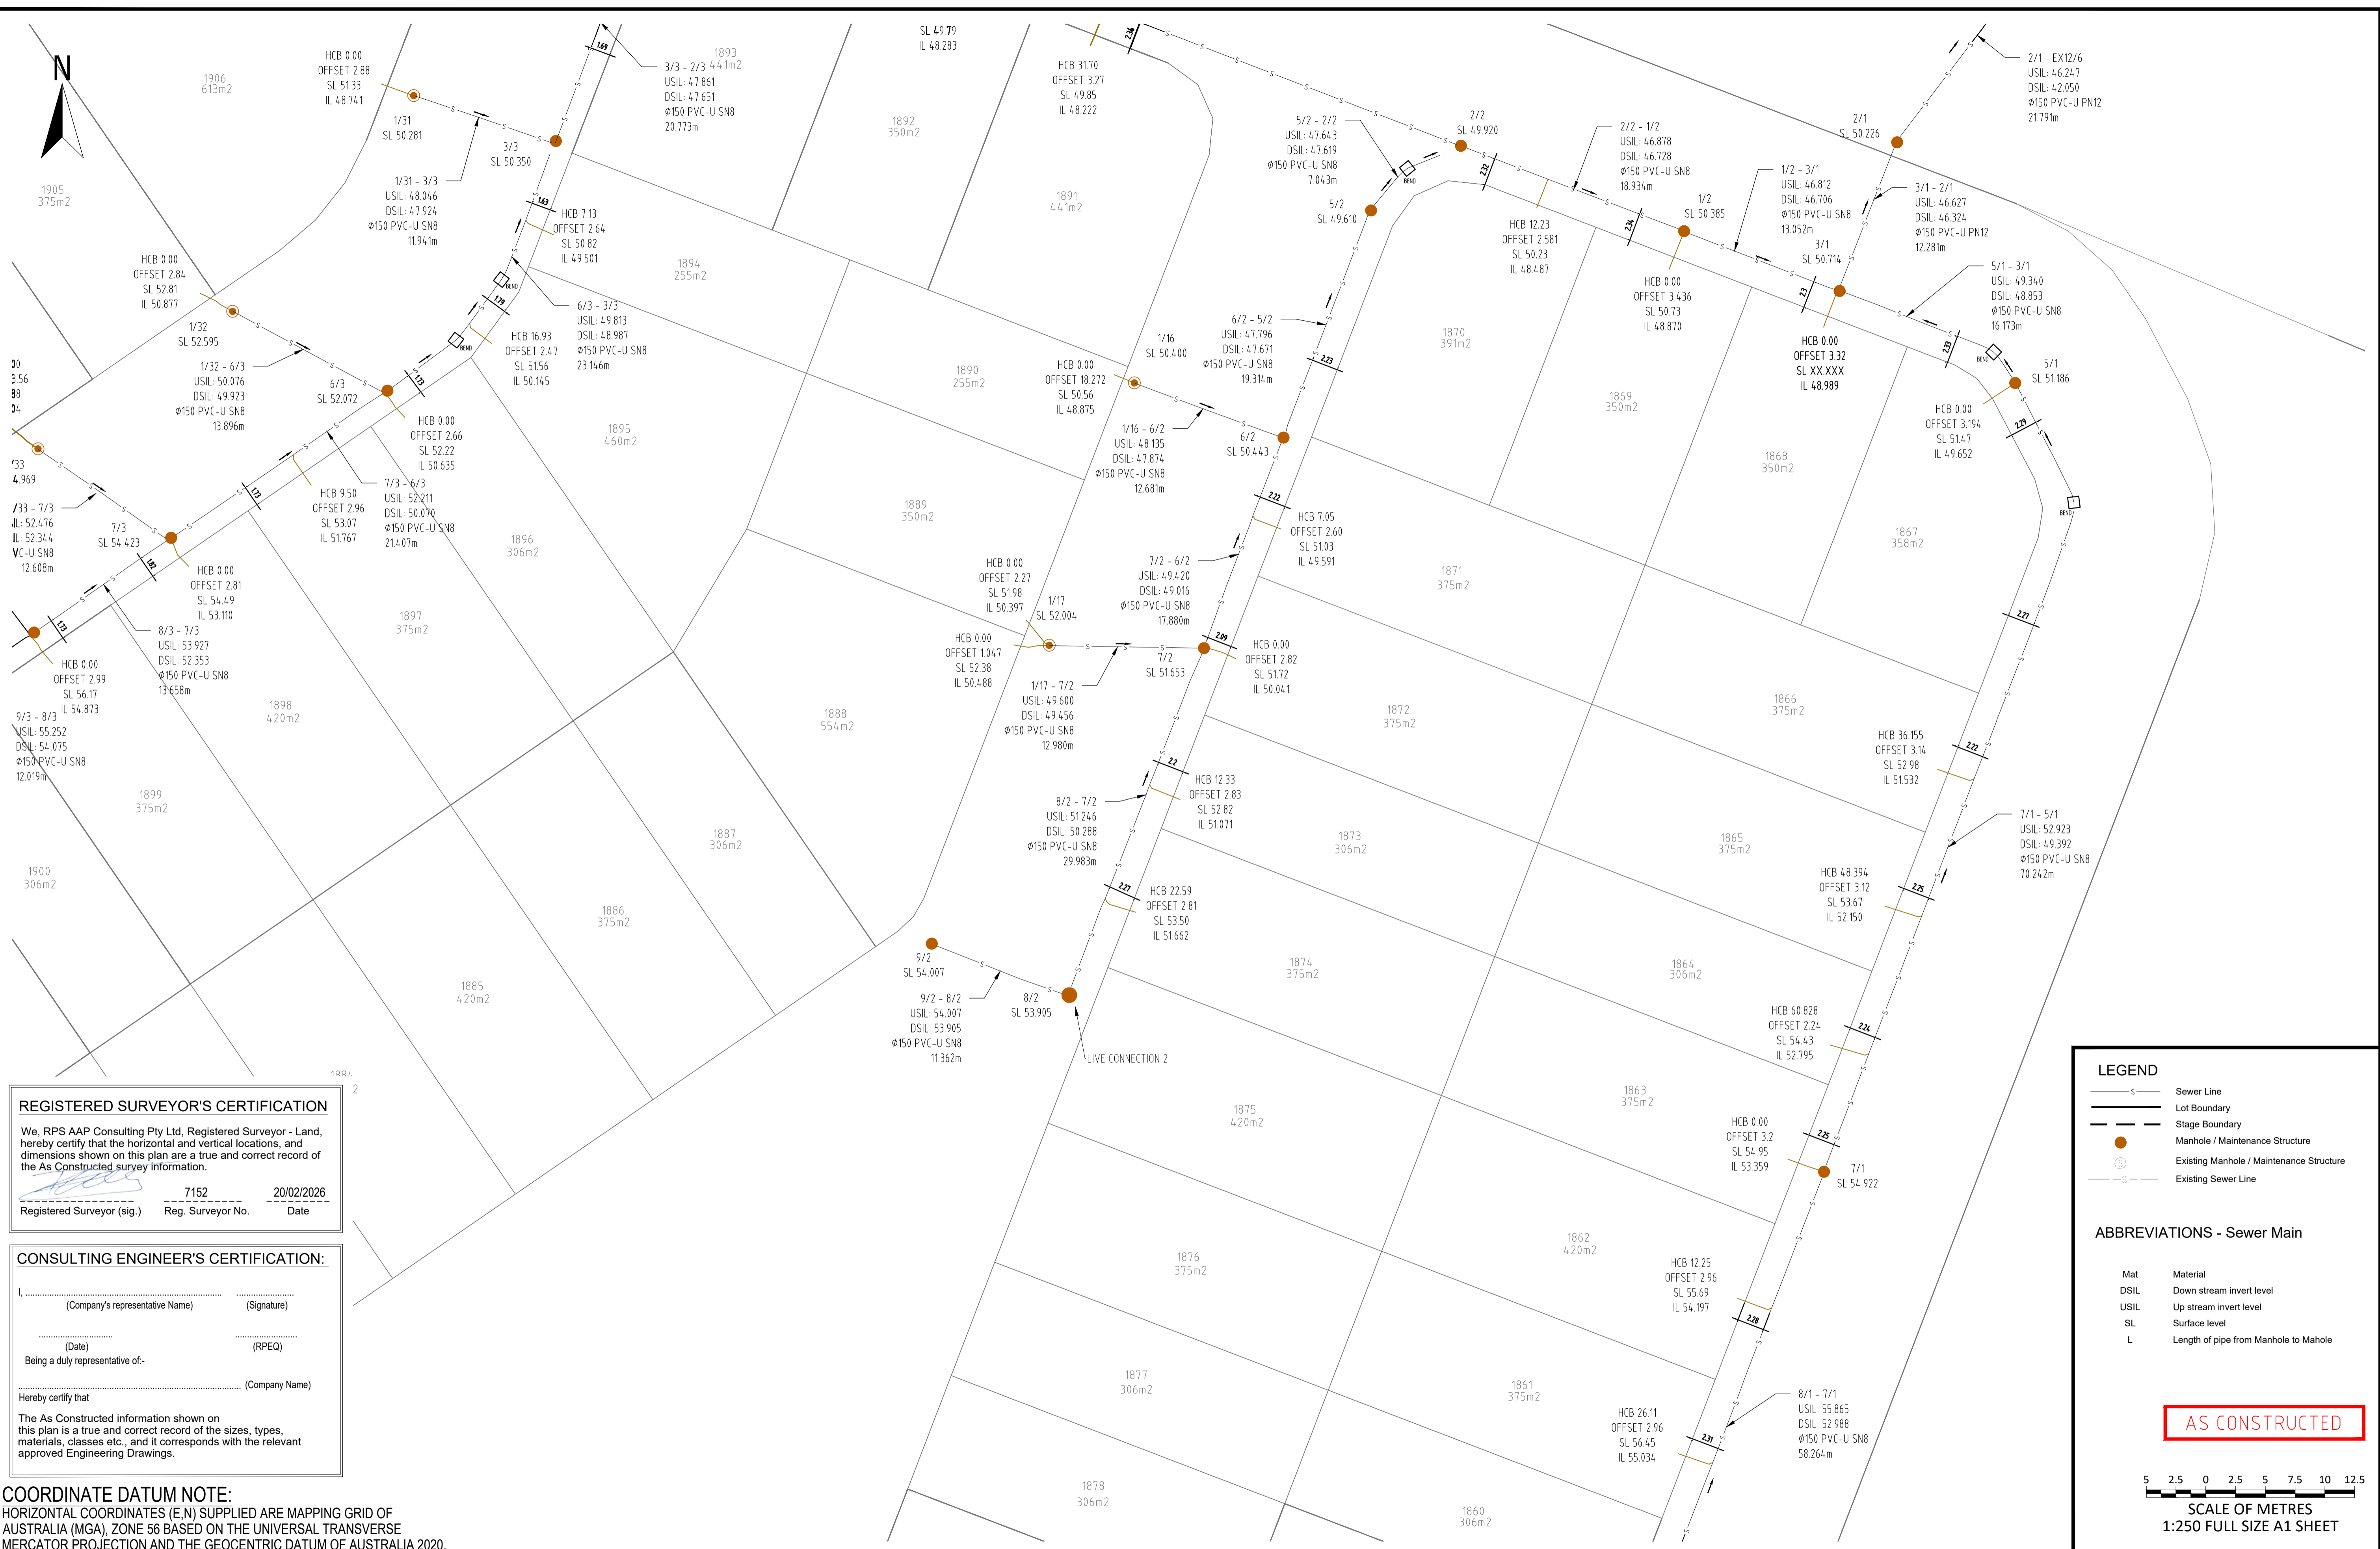

REGISTERED SURVEYOR'S CERTIFICATION

We, RPS AAP Consulting Pty Ltd, Registered Surveyor - Land, hereby certify that the horizontal and vertical locations, and dimensions shown on this plan are a true and correct record of the As Constructed survey information.

Registered Surveyor (sig.) 7152 Reg. Surveyor No. 20/02/2026 Date

CONSULTING ENGINEER'S CERTIFICATION:

I, _____ (Company's representative Name) _____ (Signature)

_____, _____ (Date) _____ (RPEQ)

Being a duly representative of: _____ (Company Name)

Hereby certify that

The As Constructed information shown on this plan is a true and correct record of the sizes, types, materials, classes etc., and it corresponds with the relevant approved Engineering Drawings.

COORDINATE DATUM NOTE:
 HORIZONTAL COORDINATES (E,N) SUPPLIED ARE MAPPING GRID OF AUSTRALIA (MGA), ZONE 56 BASED ON THE UNIVERSAL TRANSVERSE MERCATOR PROJECTION AND THE GEOCENTRIC DATUM OF AUSTRALIA 2020.


LEGEND

- Sewer Line
- Lot Boundary
- Stage Boundary
- Manhole / Maintenance Structure
- Existing Manhole / Maintenance Structure
- Existing Sewer Line

ABBREVIATIONS - Sewer Main

Mat	Material
DSIL	Down stream invert level
USIL	Up stream invert level
SL	Surface level
L	Length of pipe from Manhole to Mahole

AS CONSTRUCTED

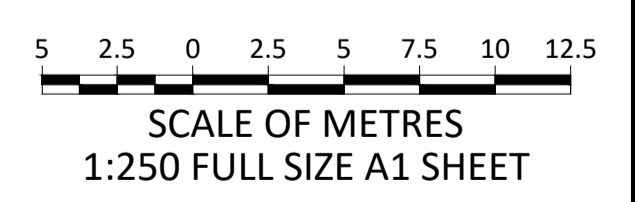

A1	INDEX	DATE	REVISIONS	DRAWN	CHECKED	PASSED
	A	18/02/2026	As Constructed	EC	---	---

Approved Operational Works Number:
DEV/2012/403/7

DRAWN	EC	18/02/2026
CHECKED	DF	20/02/2026
PASSED	DJL	20/02/2026

RPS
A TETRA TECH COMPANY

© COPYRIGHT PROTECTS THIS PLAN. Unauthorised reproduction or amendment not permitted. Please contact the author.


RPS AAP Consulting Pty Ltd
 ACN 117 883 173
 ABN 97 117 883 173
 Locked Bag 7801
 Suite A.02 Level 1
 114 Brisbane Street
 Ipswich QLD 4305
 T +61 7 3437 2000
 W rpsgroup.com



Logan City Council

Flagstone
Sewerage Reticulation As Constructed
Stage 4J

SCALE	1:250
SHEET	1 OF 4 SHEETS
DRAWING NO.	---
TLX370977-27	---
	A

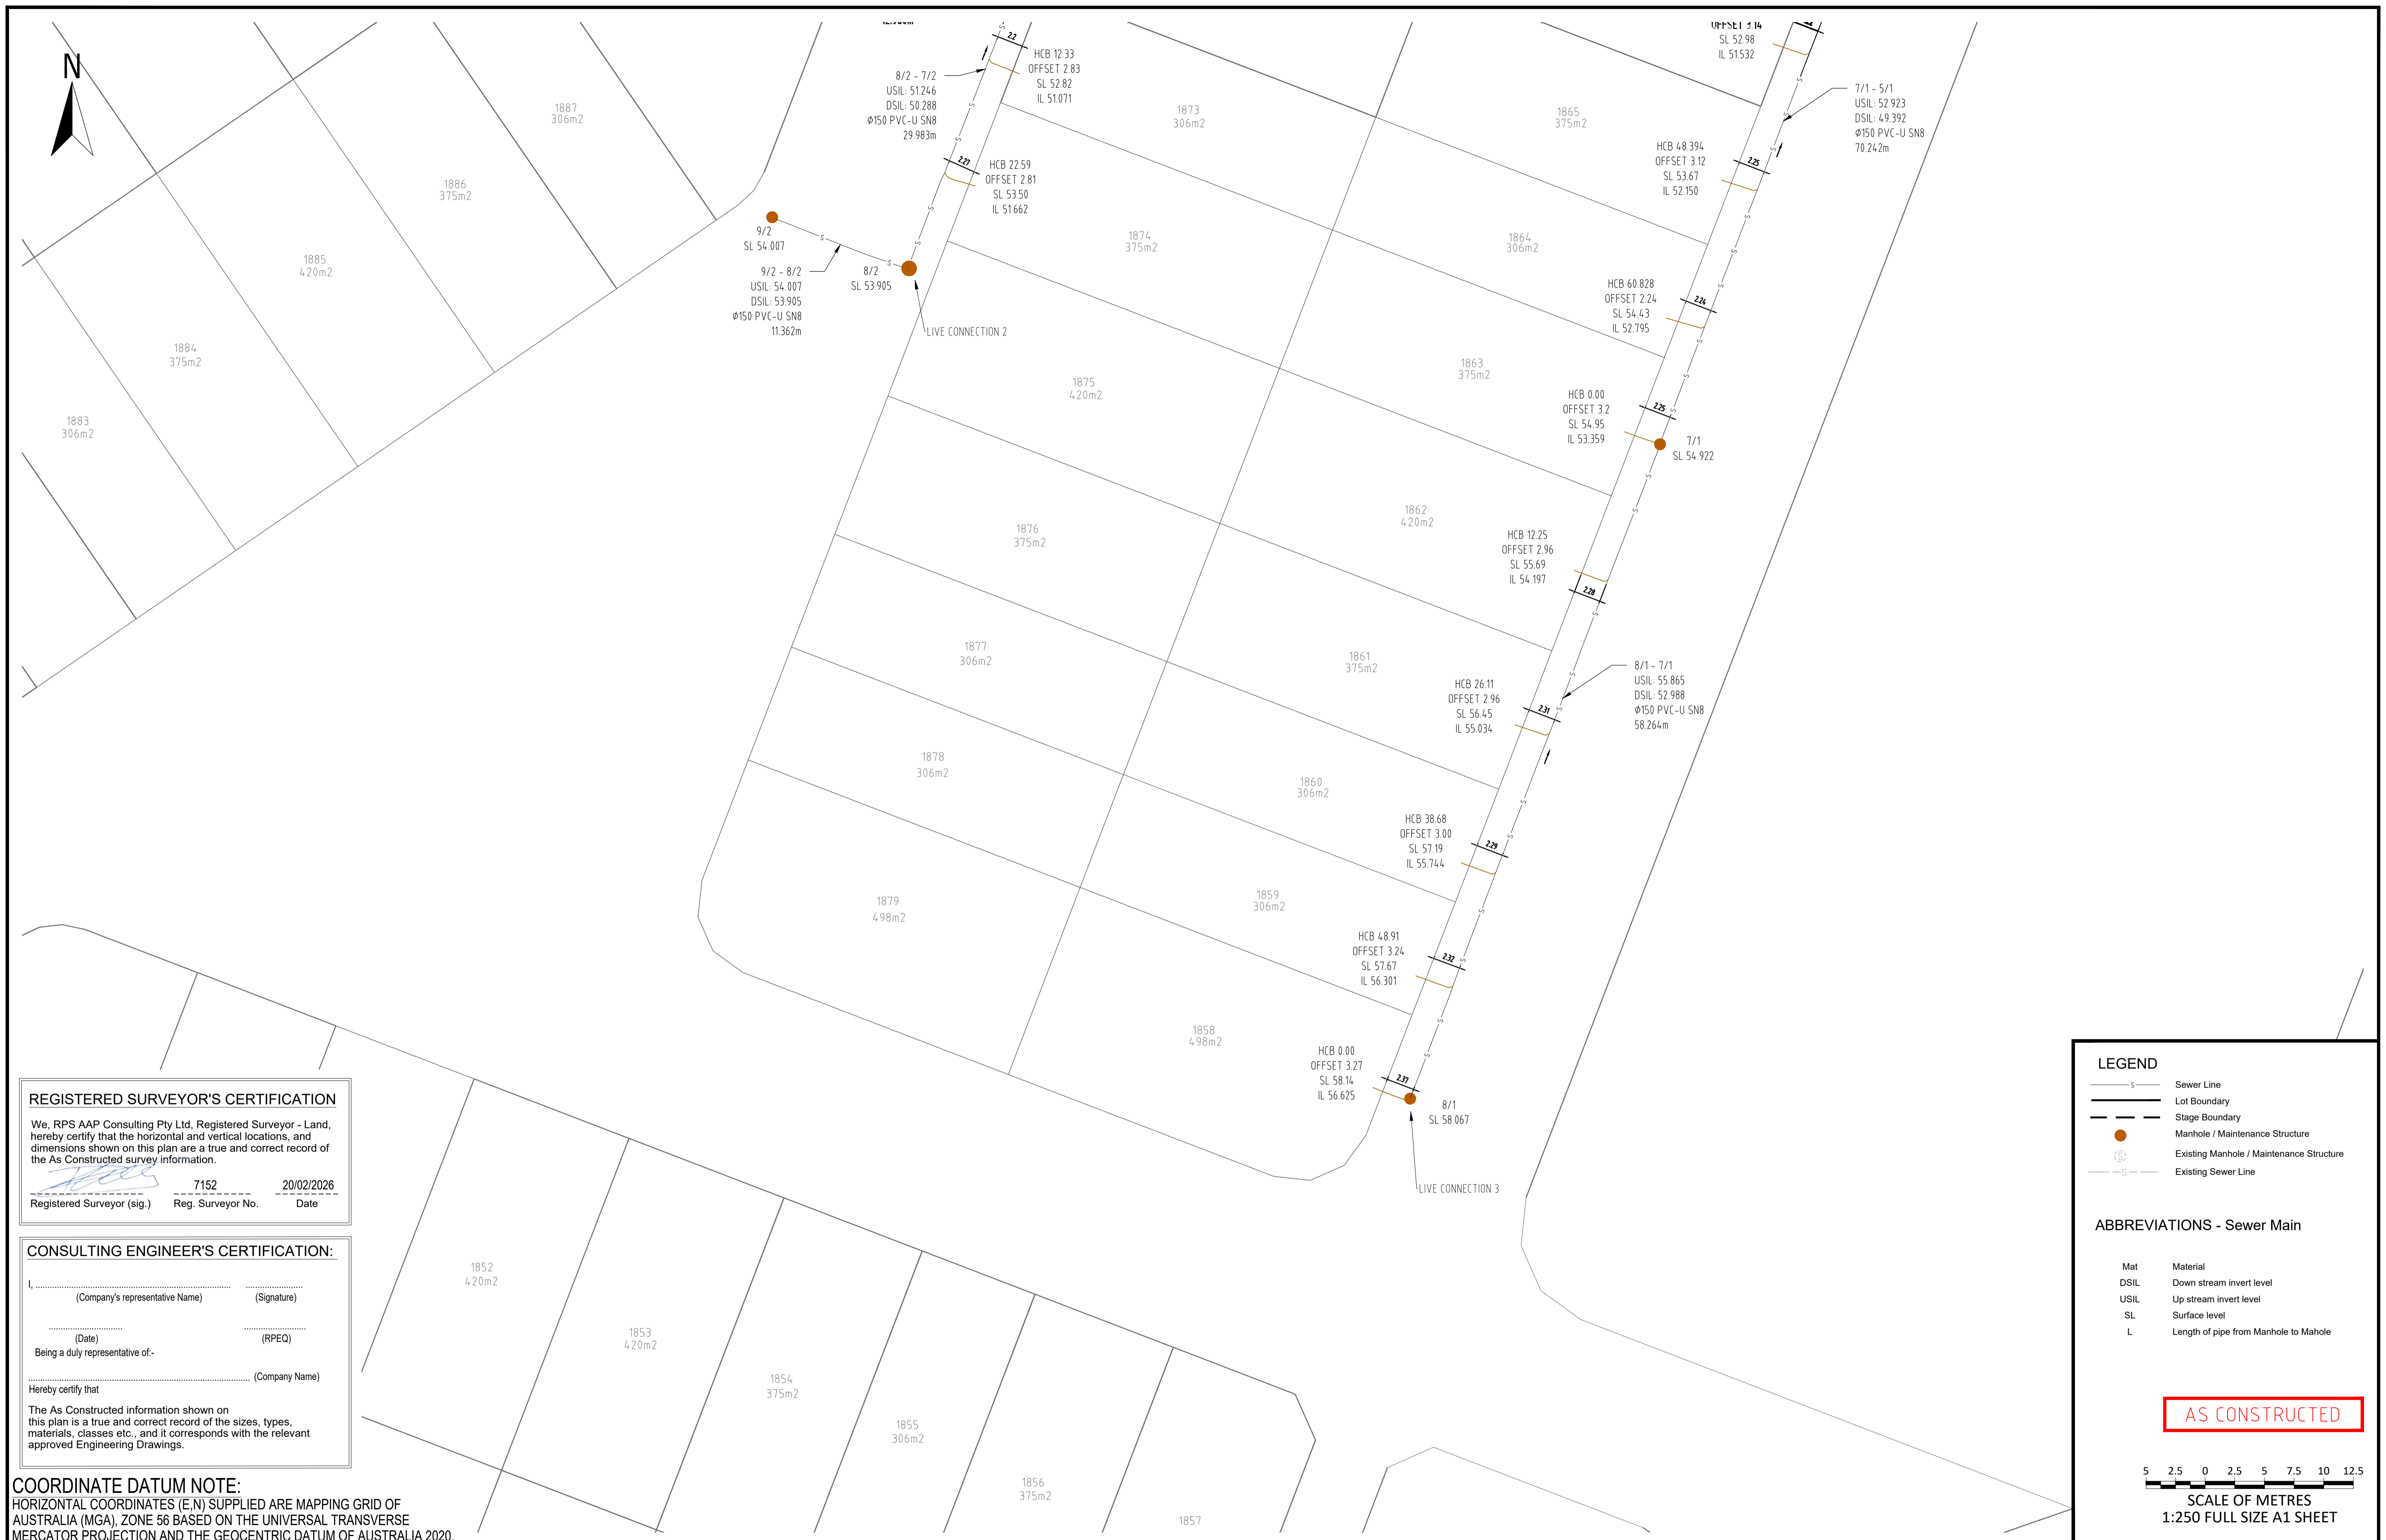

REGISTERED SURVEYOR'S CERTIFICATION
 We, RPS AAP Consulting Pty Ltd, Registered Surveyor - Land, hereby certify that the horizontal and vertical locations, and dimensions shown on this plan are a true and correct record of the As Constructed survey information.
 Registered Surveyor (sig.) *[Signature]* 7152 Reg. Surveyor No. 20/02/2026 Date

CONSULTING ENGINEER'S CERTIFICATION:
 I, _____ (Company's representative Name) _____ (Signature)
 _____ (Date) _____ (RPEQ)
 Being a duly representative of- _____ (Company Name)
 Hereby certify that
 The As Constructed information shown on this plan is a true and correct record of the sizes, types, materials, classes etc., and it corresponds with the relevant approved Engineering Drawings.

COORDINATE DATUM NOTE:
 HORIZONTAL COORDINATES (E,N) SUPPLIED ARE MAPPING GRID OF AUSTRALIA (MGA), ZONE 56 BASED ON THE UNIVERSAL TRANSVERSE MERCATOR PROJECTION AND THE GEOCENTRIC DATUM OF AUSTRALIA 2020.


LEGEND

- Sewer Line
- Lot Boundary
- Stage Boundary
- Manhole / Maintenance Structure
- Existing Manhole / Maintenance Structure
- Existing Sewer Line

ABBREVIATIONS - Sewer Main

Mat Material
 DSIL Down stream invert level
 USIL Up stream invert level
 SL Surface level
 L Length of pipe from Manhole to Mahole

AS CONSTRUCTED

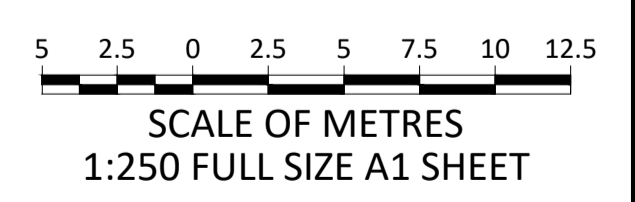

A1	INDEX	DATE	REVISIONS	DRAWN	CHECKED	PASSED
	A	18/02/2026	As Constructed	EC	---	---
	---	---	---	---	---	---
	---	---	---	---	---	---

Approved Operational Works Number:
 DEV/2012/403/7

DRAWN	EC	18/02/2026
CHECKED	DF	20/02/2026
PASSED	DJL	20/02/2026


RPS
 A TETRA TECH COMPANY

RPS AAP Consulting Pty Ltd
 ACN 117 883 173
 ABN 97 117 883 173
 Locked Bag 7801
 Suite A.02 Level 1
 114 Brisbane Street
 Ipswich QLD 4305
 T +61 7 3437 2000
 W rpsgroup.com



Logan City Council
 Flagstone
 Sewerage Reticiulation As Constructed
 Stage 4J

SCALE 1:250
 SHEET 1 OF 4 SHEETS
 DRAWING NO. TLX370977-27
 A

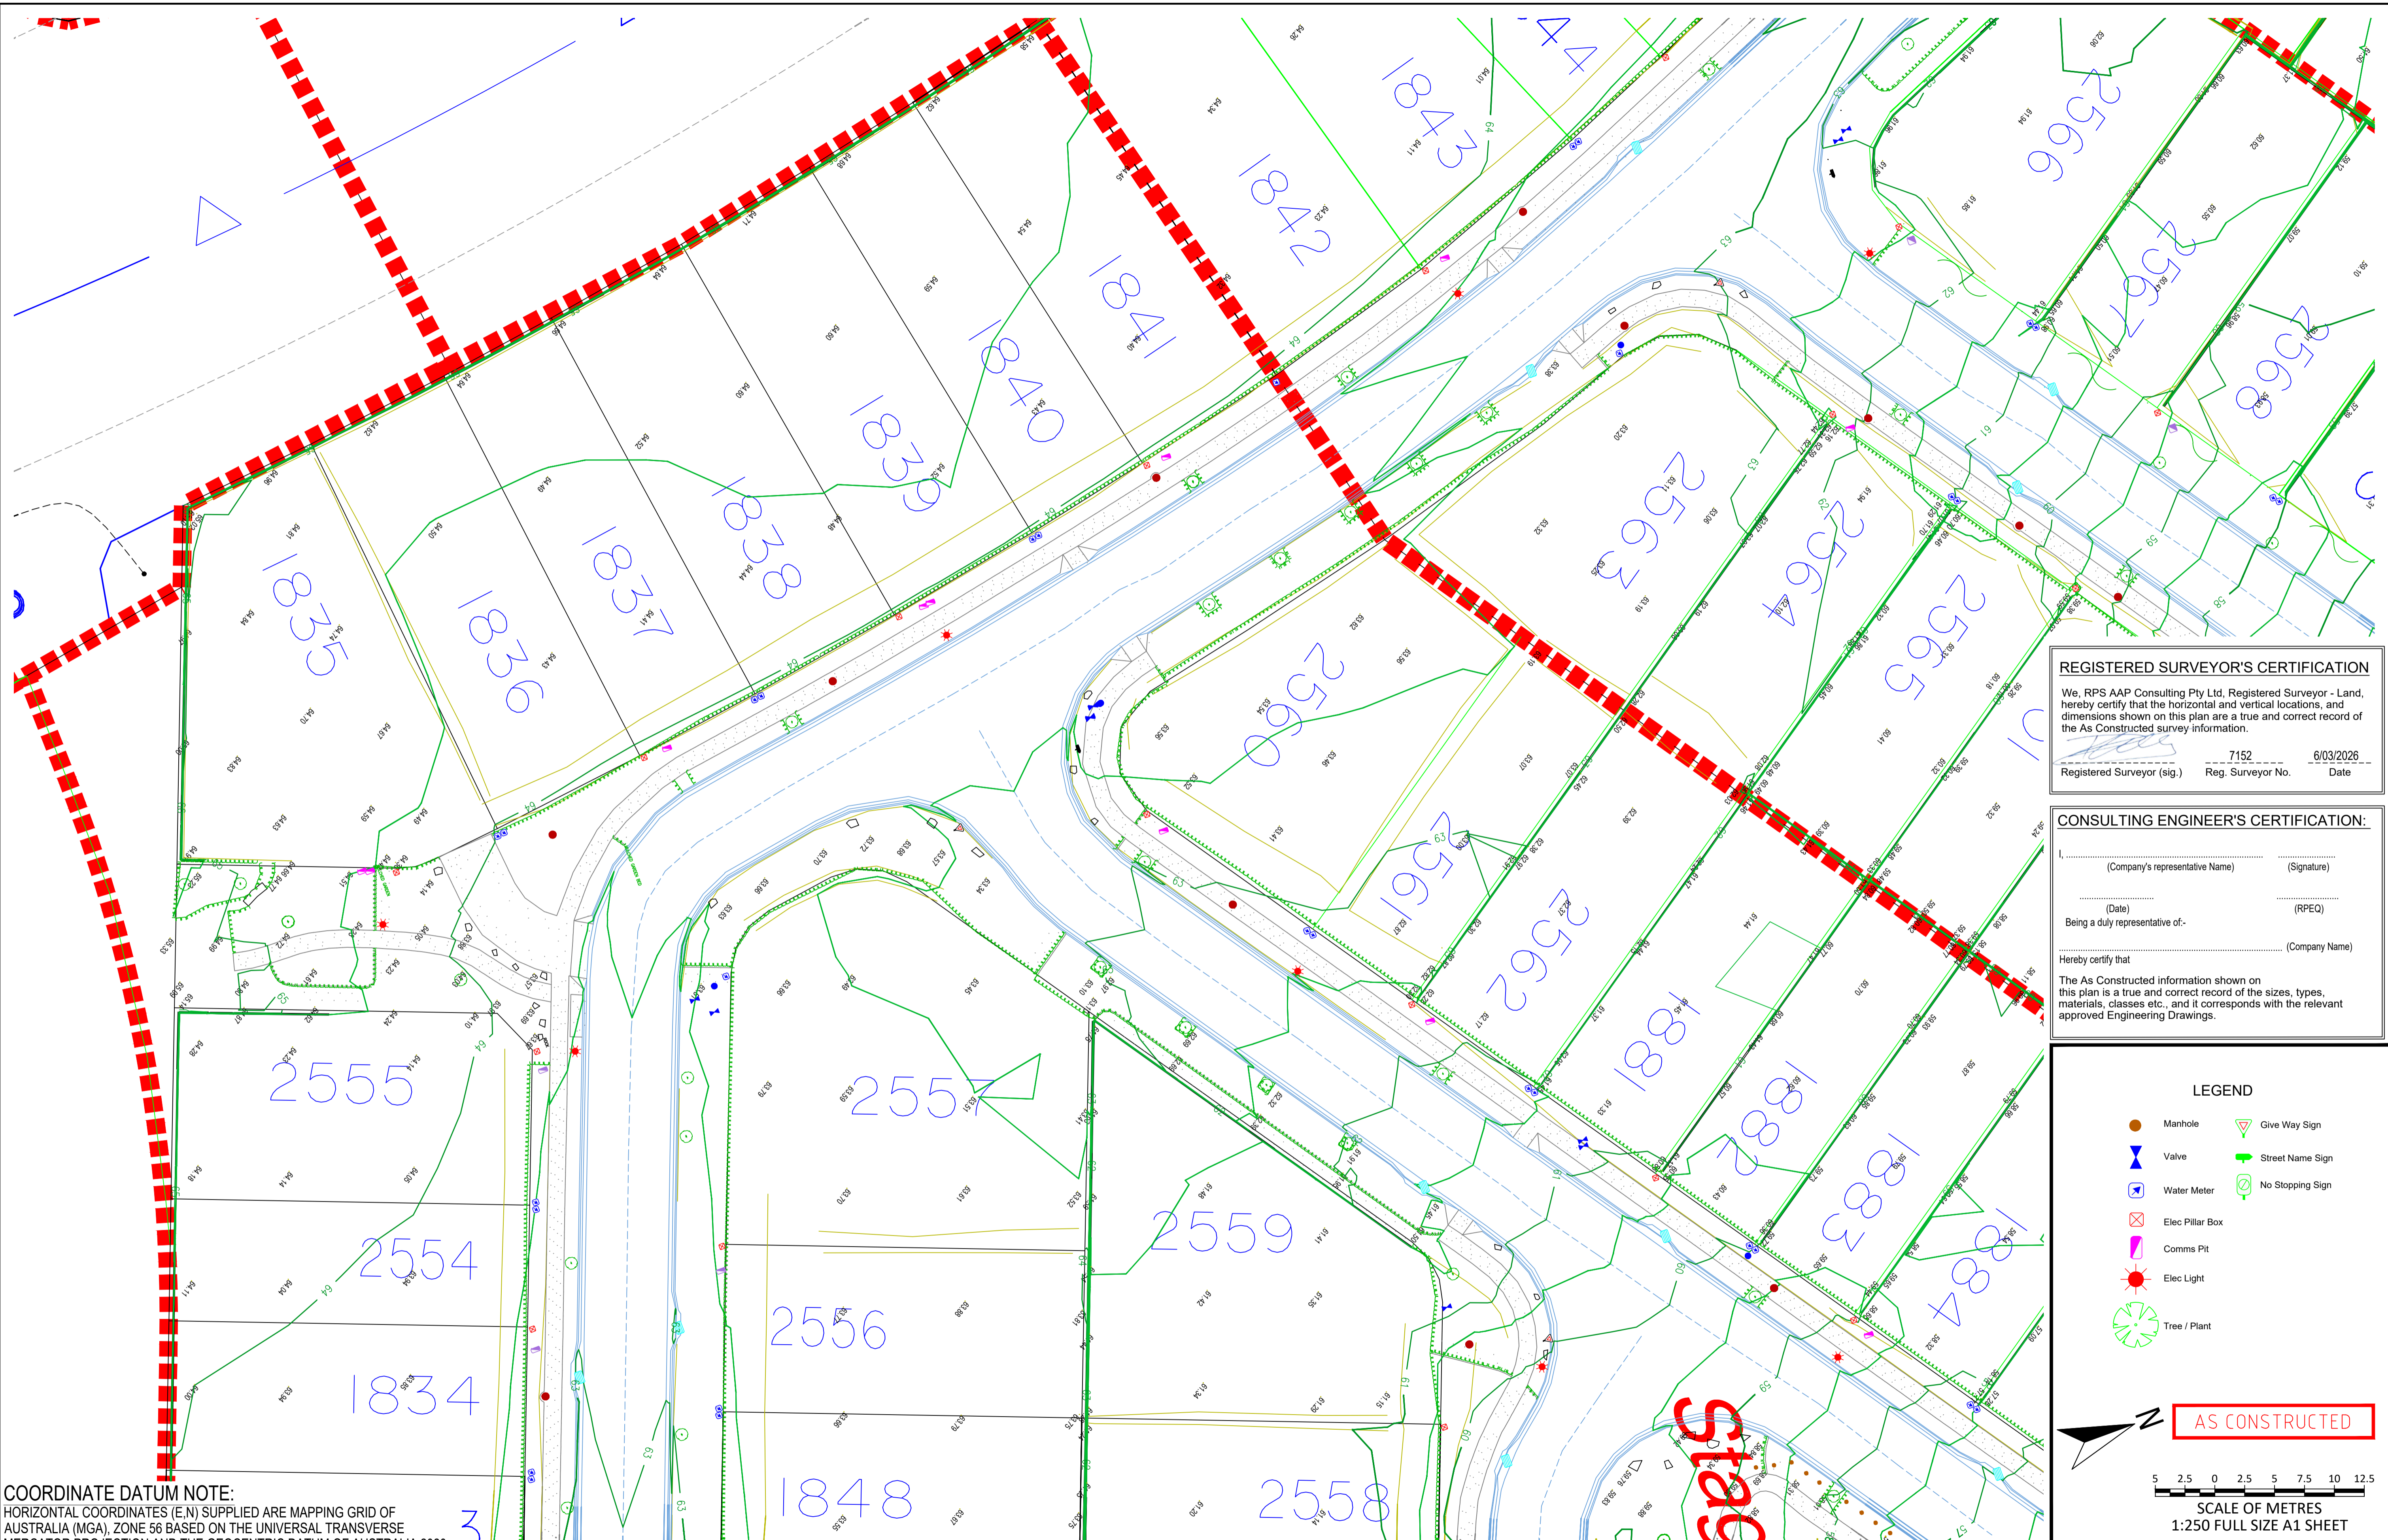

REGISTERED SURVEYOR'S CERTIFICATION
 We, RPS AAP Consulting Pty Ltd, Registered Surveyor - Land, hereby certify that the horizontal and vertical locations, and dimensions shown on this plan are a true and correct record of the As Constructed survey information.
 Registered Surveyor (sig.) _____ 7152 _____ 6/03/2026
 Reg. Surveyor No. _____ Date _____

CONSULTING ENGINEER'S CERTIFICATION:
 _____ (Company's representative Name) _____ (Signature)
 _____ (Date) _____ (RPEQ)
 Being a duly representative of- _____ (Company Name)
 Hereby certify that
 The As Constructed information shown on this plan is a true and correct record of the sizes, types, materials, classes etc., and it corresponds with the relevant approved Engineering Drawings.

LEGEND

- Manhole
- Valve
- Water Meter
- Elec Pillar Box
- Comms Pit
- Elec Light
- Tree / Plant
- Give Way Sign
- Street Name Sign
- No Stopping Sign

AS CONSTRUCTED

5 2.5 0 2.5 5 7.5 10 12.5
SCALE OF METRES
 1:250 FULL SIZE A1 SHEET

COORDINATE DATUM NOTE:
 HORIZONTAL COORDINATES (E.N) SUPPLIED ARE MAPPING GRID OF AUSTRALIA (MGA), ZONE 56 BASED ON THE UNIVERSAL TRANSVERSE MERCATOR PROJECTION AND THE GEOCENTRIC DATUM OF AUSTRALIA 2020.

INDEX	DATE	REVISIONS	DRAWN	CHECKED	PASSED
A1	19/12/2025	Preliminary As Constructed	SL	---	---
B	25/02/2026	As constructed	AP	---	---

Approved Operational Works Number: DEV2012/403/248					
INITIALS	DATE	INITIALS	DATE	INITIALS	DATE
AP	25/02/2026	DF	3/03/2026	DL	3/03/2026

RPS
 A TETRA TECH COMPANY


© COPYRIGHT PROTECTS THIS PLAN. Unauthorised reproduction or amendment not permitted. Please contact the author.

RPS AAP Consulting Pty Ltd
 ACN 117 883 173
 ABN 97 117 883 173
 Locked Bag 7801
 Suite A.02 Level 1
 114 Brisbane Street
 Ipswich QLD 4305
 T +61 7 3437 2000
 W rpsgroup.com



Logan City Council
 Flagstone
 Finished Surface Level As Constructed
 Stage 4i

SCALE	1:250
SHEET	1 OF 3 SHEETS
DRAWING NO.	TLX370977-43
INDEX	A

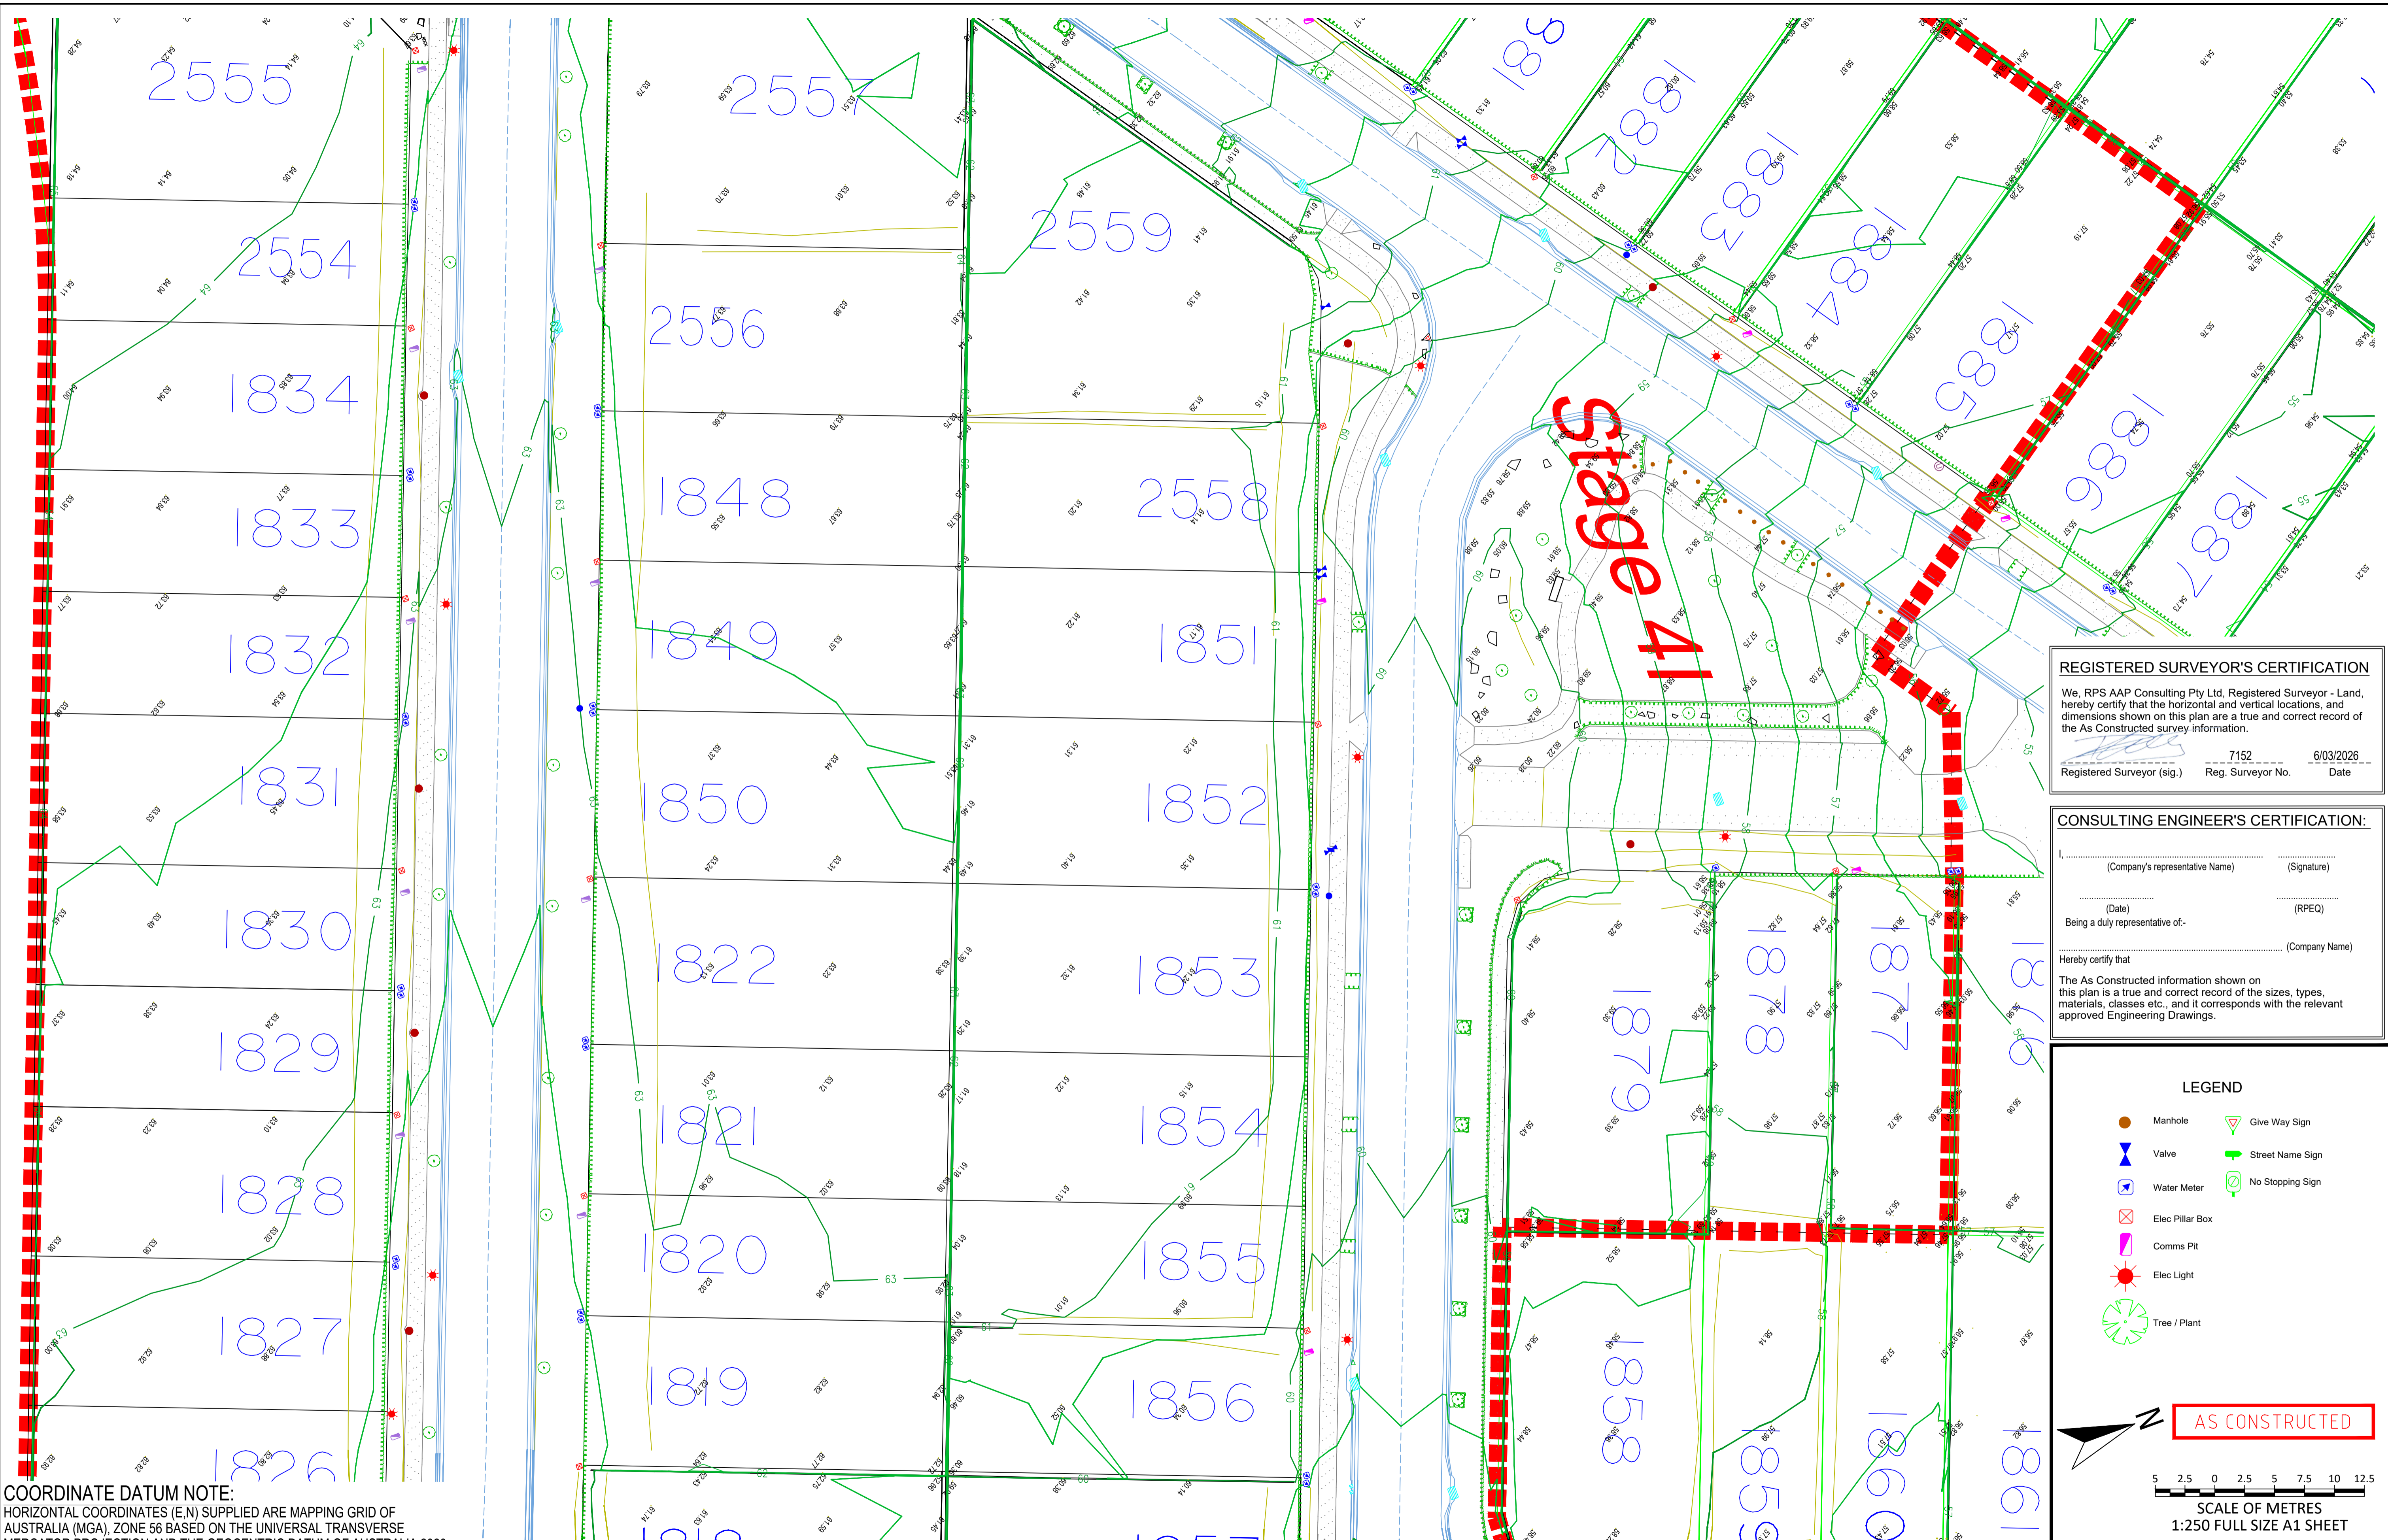


REGISTERED SURVEYOR'S CERTIFICATION
 We, RPS AAP Consulting Pty Ltd, Registered Surveyor - Land, hereby certify that the horizontal and vertical locations, and dimensions shown on this plan are a true and correct record of the As Constructed survey information.
 Registered Surveyor (sig.) _____ 7152 _____ 6/03/2026
 Reg. Surveyor No. _____ Date _____

CONSULTING ENGINEER'S CERTIFICATION:
 _____ (Company's representative Name) _____ (Signature)
 _____ (Date) _____ (RPEQ)
 Being a duly representative of- _____ (Company Name)
 I hereby certify that
 The As Constructed information shown on this plan is a true and correct record of the sizes, types, materials, classes etc., and it corresponds with the relevant approved Engineering Drawings.

LEGEND

- Manhole
- Valve
- Water Meter
- Elec Pillar Box
- Comms Pit
- Elec Light
- Tree / Plant
- Give Way Sign
- Street Name Sign
- No Stopping Sign

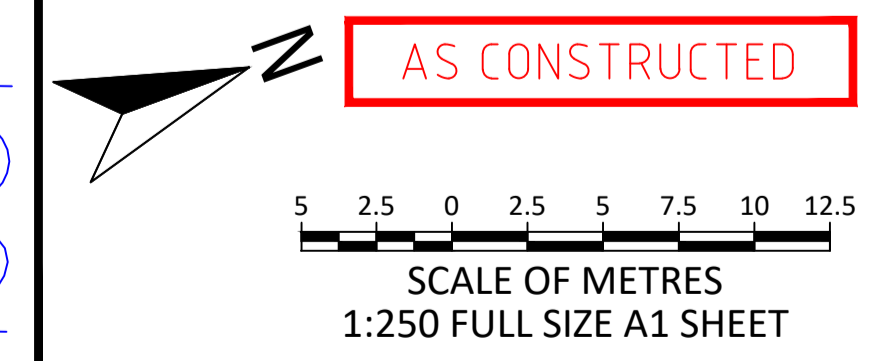

COORDINATE DATUM NOTE:
 HORIZONTAL COORDINATES (E.N) SUPPLIED ARE MAPPING GRID OF AUSTRALIA (MGA), ZONE 56 BASED ON THE UNIVERSAL TRANSVERSE MERCATOR PROJECTION AND THE GEOCENTRIC DATUM OF AUSTRALIA 2020.

INDEX	DATE	REVISIONS	DRAWN	CHECKED	PASSED
A1	25/02/2026	As constructed	AP	---	---
A	19/12/2025	Preliminary As Constructed	SL	---	---

Approved Operational Works Number: DEV2012/403/248					
INITIALS	DATE	INITIALS	DATE	INITIALS	DATE
AP	25/02/2026	DF	3/03/2026	DL	3/03/2026

RPS
 A TETRA TECH COMPANY
 ©COPYRIGHT PROTECTS THIS PLAN
 Unauthorised reproduction or amendment
 not permitted. Please contact the author.

RPS AAP Consulting Pty Ltd
 ACN 117 883 173
 ABN 97 117 883 173
 Locked Bag 7801
 Suite A.02 Level 1
 114 Brisbane Street
 Ipswich QLD 4305
 T +61 7 3437 2000
 W rpsgroup.com



Logan City Council
 Flagstone
 Finished Surface Level As Constructed
 Stage 4i

SCALE	1:250
SHEET	2 OF 3 SHEETS
DRAWING NO.	TLX370977-43
B	---
A	---



REGISTERED SURVEYOR'S CERTIFICATION
 We, RPS AAP Consulting Pty Ltd, Registered Surveyor - Land, hereby certify that the horizontal and vertical locations, and dimensions shown on this plan are a true and correct record of the As Constructed survey information.
 Registered Surveyor (sig.) _____ 7152 _____ 6/03/2026
 Reg. Surveyor No. _____ Date _____

CONSULTING ENGINEER'S CERTIFICATION:
 _____ (Company's representative Name) _____ (Signature)
 _____ (Date) _____ (RPEQ)
 Being a duly representative of- _____ (Company Name)
 Hereby certify that
 The As Constructed information shown on this plan is a true and correct record of the sizes, types, materials, classes etc., and it corresponds with the relevant approved Engineering Drawings.

- LEGEND**
- Manhole
 - Valve
 - Water Meter
 - Elec Pillar Box
 - Comms Pit
 - Elec Light
 - Tree / Plant
 - Give Way Sign
 - Street Name Sign
 - No Stopping Sign

COORDINATE DATUM NOTE:
 HORIZONTAL COORDINATES (E.N) SUPPLIED ARE MAPPING GRID OF AUSTRALIA (MGA), ZONE 56 BASED ON THE UNIVERSAL TRANSVERSE MERCATOR PROJECTION AND THE GEOCENTRIC DATUM OF AUSTRALIA 2020.

INDEX	DATE	REVISIONS	DRAWN	CHECKED	PASSED
A1	19/12/2025	Preliminary As Constructed	SL	---	---
B	25/02/2026	As constructed	AP	---	---

INITIALS	DATE
AP	25/02/2026
DF	3/03/2026
DL	3/03/2026

Approved Operational Works Number:
 DEV2012/403/248

RPS
 A TETRA TECH COMPANY
 © COPYRIGHT PROTECTS THIS PLAN
 Unauthorised reproduction or amendment
 not permitted. Please contact the author.

RPS AAP Consulting Pty Ltd
 ACN 117 883 173
 ABN 97 117 883 173
 Locked Bag 7801
 Suite A.02 Level 1
 114 Brisbane Street
 Ipswich QLD 4305
 T +61 7 3437 2000
 W rpsgroup.com



Logan City Council
 Flagstone
 Finished Surface Level As Constructed
 Stage 4i

SCALE	1:250
SHEET	3 OF 3 SHEETS
DRAWING NO.	TLX370977-43