

**COORDINATE DATUM NOTE:**  
 HORIZONTAL COORDINATES(E,N) SUPPLIED ARE MAPPING GRID OF AUSTRALIA(MGA),  
 ZONE 56 BASED ON THE UNIVERSAL TRANSVERSE MERCATOR PROJECTION AND THE  
 GEOCENTRIC DATUM OF AUSTRALIA 1994.

**Surveyors As Constructed Certification**

I: ANGELA MARGARET DÄHN (surveyors name) 05428 (surveyors registration number)  
 being a certified/registered surveyor and duly authorised representative of:  
 Therefor Group Pty Ltd

Hereby  
 • certify the information contained in this drawing is an accurate as constructed representation of the works  
 • accept responsibility for the as constructed survey information contained in this drawing  
 • acknowledge the as constructed survey information contained in the drawing may be relied on by council and others

Certification of Stage: 2D (stage number) by *Angela Dahn* (signature) On 09/12/2025 (date)

For Therefor Group Pty Ltd

**Engineers As Constructed Certification**


I: Rawdon Stanford (engineers name) 25834 (RPEQ number)  
 being a certified/registered engineer and duly authorised representative of:  
 ADG Engineers (Aust) Pty Ltd (consulting firm or company name)

Hereby  
 • certify the information contained in this drawing is an accurate as constructed representation of the works  
 • accept responsibility for the as constructed survey information contained in this drawing  
 • acknowledge the as constructed survey information contained in the drawing may be relied on by council and others

Certification of Stage: 2D (stage number) by *Rawdon Stanford* (signature) On 09/12/2025 (date)

For ADG Engineers (Aust) Pty Ltd (consulting firm or company name)

**AS CONSTRUCTED**

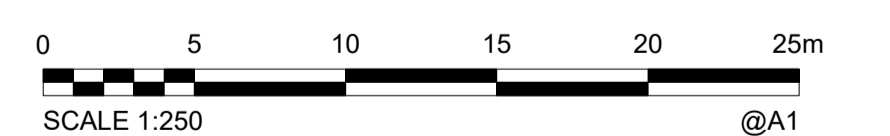

SB3594/2D-101-AC

DRAWING REVISIONS		REFERENCE DRAWINGS		DESIGN FILE No.	DESIGNED
REV.	REVISION DESCRIPTION	DRG. No.	DESCRIPTION	CONSTRUCT. No.	DATE
A	PRELIMINARY			SURVEY FILE No. SB3594/2D	DRAWN JC
1	AS CONSTRUCTED			FIELD BOOK	DATE 09-12-25
2	AS CONSTRUCTED STORMWATER UPDATES			LOG BOOK	CHECKED AD
3	AS CONSTRUCTED STORMWATER UPDATES			LEVEL DATUM	DATE 09-12-25

SCALE 1:250 ORIGINAL SIZE A1

MORETON BAY CITY  
 CABOOLTURE DISTRICT OFFICE  
 2 HASKING STREET CABOOLTURE QLD 4510  
 PO BOX 159 CABOOLTURE QLD 4510  
 Telephone: (07) 3205 0555  
 Email: council@moretonbay.qld.gov.au

**RIVERBANK ESTATE**  
 STAGE 2D  
 AS CONSTRUCTED  
 DRAINAGE SHEET 1 OF 3

SUBDIVISION REFERENCE	
DA/2023/5139	
No. 1 OF 7 PLANS	
ASCAN GRID NUMBER	REV.
-	3

PSM 191027  
 E: 4.95937.616  
 N: 7003052.339  
 RL: 8.767m

**Surveyors As Constructed Certification**

I: ANGELA MARGARET DÄHN  
 (surveyors name) 05428  
 (surveyors registration number)

being a certified/registered surveyor and duly authorised representative of:  
 Therefor Group Pty Ltd

Hereby  
 • certify the information contained in this drawing is an accurate as constructed representation of the works  
 • accept responsibility for the as constructed survey information contained in this drawing  
 • acknowledge the as constructed survey information contained in the drawing may be relied on by council and others

Certification of Stage: 2D (stage number) by *Angela Dahn* (Signature) On 09/12/2025 (date)

For Therefor Group Pty Ltd

**Engineers As Constructed Certification**

I: Rawdon Stanford  
 (engineers name) 25834  
 (RPEQ number)


being a certified/registered engineer and duly authorised representative of:  
 ADG Engineers (Aust) Pty Ltd  
 (consulting firm or company name)

Hereby  
 • certify the information contained in this drawing is an accurate as constructed representation of the works  
 • accept responsibility for the as constructed survey information contained in this drawing  
 • acknowledge the as constructed survey information contained in the drawing may be relied on by council and others


Certification of Stage: 2D (stage number) by *Rawdon Stanford* (signature) On 9/12/2025 (date)

For ADG Engineers (Aust) Pty Ltd  
 (consulting firm or company name)

- LEGEND:**
- STORMWATER PIPE
  - STORMWATER RCBC
  - STORMWATER ROOFWATER
  - EXISTING STORMWATER
  - STORMWATER MANHOLE
  - STORMWATER PIT
  - STORMWATER CUSTOM PIT BELOW MANHOLE

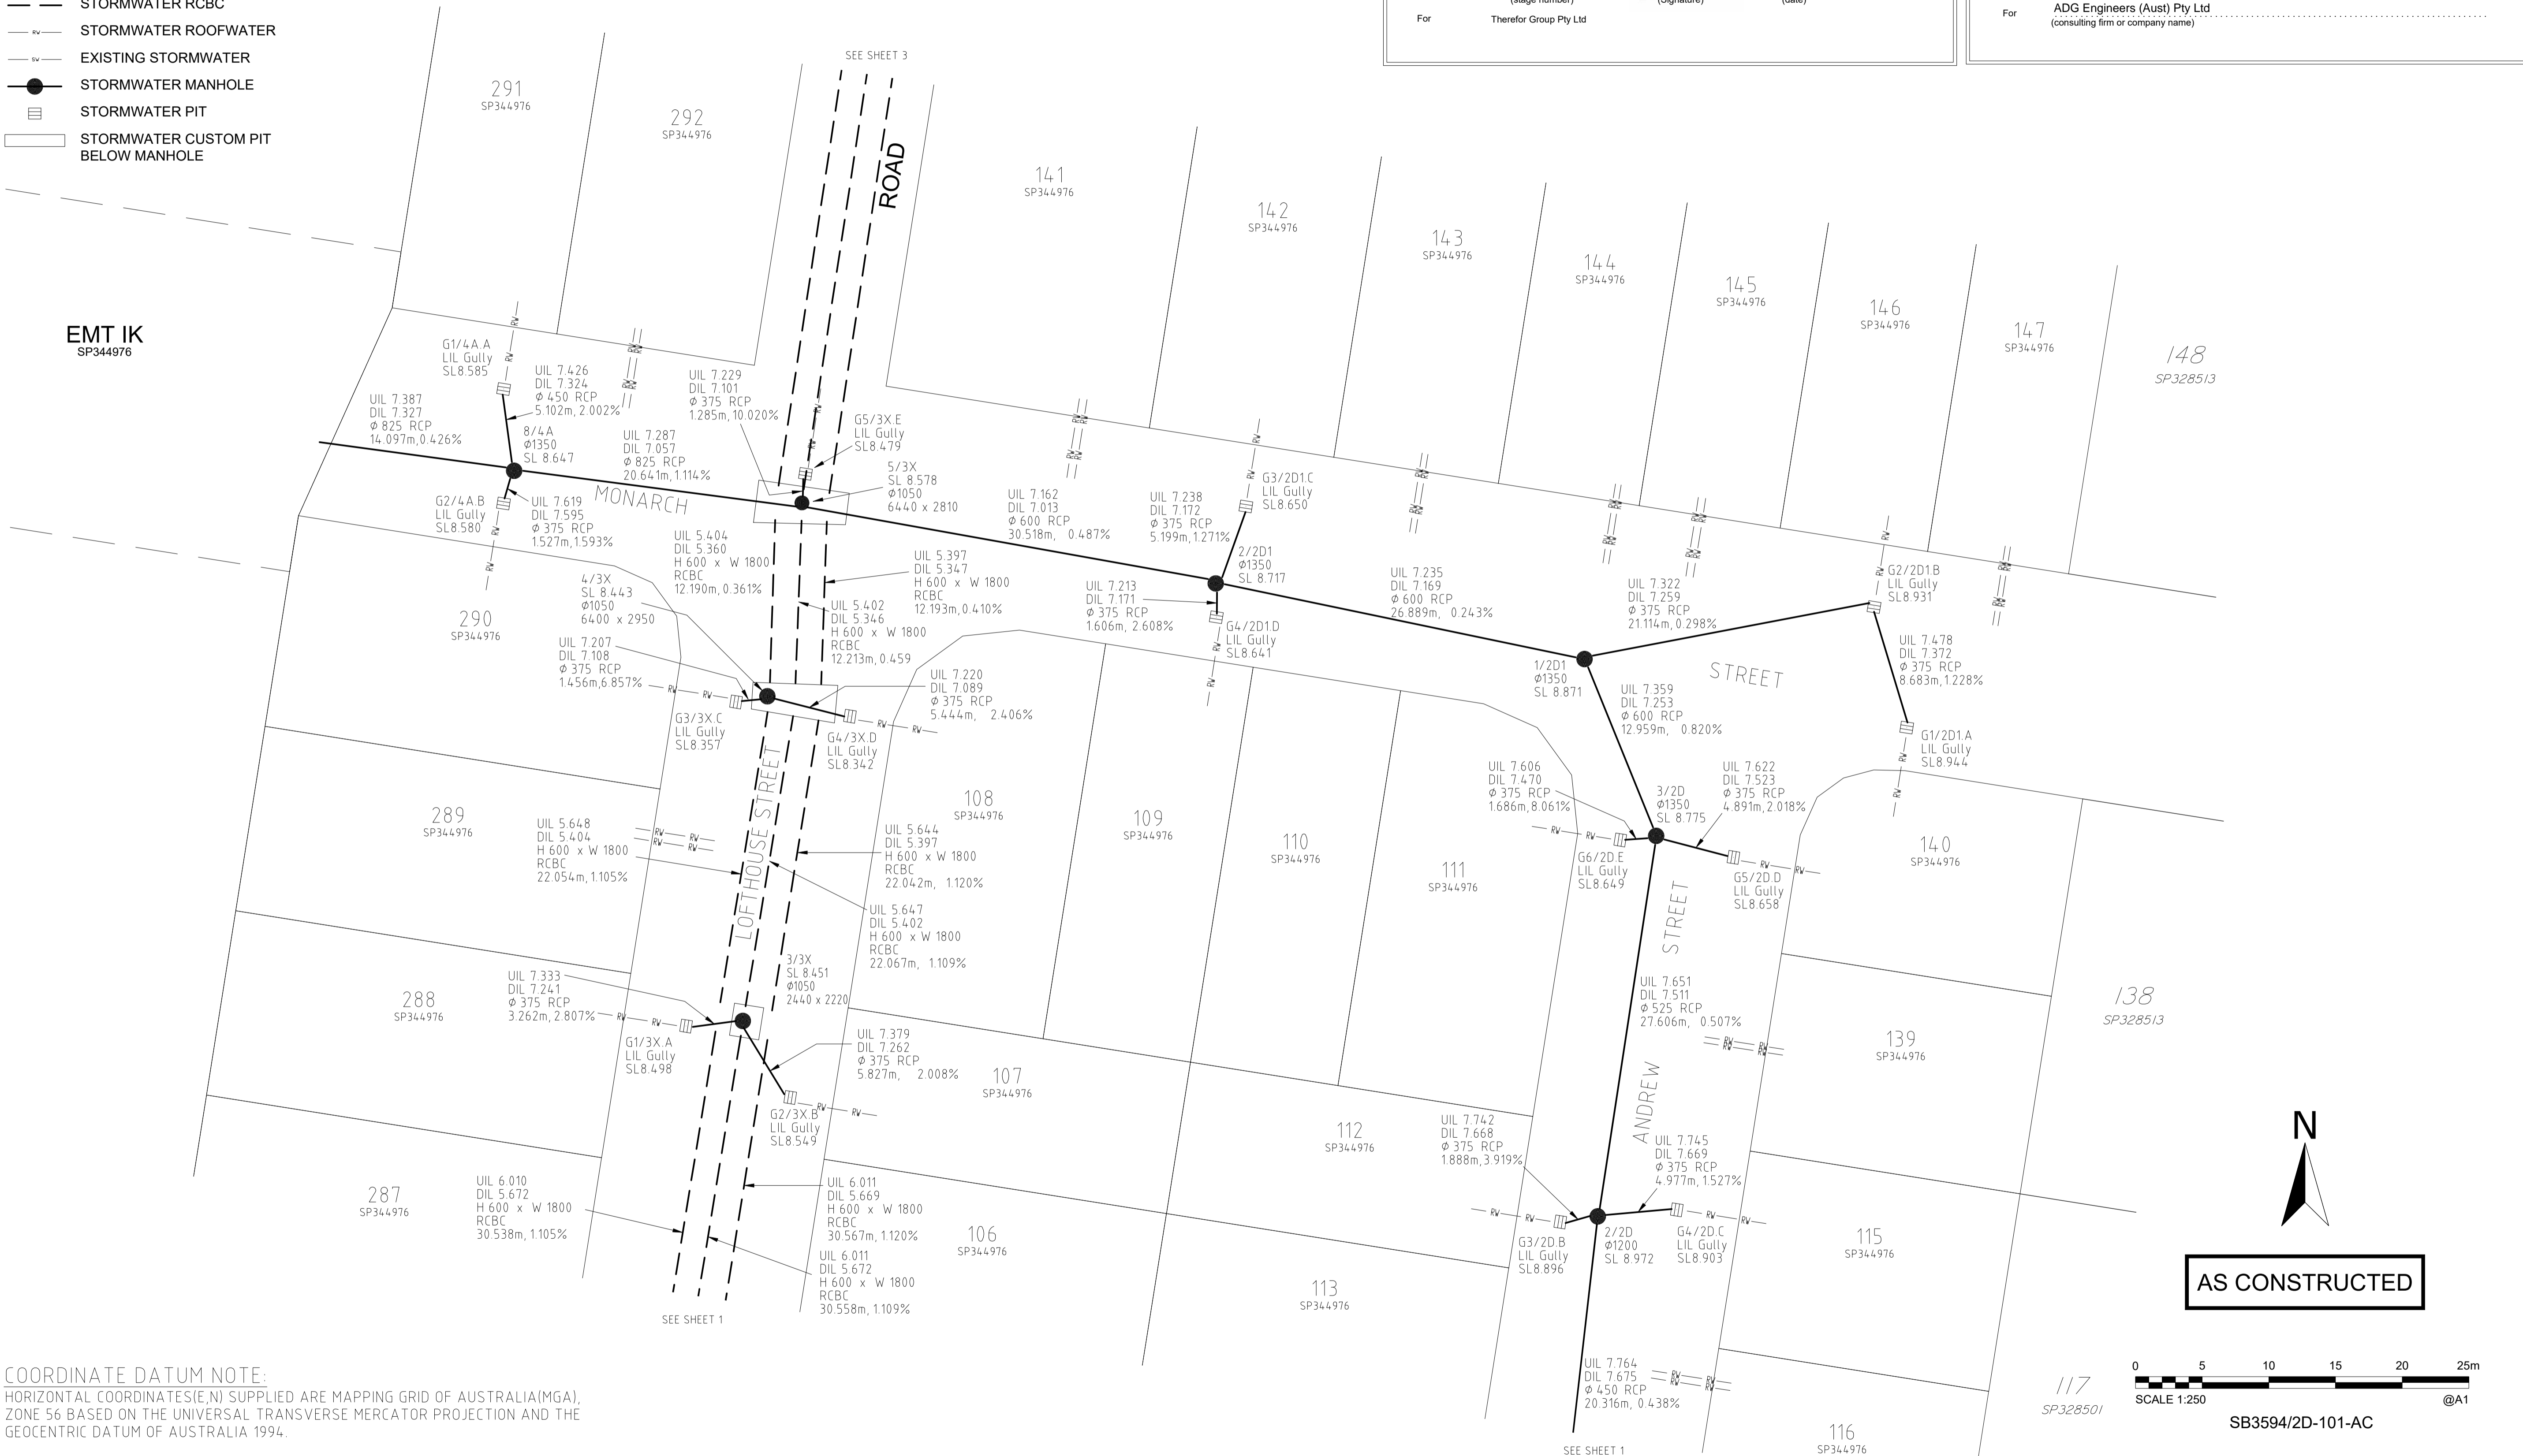

**COORDINATE DATUM NOTE:**  
 HORIZONTAL COORDINATES(E,N) SUPPLIED ARE MAPPING GRID OF AUSTRALIA(MGA),  
 ZONE 56 BASED ON THE UNIVERSAL TRANSVERSE MERCATOR PROJECTION AND THE  
 GEOCENTRIC DATUM OF AUSTRALIA 1994.

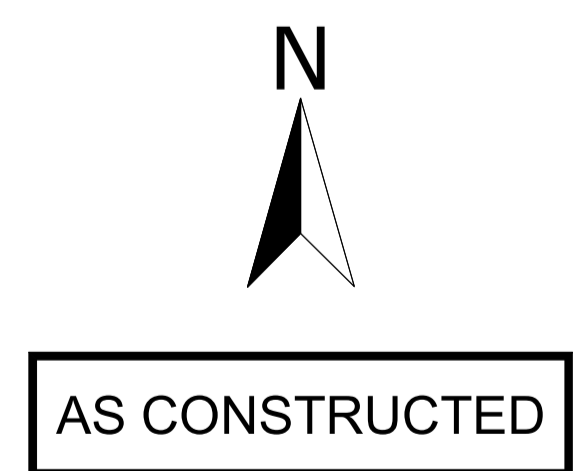

DRAWING REVISIONS		REFERENCE DRAWINGS		DESIGN FILE No.	DESIGNED
REV.	REVISION DESCRIPTION	DRG. No.	DESCRIPTION	CONSTRUCT. No.	DATE
A	PRELIMINARY				JC
1	AS CONSTRUCTED			SB3594/2D	09-12-25
2	AS CONSTRUCTED STORMWATER UPDATES				AD
3	AS CONSTRUCTED STORMWATER UPDATES				09-12-25

**therefor GROUP**

SCALE 1:250 ORIGINAL SIZE A1

**CITY OF MORETON BAY**

MORETON BAY CITY  
 CABOOLTURE DISTRICT OFFICE  
 2 HASKING STREET CABOOLTURE QLD 4510  
 PO BOX 159 CABOOLTURE QLD 4510  
 Telephone: (07) 3205 0555  
 Email: council@moretonbay.qld.gov.au

**RIVERBANK ESTATE**

STAGE 2D  
 AS CONSTRUCTED  
 DRAINAGE SHEET 2 OF 3

SUBDIVISION REFERENCE	
DA/2023/5139	
No. 2 OF 7 PLANS	
ASCAN GRID NUMBER	REV.
-	3

PSM 191027  
 E: 4.95937.616  
 N: 7003052.339  
 RL: 8.767m

**LEGEND:**

- STORMWATER PIPE
- STORMWATER RCBC
- STORMWATER ROOFWATER
- EXISTING STORMWATER
- STORMWATER MANHOLE
- STORMWATER PIT
- STORMWATER CUSTOM PIT BELOW MANHOLE

**Surveyors As Constructed Certification**

I: ANGELA MARGARET DÄHN (surveyors name) 05428 (surveyors registration number)  
 being a certified/registered surveyor and duly authorised representative of:  
 Therefor Group Pty Ltd

Hereby  
 • certify the information contained in this drawing is an accurate as constructed representation of the works  
 • accept responsibility for the as constructed survey information contained in this drawing  
 • acknowledge the as constructed survey information contained in the drawing may be relied on by council and others

Certification of Stage: 2D (stage number) by *AMS* (signature) On 09/12/2025 (date)

For Therefor Group Pty Ltd


**Engineers As Constructed Certification**

I: Rawdon Stanford (engineers name) 25834 (RPEQ number)  
 being a certified/registered engineer and duly authorised representative of:  
 ADG Engineers (Aust) Pty Ltd (consulting firm or company name)

Hereby  
 • certify the information contained in this drawing is an accurate as constructed representation of the works  
 • accept responsibility for the as constructed survey information contained in this drawing  
 • acknowledge the as constructed survey information contained in the drawing may be relied on by council and others

Certification of Stage: 2D (stage number) by *Rawdon Stanford* (signature) On 9/12/2025 (date)


For ADG Engineers (Aust) Pty Ltd (consulting firm or company name)

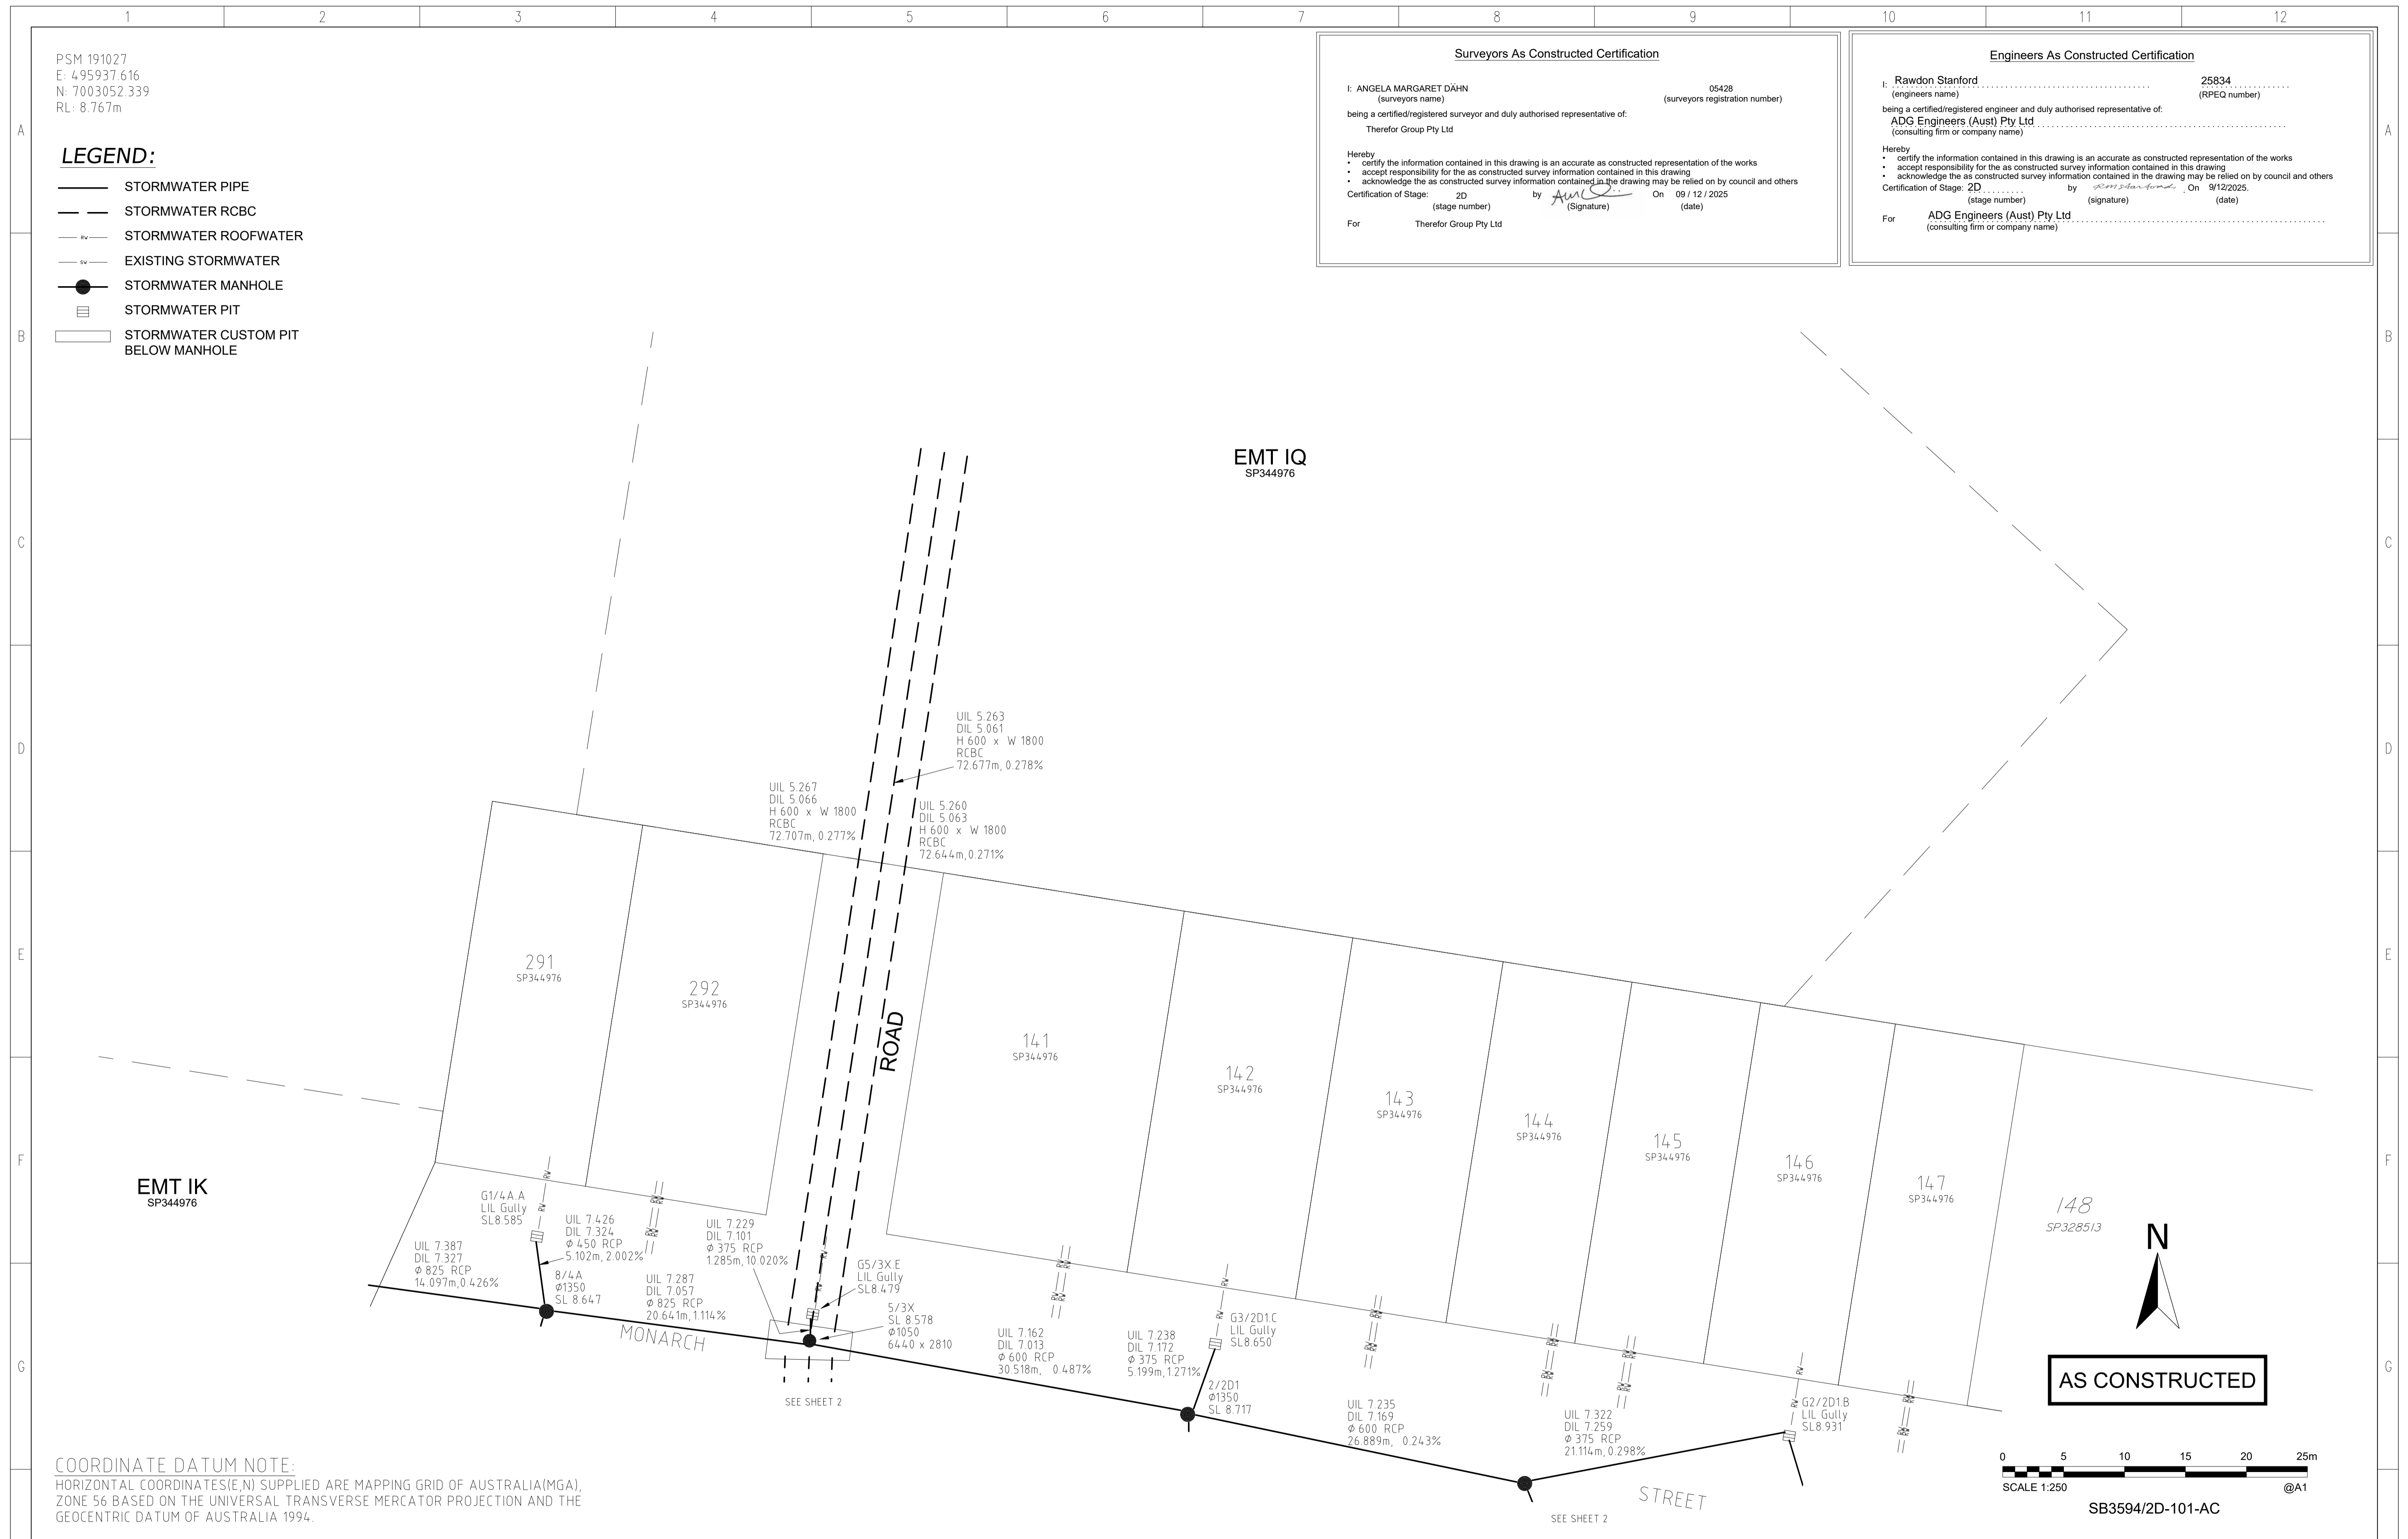

**COORDINATE DATUM NOTE:**  
 HORIZONTAL COORDINATES(E,N) SUPPLIED ARE MAPPING GRID OF AUSTRALIA(MGA),  
 ZONE 56 BASED ON THE UNIVERSAL TRANSVERSE MERCATOR PROJECTION AND THE  
 GEOCENTRIC DATUM OF AUSTRALIA 1994.

N

**AS CONSTRUCTED**

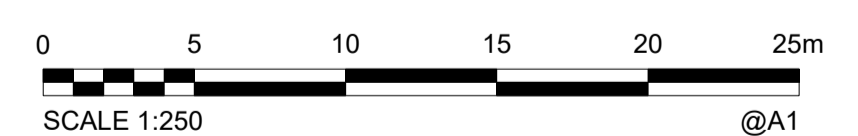

SB3594/2D-101-AC

DRAWING REVISIONS		REFERENCE DRAWINGS		DESIGN FILE No.	DESIGNED
REV.	REVISION DESCRIPTION	DRG. No.	DESCRIPTION	CONSTRUCT. No.	DATE
A	PRELIMINARY				JC
1	AS CONSTRUCTED			SB3594/2D	09-12-25
2	AS CONSTRUCTED STORMWATER UPDATES				AD
3	AS CONSTRUCTED STORMWATER UPDATES				09-12-25

**therefor GROUP**

SCALE 1:250 ORIGINAL SIZE A1

**CITY OF MORETON BAY**

MORETON BAY CITY  
 CABOOLTURE DISTRICT OFFICE  
 2 HASKING STREET CABOOLTURE QLD 4510  
 PO BOX 159 CABOOLTURE QLD 4510  
 Telephone: (07) 3205 0555  
 Email: council@moretonbay.qld.gov.au

**RIVERBANK ESTATE**  
 STAGE 2D  
 AS CONSTRUCTED  
 DRAINAGE SHEET 3 OF 3

SUBDIVISION REFERENCE	
DA/2023/5139	
No. 3 OF 7 PLANS	
ASCAN GRID NUMBER	REV.
-	3

PSM 191027  
 E: 4.95937.616  
 N: 7003052.339  
 RL: 8.767m

**LEGEND:**

- KERB LIP
- KERB INVERT
- KERB BACK
- SUB-SOIL DRAIN
- CONCRETE PATH 1.5m WIDE, 100mm THICK



EMT IL  
 SP344976

Bell Street CH0-38.698  
 Surface: 30mm, 10mm Primer  
 Basecourse: 100mm GR21  
 Sub-Base Course: 100mm GR23  
 Subgrade CBR: 45

Lofthouse Street CH0-120.98  
 Surface: 30mm, 10mm Primer  
 Basecourse: 100mm GR21  
 Sub-Base Course: 100mm GR23  
 Subgrade CBR: 45

Andrew Street CH191.71-288.527  
 Surface: 30mm, 10mm Primer  
 Basecourse: 100mm GR21  
 Sub-Base Course: 100mm GR23  
 Subgrade CBR: 45

**Surveyors As Constructed Certification**

I: ANGELA MARGARET DÄHN (surveyors name) 05428 (surveyors registration number)  
 being a certified/registered surveyor and duly authorised representative of:  
 Therefor Group Pty Ltd

Hereby  
 • certify the information contained in this drawing is an accurate as constructed representation of the works  
 • accept responsibility for the as constructed survey information contained in this drawing  
 • acknowledge the as constructed survey information contained in the drawing may be relied on by council and others

Certification of Stage: 2D (stage number) by *Angela Dahn* (signature) On 09/12/2025 (date)

For Therefor Group Pty Ltd

**Engineers As Constructed Certification**

I: Rawdon Stanford (engineers name) 25834 (RPEQ number)  
 being a certified/registered engineer and duly authorised representative of:  
 ADG Engineers (Aust) Pty Ltd (consulting firm or company name)

Hereby  
 • certify the information contained in this drawing is an accurate as constructed representation of the works  
 • accept responsibility for the as constructed survey information contained in this drawing  
 • acknowledge the as constructed survey information contained in the drawing may be relied on by council and others

Certification of Stage: 2D (stage number) by *Rawdon Stanford* (signature) On 09/12/2025 (date)

For ADG Engineers (Aust) Pty Ltd (consulting firm or company name)

N

**AS CONSTRUCTED**

0 5 10 15 20 25m  
 SCALE 1:250 @A1

SB3594/2D-101-AC

**COORDINATE DATUM NOTE:**  
 HORIZONTAL COORDINATES(E,N) SUPPLIED ARE MAPPING GRID OF AUSTRALIA(MGA),  
 ZONE 56 BASED ON THE UNIVERSAL TRANSVERSE MERCATOR PROJECTION AND THE  
 GEOCENTRIC DATUM OF AUSTRALIA 1994.

DRAWING REVISIONS		REFERENCE DRAWINGS		DESIGN FILE No.	DESIGNED
REV.	REVISION DESCRIPTION	DRG. No.	DESCRIPTION	CONSTRUCT. No.	DATE
A	PRELIMINARY				JC
1	AS CONSTRUCTED			SB3594/2D	09-12-25
2	AS CONSTRUCTED STORMWATER UPDATES				AD
3	AS CONSTRUCTED STORMWATER UPDATES				09-12-25

FIELD BOOK	CHECKED
ADG	AD
LEVEL DATUM	DATE
PSM191027	09-12-25

**therefor GROUP**

SCALE 1:250 ORIGINAL SIZE A1

**CITY OF MORETON BAY**

MORETON BAY CITY  
 CABOOLTURE DISTRICT OFFICE  
 2 HASKING STREET CABOOLTURE QLD 4510  
 PO BOX 159 CABOOLTURE QLD 4510  
 Telephone: (07) 3205 0555  
 Email: council@moretonbay.qld.gov.au

**RIVERBANK ESTATE**  
 STAGE 2D  
 AS CONSTRUCTED  
 TRANSPORT SHEET 1 OF 2

SUBDIVISION REFERENCE	
DA/2023/5139	
No. 4 OF 7 PLANS	
ASCAN GRID NUMBER	REV.
-	3

PSM 191027  
 E: 4.95937.616  
 N: 7003052.339  
 RL: 8.767m

**LEGEND:**

- KERB LIP
- KERB INVERT
- KERB BACK
- SUB-SOIL DRAIN
- CONCRETE PATH 1.5m WIDE, 100mm THICK

**Surveyors As Constructed Certification**

I: ANGELA MARGARET DÄHN (surveyors name) 05428 (surveyors registration number)  
 being a certified/registered surveyor and duly authorised representative of:  
 Therefor Group Pty Ltd

Hereby  
 • certify the information contained in this drawing is an accurate as constructed representation of the works  
 • accept responsibility for the as constructed survey information contained in this drawing  
 • acknowledge the as constructed survey information contained in the drawing may be relied on by council and others

Certification of Stage: 2D (stage number) by *[Signature]* On 09/12/2025 (date)

For Therefor Group Pty Ltd


**Engineers As Constructed Certification**

I: Rawdon Stanford (engineers name) 25834 (RPEQ number)  
 being a certified/registered engineer and duly authorised representative of:  
 ADG Engineers (Aust) Pty Ltd (consulting firm or company name)



Hereby  
 • certify the information contained in this drawing is an accurate as constructed representation of the works  
 • accept responsibility for the as constructed survey information contained in this drawing  
 • acknowledge the as constructed survey information contained in the drawing may be relied on by council and others

Certification of Stage: 2D (stage number) by *[Signature]* On 9/12/2025 (date)

For ADG Engineers (Aust) Pty Ltd (consulting firm or company name)

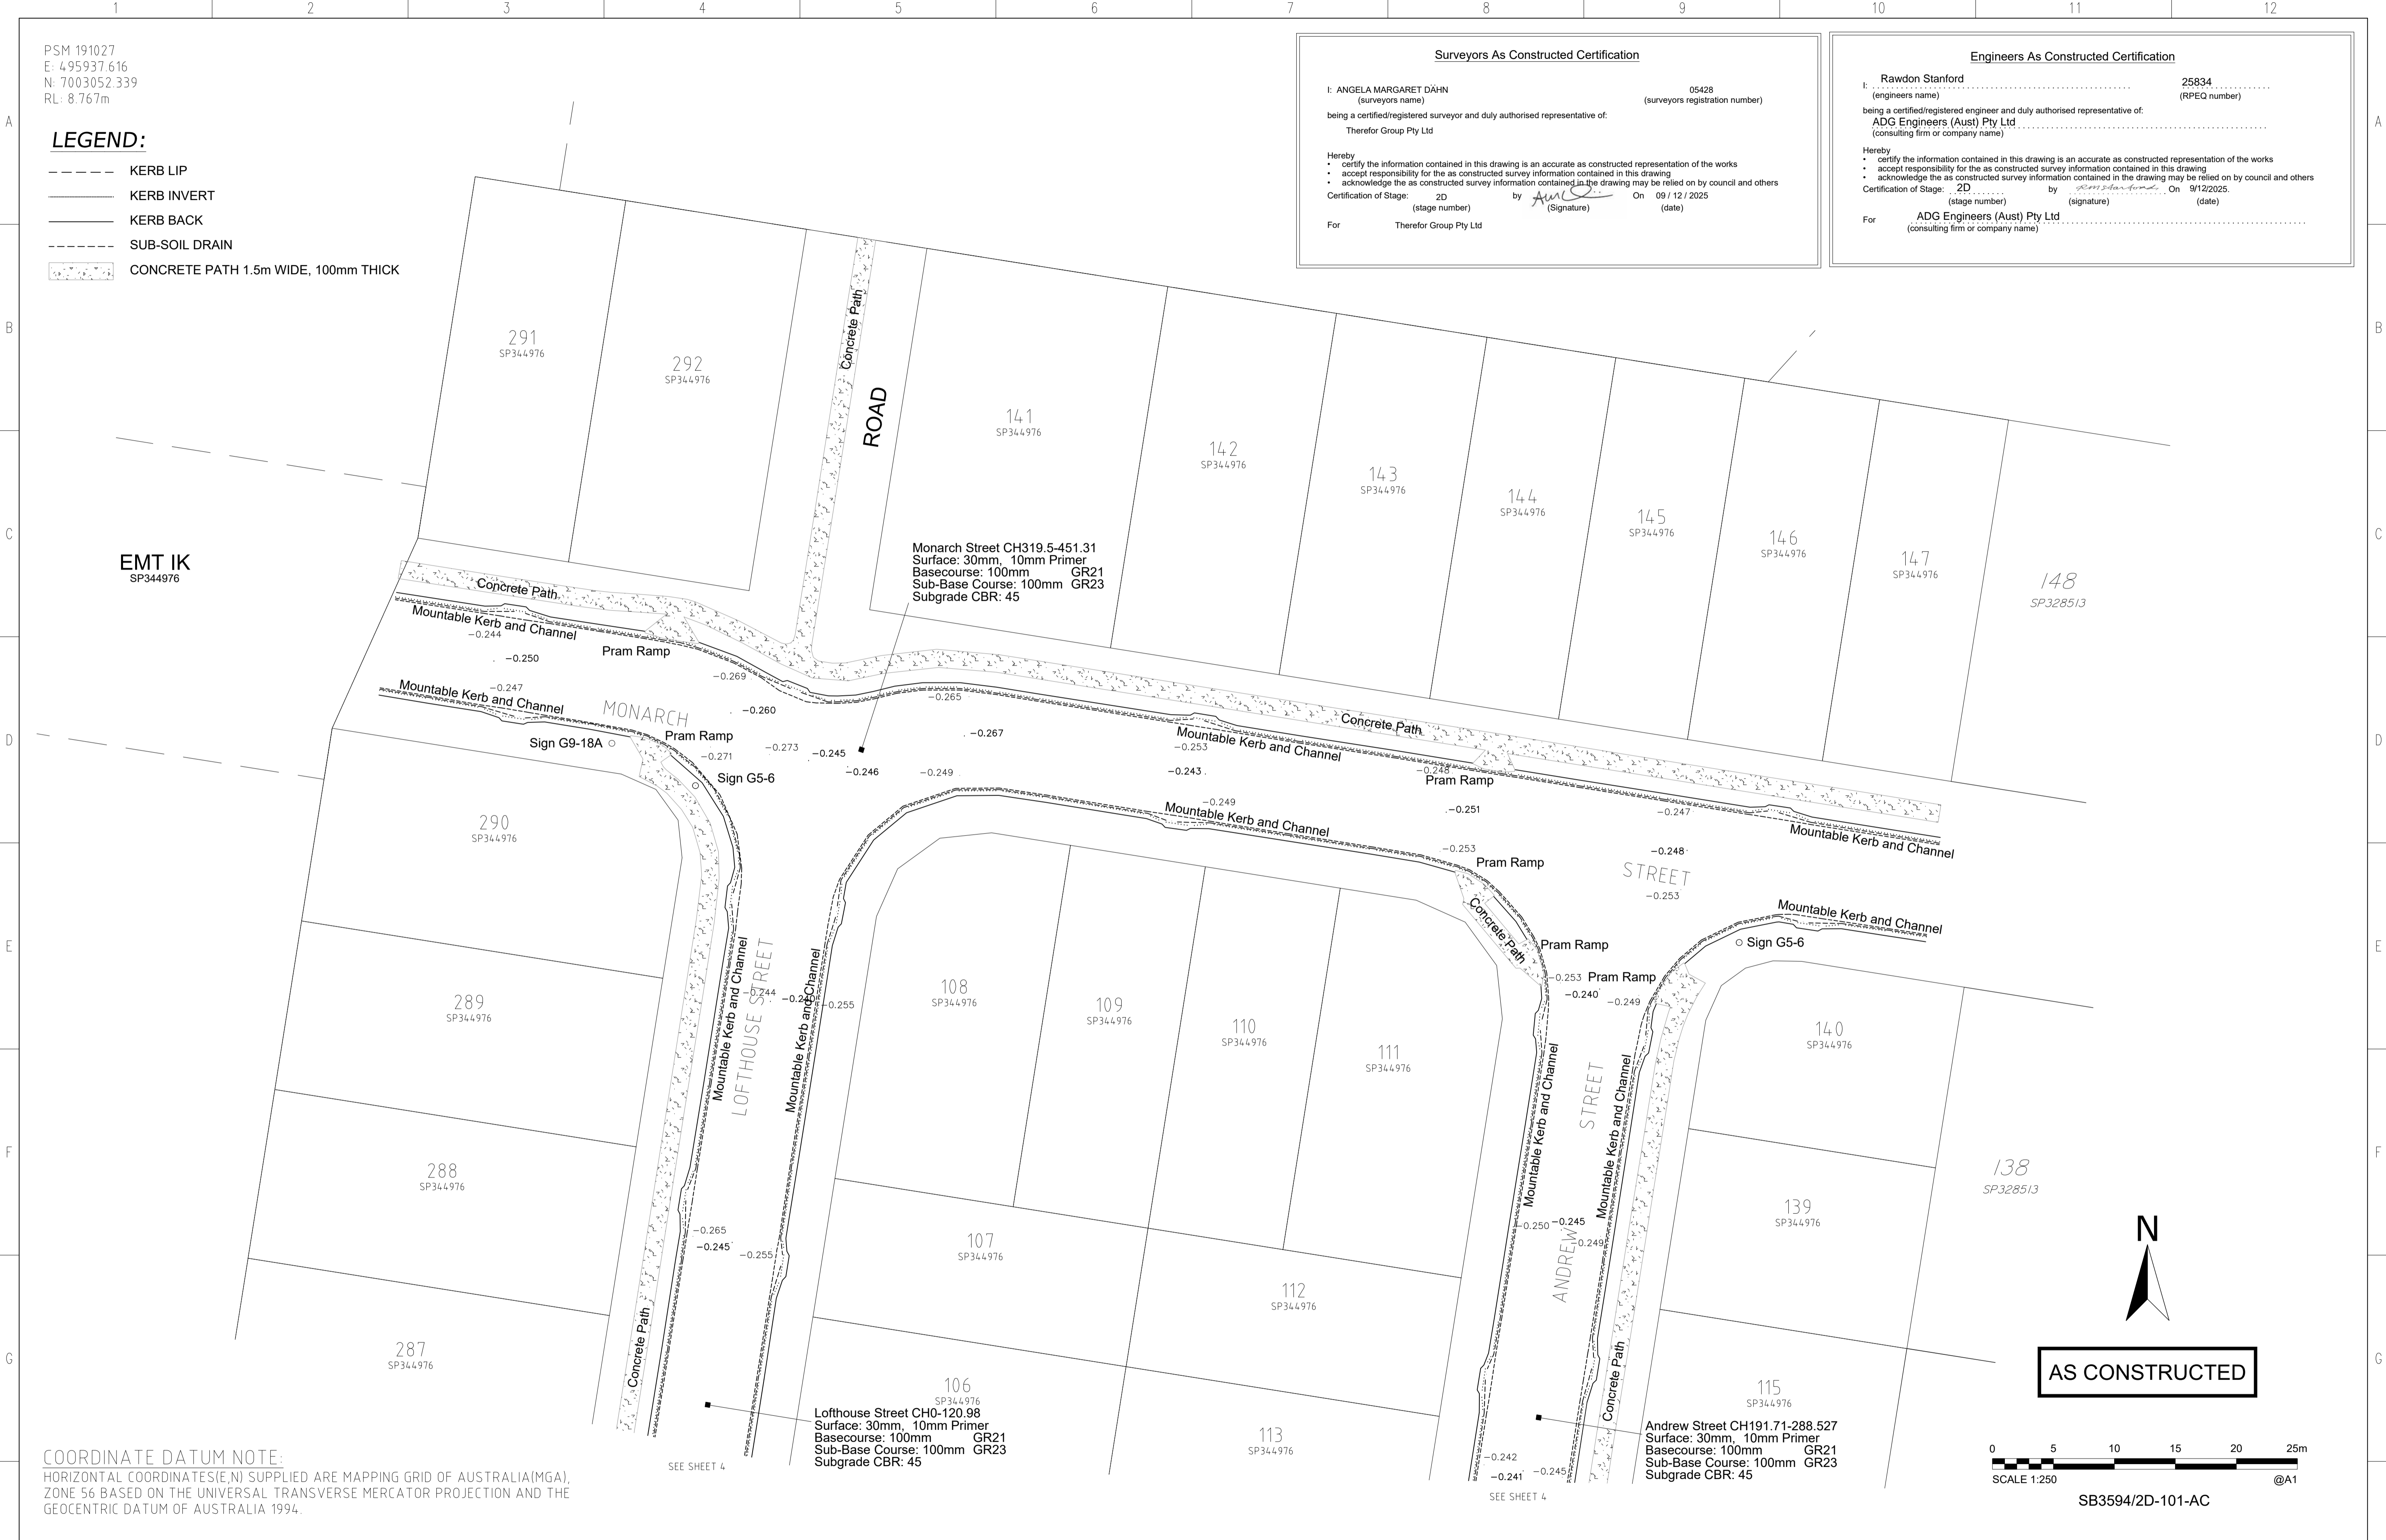

**COORDINATE DATUM NOTE:**  
 HORIZONTAL COORDINATES(E,N) SUPPLIED ARE MAPPING GRID OF AUSTRALIA(MGA),  
 ZONE 56 BASED ON THE UNIVERSAL TRANSVERSE MERCATOR PROJECTION AND THE  
 GEOCENTRIC DATUM OF AUSTRALIA 1994.

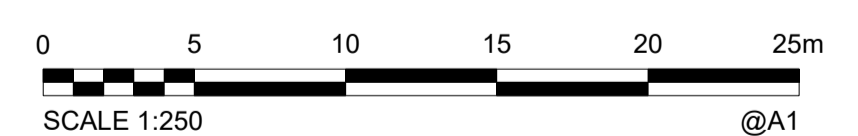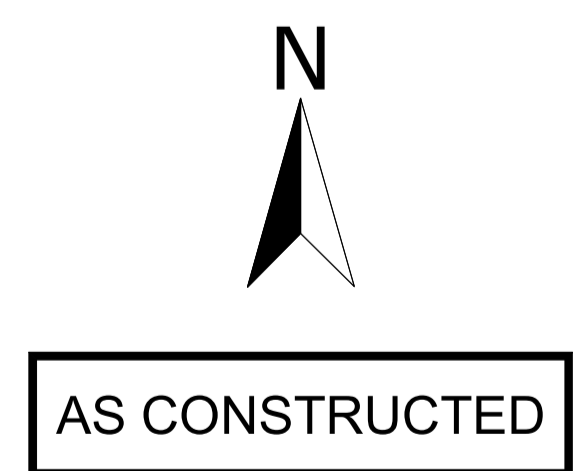

SB3594/2D-101-AC

DRAWING REVISIONS		REFERENCE DRAWINGS		DESIGN FILE No.	DESIGNED
REV.	REVISION DESCRIPTION	DRG. No.	DESCRIPTION	CONSTRUCT. No.	DATE
A	PRELIMINARY				JC
1	AS CONSTRUCTED			SB3594/2D	09-12-25
2	AS CONSTRUCTED STORMWATER UPDATES				AD
3	AS CONSTRUCTED STORMWATER UPDATES				09-12-25

FIELD BOOK	CHECKED	DATE
	AD	09-12-25
LOG BOOK	CHECKED	DATE
	AD	09-12-25
LEVEL DATUM		
PSM191027		

**therefor GROUP**

SCALE 1:250 ORIGINAL SIZE A1

**CITY OF MORETON BAY**

MORETON BAY CITY  
 CABOOLTURE DISTRICT OFFICE  
 2 HASKING STREET CABOOLTURE QLD 4510  
 PO BOX 159 CABOOLTURE QLD 4510  
 Telephone: (07) 3205 0555  
 Email: council@moretonbay.qld.gov.au


**RIVERBANK ESTATE**  
 STAGE 2D  
 AS CONSTRUCTED  
 TRANSPORT SHEET 2 OF 2

SUBDIVISION REFERENCE	
DA/2023/5139	
No. 5 OF 7 PLANS	
ASCON GRID NUMBER	REV.
-	3


PSM 191027  
 E: 4.95937.616  
 N: 7003052.339  
 RL: 8.767m

**LEGEND:**

- CONTOUR
- - - CHANGE OF GRADE
- TOP OF BANK
- - - BOTTOM OF BANK
- 55.83 ✖ SPOT HEIGHT

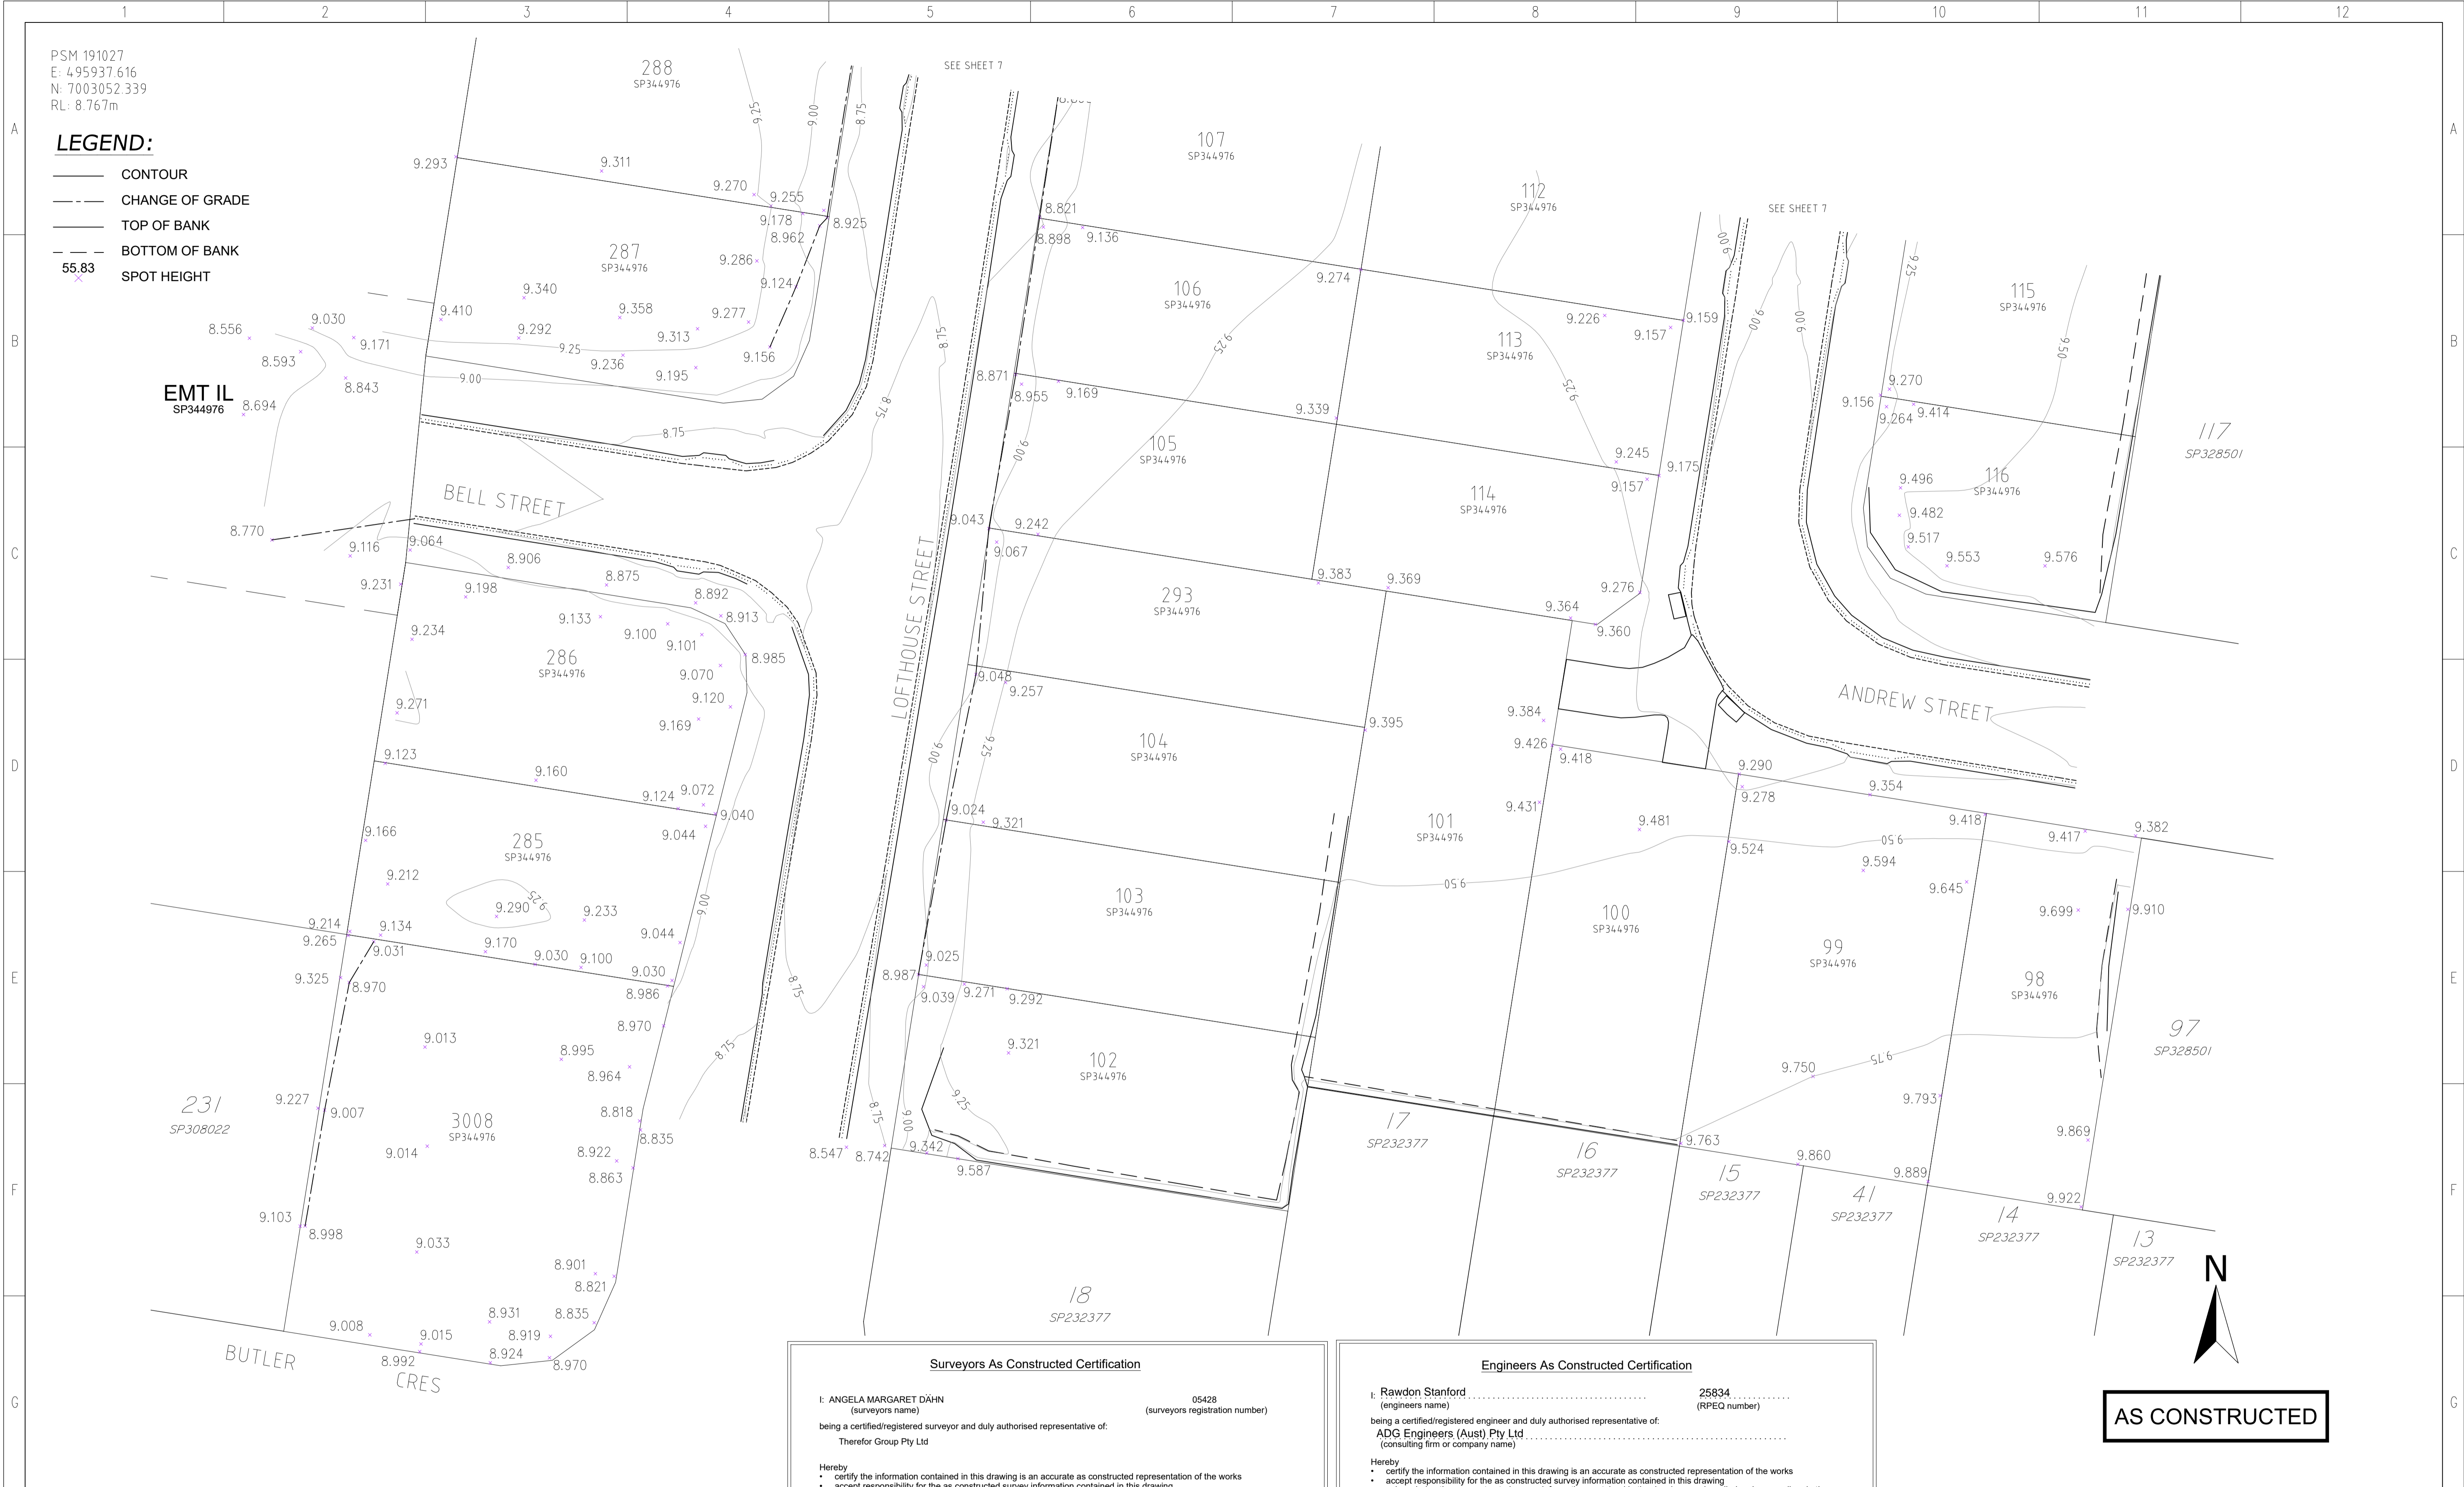

**AS CONSTRUCTED**

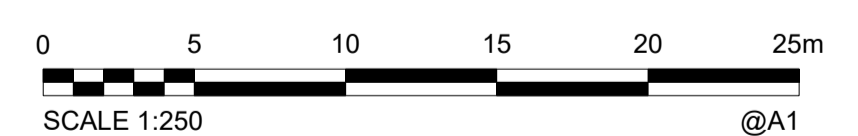

SB3594/2D-101-AC

**Surveyors As Constructed Certification**

I: ANGELA MARGARET DAHN (surveyors name) 05428 (surveyors registration number)  
 being a certified/registered surveyor and duly authorised representative of:  
 Therefor Group Pty Ltd

Hereby  
 • certify the information contained in this drawing is an accurate as constructed representation of the works  
 • accept responsibility for the as constructed survey information contained in this drawing  
 • acknowledge the as constructed survey information contained in the drawing may be relied on by council and others

Certification of Stage: 2D (stage number) by *Angela Dahn* (signature) On 09/12/2025 (date)

For Therefor Group Pty Ltd

**Engineers As Constructed Certification**

I: Rawdon Stanford (engineers name) 25834 (RPEQ number)  
 being a certified/registered engineer and duly authorised representative of:  
 ADG Engineers (Aust) Pty Ltd (consulting firm or company name)

Hereby  
 • certify the information contained in this drawing is an accurate as constructed representation of the works  
 • accept responsibility for the as constructed survey information contained in this drawing  
 • acknowledge the as constructed survey information contained in the drawing may be relied on by council and others

Certification of Stage: 2D (stage number) by *Rawdon Stanford* (signature) On 9/12/2025 (date)

For ADG Engineers (Aust) Pty Ltd (consulting firm or company name)

**COORDINATE DATUM NOTE:**  
 HORIZONTAL COORDINATES(E,N) SUPPLIED ARE MAPPING GRID OF AUSTRALIA(MGA),  
 ZONE 56 BASED ON THE UNIVERSAL TRANSVERSE MERCATOR PROJECTION AND THE  
 GEOCENTRIC DATUM OF AUSTRALIA 1994.

DRAWING REVISIONS		REFERENCE DRAWINGS		DESIGN FILE No.	DESIGNED
REV.	REVISION DESCRIPTION	DRG. No.	DESCRIPTION	CONSTRUCT. No.	DATE
A	PRELIMINARY				JC
1	AS CONSTRUCTED			SB3594/2D	09-12-25
2	AS CONSTRUCTED STORMWATER UPDATES				AD
3	AS CONSTRUCTED STORMWATER UPDATES				09-12-25

SCALE 1:250 ORIGINAL SIZE A1

MORETON BAY CITY  
 CABOOLTURE DISTRICT OFFICE  
 2 HASKING STREET CABOOLTURE QLD 4510  
 PO BOX 159 CABOOLTURE QLD 4510  
 Telephone: (07) 3205 0555  
 Email: council@moretonbay.qld.gov.au

**RIVERBANK ESTATE**  
 STAGE 2D  
 AS CONSTRUCTED  
 SURFACE SHEET 1 OF 2

SUBDIVISION REFERENCE	
DA/2023/5139	
No. 6 OF 7 PLANS	
ASCAN GRID NUMBER	REV.
-	<b>3</b>

**Surveyors As Constructed Certification**

I: ANGELA MARGARET DÄHN  
(surveyors name) 05428  
(surveyors registration number)  
being a certified/registered surveyor and duly authorised representative of:  
Therefor Group Pty Ltd

Hereby  
• certify the information contained in this drawing is an accurate as constructed representation of the works  
• accept responsibility for the as constructed survey information contained in this drawing  
• acknowledge the as constructed survey information contained in the drawing may be relied on by council and others

Certification of Stage: 2D by [Signature] On 09/12/2025  
(stage number) (signature) (date)

For Therefor Group Pty Ltd

**LEGEND:**

- CONTOUR
- - - CHANGE OF GRADE
- TOP OF BANK
- - - BOTTOM OF BANK
- 55.83 ✕ SPOT HEIGHT

PSM 191027  
E: 495937.616  
N: 7003052.339  
RL: 8.767m


EMT IK  
SP344976

MONARCH


LOFTHOUSE STREET

STREET

ANDREW STREET

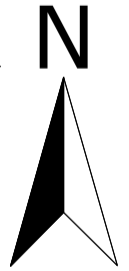

AS CONSTRUCTED

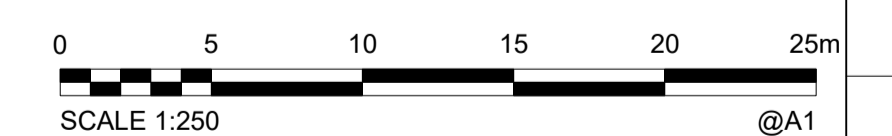

SB3594/2D-101-AC

**Engineers As Constructed Certification**

I: Rawdon Stanford  
(engineers name) 25834  
(RPEQ number)  
being a certified/registered engineer and duly authorised representative of:  
ADG Engineers (Aust) Pty Ltd  
(consulting firm or company name)

Hereby  
• certify the information contained in this drawing is an accurate as constructed representation of the works  
• accept responsibility for the as constructed survey information contained in this drawing  
• acknowledge the as constructed survey information contained in the drawing may be relied on by council and others

Certification of Stage: 2D by [Signature] On 9/12/2025  
(stage number) (signature) (date)

For ADG Engineers (Aust) Pty Ltd  
(consulting firm or company name)

**COORDINATE DATUM NOTE:**  
HORIZONTAL COORDINATES(E,N) SUPPLIED ARE MAPPING GRID OF AUSTRALIA(MGA),  
ZONE 56 BASED ON THE UNIVERSAL TRANSVERSE MERCATOR PROJECTION AND THE  
GEOCENTRIC DATUM OF AUSTRALIA 1994.

DRAWING REVISIONS		REFERENCE DRAWINGS		DESIGN FILE No.	DESIGNED	
REV.	REVISION DESCRIPTION	DRG. No.	DESCRIPTION	CONSTRUCT. No.	DATE	
A	PRELIMINARY					JC
1	AS CONSTRUCTED			SB3594/2D	09-12-25	
2	AS CONSTRUCTED STORMWATER UPDATES					AD
3	AS CONSTRUCTED STORMWATER UPDATES				09-12-25	

**therefor GROUP**

SCALE 1:250 ORIGINAL SIZE A1

**CITY OF MORETON BAY**

MORETON BAY CITY  
CABOOLTURE DISTRICT OFFICE  
2 HASKING STREET CABOOLTURE QLD 4510  
PO BOX 159 CABOOLTURE QLD 4510  
Telephone: (07) 3205 0555  
Email: council@moretonbay.qld.gov.au

**RIVERBANK ESTATE**  
STAGE 2D  
AS CONSTRUCTED  
SURFACE SHEET 2 OF 2

SUBDIVISION REFERENCE	
DA/2023/5139	
No. 7 OF 7 PLANS	
ASCON GRID NUMBER	REV.
-	3

PSM 191027  
 E: 495938.222  
 N: 7003053.734  
 RL: 8.767m  
 GDA2020

# UNITYWATER PROJECT NUMBER APP-06699 RIVERBANK ESTATE STAGE 2D MONARCH STREET, CABOOLTURE SOUTH OD160 SEWER MAIN / DN150/100 WATERMAIN



DRAWING INDEX	
DRAWING NUMBER	DESCRIPTION
U-2024-5394-01	LOCALITY PLAN AND DRAWING INDEX
U-2024-5394-02	SEWER RETICULATION LAYOUT PLAN SHEET 1 OF 2
U-2024-5394-03	SEWER RETICULATION LAYOUT PLAN SHEET 2 OF 2
U-2024-5394-04	WATER RETICULATION LAYOUT PLAN SHEET 1 OF 2
U-2024-5394-05	WATER RETICULATION LAYOUT PLAN SHEET 2 OF 2

**REGISTERED SURVEYOR'S CERTIFICATION**

I, ANGELA MARGARET DAHN, hereby certify that the vertical and horizontal locations and dimensions shown on this plan are a true and correct record and were located by survey.

*Angela Dahn*  
 Registered Surveyor (sig) Reg. Surveyor No. 05428 Date: 19-08-2025

**ENGINEER'S CERTIFICATION**

I, GLENN AINSWORTH, hereby certify that the as-constructed details shown on this drawing are a true and accurate record of the construction works, in compliance with the approved drawings and approved design.

*Glenn Ainsworth*  
 RPEQ (signature) RPEQ No. 19204 Date: 25/09/25

**AS CONSTRUCTED**

**COORDINATE DATUM NOTE:**  
 HORIZONTAL COORDINATES(E,N) SUPPLIED ARE MAPPING GRID OF AUSTRALIA(MGA), ZONE 56 BASED ON THE UNIVERSAL TRANSVERSE MERCATOR PROJECTION AND THE GEOCENTRIC DATUM OF AUSTRALIA 2020.

**A1**

INDEX	DATE	REVISIONS	DRAWN	CHECKED	PASSED	INITIALS	DATE
3	23-09-2025	AS CONSTRUCTED - ENGINEER REQUESTED UPDATES	JC	LM	AD	DRAWN JC	23-09-2025
2	19-08-2025	AS CONSTRUCTED - MINOR AMENDS	JC	LM	AD	CHECKED LM	23-09-2025
1	06-08-2025	AS CONSTRUCTED	JC	LM	AD	PASSED AD	23-09-2025




**Unitywater**

UNITYWATER APPROVAL No.: APP-06699  
 RIVERBANK ESTATE, STAGE 2D  
 AS CONSTRUCTED  
 LOCALITY PLAN & INDEX OF DRAWINGS

SHEET 1 OF 5 SHEETS	SCALE 1:250
REVISION DATE 23-09-2025	REVISION 3
DISCIPLINE CODE C	
DRAWING NO. U-2024-5394-01	

PSM 191027  
 E: 495938.222  
 N: 7003053.734  
 RL: 8.767m  
 GDA2020

JOINS PLAN U-2024-5394-03

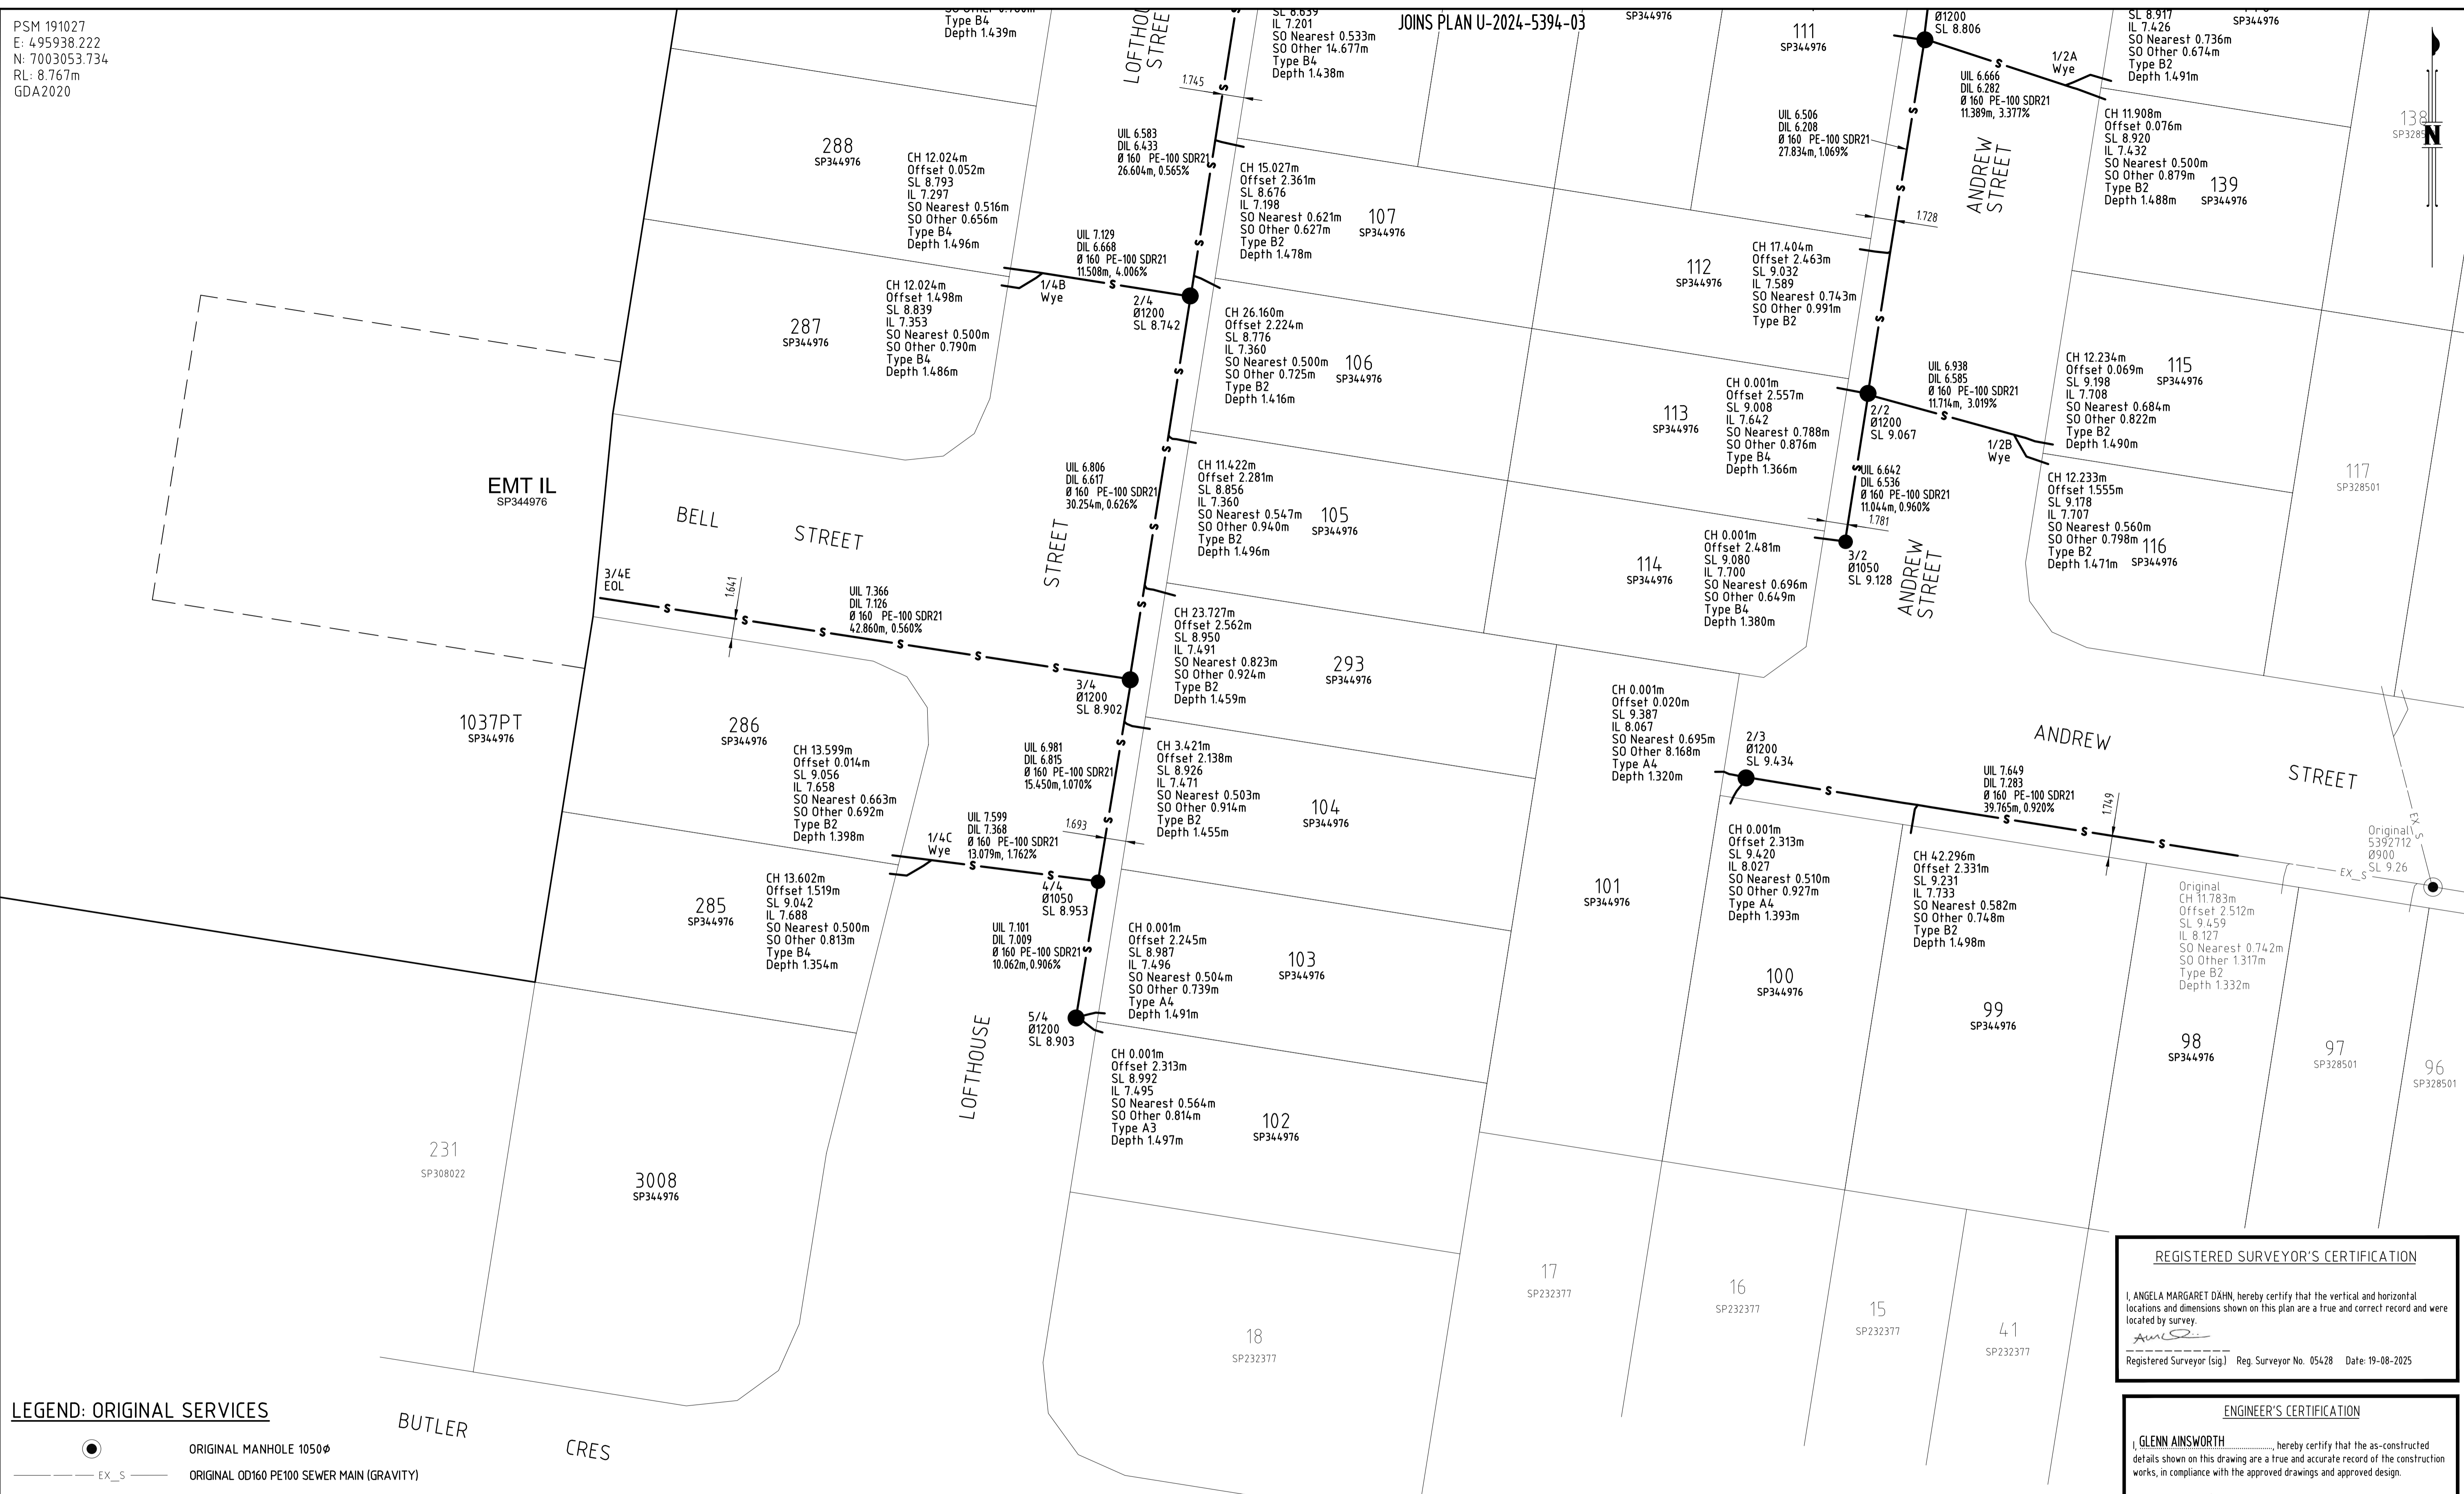

LEGEND: ORIGINAL SERVICES

- ORIGINAL MANHOLE 1050Ø
- ORIGINAL OD160 PE100 SEWER MAIN (GRAVITY)

LEGEND: NEW SERVICES

- MANHOLE (CAST-INSITU) (CALCAREOUS CONCRETE)
- OD160 PE100 SEWER MAIN (GRAVITY)



**REGISTERED SURVEYOR'S CERTIFICATION**  
 I, ANGELA MARGARET DAHN, hereby certify that the vertical and horizontal locations and dimensions shown on this plan are a true and correct record and were located by survey.  
 \_\_\_\_\_  
 Registered Surveyor (sig) Reg. Surveyor No. 05428 Date: 19-08-2025

**ENGINEER'S CERTIFICATION**  
 I, GLENN AINSWORTH, hereby certify that the as-constructed details shown on this drawing are a true and accurate record of the construction works, in compliance with the approved drawings and approved design.  
 \_\_\_\_\_  
 RPEQ (signature) RPEQ No. 19204 Date: 25/09/25

**AS CONSTRUCTED**

INDEX	DATE	REVISIONS	DRAWN	CHECKED	PASSED	INITIALS	DATE
A1	3	23-09-2025	AS CONSTRUCTED - ENGINEER REQUESTED UPDATES	JC	LM	AD	DRAWN JC 23-09-2025
	2	19-08-2025	AS CONSTRUCTED - MINOR AMENDS	JC	LM	AD	CHECKED LM 23-09-2025
	1	06-08-2025	AS CONSTRUCTED	JC	LM	AD	PASSED AD 23-09-2025





**Unitywater**  
 UNITYWATER APPROVAL No.: APP-06699  
 RIVERBANK ESTATE, STAGE 2D  
 AS CONSTRUCTED  
 SEWER RETICULATION LAYOUT PLAN SHEET 1 OF 2

SHEET 2 OF 5 SHEETS	SCALE 1:250
REVISION DATE 23-09-2025	REVISION 3
DISCIPLINE CODE C	
DRAWING NO. U-2024-5394-02	

PSM 191027  
 E: 495938.222  
 N: 7003053.734  
 RL: 8.767m  
 GDA2020

1037PT  
 SP344976

EMT IQ  
 SP344976

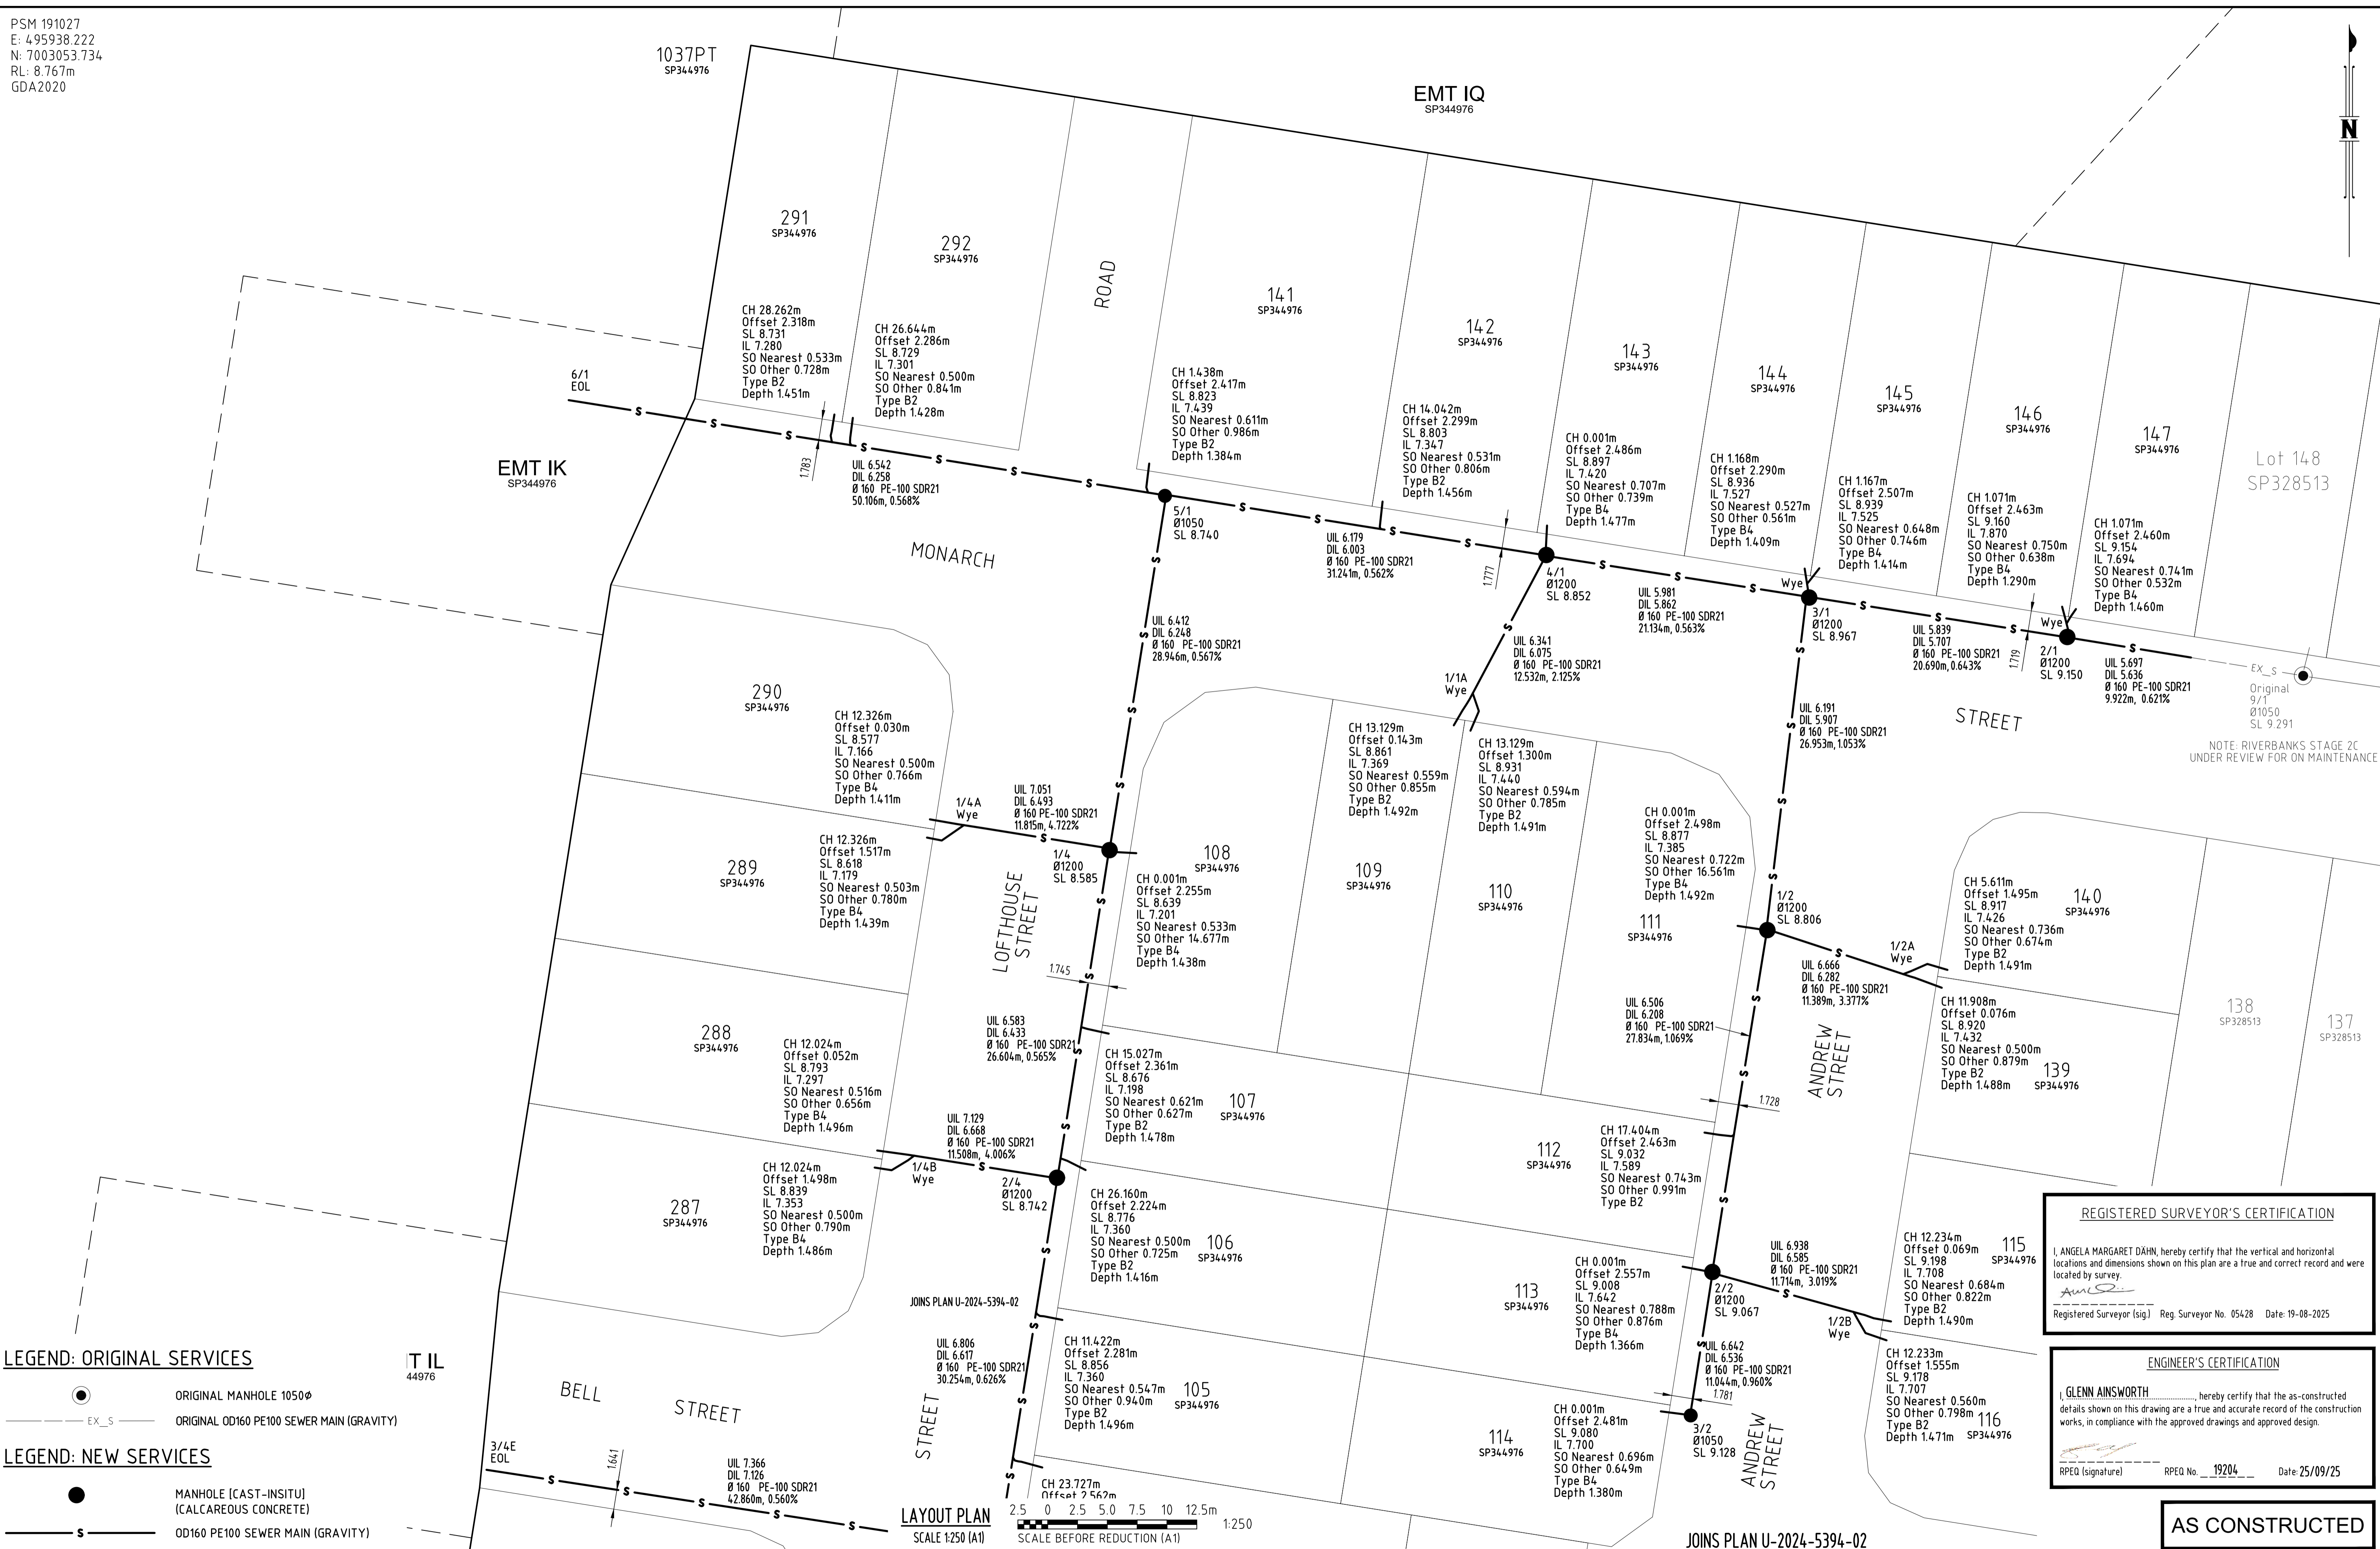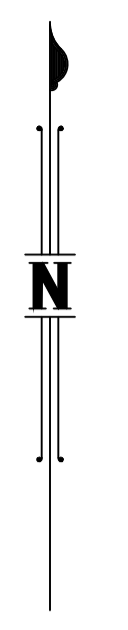

**LEGEND: ORIGINAL SERVICES**

- ORIGINAL MANHOLE 1050Ø
- EX\_S ORIGINAL OD160 PE100 SEWER MAIN (GRAVITY)

**LEGEND: NEW SERVICES**

- MANHOLE (CAST-INSITU) (CALCAREOUS CONCRETE)
- OD160 PE100 SEWER MAIN (GRAVITY)

IT IL  
 44976

LAYOUT PLAN  
 SCALE 1:250 (A1) SCALE BEFORE REDUCTION (A1) 1:250

**REGISTERED SURVEYOR'S CERTIFICATION**  
 I, ANGELA MARGARET DAHN, hereby certify that the vertical and horizontal locations and dimensions shown on this plan are a true and correct record and were located by survey.  
 Registered Surveyor (Sig) Reg. Surveyor No. 05428 Date: 19-08-2025

**ENGINEER'S CERTIFICATION**  
 I, GLENN AINSWORTH, hereby certify that the as-constructed details shown on this drawing are a true and accurate record of the construction works, in compliance with the approved drawings and approved design.  
 RPEQ (signature) RPEQ No. 19204 Date: 25/09/25

**AS CONSTRUCTED**

INDEX	DATE	REVISIONS	DRAWN	CHECKED	PASSED	INITIALS	DATE
3	23-09-2025	AS CONSTRUCTED - ENGINEER REQUESTED UPDATES	JC	LM	AD	DRAWN	JC 23-09-2025
2	19-08-2025	AS CONSTRUCTED - MINOR AMENDS	JC	LM	AD	CHECKED	LM 23-09-2025
1	06-08-2025	AS CONSTRUCTED	JC	LM	AD	PASSED	AD 23-09-2025




**Unitywater**  
 UNITYWATER APPROVAL No.: APP-06699  
 RIVERBANK ESTATE, STAGE 20  
 AS CONSTRUCTED  
 SEWER RETICULATION LAYOUT PLAN SHEET 2 OF 2

SHEET 3 OF 5 SHEETS	SCALE 1:250
REVISION DATE 23-09-2025	REVISION 3
DISCIPLINE CODE C	
DRAWING NO. U-2024-5394-03	

PSM 191027  
 E: 495938.222  
 N: 7003053.734  
 RL: 8.767m  
 GDA2020

JOINS PLAN U-2024-5394-05

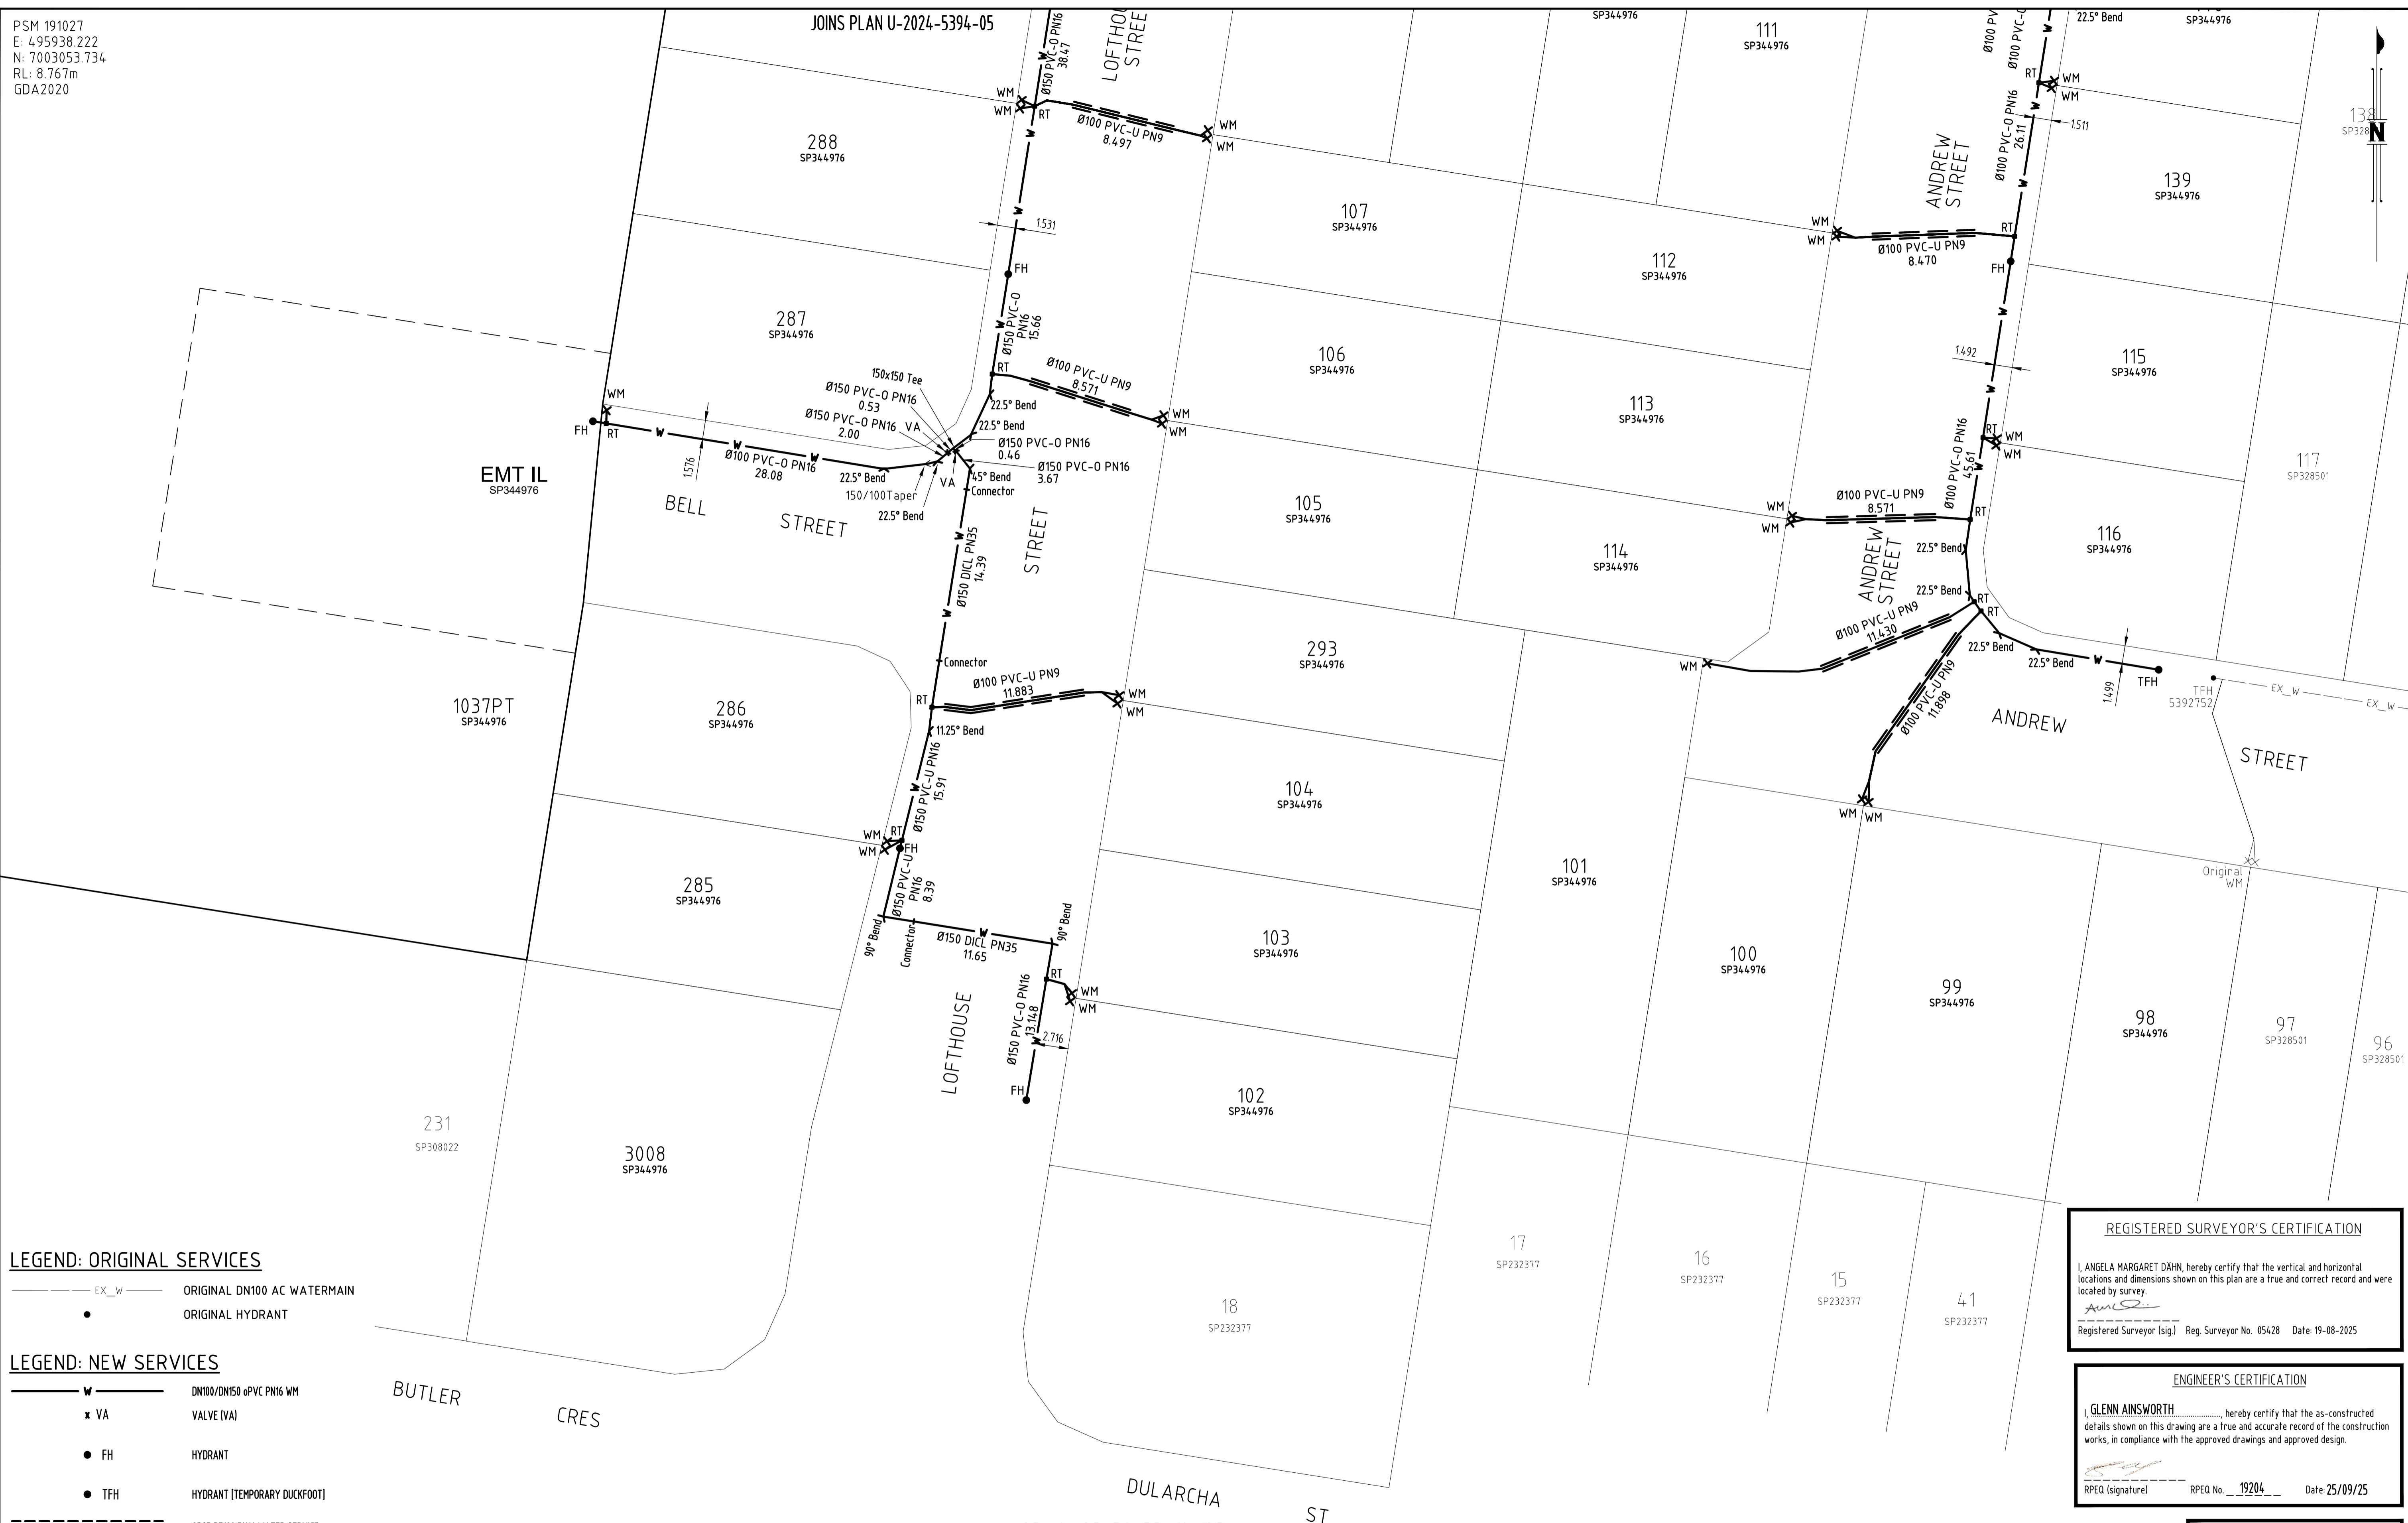

**LEGEND: ORIGINAL SERVICES**

- EX\_W — ORIGINAL DN100 AC WATERMAIN
- ORIGINAL HYDRANT

**LEGEND: NEW SERVICES**

- DN100/DN150 oPVC PN16 WM
- VA VALVE (VA)
- FH HYDRANT
- TFH HYDRANT (TEMPORARY DUCKFOOT)
- OD25 PE100 PN16 WATER SERVICE
- WATER METER

LAYOUT PLAN  
 SCALE 1:250 (A1)  
 SCALE BEFORE REDUCTION (A1) 1:250

**REGISTERED SURVEYOR'S CERTIFICATION**  
 I, ANGELA MARGARET DAHN, hereby certify that the vertical and horizontal locations and dimensions shown on this plan are a true and correct record and were located by survey.  
 Registered Surveyor (Sig) Reg. Surveyor No. 05428 Date: 19-08-2025

**ENGINEER'S CERTIFICATION**  
 I, GLENN AINSWORTH, hereby certify that the as-constructed details shown on this drawing are a true and accurate record of the construction works, in compliance with the approved drawings and approved design.  
 RPEQ (signature) RPEQ No. 19204 Date: 25/09/25

**AS CONSTRUCTED**

A1	3	23-09-2025	AS CONSTRUCTED - ENGINEER REQUESTED UPDATES	JC	LM	AD	DRAWN	JC	23-09-2025
	2	19-08-2025	AS CONSTRUCTED - MINOR AMENDS	JC	LM	AD	CHECKED	LM	23-09-2025
	1	06-08-2025	AS CONSTRUCTED	JC	LM	AD	PASSED	AD	23-09-2025
	INDEX	DATE	REVISIONS	DRAWN	CHECKED	PASSED	INITIALS	DATE	



**Unitywater**



UNITYWATER APPROVAL No.: APP-06699  
 RIVERBANK ESTATE, STAGE 2D  
 AS CONSTRUCTED  
 WATER RETICULATION LAYOUT PLAN SHEET 1 OF 2

SHEET 4 OF 5 SHEETS	SCALE 1:250
REVISION DATE 23-09-2025	REVISION 3
DISCIPLINE CODE C	
DRAWING NO. U-2024-5394-04	

PSM 191027  
 E: 495938.222  
 N: 7003053.734  
 RL: 8.767m  
 GDA2020

1037PT  
 SP344976

EMT IQ  
 SP344976

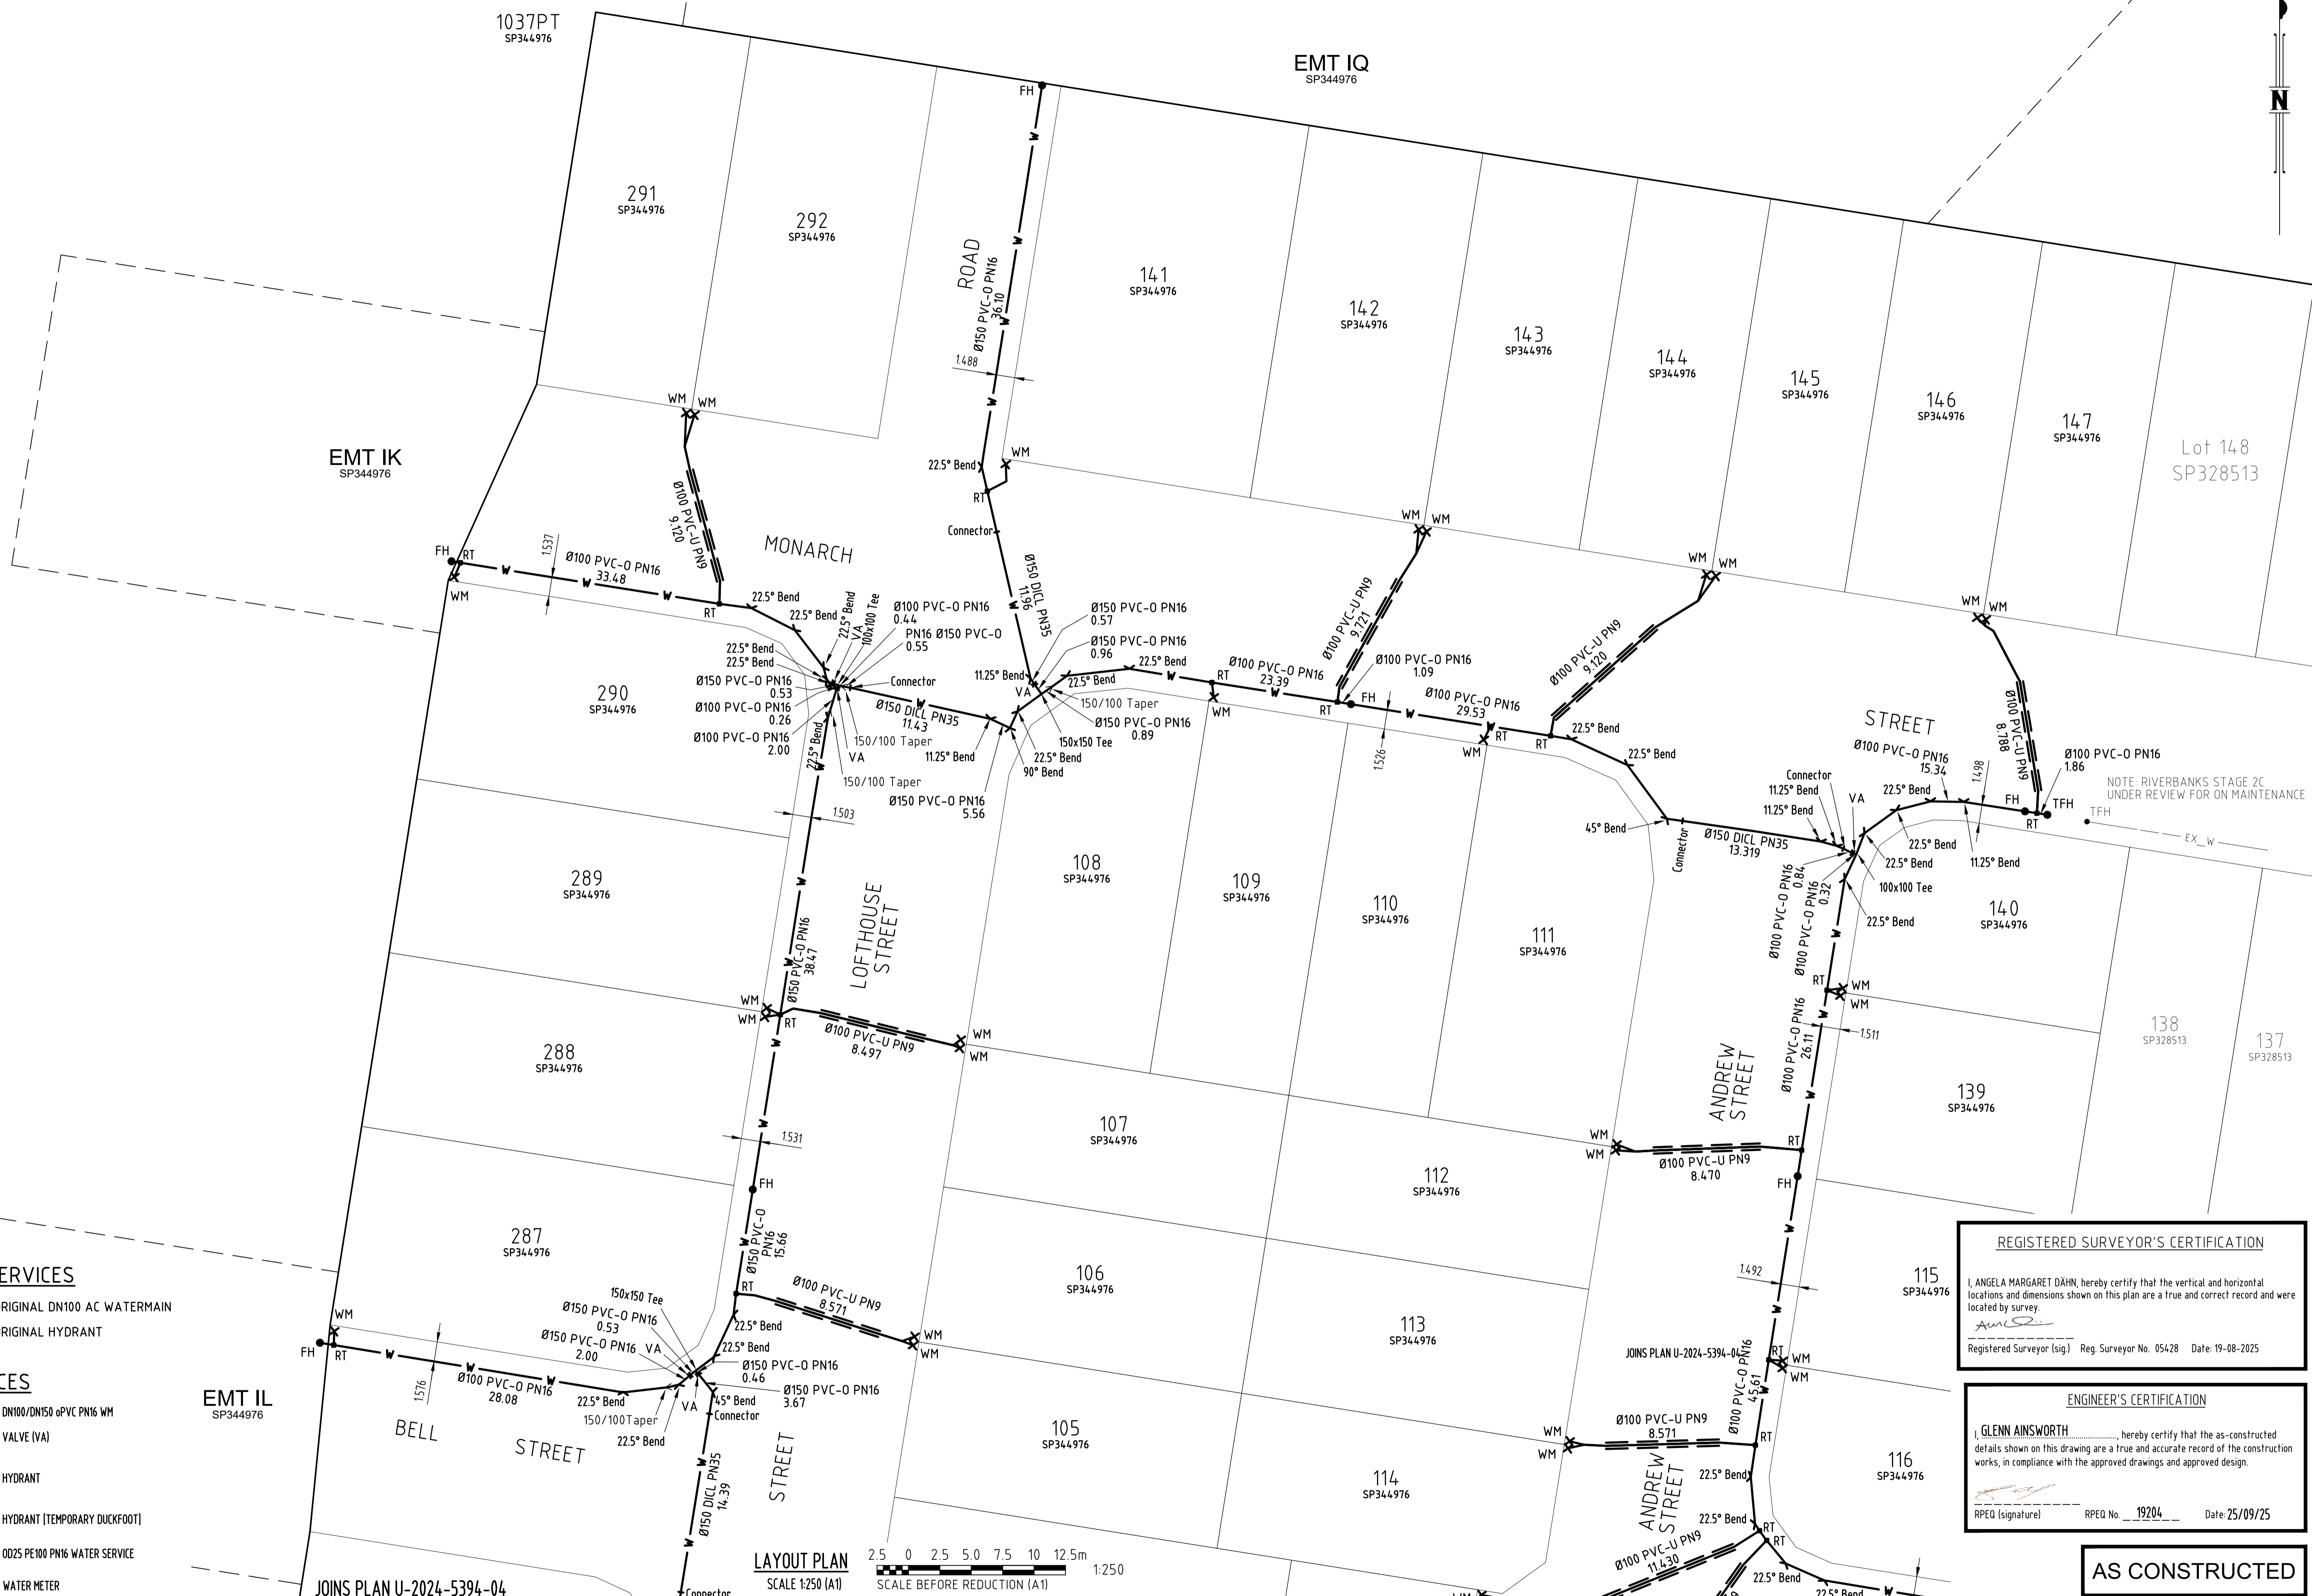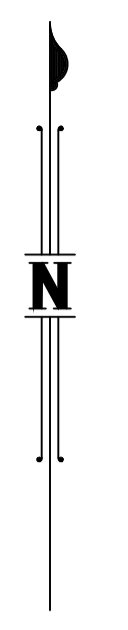

**LEGEND: ORIGINAL SERVICES**

- EX\_W — ORIGINAL DN100 AC WATERMAIN
- ORIGINAL HYDRANT

**LEGEND: NEW SERVICES**

- DN100/DN150 oPVC PN16 WM
- VA VALVE (VA)
- FH HYDRANT
- TFH HYDRANT (TEMPORARY DUCKFOOT)
- 0025 PE100 PN16 WATER SERVICE
- WATER METER

EMT IL  
 SP344976

JOINS PLAN U-2024-5394-04

LAYOUT PLAN  
 SCALE 1:250 (A1)  
 SCALE BEFORE REDUCTION (A1) 1:250

**REGISTERED SURVEYOR'S CERTIFICATION**  
 I, ANGELA MARGARET DAHN, hereby certify that the vertical and horizontal locations and dimensions shown on this plan are a true and correct record and were located by survey.  
 Registered Surveyor (sig) Reg. Surveyor No. 05428 Date: 19-08-2025

**ENGINEER'S CERTIFICATION**  
 I, GLENN AINSWORTH, hereby certify that the as-constructed details shown on this drawing are a true and accurate record of the construction works, in compliance with the approved drawings and approved design.  
 RPEQ (signature) RPEQ No. 19204 Date: 25/09/25

**AS CONSTRUCTED**

A1	3	23-09-2025	AS CONSTRUCTED - ENGINEER REQUESTED UPDATES	JC	LM	AD	DRAWN	JC	23-09-2025
	2	19-08-2025	AS CONSTRUCTED - MINOR AMENDS	JC	LM	AD	CHECKED	LM	23-09-2025
	1	06-08-2025	AS CONSTRUCTED	JC	LM	AD	PASSED	AD	23-09-2025
	INDEX	DATE	REVISIONS	DRAWN	CHECKED	PASSED	INITIALS	DATE	



**Unitywater**  
 UNITYWATER APPROVAL No.: APP-06699  
 RIVERBANK ESTATE, STAGE 20  
 AS CONSTRUCTED  
 WATER RETICULATION LAYOUT PLAN SHEET 2 OF 2

SHEET 5 OF 5 SHEETS	SCALE 1:250
REVISION DATE 23-09-2025	REVISION 3
DISCIPLINE CODE C	
DRAWING NO. U-2024-5394-05	