

- LEGEND:**
- SEWER MAIN NON PRESSURE
  - EXISTING SEWER MAIN
  - HOUSE CONNECTION
  - SEWER MAINTENANCE HOLE
  - SEWER MAINTENANCE SHAFT
  - SEWER BEND
  - SEWER WYE BRANCH
  - SEWER TAPER
  - SEWER VALVE
  - SEWER END OF LINE
- NOTE:**
- ALL SEWER MAINS DN150 PVC-U CLASS SN8 U.N.O.
  - ALL MAINTENANCE HOLES (MH) ARE CONCRETE U.N.O. Ø AS LABELLED
  - ALL MAINTENANCE SHAFTS (MS) 600Ø

**ENGINEER'S CERTIFICATION**

I, James Vonnhoff, hereby certify that:

- The information contained in this drawing / document is generally in compliance with approved drawings and design.
- The new sewerage works defined by this drawing have been designed and constructed generally in accordance with the SED code.
- This represents an accurate record of as-constructed works
- I accept the information contained in this drawing / document.

RPEQ (signature) RPEQ No. 32647 Date: 12/06/2025

**Surveyors As Constructed Certification**

I, Angela Maragaret Dahn (surveyors name) 05428 (surveyors registration number) being a certified/registered surveyor and duly authorised representative of: THEREFOR GROUP (consulting firm or company name)

Hereby:

- certify the information contained in this drawing is an accurate as constructed representation of the works
- accept responsibility for the as constructed survey information contained in this drawing
- acknowledge the as constructed survey information contained in the drawing may be relied on by council and others

Certification of Stage: 4A by [Signature] On 09/05/2025 (stage number) (signature) (date)

For: THEREFOR GROUP (consulting firm or company name)

Note: Where consulting firms, company name or stage numbers do not apply, complete with N/A for not applicable

**COORDINATE DATUM NOTE:**  
 HORIZONTAL COORDINATES(E,N) SUPPLIED ARE MAPPING GRID OF AUSTRALIA(MGA), ZONE 56 BASED ON THE UNIVERSAL TRANSVERSE MERCATOR PROJECTION AND THE GEOCENTRIC DATUM OF AUSTRALIA 1994.

**AS CONSTRUCTED**


A1	INDEX	DATE	AS CONSTRUCTED	REVISIONS	DRAWN	CHECKED	PASSED	INITIALS	DATE
	A	09/05/2025	AS CONSTRUCTED		DM	A Dahn	A Dahn		09/05/2025

DRAWN	DM	09/05/2025
CHECKED	AMD	09/05/2025
PASSED	AMD	09/05/2025

**Unitywater**

2019013911S11  
 Village Green - Stage 4A  
 College Drive Palmview  
 Sewer Reticulation

SHEET 2 OF 6 SHEETS	SCALE 1:250
REVISION DATE 09/05/2025	REVISION A
DISCIPLINE CODE C	
DRAWING NO. U-2024-5342 SE01	

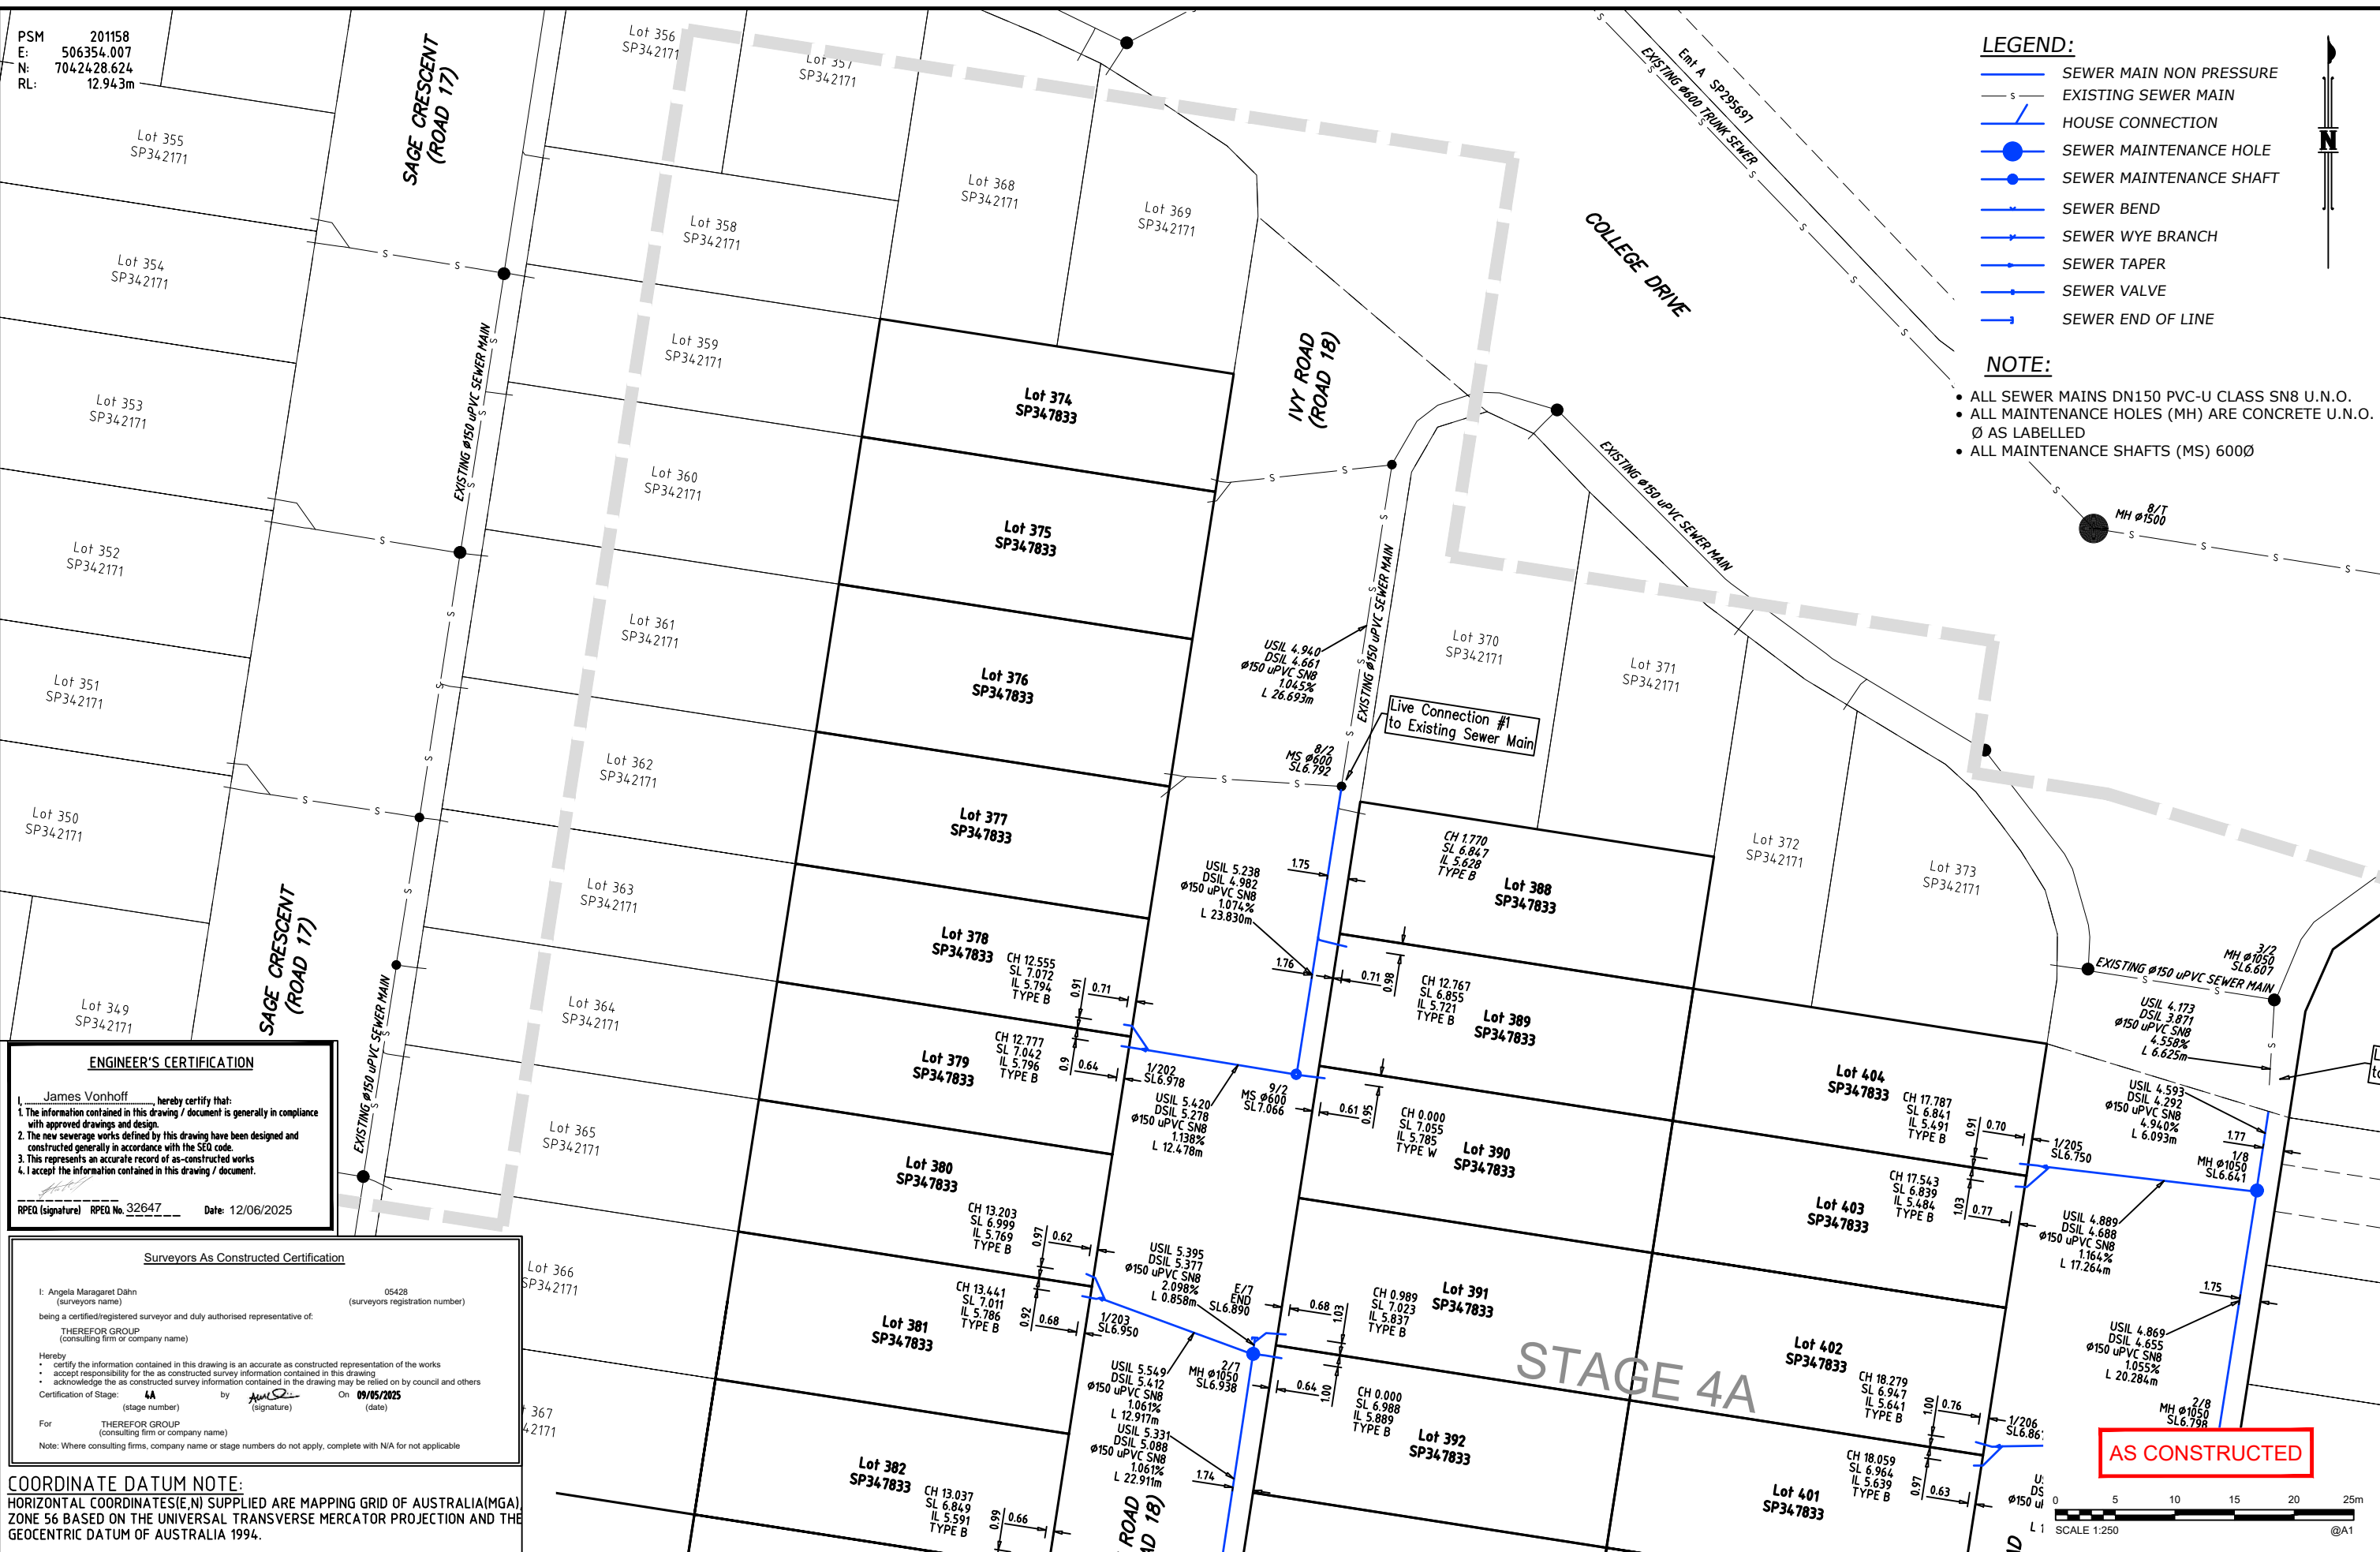

- LEGEND:**
- SEWER MAIN NON PRESSURE
  - EXISTING SEWER MAIN
  - HOUSE CONNECTION
  - SEWER MAINTENANCE HOLE
  - SEWER MAINTENANCE SHAFT
  - SEWER BEND
  - SEWER WYE BRANCH
  - SEWER TAPER
  - SEWER VALVE
  - SEWER END OF LINE

- NOTE:**
- ALL SEWER MAINS DN150 PVC-U CLASS SN8 U.N.O.
  - ALL MAINTENANCE HOLES (MH) ARE CONCRETE U.N.O. Ø AS LABELLED
  - ALL MAINTENANCE SHAFTS (MS) 600Ø

PSM 201158  
 E: 506354.007  
 N: 7042428.624  
 RL: 12.943m

**ENGINEER'S CERTIFICATION**  
 I, James Vonhoff, hereby certify that:  
 1. The information contained in this drawing / document is generally in compliance with approved drawings and design.  
 2. The new sewerage works defined by this drawing have been designed and constructed generally in accordance with the SED code.  
 3. This represents an accurate record of as-constructed works  
 4. I accept the information contained in this drawing / document.  
 RPED (signature) RPED No. 32647 Date: 12/06/2025

**Surveyors As Constructed Certification**  
 I, Angela Maragaret Dahn (surveyors name) 05428 (surveyors registration number)  
 being a certified/registered surveyor and duly authorised representative of:  
 THEREFOR GROUP (consulting firm or company name)  
 Hereby:  
 • certify the information contained in this drawing is an accurate as constructed representation of the works  
 • accept responsibility for the as constructed survey information contained in this drawing  
 • acknowledge the as constructed survey information contained in the drawing may be relied on by council and others  
 Certification of Stage: 4A by [Signature] On 09/05/2025 (stage number) (signature) (date)  
 For THEREFOR GROUP (consulting firm or company name)  
 Note: Where consulting firms, company name or stage numbers do not apply, complete with N/A for not applicable

**COORDINATE DATUM NOTE:**  
 HORIZONTAL COORDINATES(E,N) SUPPLIED ARE MAPPING GRID OF AUSTRALIA(MGA) ZONE 56 BASED ON THE UNIVERSAL TRANSVERSE MERCATOR PROJECTION AND THE GEOCENTRIC DATUM OF AUSTRALIA 1994.


A1	INDEX	DATE	AS CONSTRUCTED	REVISIONS	DRAWN	CHECKED	PASSED	INITIALS	DATE
	A	09/05/2025	AS CONSTRUCTED		DM	A Dahn	A Dahn		09/05/2025

therefor GROUP logo

Unitywater logo

Unitywater  
 2019013911S11  
 Village Green - Stage 4A  
 College Drive Palmview  
 Sewer Reticulation

SHEET 3 OF 6 SHEETS	SCALE 1:250
REVISION DATE 09/05/2025	REVISION A
DISCIPLINE CODE C	
DRAWING NO. U-2024-5342 SE02	

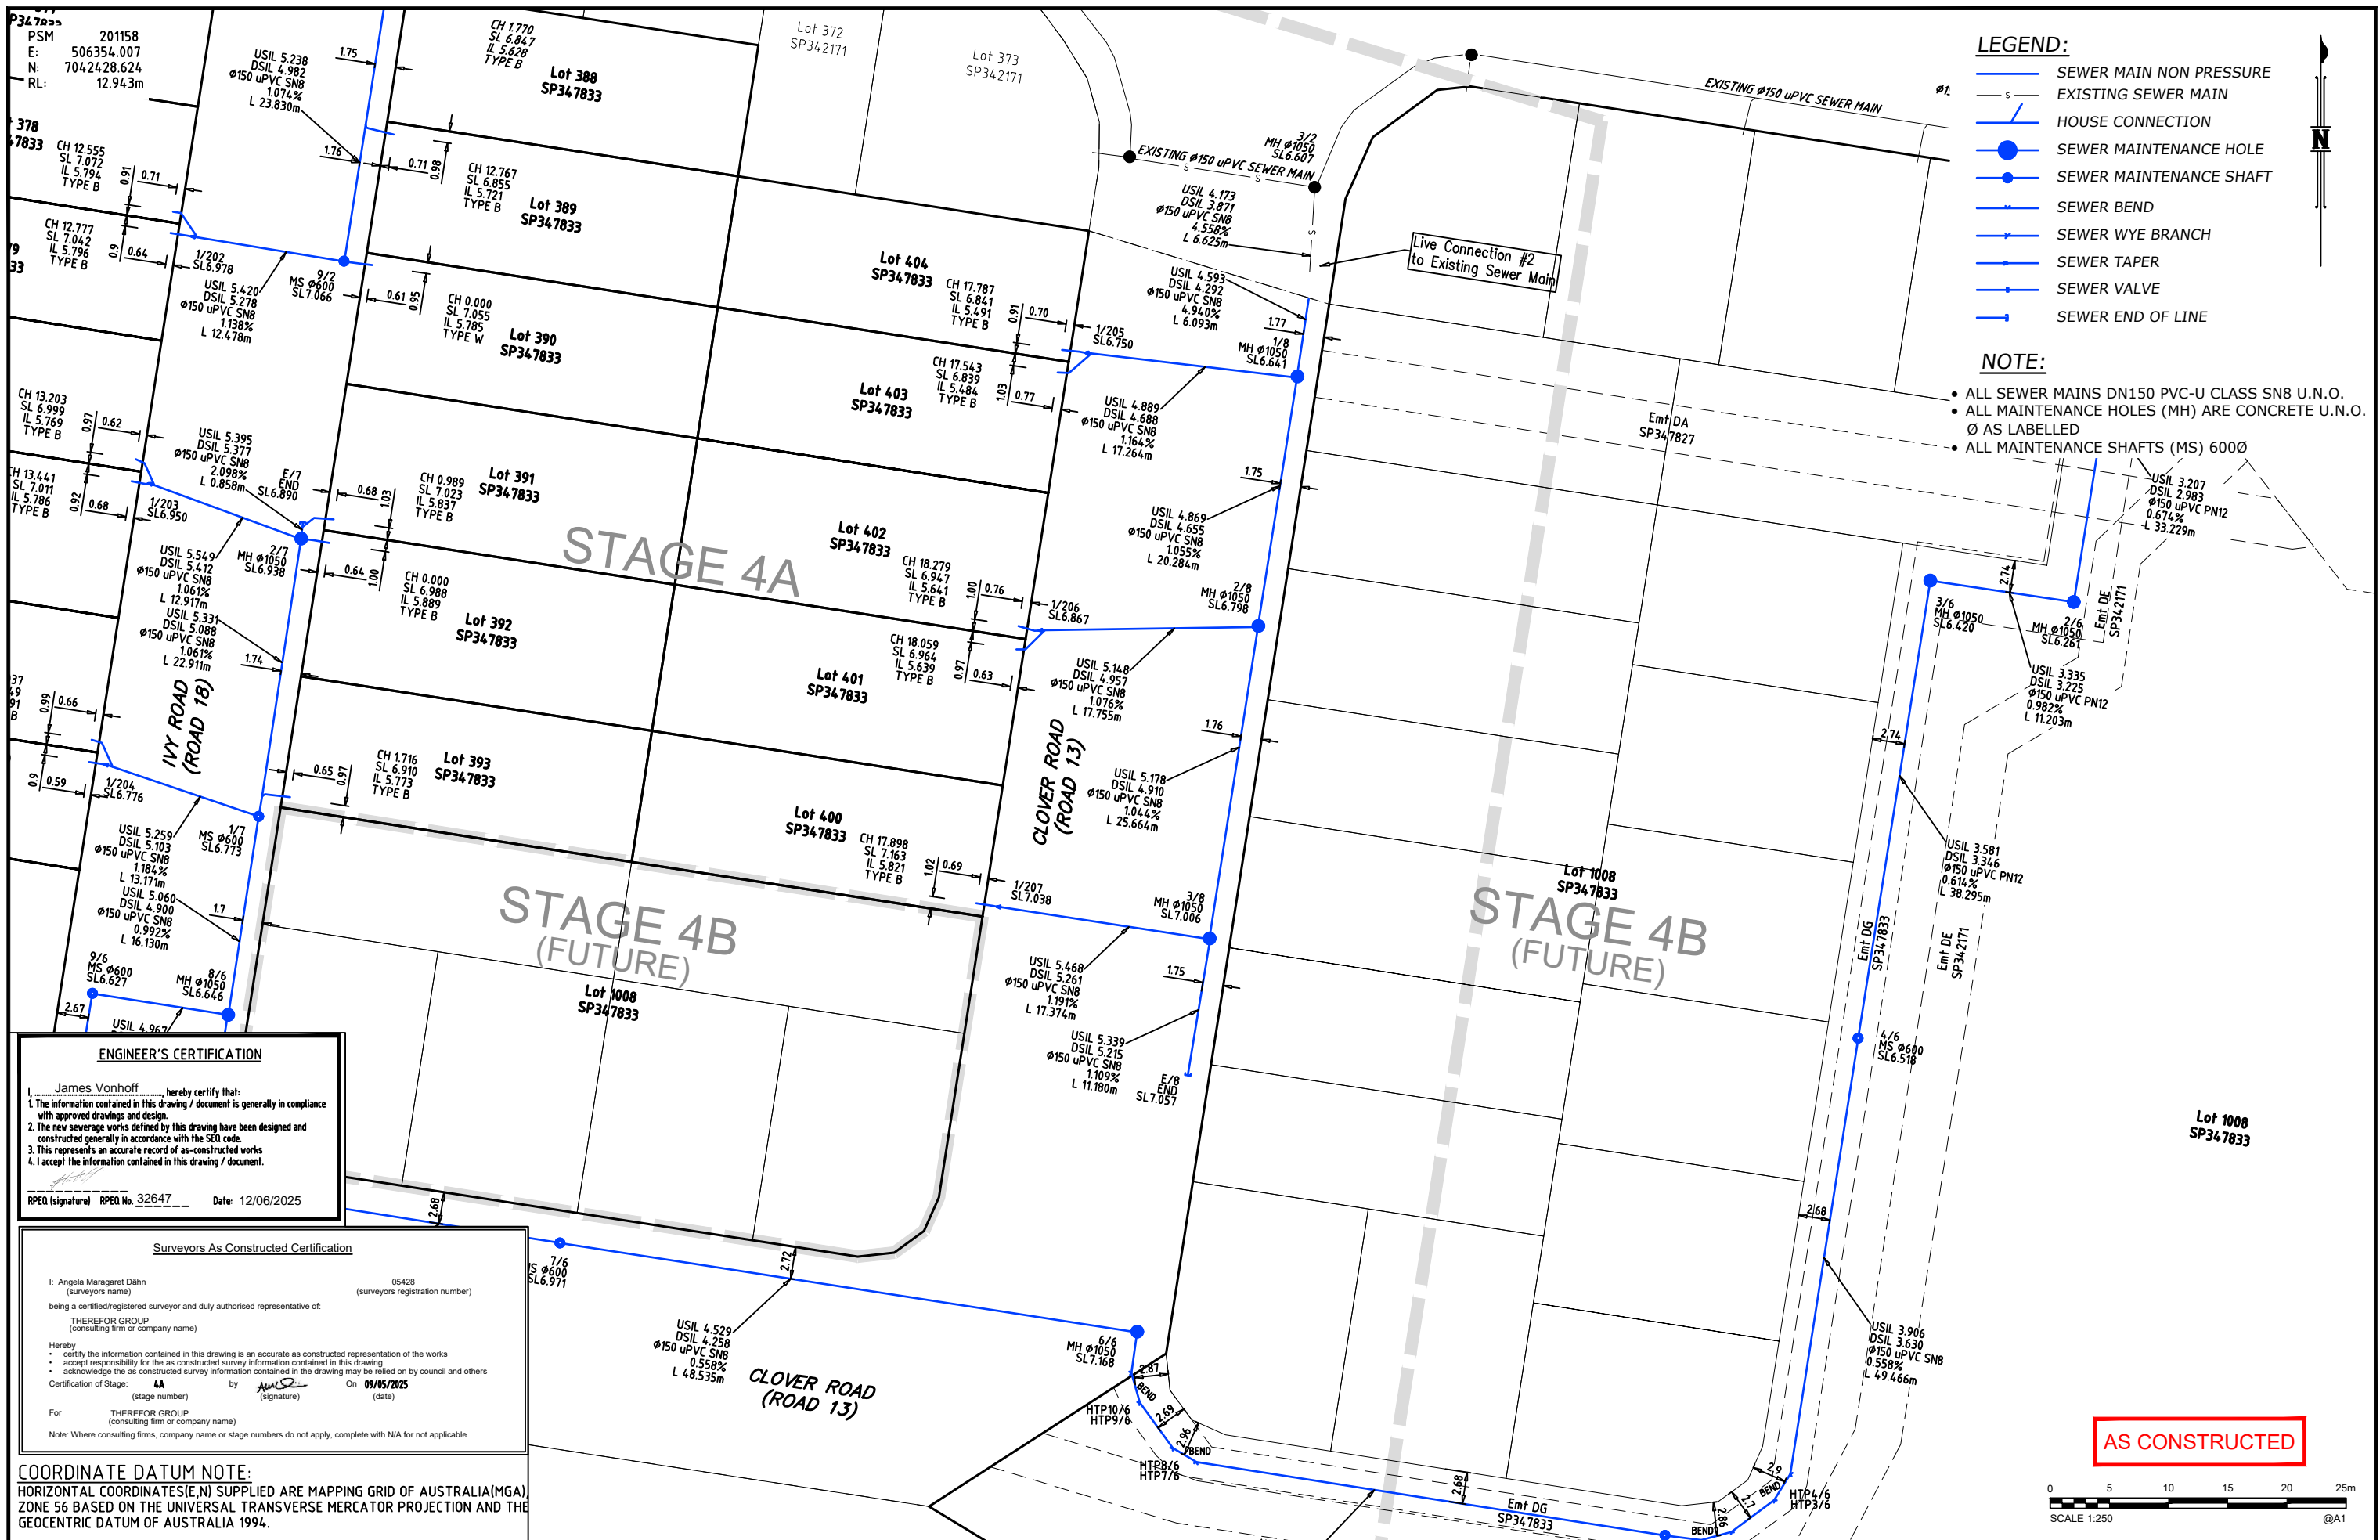

- LEGEND:**
- SEWER MAIN NON PRESSURE
  - EXISTING SEWER MAIN
  - HOUSE CONNECTION
  - SEWER MAINTENANCE HOLE
  - SEWER MAINTENANCE SHAFT
  - SEWER BEND
  - SEWER WYE BRANCH
  - SEWER TAPER
  - SEWER VALVE
  - SEWER END OF LINE
- NOTE:**
- ALL SEWER MAINS DN150 PVC-U CLASS SN8 U.N.O.
  - ALL MAINTENANCE HOLES (MH) ARE CONCRETE U.N.O. Ø AS LABELLED
  - ALL MAINTENANCE SHAFTS (MS) 600Ø

**ENGINEER'S CERTIFICATION**

I, James Vonhoff, hereby certify that:

- The information contained in this drawing / document is generally in compliance with approved drawings and design.
- The new sewerage works defined by this drawing have been designed and constructed generally in accordance with the SED code.
- This represents an accurate record of as-constructed works.
- I accept the information contained in this drawing / document.

RPEQ (signature) RPEQ No. 32647 Date: 12/06/2025

**Surveyors As Constructed Certification**

I, Angela Maragaret Dahn (surveyors name) 05428 (surveyors registration number) being a certified/registered surveyor and duly authorised representative of: THEREFOR GROUP (consulting firm or company name)

Herby:

- certify the information contained in this drawing is an accurate as constructed representation of the works
- accept responsibility for the as constructed survey information contained in this drawing
- acknowledge the as constructed survey information contained in the drawing may be relied on by council and others


Certification of Stage: 4A by [Signature] On 09/05/2025 (stage number) (signature) (date)

For THEREFOR GROUP (consulting firm or company name)

Note: Where consulting firms, company name or stage numbers do not apply, complete with N/A for not applicable

**COORDINATE DATUM NOTE:**  
 HORIZONTAL COORDINATES(E,N) SUPPLIED ARE MAPPING GRID OF AUSTRALIA(MGA) ZONE 56 BASED ON THE UNIVERSAL TRANSVERSE MERCATOR PROJECTION AND THE GEOCENTRIC DATUM OF AUSTRALIA 1994.


**AS CONSTRUCTED**

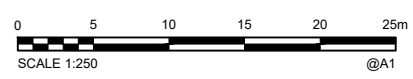

A1	INDEX	DATE	AS CONSTRUCTED	REVISIONS	DRAWN	CHECKED	PASSED	INITIALS	DATE
	A	09/05/2025	AS CONSTRUCTED		DM	A Dahn	A Dahn		09/05/2025

DRAWN DM 09/05/2025 CHECKED AMD 09/05/2025 PASSED AMD 09/05/2025	2019013911511 Village Green - Stage 4A College Drive Palmview Sewer Reticulation

<b>Unitywater</b> SHEET 4 OF 6 SHEETS REVISION DATE 09/05/2025 DISCIPLINE CODE C DRAWING NO. U-2024-5342 SE03	SCALE 1:250 REVISION A
---	---------------------------

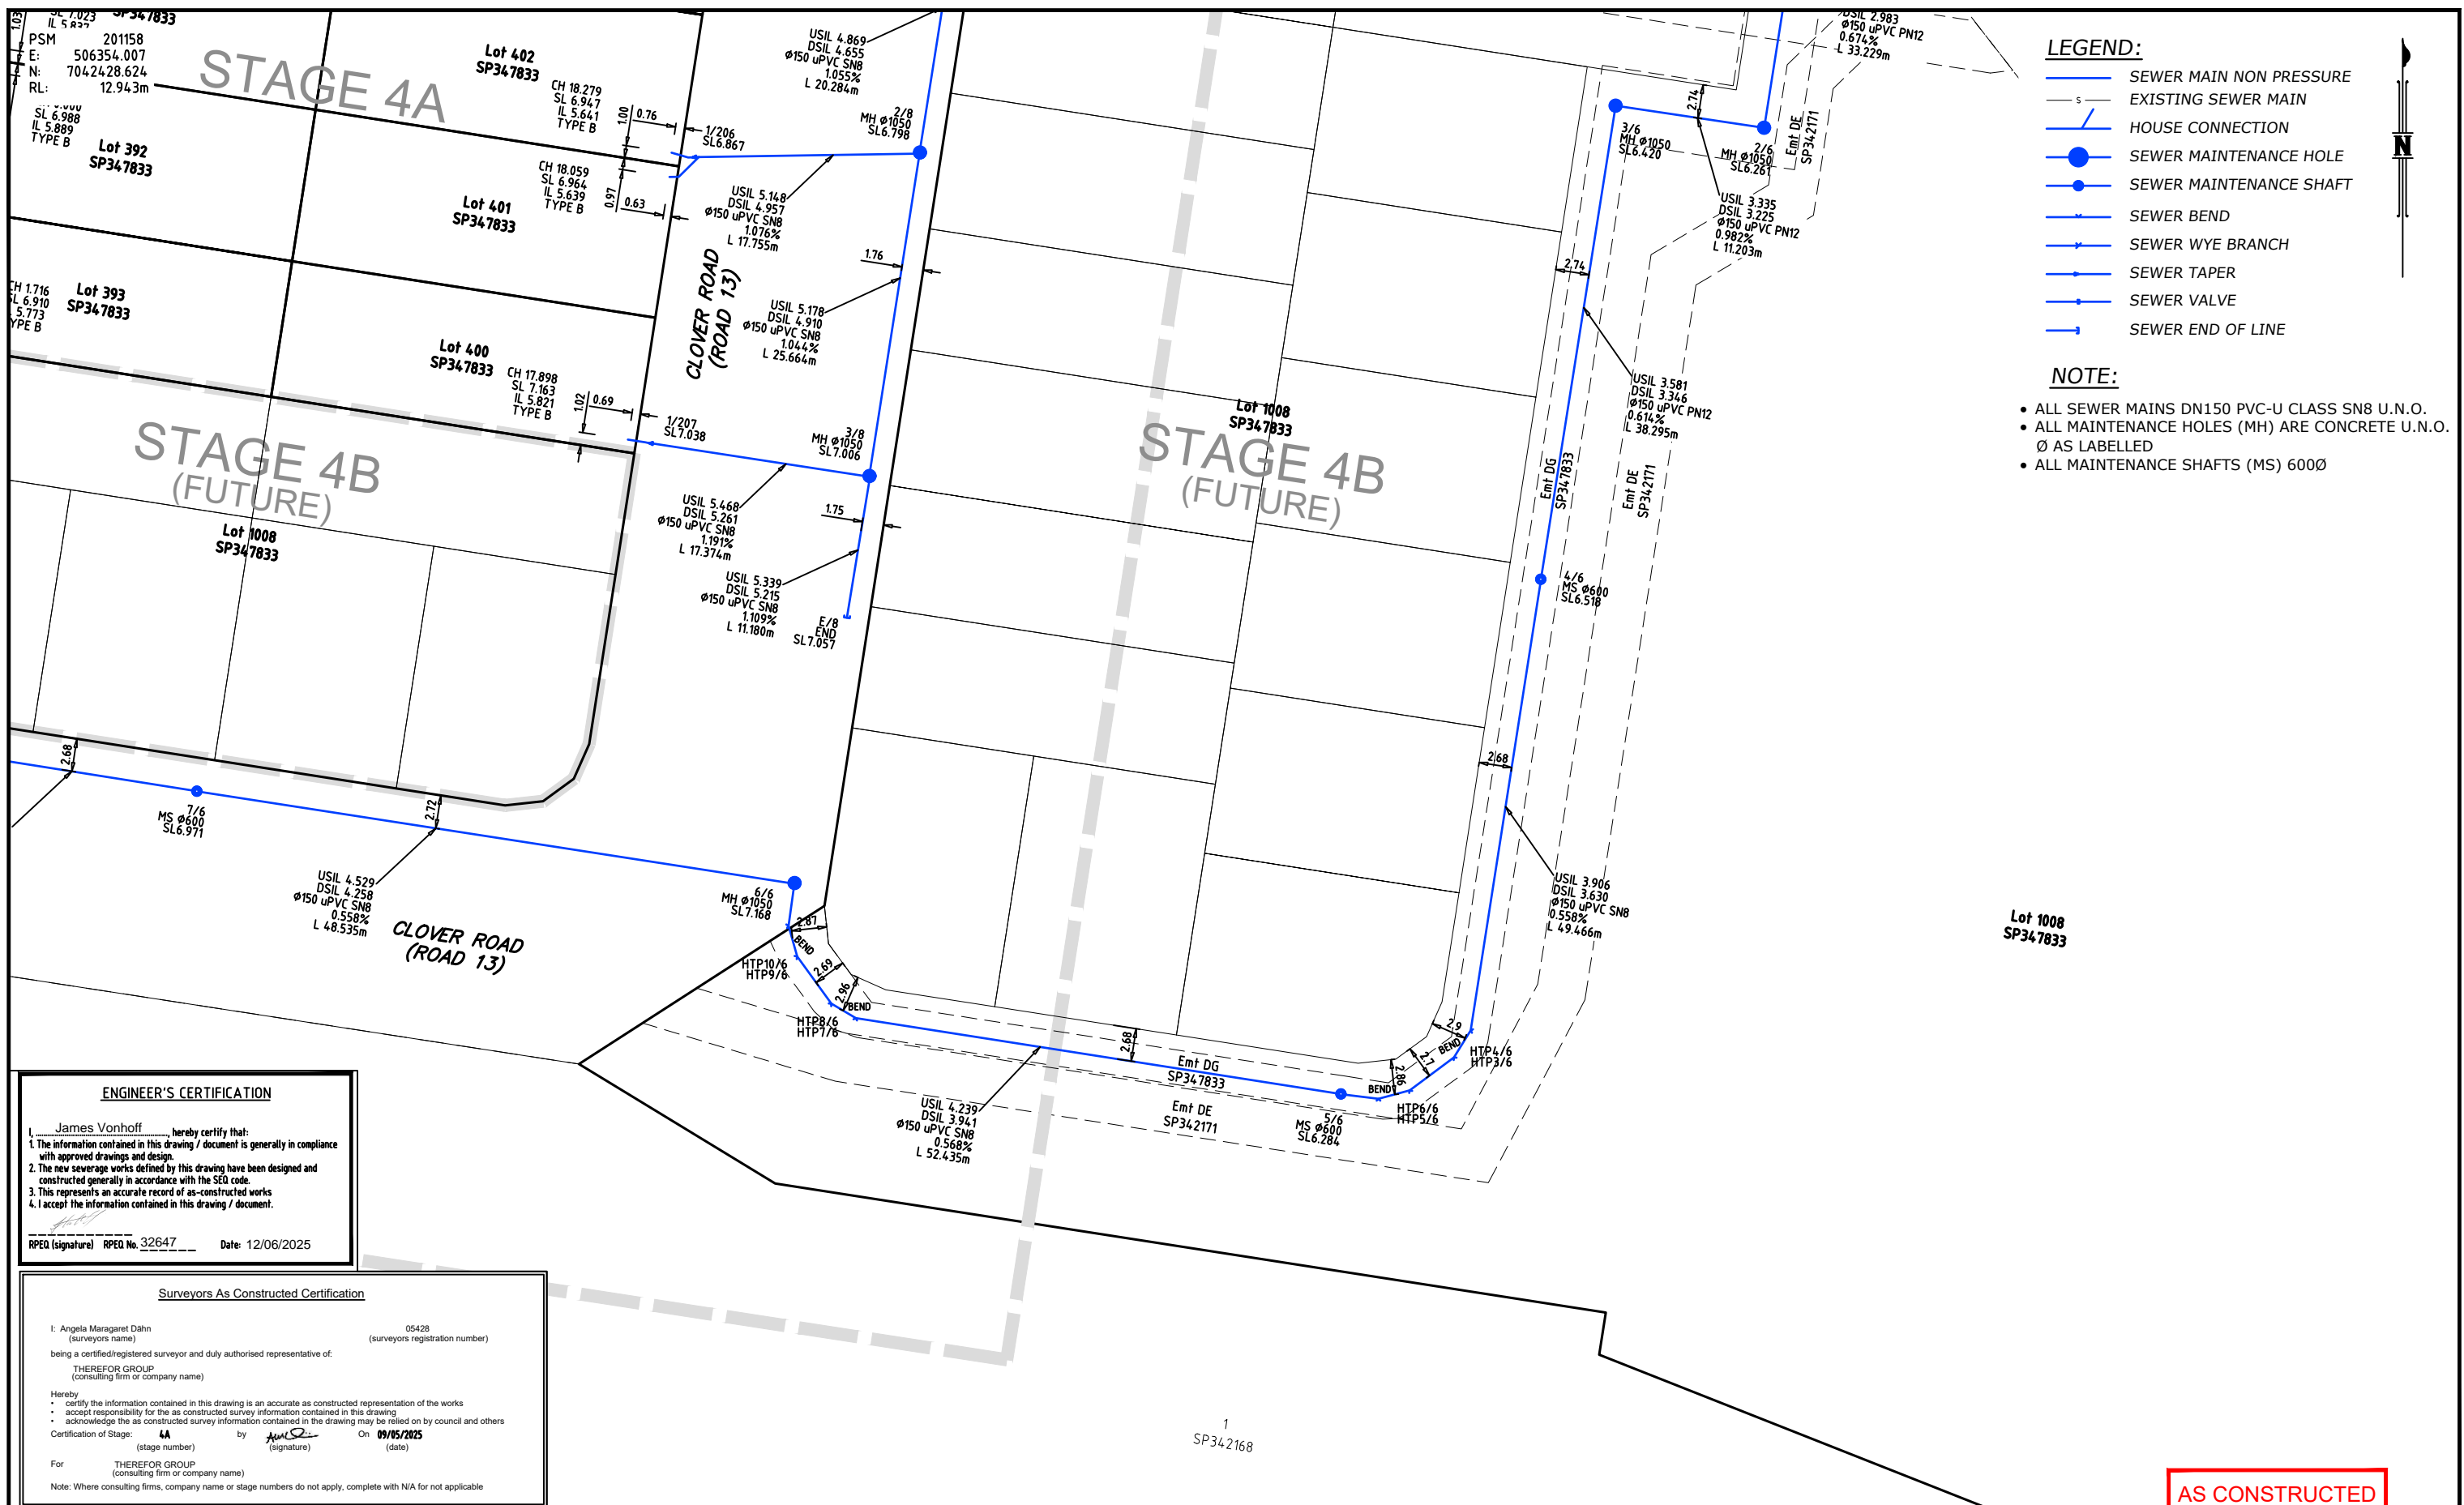

- LEGEND:**
- SEWER MAIN NON PRESSURE
  - EXISTING SEWER MAIN
  - HOUSE CONNECTION
  - SEWER MAINTENANCE HOLE
  - SEWER MAINTENANCE SHAFT
  - SEWER BEND
  - SEWER WYE BRANCH
  - SEWER TAPER
  - SEWER VALVE
  - SEWER END OF LINE

- NOTE:**
- ALL SEWER MAINS DN150 PVC-U CLASS SN8 U.N.O.
  - ALL MAINTENANCE HOLES (MH) ARE CONCRETE U.N.O. Ø AS LABELLED
  - ALL MAINTENANCE SHAFTS (MS) 600Ø

**ENGINEER'S CERTIFICATION**

I, James Vonhoff, hereby certify that:

1. The information contained in this drawing / document is generally in compliance with approved drawings and design.
2. The new sewerage works defined by this drawing have been designed and constructed generally in accordance with the SED code.
3. This represents an accurate record of as-constructed works
4. I accept the information contained in this drawing / document.

RPEQ (signature) RPEQ No. 32647 Date: 12/06/2025

**Surveyors As Constructed Certification**

I, Angela Maragaret Dahn (surveyors name) 05428 (surveyors registration number)  
 being a certified/registered surveyor and duly authorised representative of:  
 THEREFOR GROUP (consulting firm or company name)

Hereby:


- certify the information contained in this drawing is an accurate as constructed representation of the works
- accept responsibility for the as constructed survey information contained in this drawing
- acknowledge the as constructed survey information contained in the drawing may be relied on by council and others

Certification of Stage: 4A by [Signature] On 09/05/2025  
 (stage number) (signature) (date)

For  
 THEREFOR GROUP (consulting firm or company name)  
 Note: Where consulting firms, company name or stage numbers do not apply, complete with N/A for not applicable

**COORDINATE DATUM NOTE:**  
 HORIZONTAL COORDINATES(E,N) SUPPLIED ARE MAPPING GRID OF AUSTRALIA(MGA) ZONE 56 BASED ON THE UNIVERSAL TRANSVERSE MERCATOR PROJECTION AND THE GEOCENTRIC DATUM OF AUSTRALIA 1994.

**AS CONSTRUCTED**

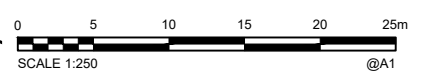

A1	INDEX	DATE	AS CONSTRUCTED	REVISIONS	DRAWN	CHECKED	PASSED	DRAWN	CHECKED	PASSED	INITIALS	DATE
	A	09/05/2025	AS CONSTRUCTED		DM	A Dahn	A Dahn					

DRAWN	DM	09/05/2025
CHECKED	AMD	09/05/2025
PASSED	AMD	09/05/2025

**Unitywater**

2019013911S11  
 Village Green - Stage 4A  
 College Drive Palmview  
 Sewer Reticulation

SHEET 5 OF 6 SHEETS	SCALE 1:250
REVISION DATE 09/05/2025	REVISION A
DISCIPLINE CODE C	
DRAWING NO. U-2024-5342 SE04	

