

- LEGEND:**
- 150 PVC-O CLASS PN16
 - EXISTING WATER MAIN
 - DI CL WATERMAIN
 - READY TAP HOUSE CONNECTION
 - FH
 - SV
 - SLUDGE VALVE
 - TAPER
 - TAPER/REDUCER
 - BEND
 - BEND
 - EOL
 - END CAP
 - WATER SERVICE PIPE
 - WATER SERVICE METER
 - WATER SERVICE CONDUIT 100Ø PVC-O

PSM 201158
 E: 506354.007
 N: 7042428.624
 RL: 12.943m

ENGINEER'S CERTIFICATION

I, James Vonhoff, hereby certify that:

- The information contained in this drawing / document is generally in compliance with approved drawings and design.
- The new sewerage works defined by this drawing have been designed and constructed generally in accordance with the SED code.
- This represents an accurate record of as-constructed works.
- I accept the information contained in this drawing / document.

RPEQ (signature) RPEQ No. 32647 Date: 12/06/2025

Surveyors As Constructed Certification

I, Angela Maragaret Dahn (surveyors name) 05428 (surveyors registration number)
 being a certified/registered surveyor and duly authorised representative of:
 THEREFOR GROUP (consulting firm or company name)

Hereby:


- certify the information contained in this drawing is an accurate as constructed representation of the works
- accept responsibility for the as constructed survey information contained in this drawing
- acknowledge the as constructed survey information contained in the drawing may be relied on by council and others

Certification of Stage: 4A by [Signature] On 09/05/2025 (stage number) (signature) (date)

For: THEREFOR GROUP (consulting firm or company name)
 Note: Where consulting firms, company name or stage numbers do not apply, complete with N/A for not applicable

COORDINATE DATUM NOTE:
 HORIZONTAL COORDINATES(E,N) SUPPLIED ARE MAPPING GRID OF AUSTRALIA(MGA), ZONE 56 BASED ON THE UNIVERSAL TRANSVERSE MERCATOR PROJECTION AND THE GEOCENTRIC DATUM OF AUSTRALIA 1994.

AS CONSTRUCTED

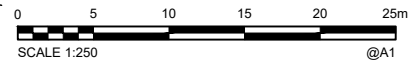


A1	INDEX	DATE	AS CONSTRUCTED	REVISIONS	DRAWN	CHECKED	PASSED	INITIALS	DATE
	A	09/05/2025	AS CONSTRUCTED		DM	A Dahn	A Dahn		09/05/2025

DRAWN	DM	09/05/2025
CHECKED	AMD	09/05/2025
PASSED	AMD	09/05/2025

Unitywater

2019013911511
 Village Green - Stage 4A
 College Drive Palmview
 Water Reticulation

SHEET 2 OF 5 SHEETS	SCALE 1:250
REVISION DATE 09/05/2025	REVISION A
DISCIPLINE CODE C	
DRAWING NO. U-2024-5342 WA01	

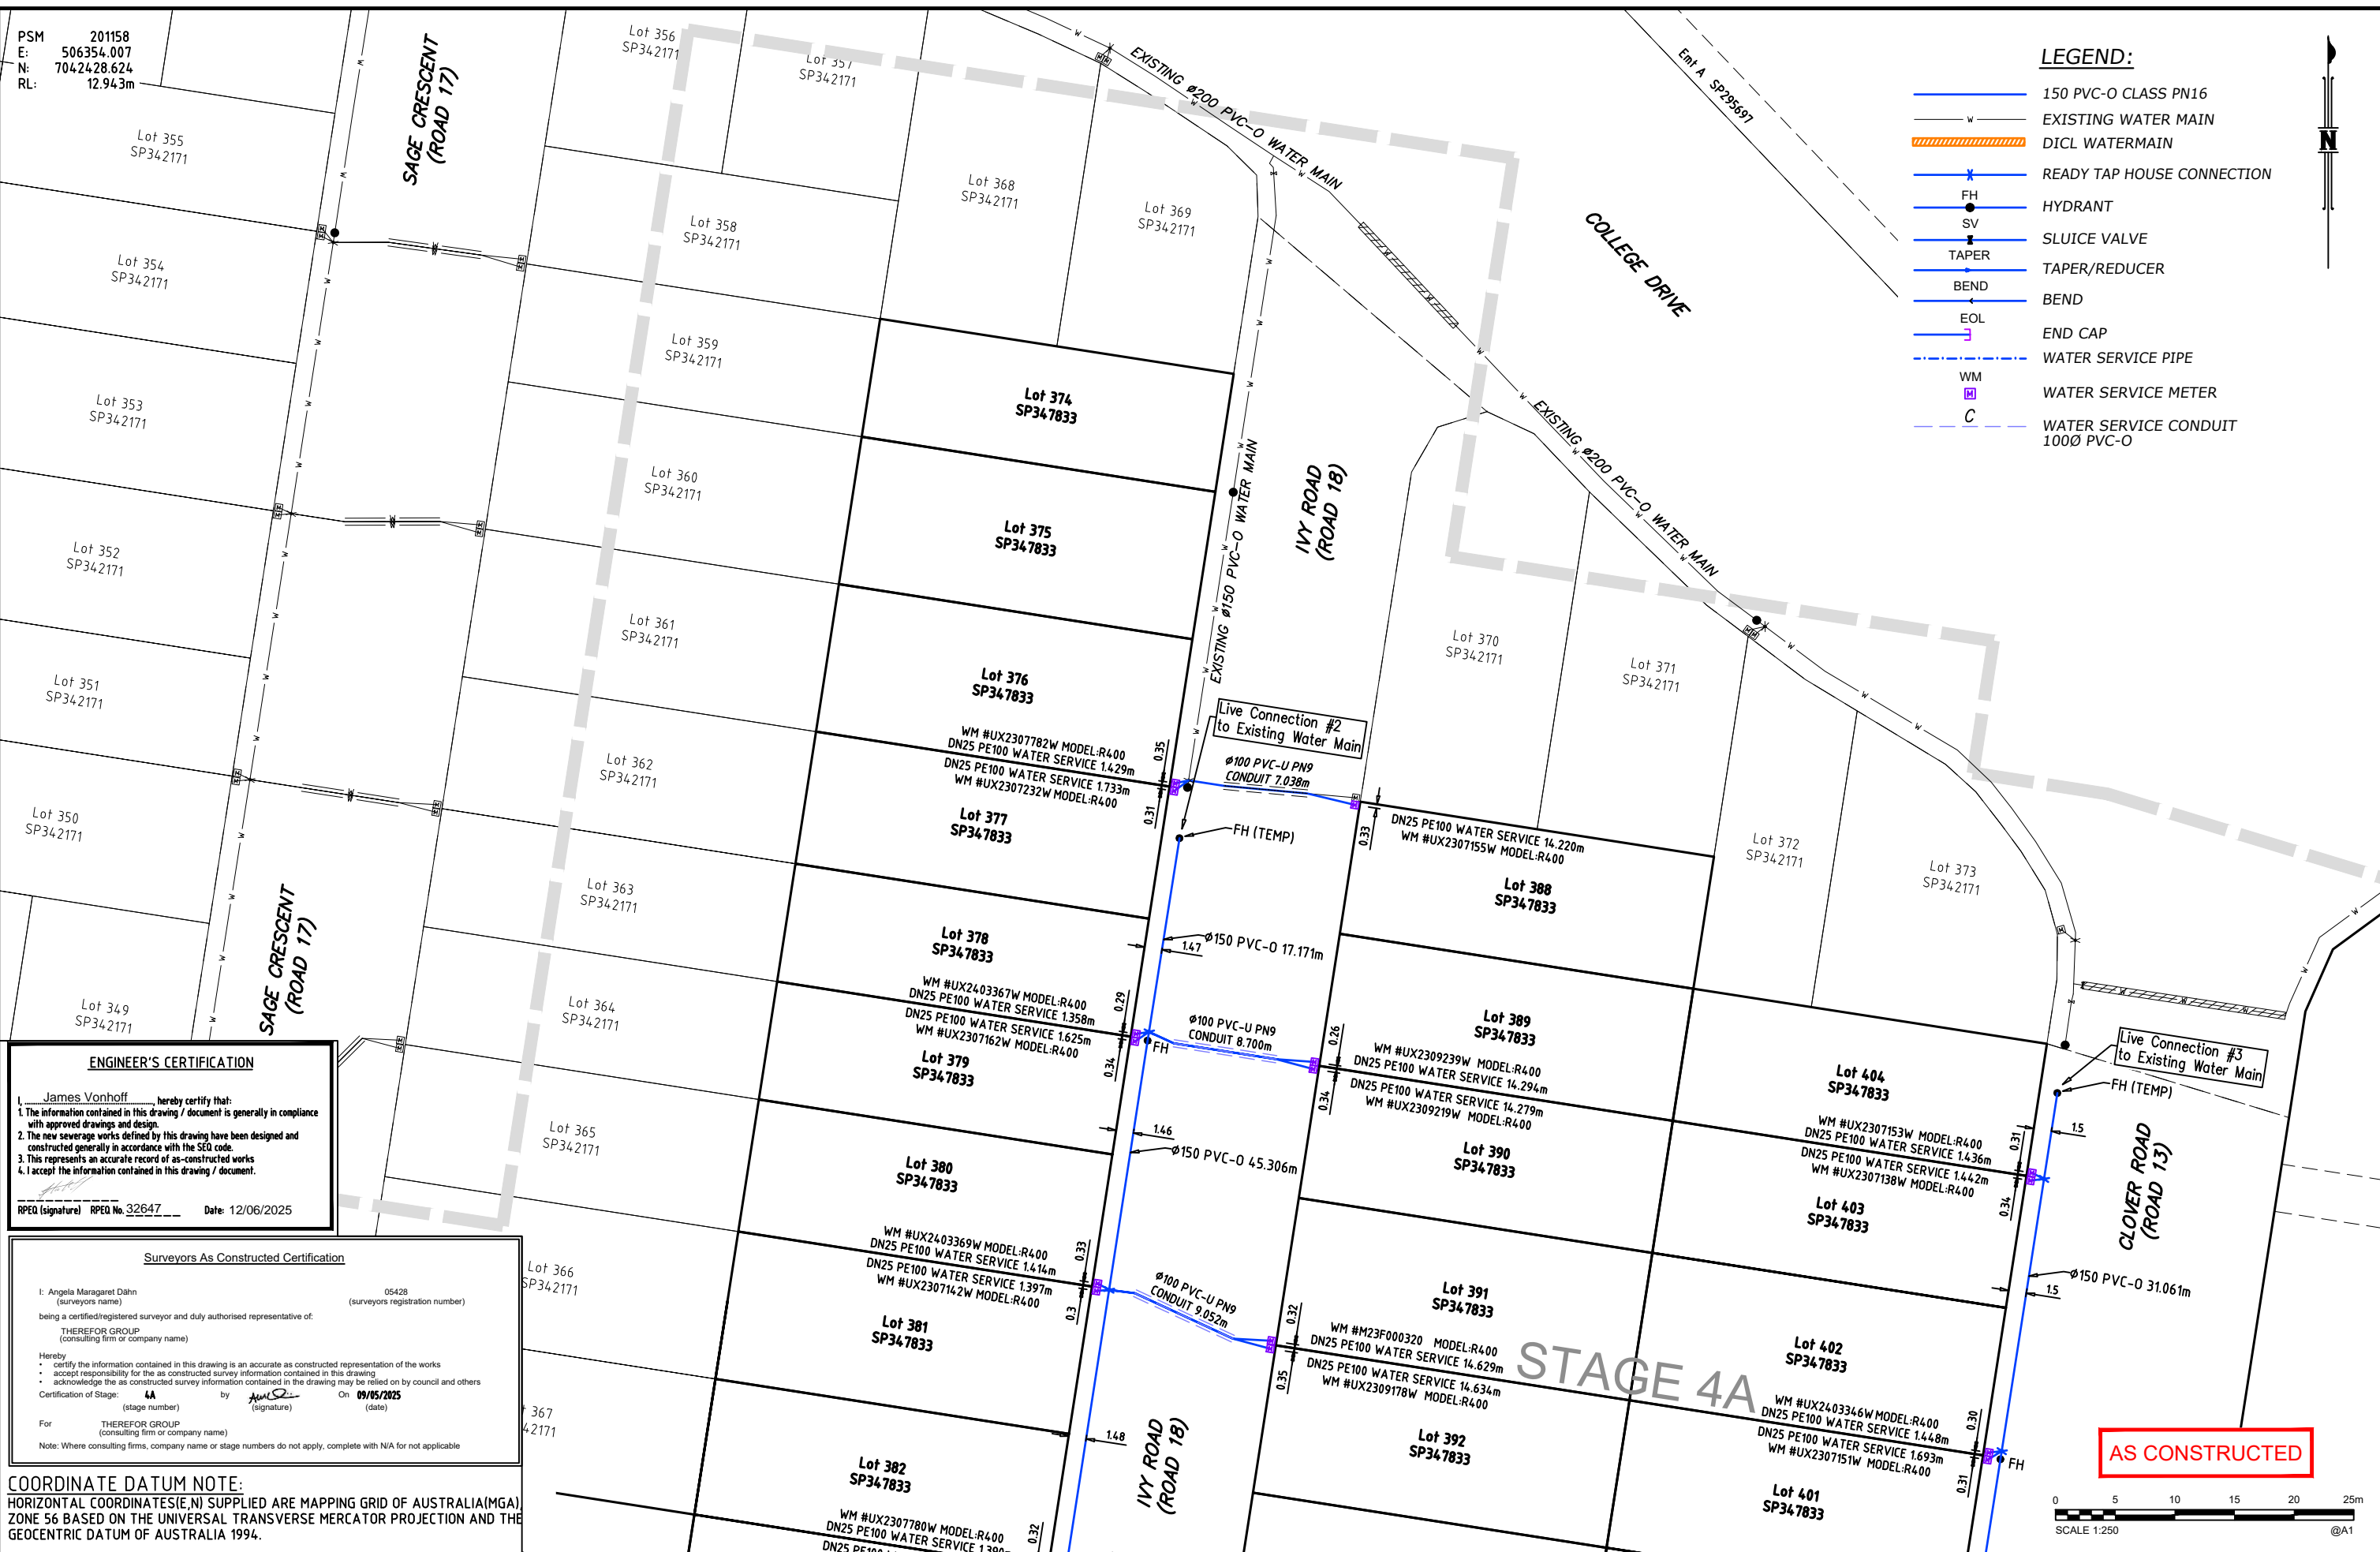

- LEGEND:**
- 150 PVC-O CLASS PN16
 - EXISTING WATER MAIN
 - ▨ DICL WATERMAIN
 - READY TAP HOUSE CONNECTION
 - FH
 - SV
 - SLUICE VALVE
 - TAPER
 - TAPER/REDUCER
 - BEND
 - BEND
 - EOL
 - END CAP
 - WATER SERVICE PIPE
 - WM
 - WATER SERVICE METER
 - C
 - WATER SERVICE CONDUIT 100Ø PVC-O




PSM 201158
 E: 506354.007
 N: 7042428.624
 RL: 12.943m

ENGINEER'S CERTIFICATION
 I, James Vonhoff, hereby certify that:
 1. The information contained in this drawing / document is generally in compliance with approved drawings and design.
 2. The new sewerage works defined by this drawing have been designed and constructed generally in accordance with the SED code.
 3. This represents an accurate record of as-constructed works
 4. I accept the information contained in this drawing / document.
 RPED (signature) RPED No. 32647 Date: 12/06/2025

Surveyors As Constructed Certification
 I, Angela Maragaret Dahn (surveyors name) 05428 (surveyors registration number)
 being a certified/registered surveyor and duly authorised representative of:
 THEREFOR GROUP (consulting firm or company name)
 Hereby:
 • certify the information contained in this drawing is an accurate as constructed representation of the works
 • accept responsibility for the as constructed survey information contained in this drawing
 • acknowledge the as constructed survey information contained in the drawing may be relied on by council and others
 Certification of Stage: 4A by [Signature] On 09/05/2025
 (stage number) (signature) (date)
 For THEREFOR GROUP (consulting firm or company name)
 Note: Where consulting firms, company name or stage numbers do not apply, complete with N/A for not applicable

COORDINATE DATUM NOTE:
 HORIZONTAL COORDINATES(E,N) SUPPLIED ARE MAPPING GRID OF AUSTRALIA(MGA) ZONE 56 BASED ON THE UNIVERSAL TRANSVERSE MERCATOR PROJECTION AND THE GEOCENTRIC DATUM OF AUSTRALIA 1994.

AS CONSTRUCTED

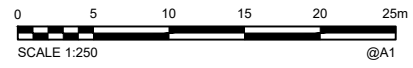


A1	INDEX	DATE	AS CONSTRUCTED	REVISIONS	DRAWN	CHECKED	PASSED	INITIALS	DATE
	A	09/05/2025	AS CONSTRUCTED		DM	A Dahn	A Dahn		09/05/2025

DRAWN	DM	09/05/2025
CHECKED	AMD	09/05/2025
PASSED	AMD	09/05/2025



Unitywater
 2019013911S11
 Village Green - Stage 4A
 College Drive Palmview
 Water Reticulation

SHEET 3 OF 5 SHEETS	SCALE 1:250
REVISION DATE 09/05/2025	REVISION A
DISCIPLINE CODE C	
DRAWING NO. U-2024-5342 WA02	

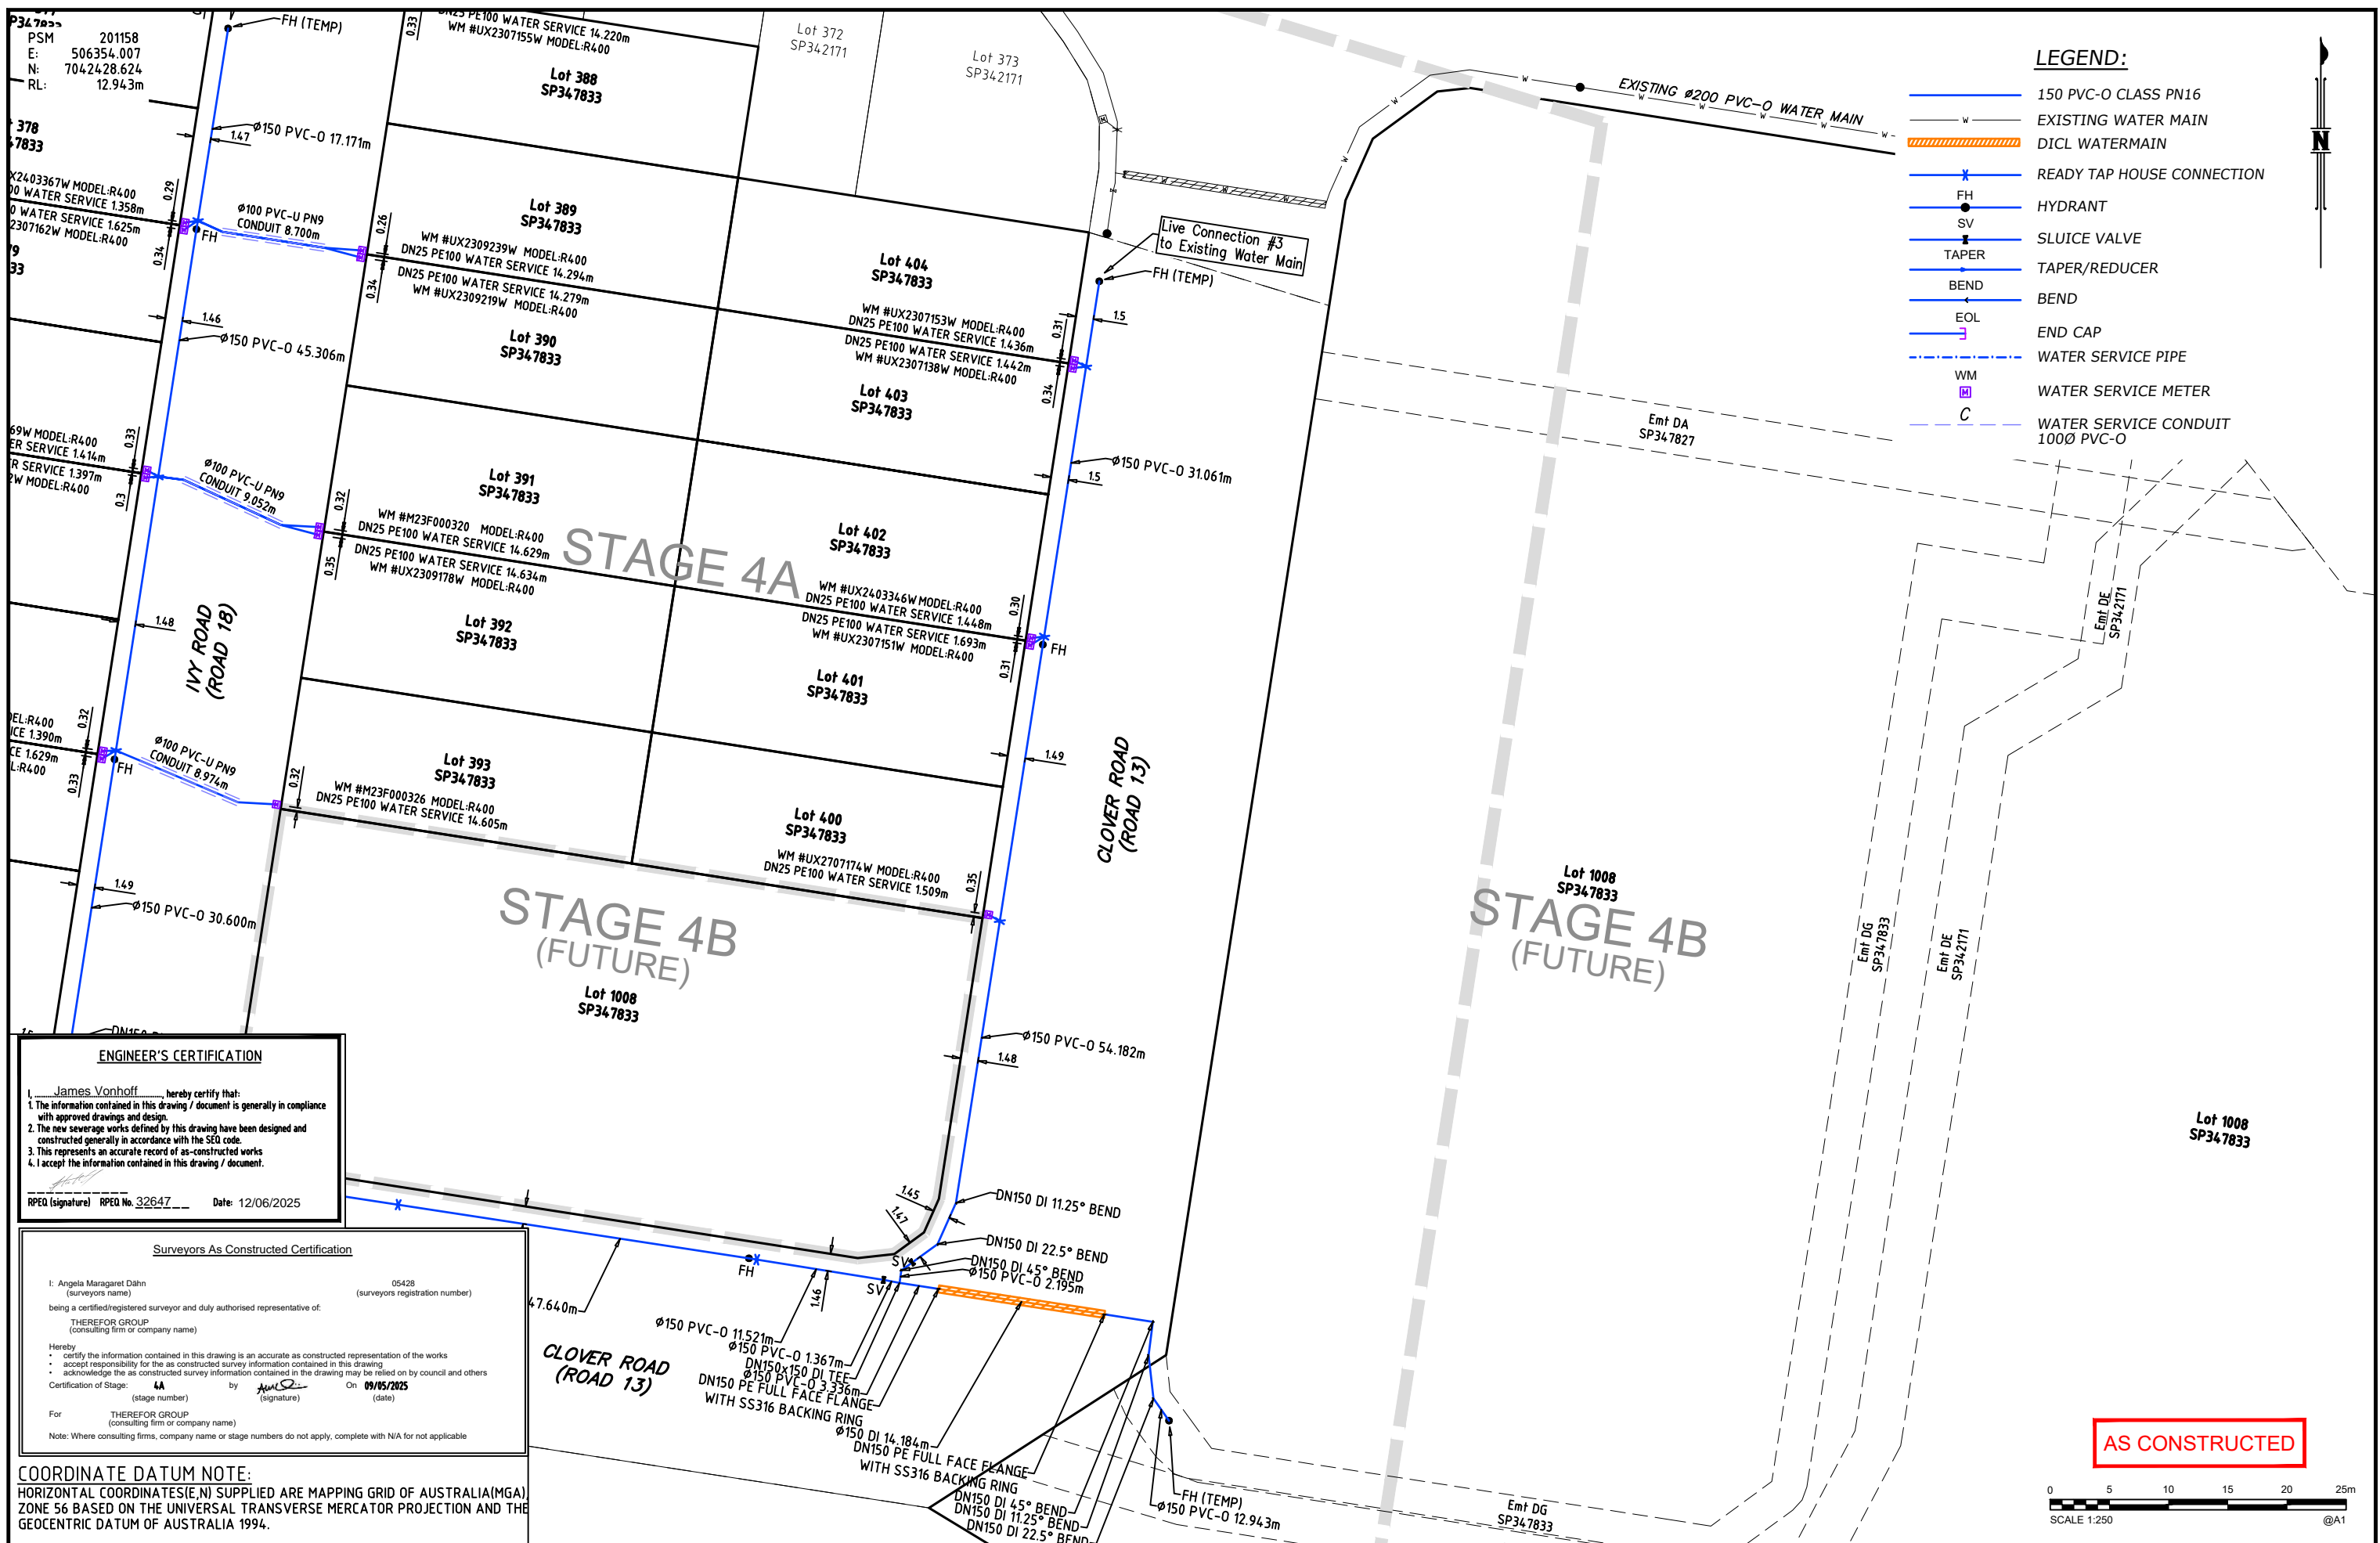

- LEGEND:**
- 150 PVC-O CLASS PN16
 - EXISTING WATER MAIN
 - ▨ DI CL WATERMAIN
 - ✕ READY TAP HOUSE CONNECTION
 - HYDRANT
 - SLUICE VALVE
 - TAPER
 - TAPER/REDUCER
 - BEND
 - BEND
 - EOL
 - END CAP
 - WATER SERVICE PIPE
 - WATER SERVICE METER
 - WATER SERVICE CONDUIT 100Ø PVC-O

ENGINEER'S CERTIFICATION

I, James Vonhoff, hereby certify that:

- The information contained in this drawing / document is generally in compliance with approved drawings and design.
- The new sewerage works defined by this drawing have been designed and constructed generally in accordance with the SED code.
- This represents an accurate record of as-constructed works.
- I accept the information contained in this drawing / document.

RPEQ (signature) RPEQ No. 32647 Date: 12/06/2025

Surveyors As Constructed Certification

I, Angela Maragaret Dahn (surveyors name) 05428 (surveyors registration number) being a certified/registered surveyor and duly authorised representative of: THEREFOR GROUP (consulting firm or company name)

Hereby:

- certify the information contained in this drawing is an accurate as constructed representation of the works
- accept responsibility for the as constructed survey information contained in this drawing
- acknowledge the as constructed survey information contained in the drawing may be relied on by council and others


Certification of Stage: 4A by [Signature] On 09/05/2025 (date)

For THEREFOR GROUP (consulting firm or company name)

Note: Where consulting firms, company name or stage numbers do not apply, complete with N/A for not applicable

COORDINATE DATUM NOTE:
 HORIZONTAL COORDINATES (E,N) SUPPLIED ARE MAPPING GRID OF AUSTRALIA (MGA) ZONE 56 BASED ON THE UNIVERSAL TRANSVERSE MERCATOR PROJECTION AND THE GEOCENTRIC DATUM OF AUSTRALIA 1994.

AS CONSTRUCTED

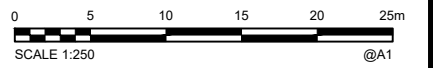

A1	INDEX	DATE	AS CONSTRUCTED	REVISIONS	DRAWN	CHECKED	PASSED	INITIALS	DATE			Unitywater 2019013911S11 Village Green - Stage 4A College Drive Palmview Water Reticulation	SHEET 4 OF 5 SHEETS	SCALE 1:250
		09/05/2025			DM	A Dahn	A Dahn		09/05/2025				REVISION DATE 09/05/2025	REVISION A

