

AS CONSTRUCTED



36 (PT)
S 311685

SCALE 1:500 - LENGTHS IN METRES

A1	INDEX	DATE	REVISIONS	DRAWN	CHECKED	PASSED

SCHLENCKER SURVEYING (QLD)
Gold Coast - Brisbane
Consultants in Surveying,
Mapping & Development




A.B.N. 38 909 833 411
PO Box 41,
Helensvale QLD 4212.

Suite 206,
Helensvale Professional Centre
3 Sir John Overall Dr.,
Helensvale QLD 4212. EMAIL: mail@ssq.net.au

Ph: (07) 5573 6744
Fax: (07) 5573 6755
Mob: 0413 945 999

REGISTERED SURVEYOR'S CERTIFICATION

Schlencker Surveying (Qld) Pty Ltd (ACN 063 830 642), hereby certify that the horizontal and vertical locations, and dimensions shown in the plans contained in this electronic submission are a true and correct record of the As-constructed information.

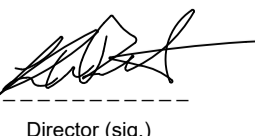
Director (sig.)

Date: 26/05/2023
Reg. Surveyor No. 3337

REGISTERED ENGINEER'S CERTIFICATION

I, _____ hereby certify that the As-constructed information shown on the plans contained in this electronic submission is a true and correct record of the sizes, types, materials, classes etc., and it corresponds with the relevant approved Engineering Drawings.

Project Name
Company
Consultant: KN GROUP
RPEQ/CPeng Membership No.

Date: _____

This Plan has been prepared for Logan City Council for the purpose of recording the As-Constructed details of a new service constructed under a specific Council Approval and should not be used for any other purpose. No report is made on any other services, nor any services that may exist before or be constructed after, the time of survey, or constructed under any other approval. The property boundaries, easements and lot numbers shown hereon may be proposed only and subject to registration by the Department of Natural Resources & Mines. All property information should be determined from the registered Survey Plans.



THIS NOTE IS AN INTEGRAL PART OF THIS PLAN.

SURFACE AS CONSTRUCTED

STAGE 15C
SPRING MOUNTAIN
OW/242/2021

LOCAL AUTHORITY	LOGAN CITY COUNCIL
LOCALITY	NEW BEITH
LEVEL DATUM	AHD DERIVED
LEVEL ORIGIN	PM180644 RL: 77.302 m
SURVEYED	TR, JM, RB
DRAWN	ASS
SCALE	1:1000 SHEET 1 OF 3
DRAWING NO.	15159 - 129

AS CONSTRUCTED

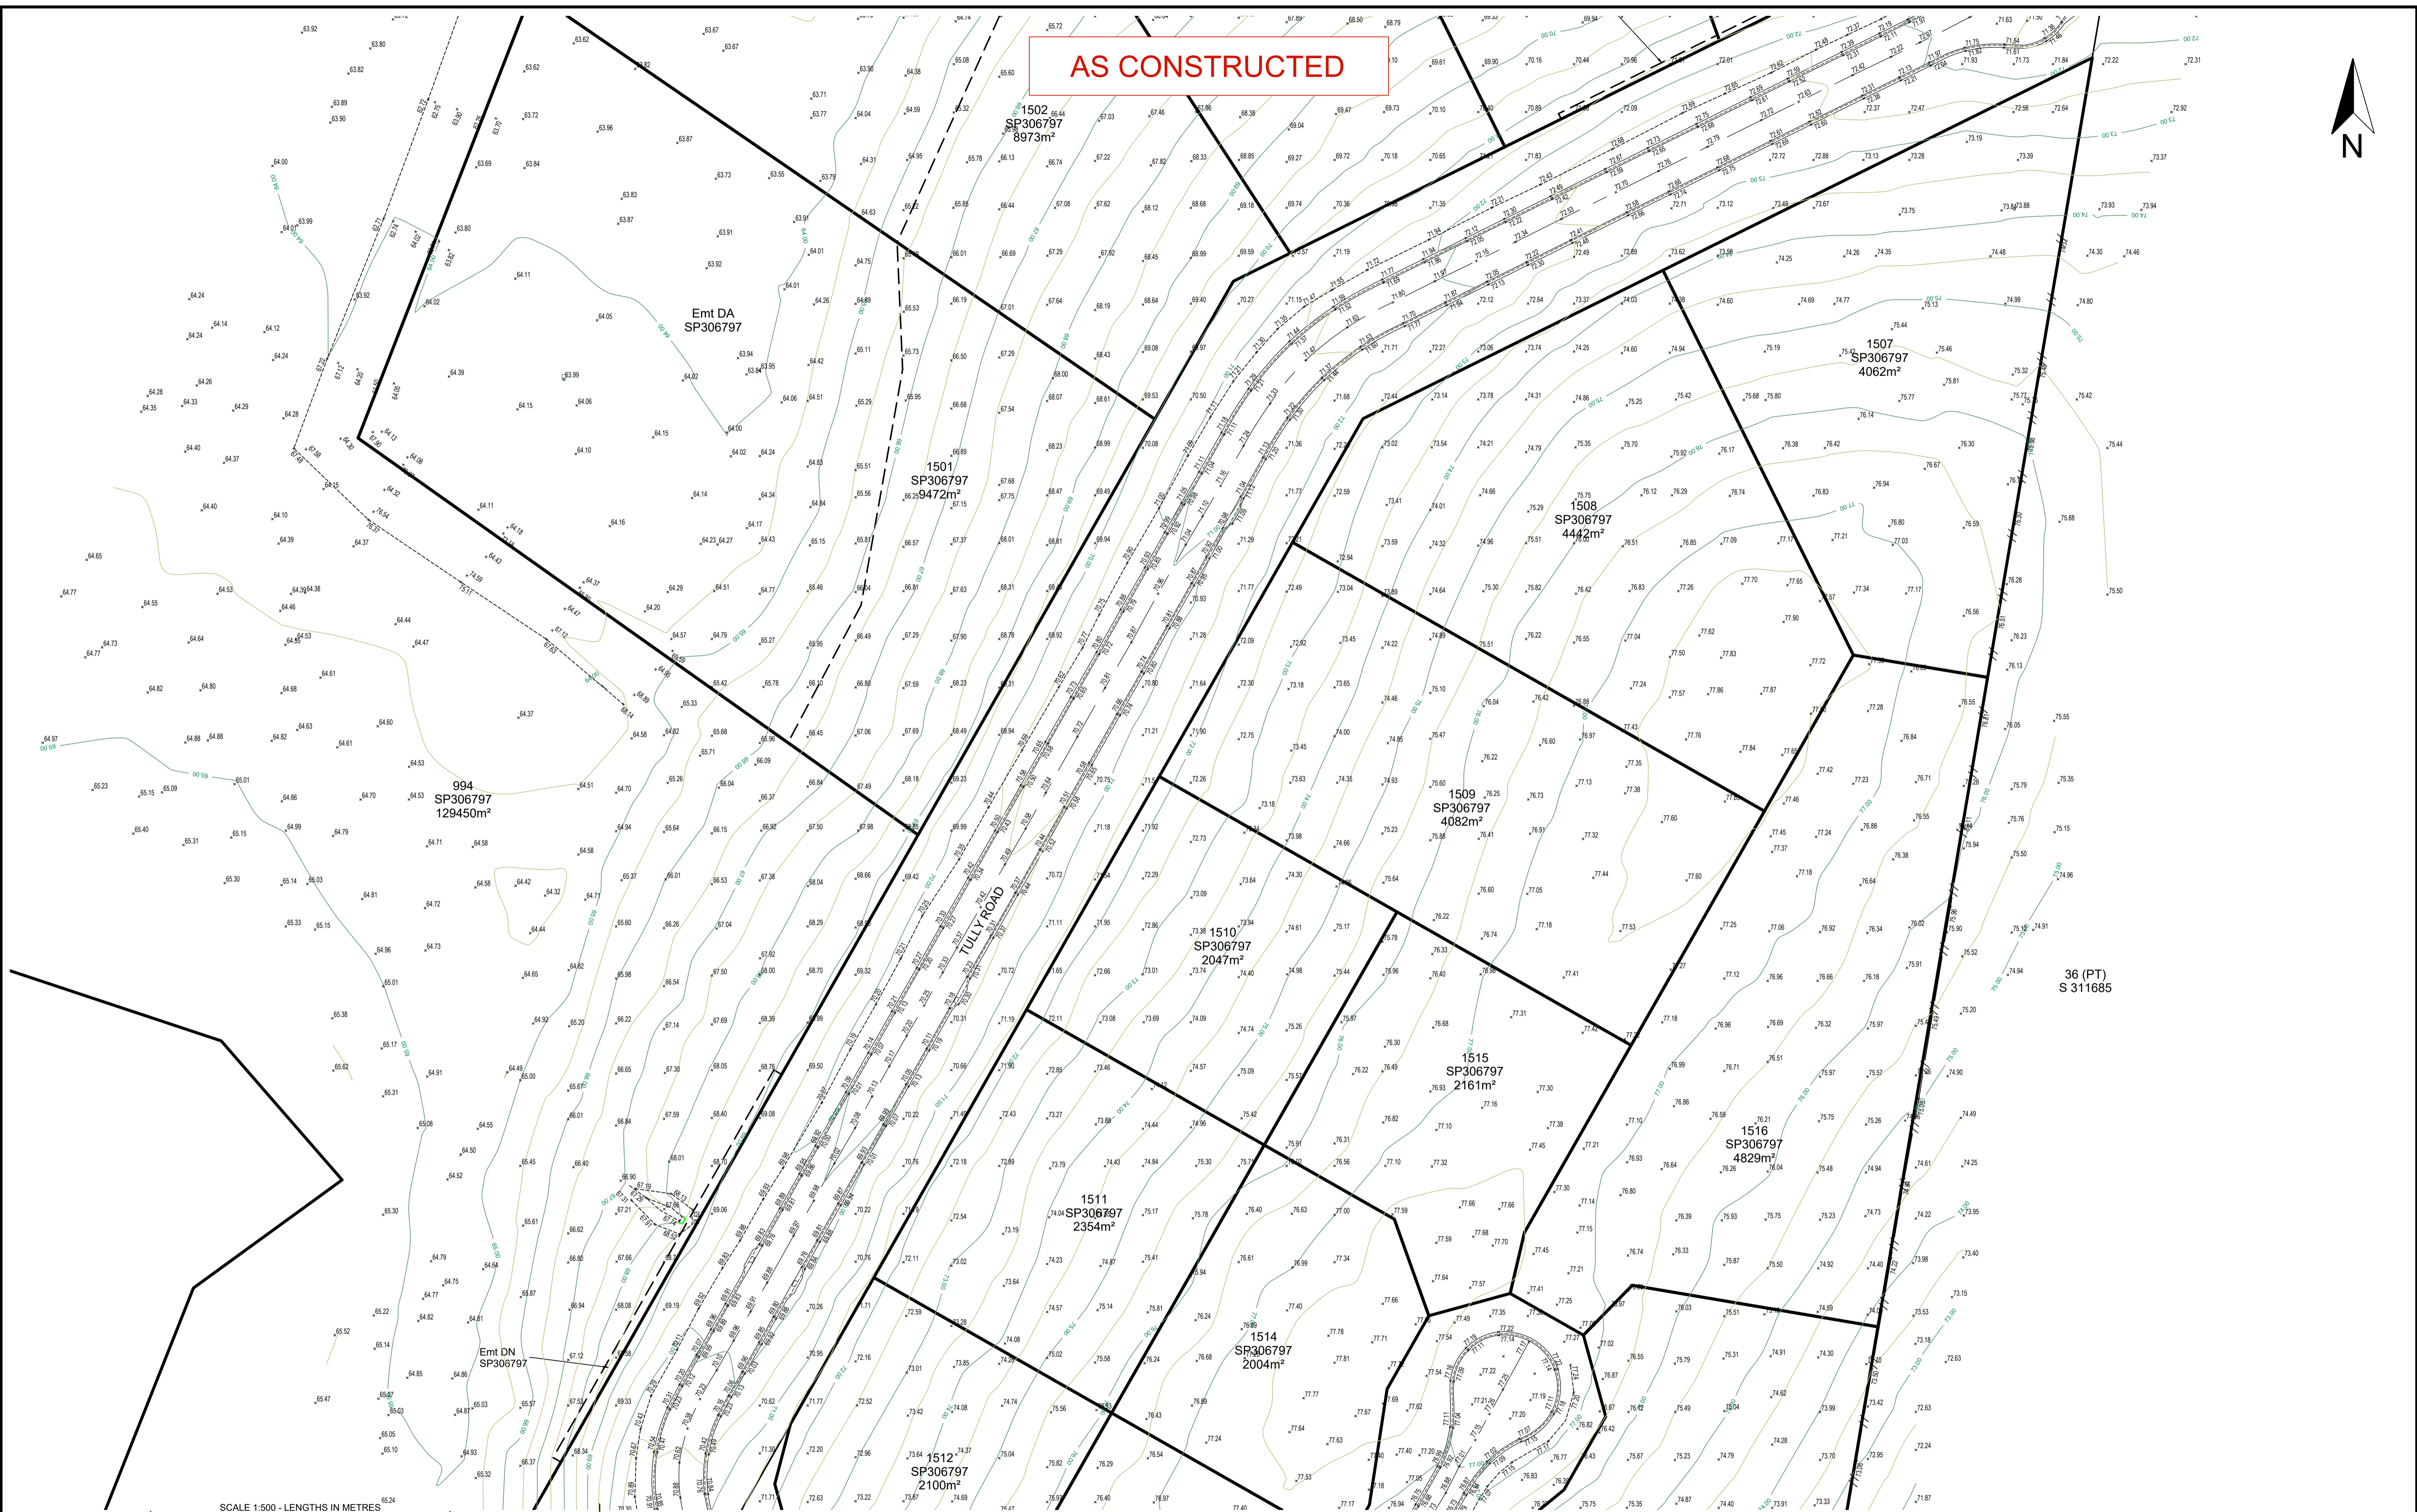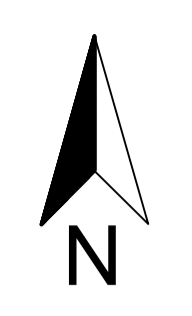

SCALE 1:500 - LENGTHS IN METRES

A1	INDEX	DATE	REVISIONS	DRAWN	CHECKED	PASSED

SCHLENCKER SURVEYING (QLD)
 Gold Coast - Brisbane
 Consultants in Surveying,
 Mapping & Development

A.B.N. 38 909 833 411
 PO Box 41,
 Helensvale QLD 4212.

Suite 206,
 Helensvale Professional Centre
 3 Sir John Overall Dr,
 Helensvale QLD 4212. EMAIL: mail@ssq.net.au

Ph: (07) 5573 6744
 Fax: (07) 5573 6755
 Mob: (0413) 945 959

REGISTERED SURVEYOR'S CERTIFICATION

Schlencker Surveying (Qld) Pty Ltd (ACN 063 830 642), hereby certify that the horizontal and vertical locations, and dimensions shown in the plans contained in this electronic submission are a true and correct record of the As-constructed information.

Director (sig.)

Date: 26/05/2023
 Reg. Surveyor No. 3337

REGISTERED ENGINEER'S CERTIFICATION

I, _____ hereby certify that the As-constructed information shown on the plans contained in this electronic submission is a true and correct record of the sizes, types, materials, classes etc., and it corresponds with the relevant approved Engineering Drawings.

Project Name
 Company
 Consultant: KN GROUP
 RPEQ/CPeng Membership No.

Date: _____

This Plan has been prepared for Logan City Council for the purpose of recording the As-Constructed details of a new service constructed under a specific Council Approval and should not be used for any other purpose. No report is made on any other services, nor any services that may exist before or be constructed after, the time of survey, or constructed under any other approval. The property boundaries, easements and lot numbers shown hereon may be proposed only and subject to registration by the Department of Natural Resources & Mines. All property information should be determined from the registered Survey Plans.


THIS NOTE IS AN INTEGRAL PART OF THIS PLAN.

SURFACE AS CONSTRUCTED

STAGE 15C
SPRING MOUNTAIN
 OW/242/2021

LOCAL AUTHORITY	LOGAN CITY COUNCIL
LOCALITY	NEW BEITH
LEVEL DATUM	AHD DERIVED
LEVEL ORIGIN	PM180644 RL: 77.302 m
SURVEYED	TR, JM, RB
DRAWN	ASS
SCALE	1:1000 SHEET 2 OF 3
DRAWING NO.	15159 - 129

AS CONSTRUCTED

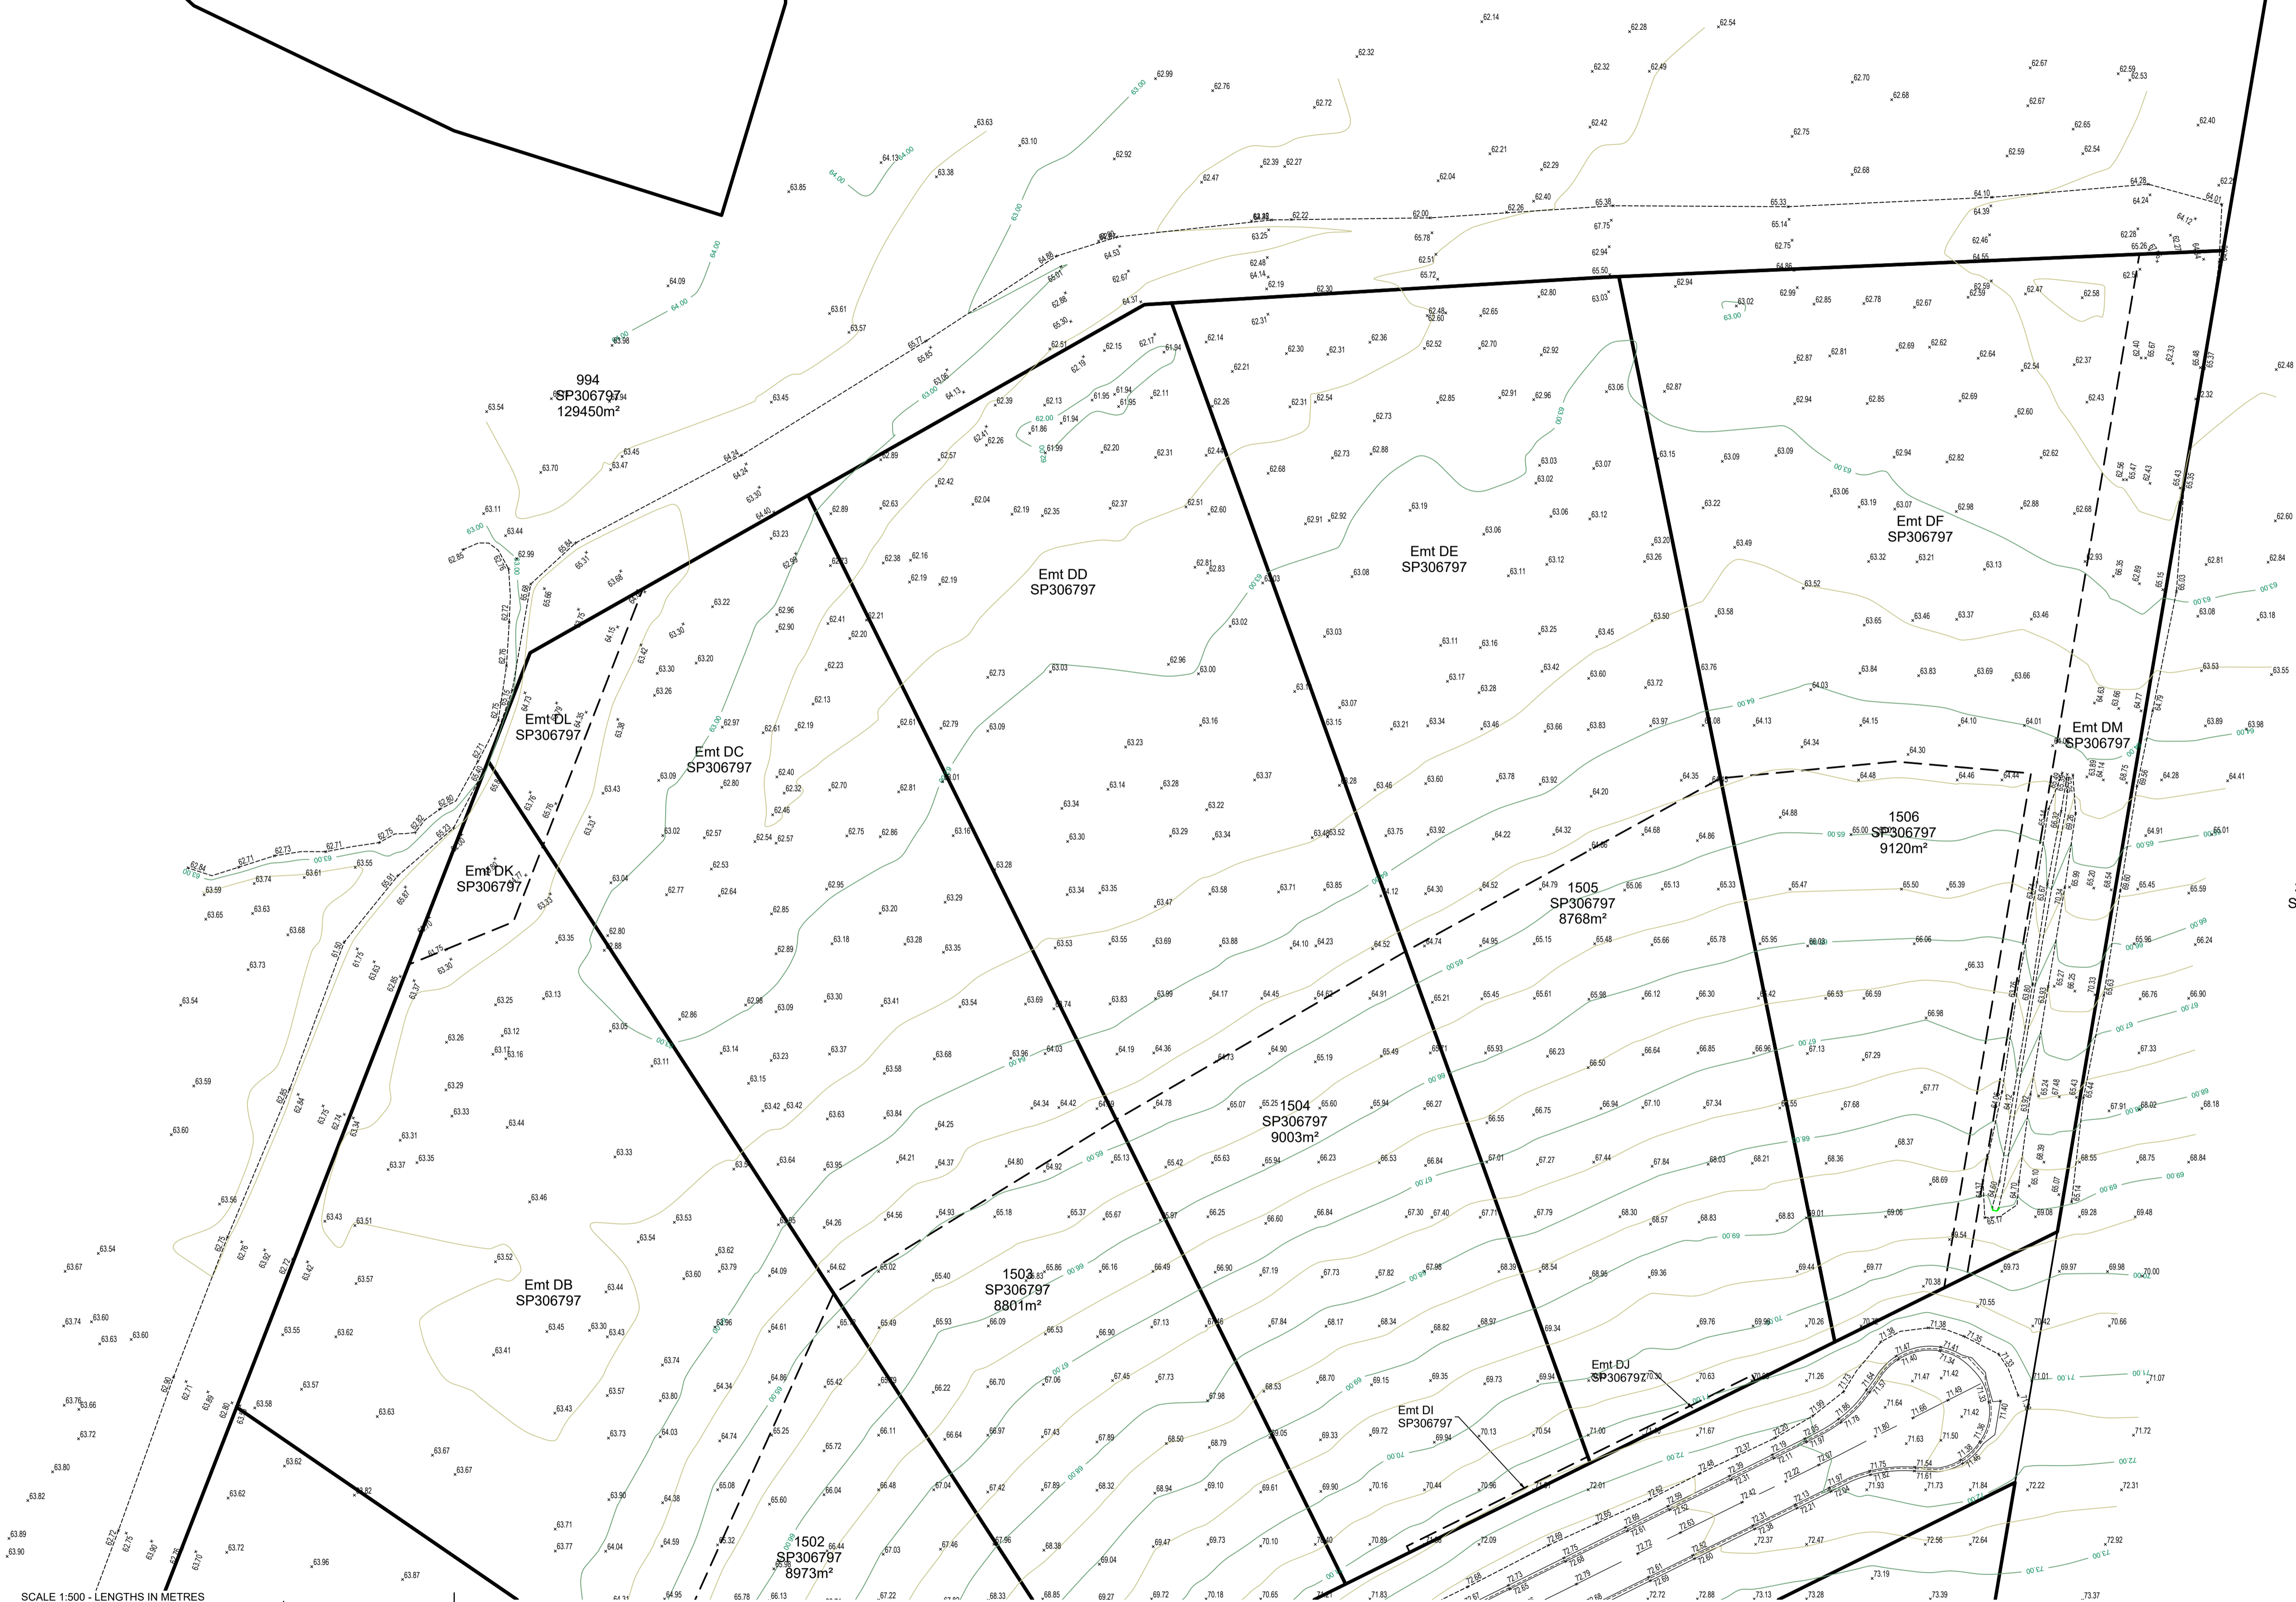

SCALE 1:500 - LENGTHS IN METRES

A1	INDEX	DATE	REVISIONS	DRAWN	CHECKED	PASSED

SCHLENCKER SURVEYING (QLD)
 Gold Coast - Brisbane
 Consultants in Surveying
 Mapping & Development

A B N. 38 909 833 411
 PO Box 41,
 Helensvale QLD 4212.

Suite 206,
 Helensvale Professional Centre
 3 Sir John Overall Dr,
 Helensvale QLD 4212. EMAIL: mail@ssq.net.au

Ph: (07) 5573 6744
 Fax: (07) 5573 6755
 Mob: (0413) 945 959

REGISTERED SURVEYOR'S CERTIFICATION

Schlencker Surveying (Qld) Pty Ltd (ACN 063 830 642), hereby certify that the horizontal and vertical locations, and dimensions shown in the plans contained in this electronic submission are a true and correct record of the As-constructed information.

Director (sig.)

Date: 26/05/2023
 Reg. Surveyor No. 33327

REGISTERED ENGINEER'S CERTIFICATION

I, _____ hereby certify that the As-constructed information shown on the plans contained in this electronic submission is a true and correct record of the sizes, types, materials, classes etc., and it corresponds with the relevant approved Engineering Drawings.

Project Name
 Company
 Consultant: KN GROUP
 RPEQ/CPENG Membership No.

Date: _____

This Plan has been prepared for Logan City Council for the purpose of recording the As-Constructed details of a new service constructed under a specific Council Approval and should not be used for any other purpose. No report is made on any other services, nor any services that may exist before or be constructed after, the time of survey, or constructed under any other approval. The property boundaries, easements and lot numbers shown hereon may be proposed only and subject to registration by the Department of Natural Resources & Mines. All property information should be determined from the registered Survey Plans.

THIS NOTE IS AN INTEGRAL PART OF THIS PLAN.

SURFACE AS CONSTRUCTED

STAGE 15C
 SPRING MOUNTAIN
 OW/242/2021

LOCAL AUTHORITY	LOGAN CITY COUNCIL
LOCALITY	NEW BEITH
LEVEL DATUM	AHD DERIVED
LEVEL DATUM	PM180644 RL: 77.302 m
SURVEYED	TR, JM, RB
DRAWN	ASS
SCALE	1:1000 SHEET 3 OF 3
DRAWING NO.	15159 - 129