

SCALE 1:500 - LENGTHS IN METRES

A1	B	26/04/2023	Surveyor's and Engineer's Certifications updated	AS		
	A	26/04/2023	Missing hydrants and reducer note added	AS		
	INDEX	DATE	REVISIONS	DRAWN	CHECKED	PASSED

**SCHLENCKER SURVEYING (QLD)**  
 Gold Coast - Brisbane  
 Consultants in Surveying, Mapping & Development

A.B.N. 38 909 833 411  
 PO Box 41, Helensvale QLD 4212.

Suite 206, Helensvale Professional Centre  
 3 Sir John Overall Dr., Helensvale QLD 4212. EMAIL: mail@ssq.net.au

Ph: (07) 5573 6744  
 Fax: (07) 5573 6755  
 Mob: 0413 945 959

**REGISTERED SURVEYOR'S CERTIFICATION**

Schlencker Surveying (Qld) Pty Ltd (ACN 063 830 642), hereby certify that the horizontal and vertical locations, and dimensions shown in the plans contained in this electronic submission are a true and correct record of the As-constructed information.

*[Signature]*  
 Director (sig.)

Date: 20/04/2023  
 Reg. Surveyor No. \_3337\_

**REGISTERED ENGINEER'S CERTIFICATION**

I, \_\_\_\_\_, hereby certify that the As-constructed information shown on the plans contained in this electronic submission is a true and correct record of the sizes, types, materials, classes etc., and it corresponds with the relevant approved Engineering Drawings.

Project Name  
 Company  
 Consultant: KN GROUP  
 RPE/CPEng Membership No.

Date: \_\_\_\_\_

This Plan has been prepared for Logan City Council for the purpose of recording the As-constructed details of a new service constructed under a specific Council Approval and should not be used for any other purpose. No report is made on any other services, nor any services that may exist before or be constructed after, the time of survey, or constructed under any other approval. The property boundaries, easements and lot numbers shown hereon may be proposed only and subject to registration by the Department of Natural Resources & Mines. All property information should be determined from the registered Survey Plans.

THIS NOTE IS AN INTEGRAL PART OF THIS PLAN.


**WATER AS CONSTRUCTED**

**STAGE 15C**  
**SPRING MOUNTAIN**  
 OW/242/2021

LOCAL AUTHORITY	LOGAN CITY COUNCIL
LOCALITY	NEW BEITH
LEVEL DATUM	AHD DERIVED
LEVEL ORIGIN	PM180644 RL: 77.302 m
SURVEYED	ASS
DRAWN	ASS
SCALE	1:500 SHEET 1 OF 3
DRAWING NO.	15159 - 124B



# AS CONSTRUCTED

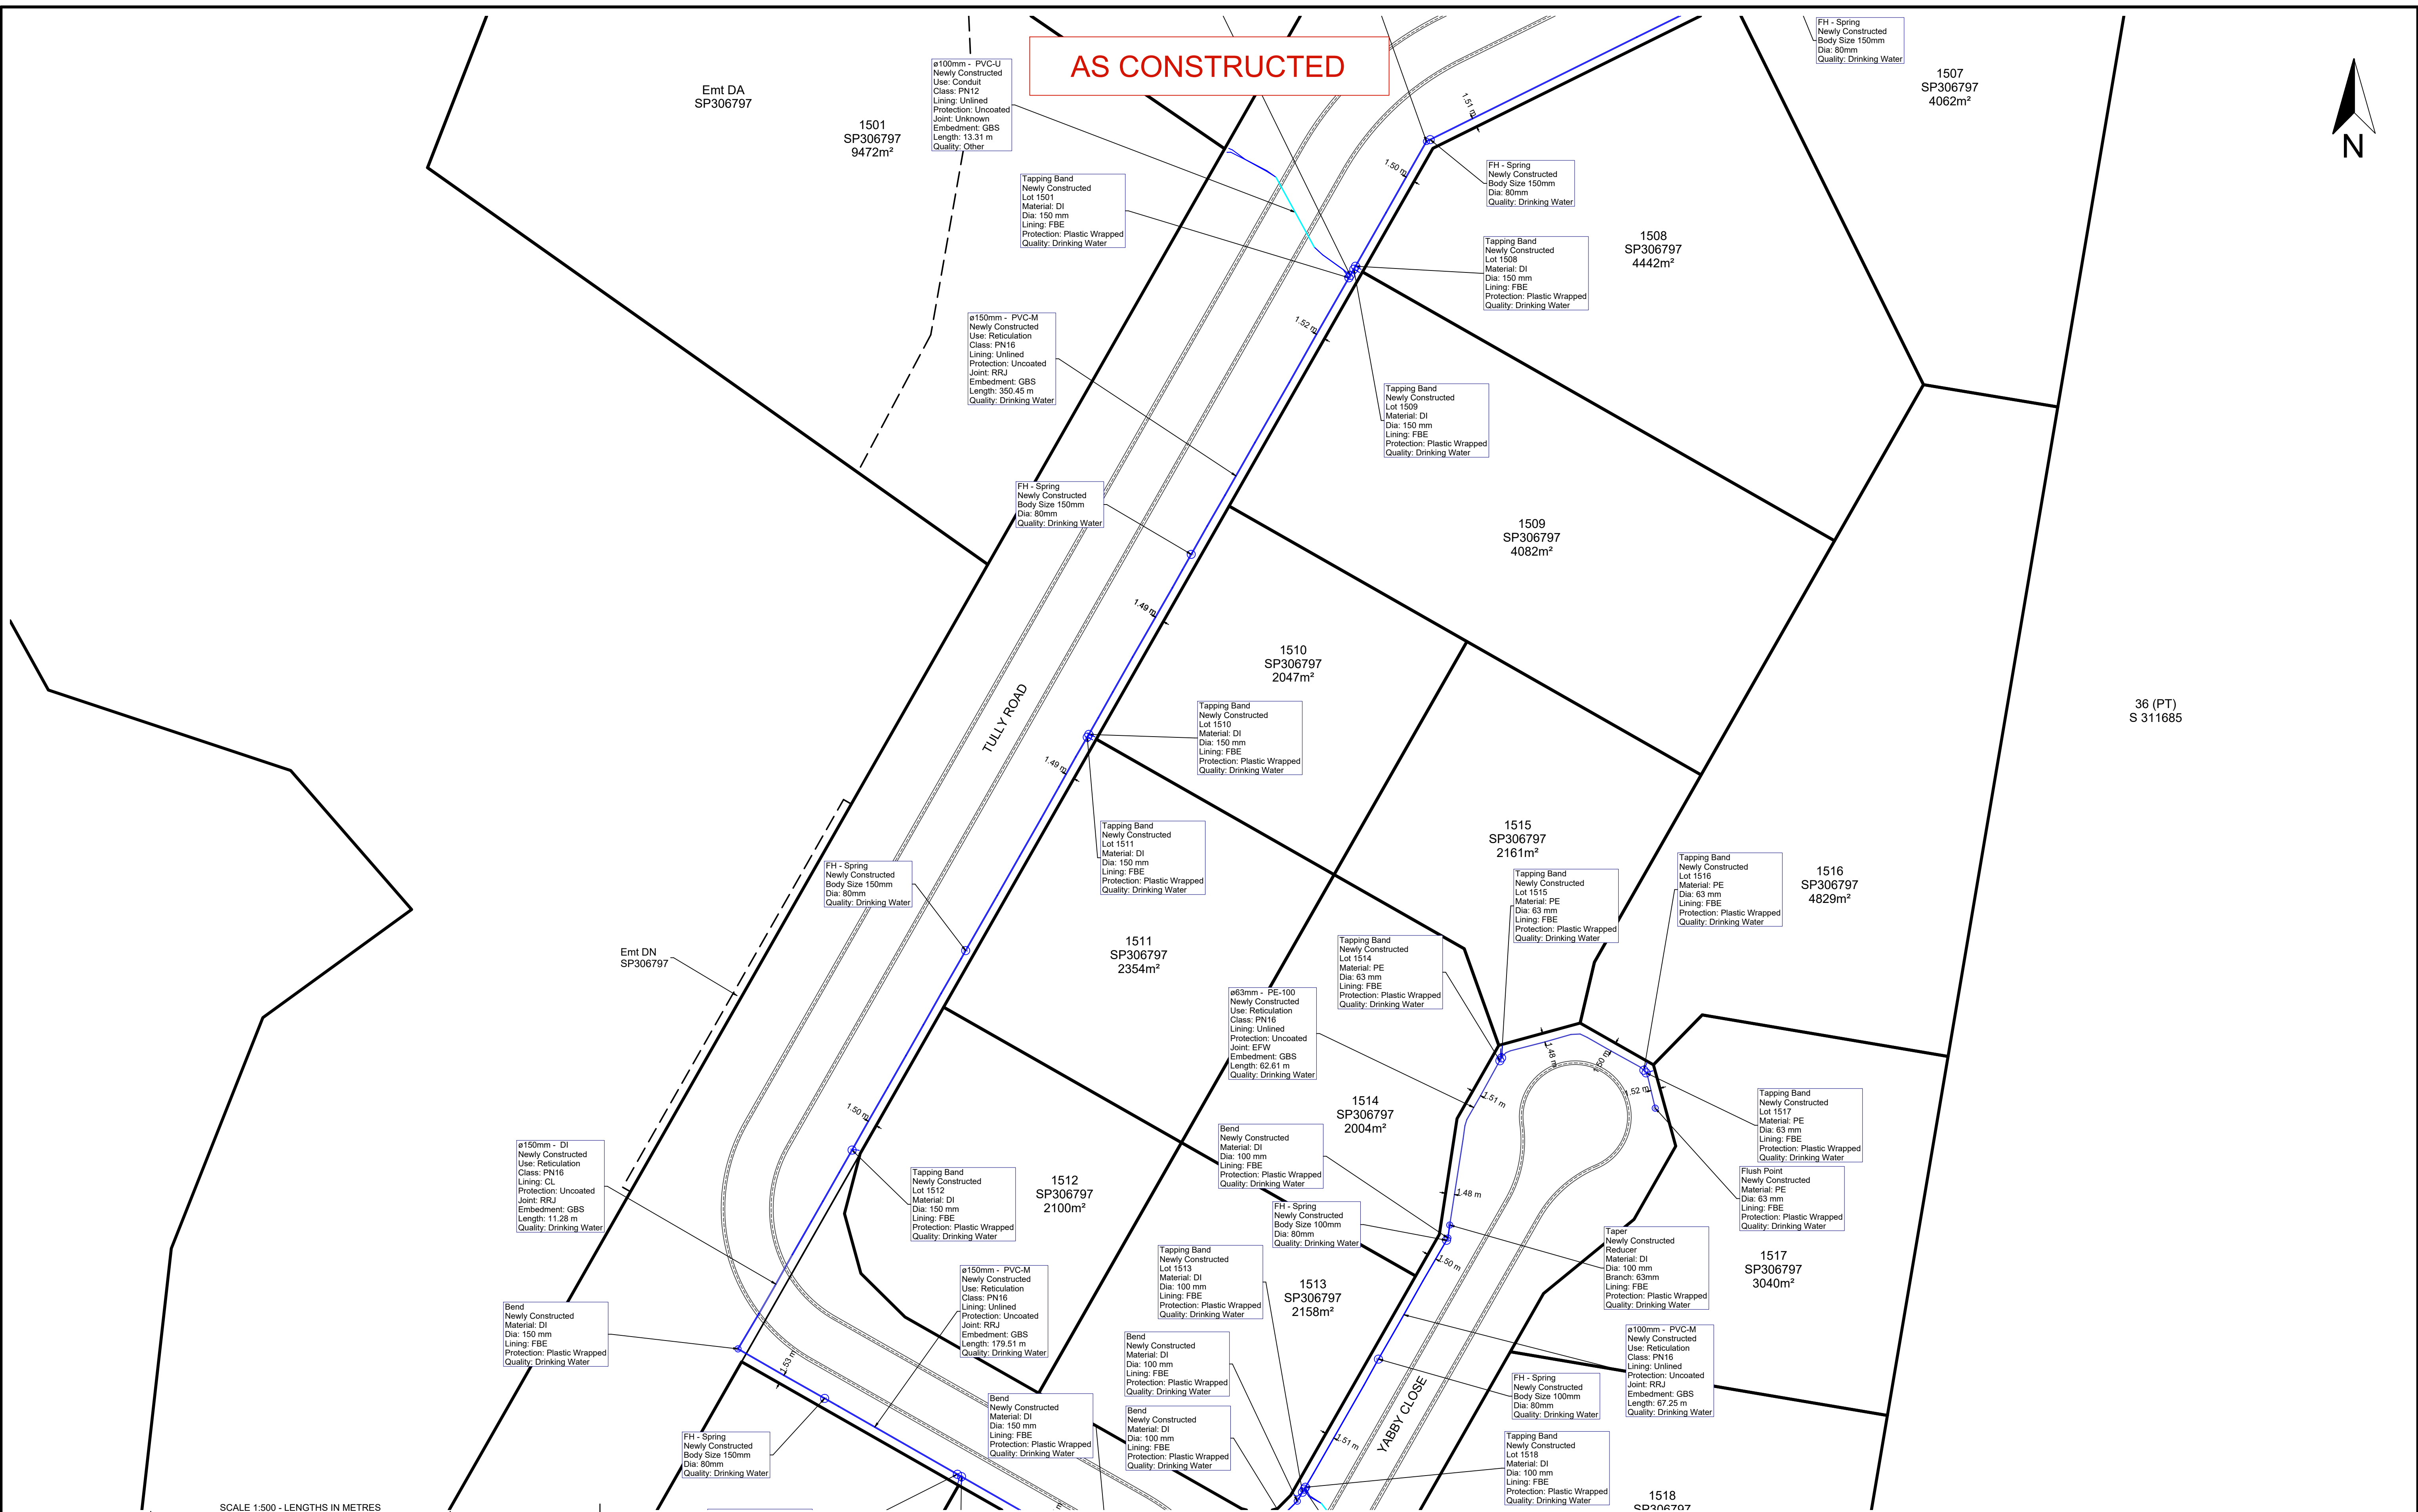

SCALE 1:500 - LENGTHS IN METRES

<b>A1</b>					
	B	26/04/2023	Surveyor's and Engineer's Certifications updated	AS	
	A	26/04/2023	Missing hydrants and reducer note added	AS	
	INDEX	DATE	REVISIONS	DRAWN	CHECKED

**SCHLENCKER SURVEYING (QLD)**  
 Gold Coast - Brisbane  
 Consultants in Surveying,  
 Mapping & Development

A.B.N. 38 909 833 411  
 PO Box 41,  
 Helensvale QLD 4212.

Suite 206,  
 Helensvale Professional Centre  
 3 Sir John Overall Dr.,  
 Helensvale QLD 4212. EMAIL: mail@ssq.net.au

Ph: (07) 5573 6744  
 Fax: (07) 5573 6755  
 Mob: 0413 945 959

**REGISTERED SURVEYOR'S CERTIFICATION**

Schlencker Surveying (Qld) Pty Ltd (ACN 063 830 642), hereby certify that the horizontal and vertical locations, and dimensions shown in the plans contained in this electronic submission are a true and correct record of the As-constructed information.

*[Signature]*  
 Director (sig.)

Date: 20/04/2023  
 Reg. Surveyor No. 3337

**REGISTERED ENGINEER'S CERTIFICATION**

I, \_\_\_\_\_, hereby certify that the As-constructed information shown on the plans contained in this electronic submission is a true and correct record of the sizes, types, materials, classes etc., and it corresponds with the relevant approved Engineering Drawings.

Project Name  
 Company  
 Consultant: KN GROUP  
 RPEQ/CPENG Membership No.

Date: \_\_\_\_\_

This Plan has been prepared for Logan City Council for the purpose of recording the As Constructed details of a new service constructed under a specific Council Approval and should not be used for any other purpose. No report is made on any other services, nor any services that may exist before or be constructed after, the time of survey, or constructed under any other approval. The property boundaries, easements and lot numbers shown hereon may be proposed only and subject to registration by the Department of Natural Resources & Mines. All property information should be determined from the registered Survey Plans.

THIS NOTE IS AN INTEGRAL PART OF THIS PLAN.

## WATER AS CONSTRUCTED



### STAGE 15C SPRING MOUNTAIN

OW/242/2021

LOCAL AUTHORITY	LOGAN CITY COUNCIL		
LOCALITY	NEW BEITH		
LEVEL DATUM	AHD DERIVED		
LEVEL ORIGIN	PM180644	RL:	77.302 m
SURVEYED	ASS	DRAWN	ASS
SCALE	1 : 500	SHEET	2 OF 3
DRAWING NO.	15159 - 124B		



AS CONSTRUCTED

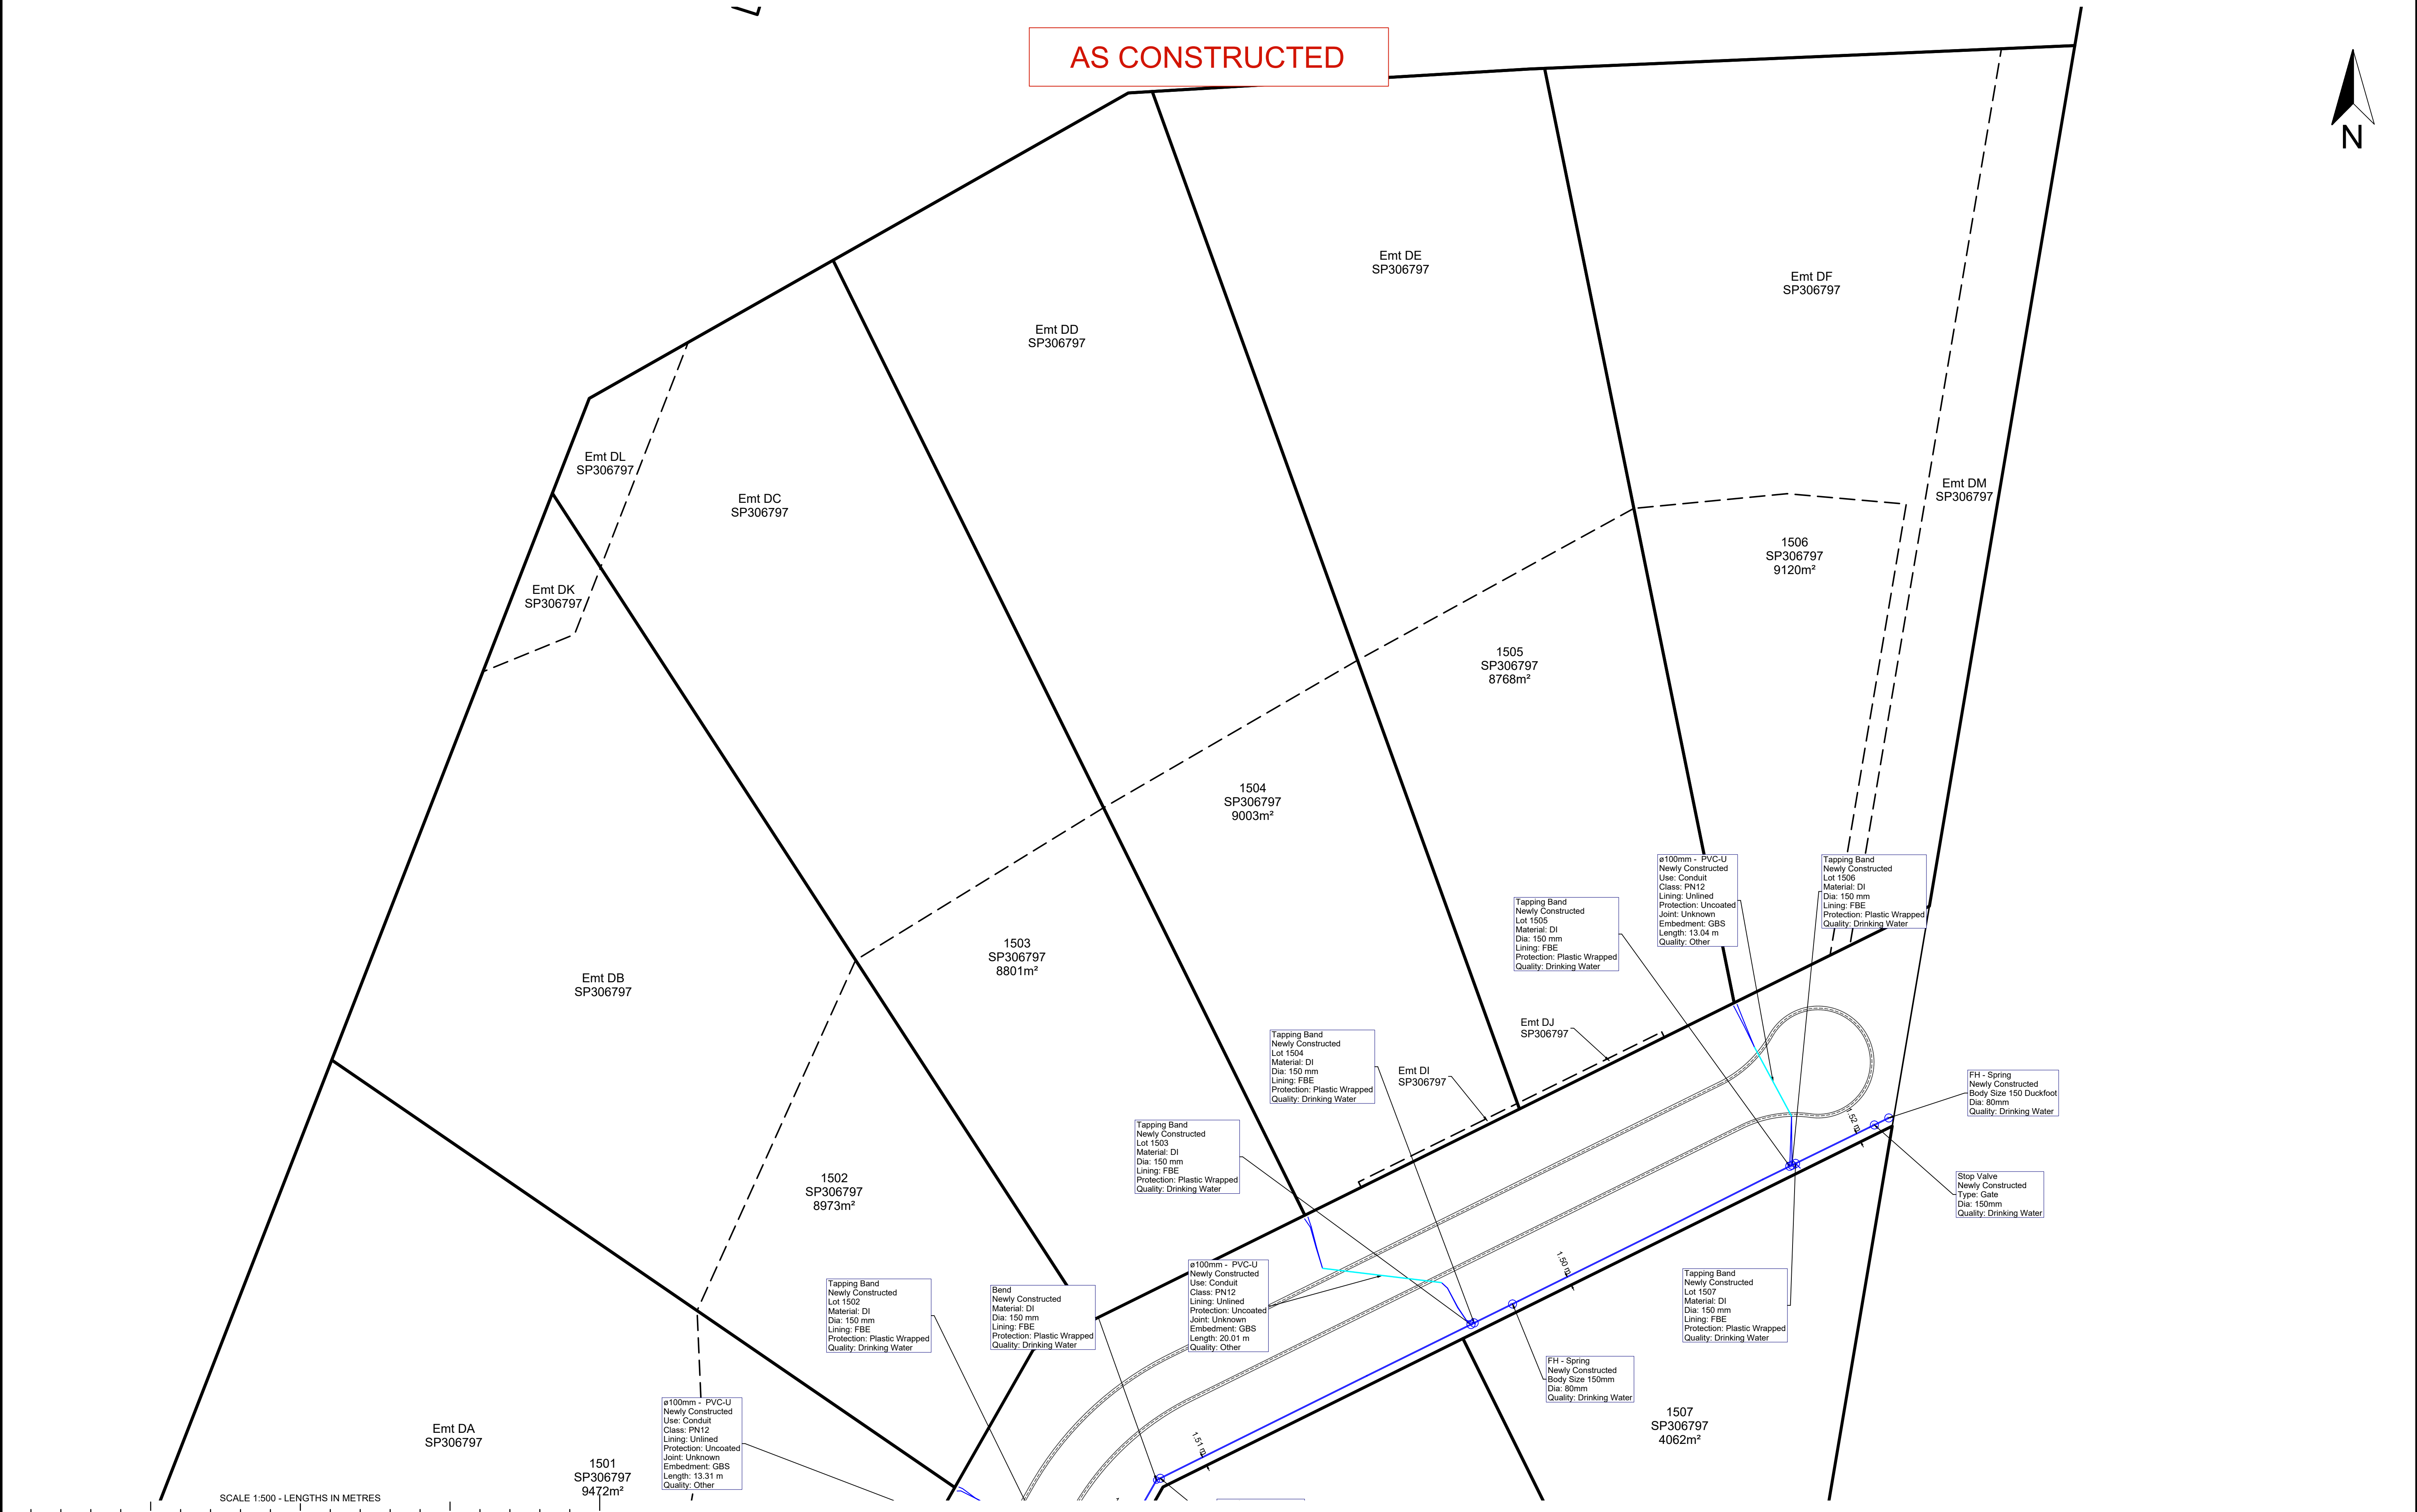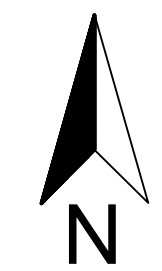

SCALE 1:500 - LENGTHS IN METRES

A1					
	B	26/04/2023	Surveyor's and Engineer's Certifications updated	AS	
	A	26/04/2023	Missing hydrants and reducer note added	AS	
	INDEX	DATE	REVISIONS	DRAWN	CHECKED
				PASSED	

**SCHLENCKER SURVEYING (QLD)**  
 Gold Coast - Brisbane  
 Consultants in Surveying,  
 Mapping & Development

A.B.N. 38 909 833 411  
 PO Box 41,  
 Helensvale QLD 4212.

Suite 206,  
 Helensvale Professional Centre  
 3 Sir John Overall Dr.,  
 Helensvale QLD 4212. EMAIL: mail@ssq.net.au

Ph: (07) 5573 6744  
 Fax: (07) 5573 6755  
 Mob: 0413 945 999

**REGISTERED SURVEYOR'S CERTIFICATION**

Schlencker Surveying (Qld) Pty Ltd (ACN 063 830 642), hereby certify that the horizontal and vertical locations, and dimensions shown in the plans contained in this electronic submission are a true and correct record of the As-constructed information.

Director (sig.)

Date: 20/04/2023  
 Reg. Surveyor No. 3337

**REGISTERED ENGINEER'S CERTIFICATION**

I, \_\_\_\_\_ hereby certify that the As-constructed information shown on the plans contained in this electronic submission is a true and correct record of the sizes, types, materials, classes etc., and it corresponds with the relevant approved Engineering Drawings.

Project Name  
 Company  
 Consultant: KN GROUP  
 RPEQ/CPENG Membership No.

Date: \_\_\_\_\_

This Plan has been prepared for Logan City Council for the purpose of recording the As-constructed details of a new service constructed under a specific Council Approval and should not be used for any other purpose. No report is made on any other services, nor any services that may exist before or be constructed after, the time of survey, or constructed under any other approval. The property boundaries, easements and lot numbers shown hereon may be proposed only and subject to registration by the Department of Natural Resources & Mines. All property information should be determined from the registered Survey Plans.

THIS NOTE IS AN INTEGRAL PART OF THIS PLAN.

WATER AS CONSTRUCTED

STAGE 15C  
 SPRING MOUNTAIN  
 OW/242/2021

LOCAL AUTHORITY	LOGAN CITY COUNCIL		
LOCALITY	NEW BEITH		
LEVEL DATUM	AHD DERIVED		
LEVEL ORIGIN	PM180644 RL: 77.302 m		
SURVEYED	ASS	DRAWN	ASS
SCALE	1 : 500	SHEET	3 OF 3
DRAWING NO.	15159 - 124B		