


LEGEND:

	New Water 150 PVC-M CL16
	New Water 100 PVC-M CL16
	New Water 150 DICL PN35
	New Water 150 DICL PN35
	Fire Hydrant
	Stop Valve
	Tee Junction
	Pipe Reducer
	End Cap
	11.25 Bend
	22.5 Bend
	House Connection

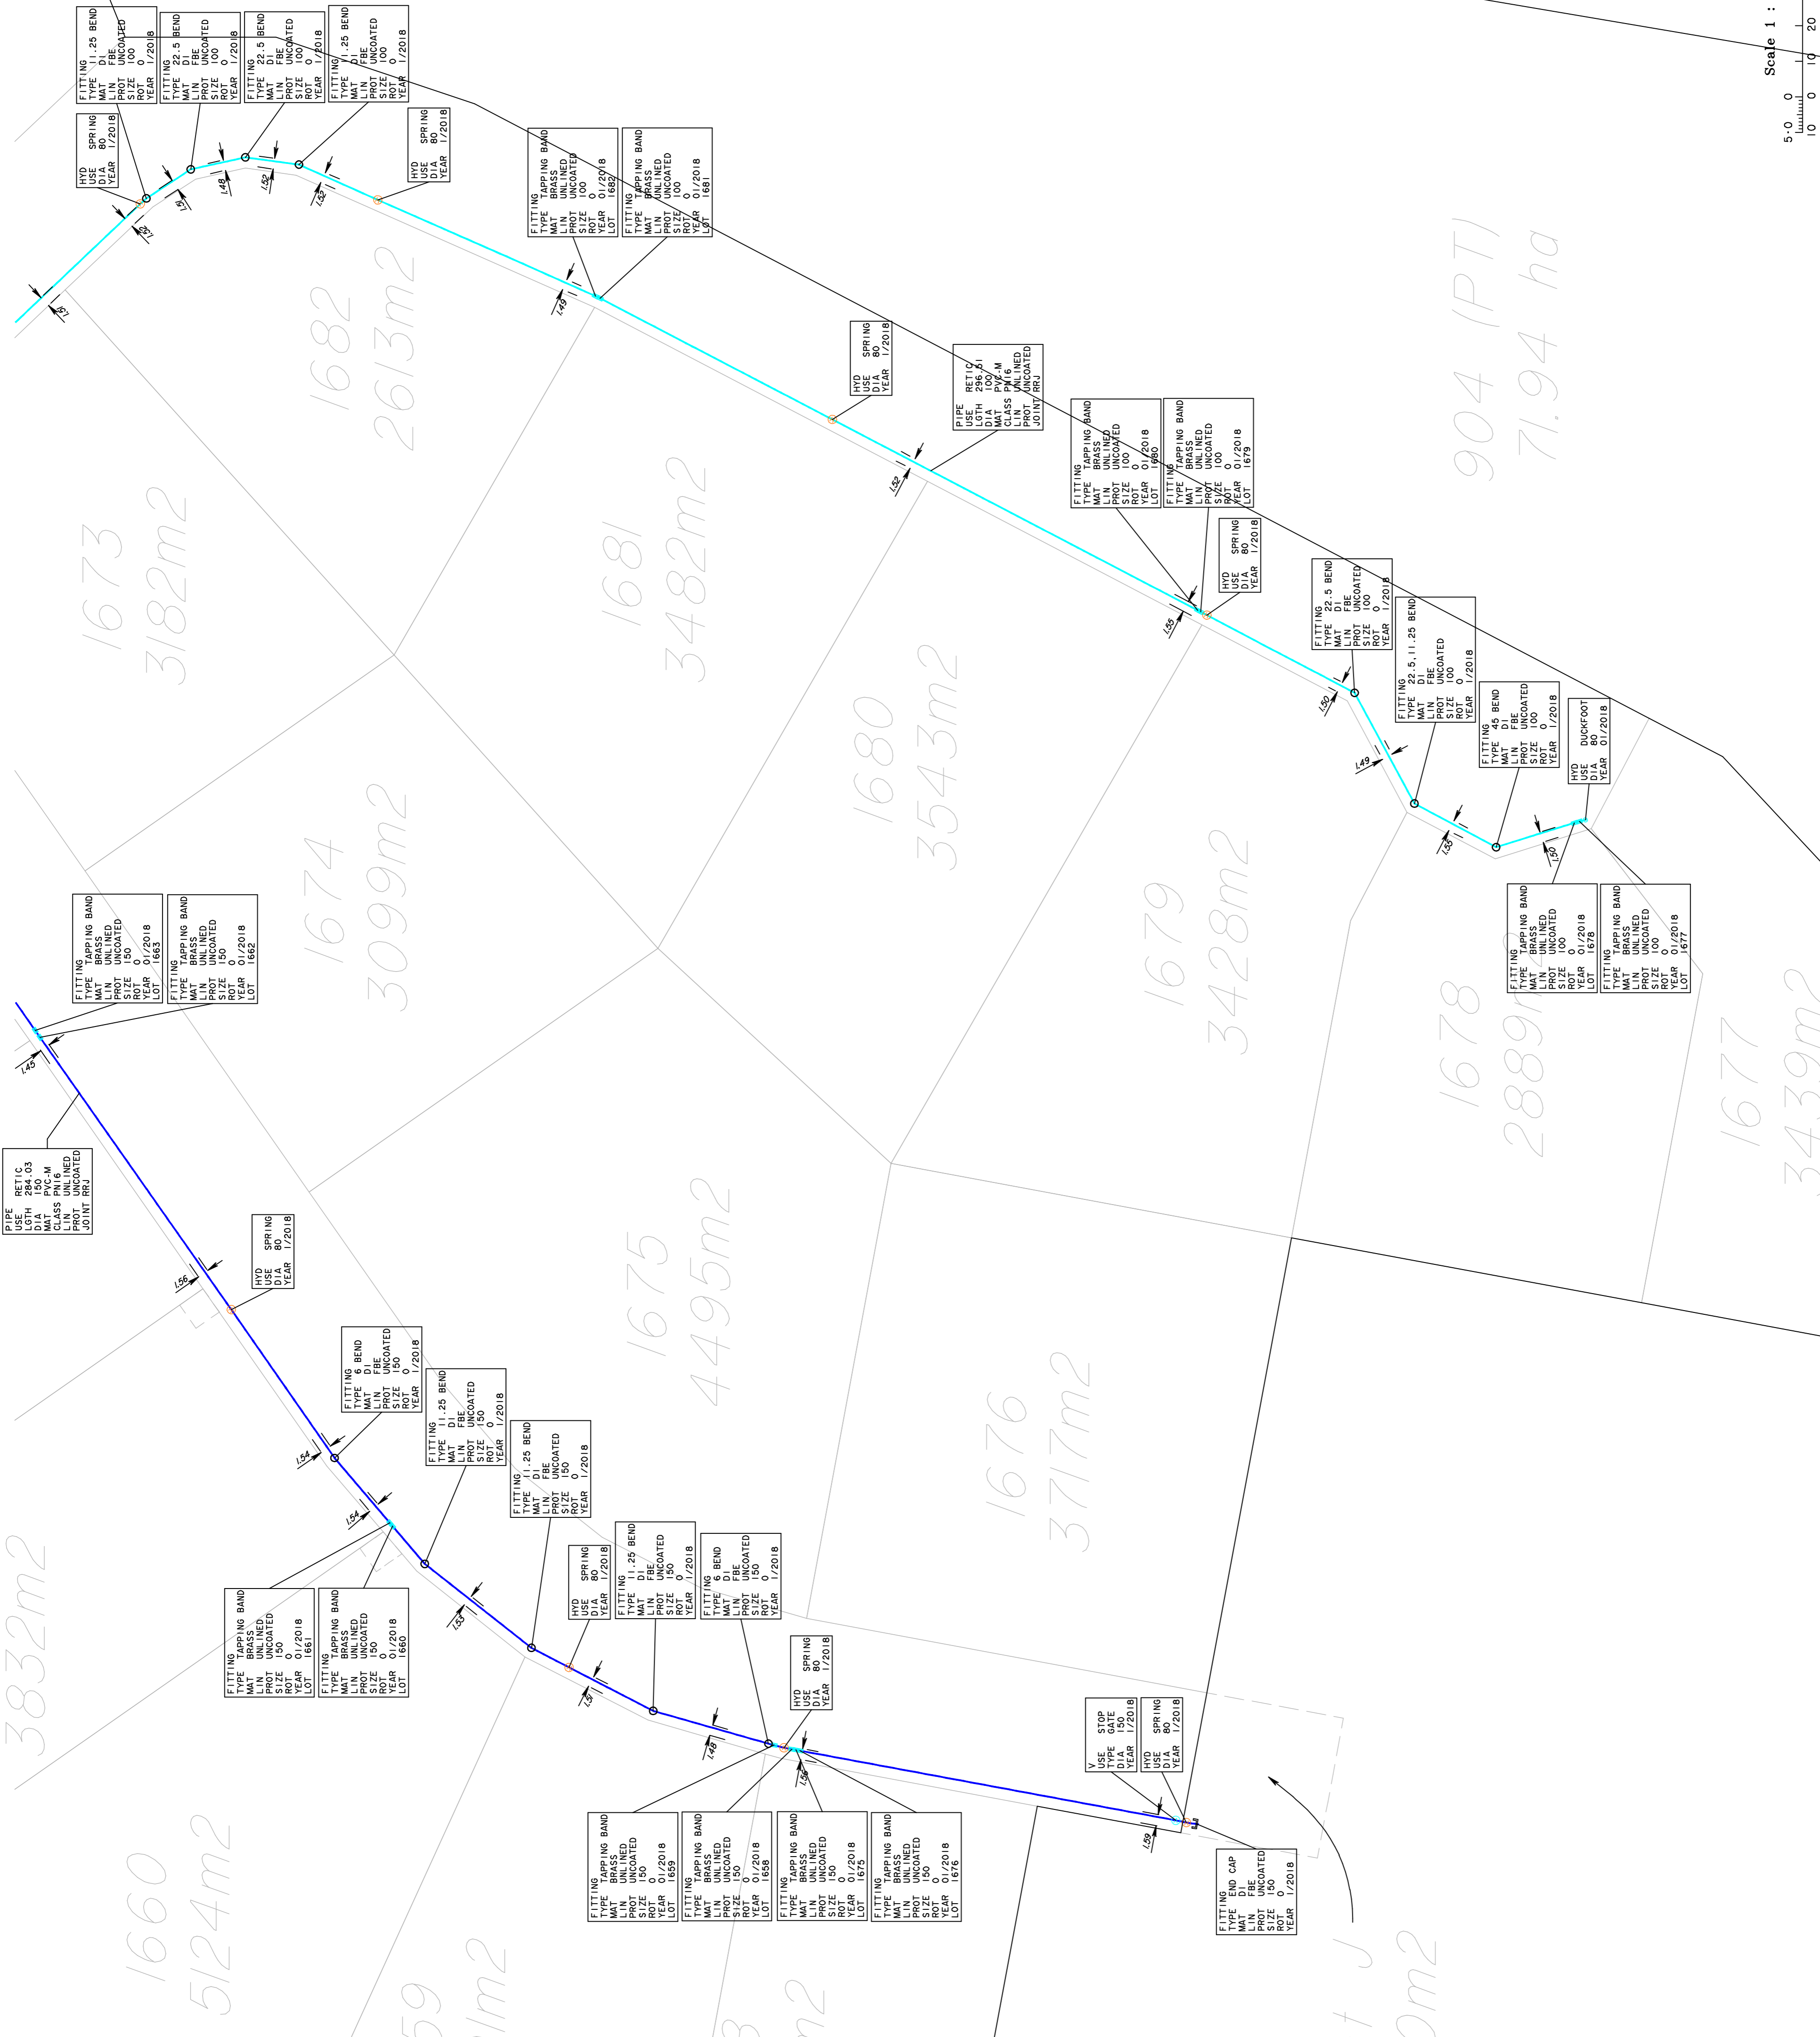

Scale 1 : 500 @ A1 paper size - Lengths are : Metres.

5.0 10.0 20.0 30.0 40.0 50.0 60.0 70.0 80.0 90.0 100.0 110.0 120.0 130.0 140.0

AS CONSTRUCTED WATER
Spring Mountain Estate, Stage 16C
GREENBANK
RL / 44 / 2008 / B
OW / 232 / 2017

SURVEYOR : PAN
DRAWN BY : SPR
JOB NO : 15159
LOCAL AUTHORITY : LOGAN
COUNTY : STANLEIGH
LEVEL DATUM : AHD Der
LEVEL ORIGIN : PM61324
RL : 69.322

SHEET : 2 OF 2

SCALE : 1:500 (@A1)

PLAN NO: 15159-31

3. I certify the approved drawings have been carefully compared with the site works as to line, levels and dimensions, and this drawing has been accurately amended; all respects as to constitute a true record of the works.

Consulting Engineer's Certification :
1. I state the works described on this drawing have been constructed under my supervision, and I or my authorised representatives have inspected the works at all stages of construction.
2. I certify that the works have been constructed in accordance with the development approval, the approved drawings, the Logan Planning Scheme 2006 and any relevant planning scheme policies and standards specifications.

Company Name :
Contractor :
RPED/CP/Eng Membership No. :
Date :
Signature :
Date :

Registered Surveyor's Certification :
I, Bruce Victor DALTON hereby certify that the vertical and horizontal locations, and dimensions, and levels of the works shown on this drawing are true and correct and correct record of the As Constructed information.

Signed :
Date: 19/01/2018
for and on behalf of Schlenker Surveying (Qld) Pty. Ltd.

SCHLENKER SURVEYING (QLD)
Gold Coast
Brisbane
Gold Coast
Ph: 07 559 833 411
Ph: 07 559 833 411
Ph: 07 559 833 411
Ph: 07 559 833 411

IMPORTANT NOTE:
This Plan has been prepared for Logan City Council for the purpose of recording the As Constructed details of a new service constructed under a specific Council Approval and should not be used for any other purpose. No report is made on any other service/s, nor any service/s that may exist before or be constructed after, the time of survey, or constructed under any other approval. The property boundaries, easements and lot numbers shown hereon may be proposed only and subject to registration by the Department of Natural Resources & Mines. All property information should be determined from the registered Survey Plans.

THIS NOTE IS AN INTEGRAL PART OF THIS PLAN.

REVISIONS	DATE	BY	CHKD
A	2.2.18	SPR	BVD
B	30.01.18	SPR	BVD