


AS CONSTRUCTED

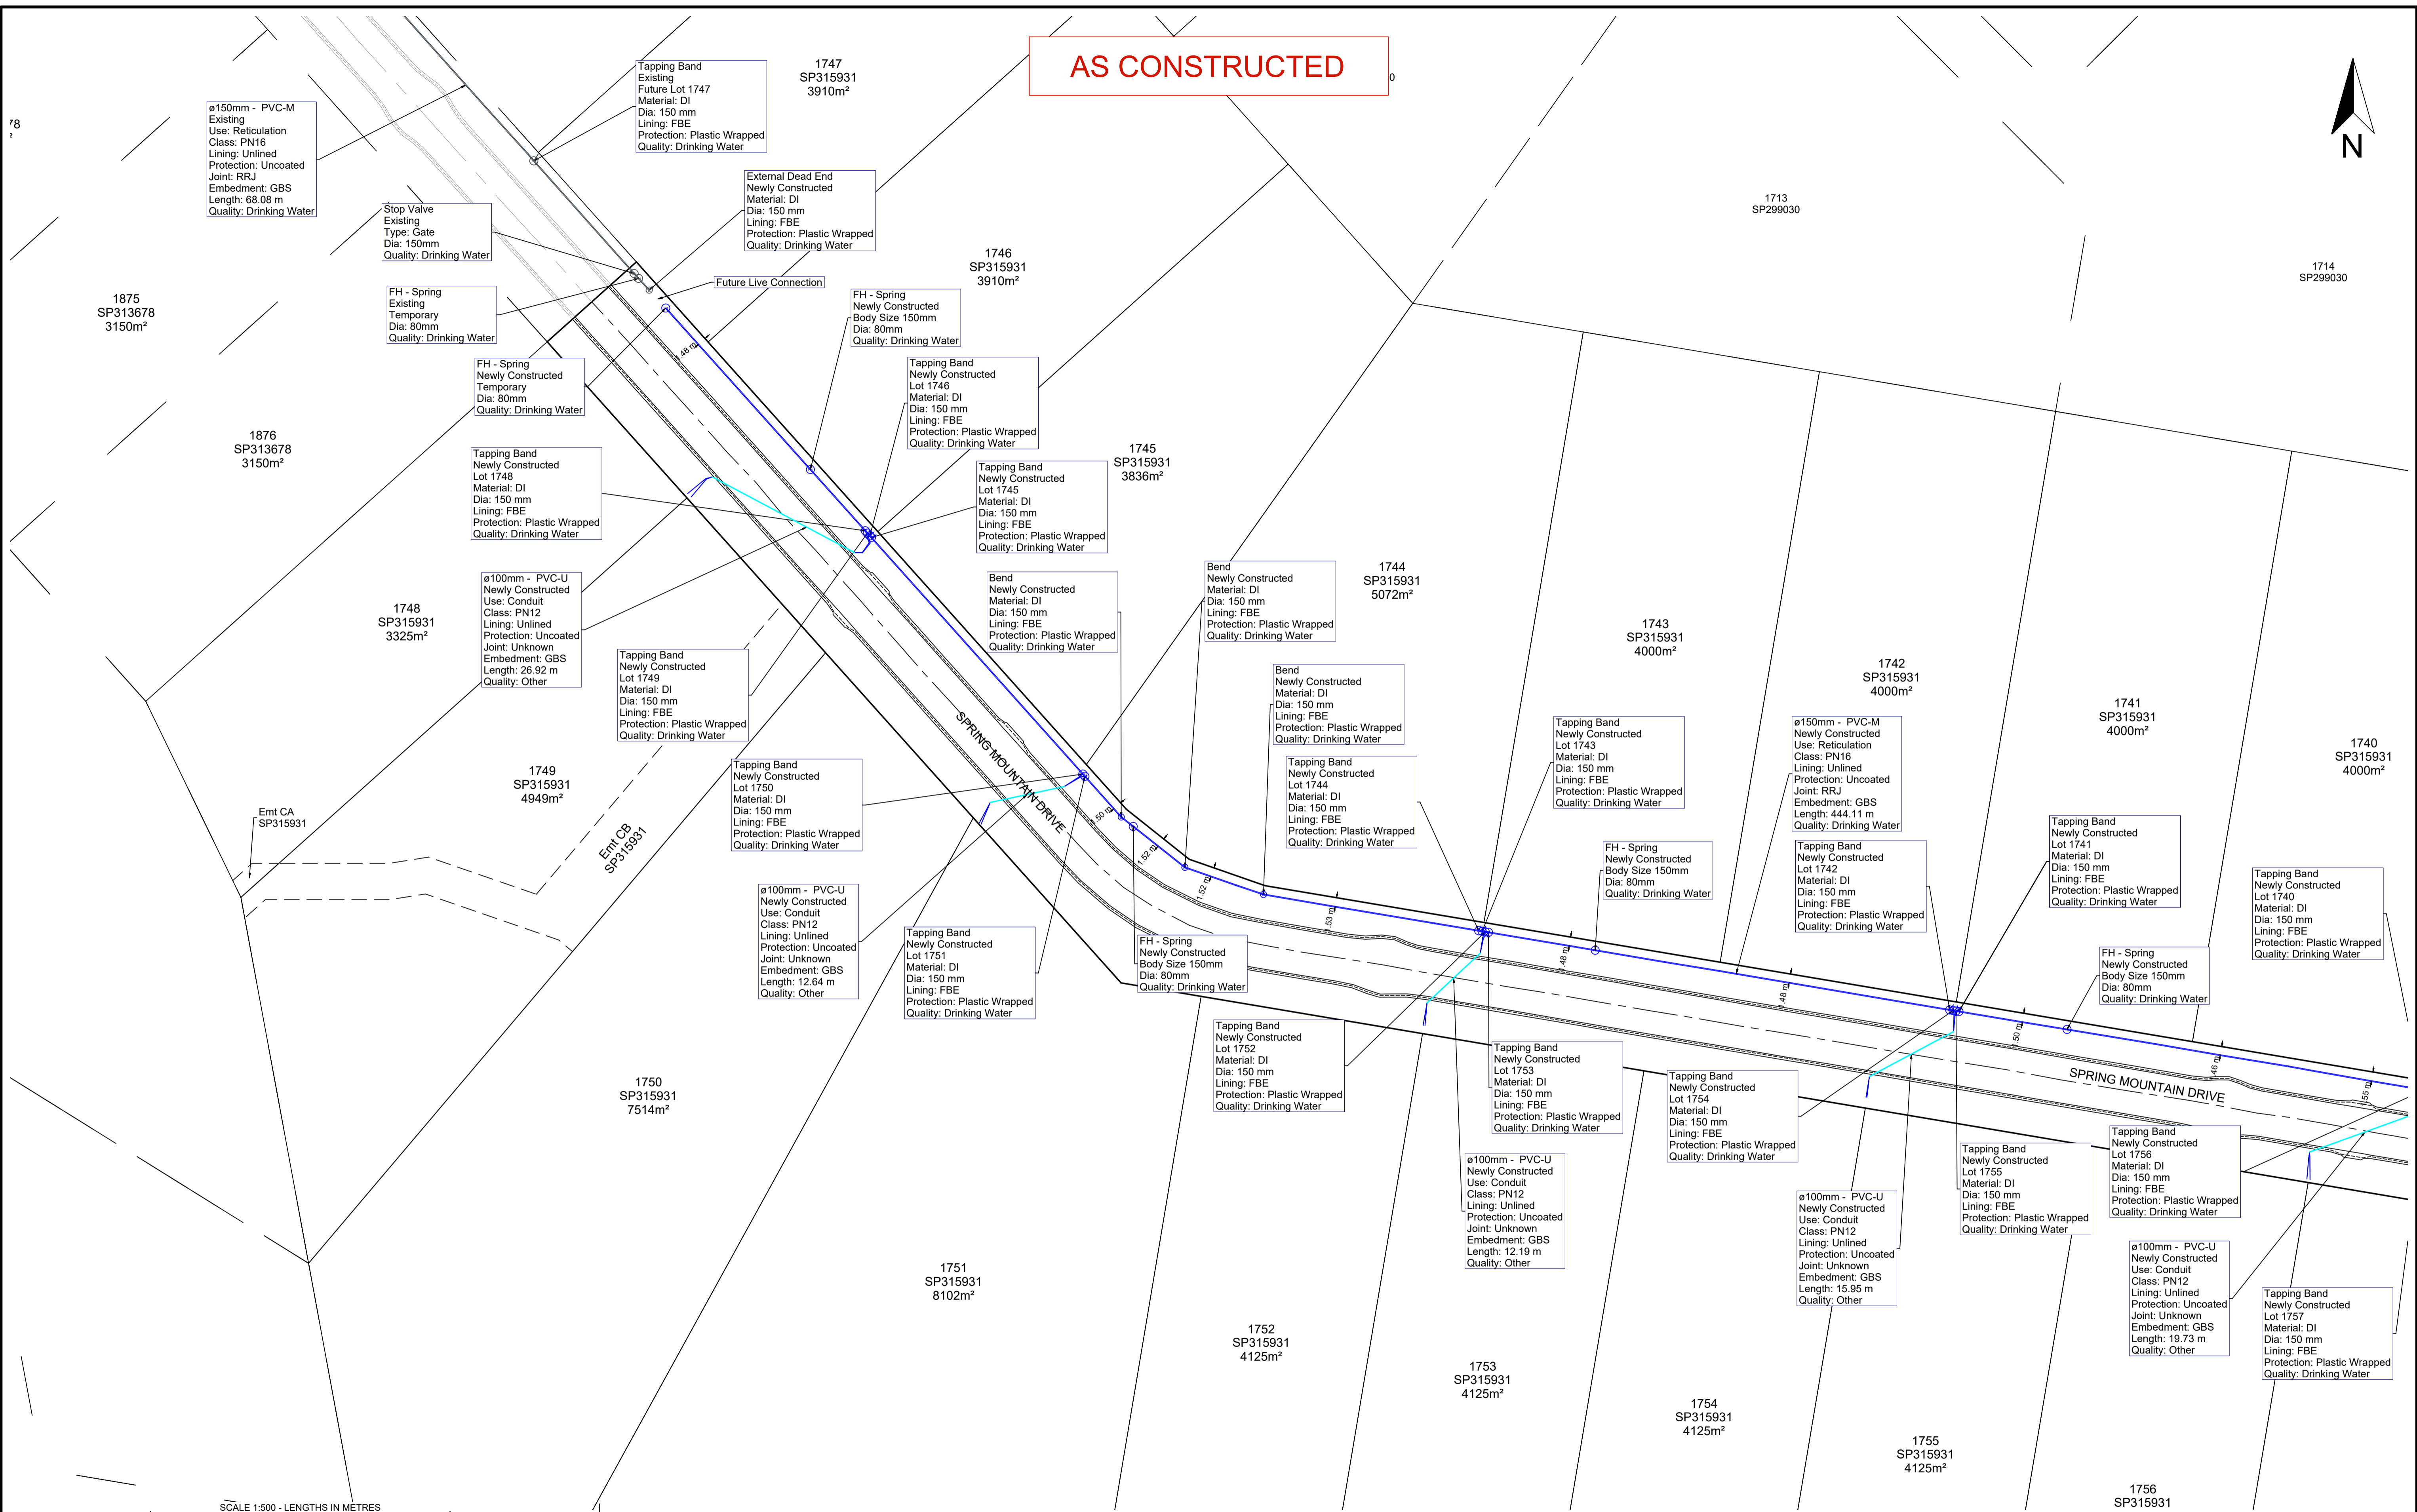

SCALE 1:500 - LENGTHS IN METRES

A1

SCHLENCKER SURVEYING (QLD)
 Gold Coast - Brisbane
 Consultants in Surveying
 Mapping & Development

A.B.N. 38 909 833 411
 PO Box 41,
 Helensvale QLD 4212.

Suite 206,
 Helensvale Professional Centre
 3 Sir John Overall Dr,
 Helensvale QLD 4212. EMAIL: mail@ssq.net.au

Ph: (07) 5573 6744
 Fax: (07) 5573 6755
 Mob: 0413 945 959

REGISTERED SURVEYOR'S CERTIFICATION

I, Bruce Victor Dalton, hereby certify that the vertical and horizontal locations and dimensions shown on this plan are a true and correct record of the As Constructed information and were located by survey.

B.V. Dalton Date: 10/05/2021

Registered Surveyor (sig.) Reg. Surveyor No. 3239
 For and on behalf of Schlencker Surveying (Qld) Pty Ltd.

REGISTERED ENGINEER'S CERTIFICATION

I, _____, hereby certify that:

1. I state the works described on this drawing have been constructed under my supervision, and I or my authorised representatives have inspected the work at all stages of construction.

2. I certify that the works have been constructed in accordance with the development approval, the approved drawings, the Scenic Rim Planning Scheme 2006 and any relevant planning scheme policies and standards specifications.

3. I certify the approved drawings have been carefully compared with the site works as to line, levels and dimensions, and this drawing has been accurately amended: all respects as to constitute a true record.

Project Name
 Company
 Consultant: KN GROUP
 RPEQ/CPENG Membership No. _____

Date: _____



This Plan has been prepared for Logan City Council for the purpose of recording the As Constructed details of a new service constructed under a specific Council Approval and should not be used for any other purpose. No report is made on any other services, nor any services that may exist before or be constructed after, the time of survey, or constructed under any other approval. The property boundaries, easements and lot numbers shown hereon may be proposed only and subject to registration by the Department of Natural Resources & Mines. All property information should be determined from the registered Survey Plans.

THIS NOTE IS AN INTEGRAL PART OF THIS PLAN.

WATER AS CONSTRUCTED
STAGE 17C
SPRING MOUNTAIN
 OW/116/2020

LOCAL AUTHORITY	LOGAN CITY COUNCIL		
LOCALITY	NEW BEITH		
LEVEL DATUM	AHD DERIVED		
LEVEL ORIGIN	PM186509	RL:	94.025 m
SURVEYED	JRM	DRAWN	ASS
SCALE	1:500	SHEET	1 OF 2
DRAWING NO.	15159 - 111		

AS CONSTRUCTED

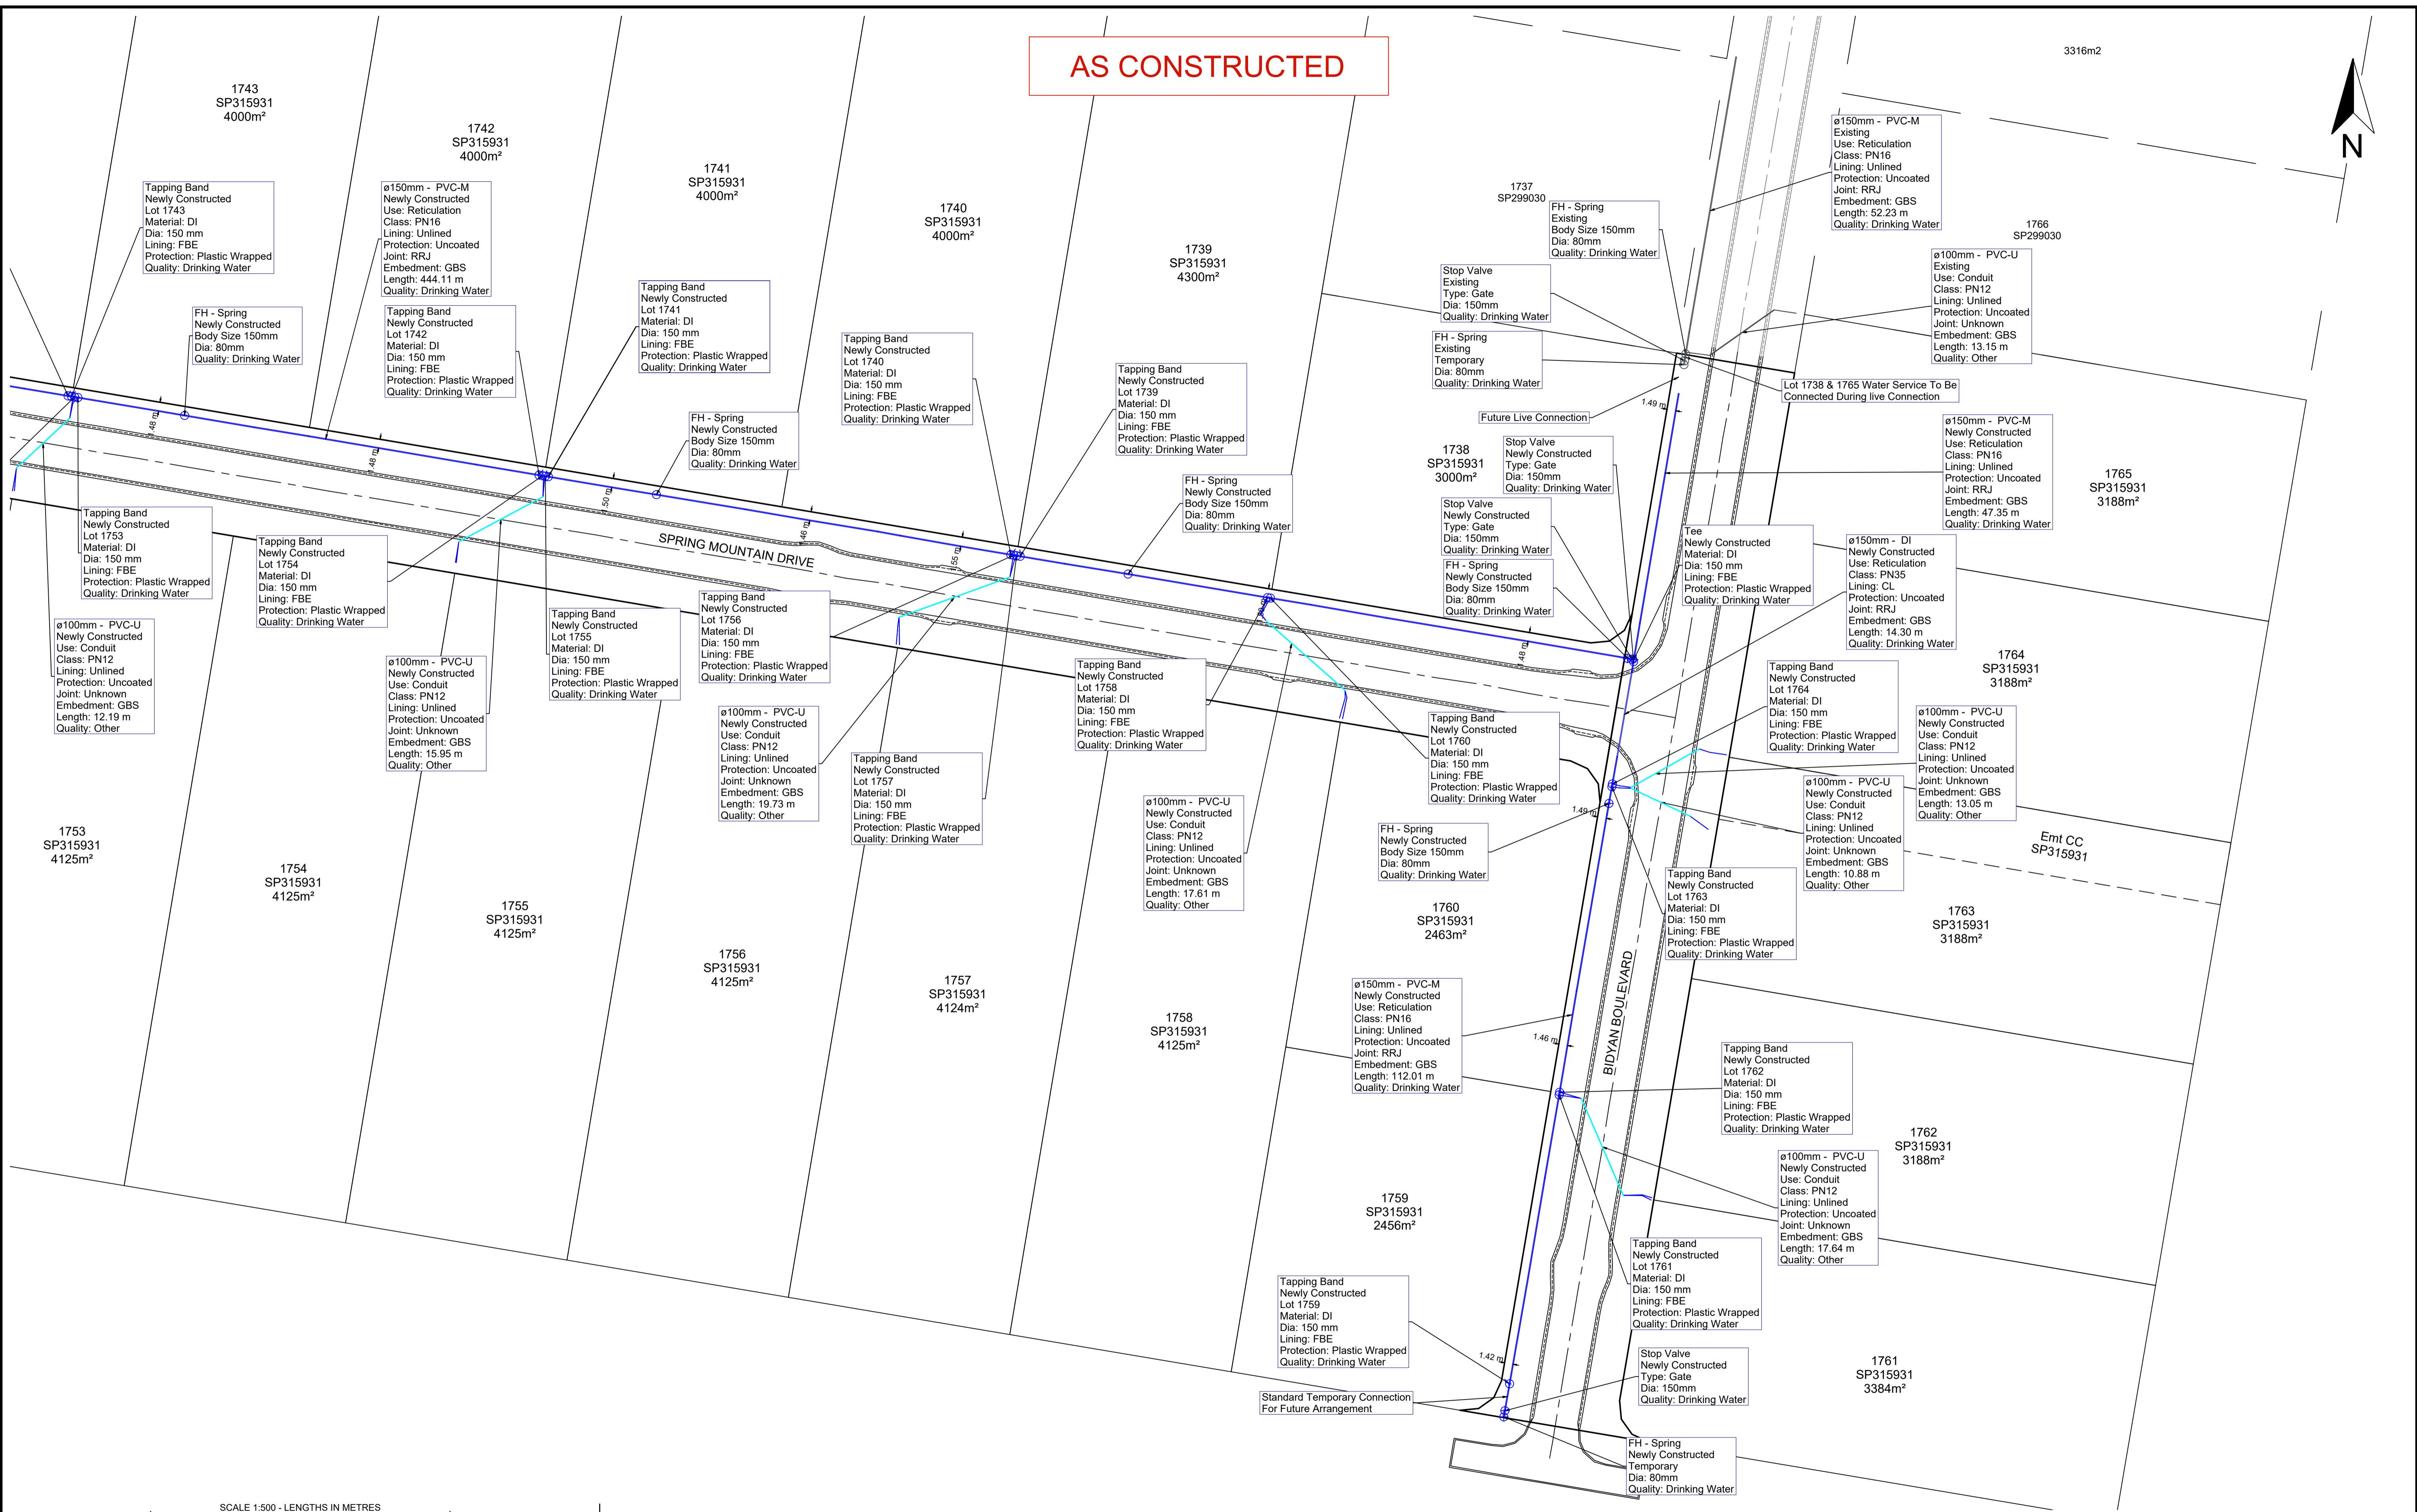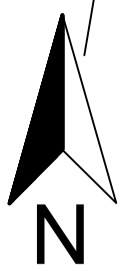

SCALE 1:500 - LENGTHS IN METRES

A1	INDEX	DATE	REVISIONS	DRAWN	CHECKED	PASSED

SCHLENCKER SURVEYING (QLD)
 Gold Coast - Brisbane
 Consultants in Surveying,
 Mapping & Development

A.B.N. 38 909 833 411
 PO Box 41,
 Helensvale QLD 4212.

Suite 206,
 Helensvale Professional Centre
 3 Sir John Overall Dr,
 Helensvale QLD 4212. EMAIL: mail@ssq.net.au

Ph: (07) 5573 6744
 Fax: (07) 5573 6755
 Mob: 0413 945 959

REGISTERED SURVEYOR'S CERTIFICATION

I, Bruce Victor Dalton, hereby certify that the vertical and horizontal locations and dimensions shown on this plan are a true and correct record of the As Constructed information and were located by survey.

B.V. Dalton
 Registered Surveyor (sig.) Reg. Surveyor No. 3239
 For and on behalf of Schlencker Surveying (Qld) Pty Ltd.

Date: 10/05/2021

REGISTERED ENGINEER'S CERTIFICATION

I, _____, hereby certify that:

1. I state the works described on this drawing have been constructed under my supervision, and I or my authorised representatives have inspected the work at all stages of construction.

2. I certify that the works have been constructed in accordance with the development approval, the approved drawings, the Scenic Rim Planning Scheme 2006 and any relevant planning scheme policies and standards specifications.

3. I certify the approved drawings have been carefully compared with the site works as to line, levels and dimensions, and this drawing has been accurately amended: all respects as to constitute a true record.

Project Name
 Company
 Consultant: KN GROUP
 RPEQ/CPEng Membership No. _____

Date: _____

This Plan has been prepared for Logan City Council for the purpose of recording the As Constructed details of a new service constructed under a specific Council Approval and should not be used for any other purpose. No report is made on any other services, nor any services that may exist before or be constructed after, the time of survey, or constructed under any other approval. The property boundaries, easements and lot numbers shown herein may be proposed only and subject to registration by the Department of Natural Resources & Mines. All property information should be determined from the registered Survey Plans.

THIS NOTE IS AN INTEGRAL PART OF THIS PLAN.


WATER AS CONSTRUCTED

STAGE 17C

SPRING MOUNTAIN

OW/116/2020

LOCAL AUTHORITY	LOGAN CITY COUNCIL		
LOCALITY	NEW BEITH		
LEVEL DATUM	AHD DERIVED		
LEVEL ORIGIN	PM186509	RL:	94.025 m
SURVEYED	JRM	DRAWN	ASS
SCALE	1:500	SHEET	2 OF 2
DRAWING NO.	15159 - 111		

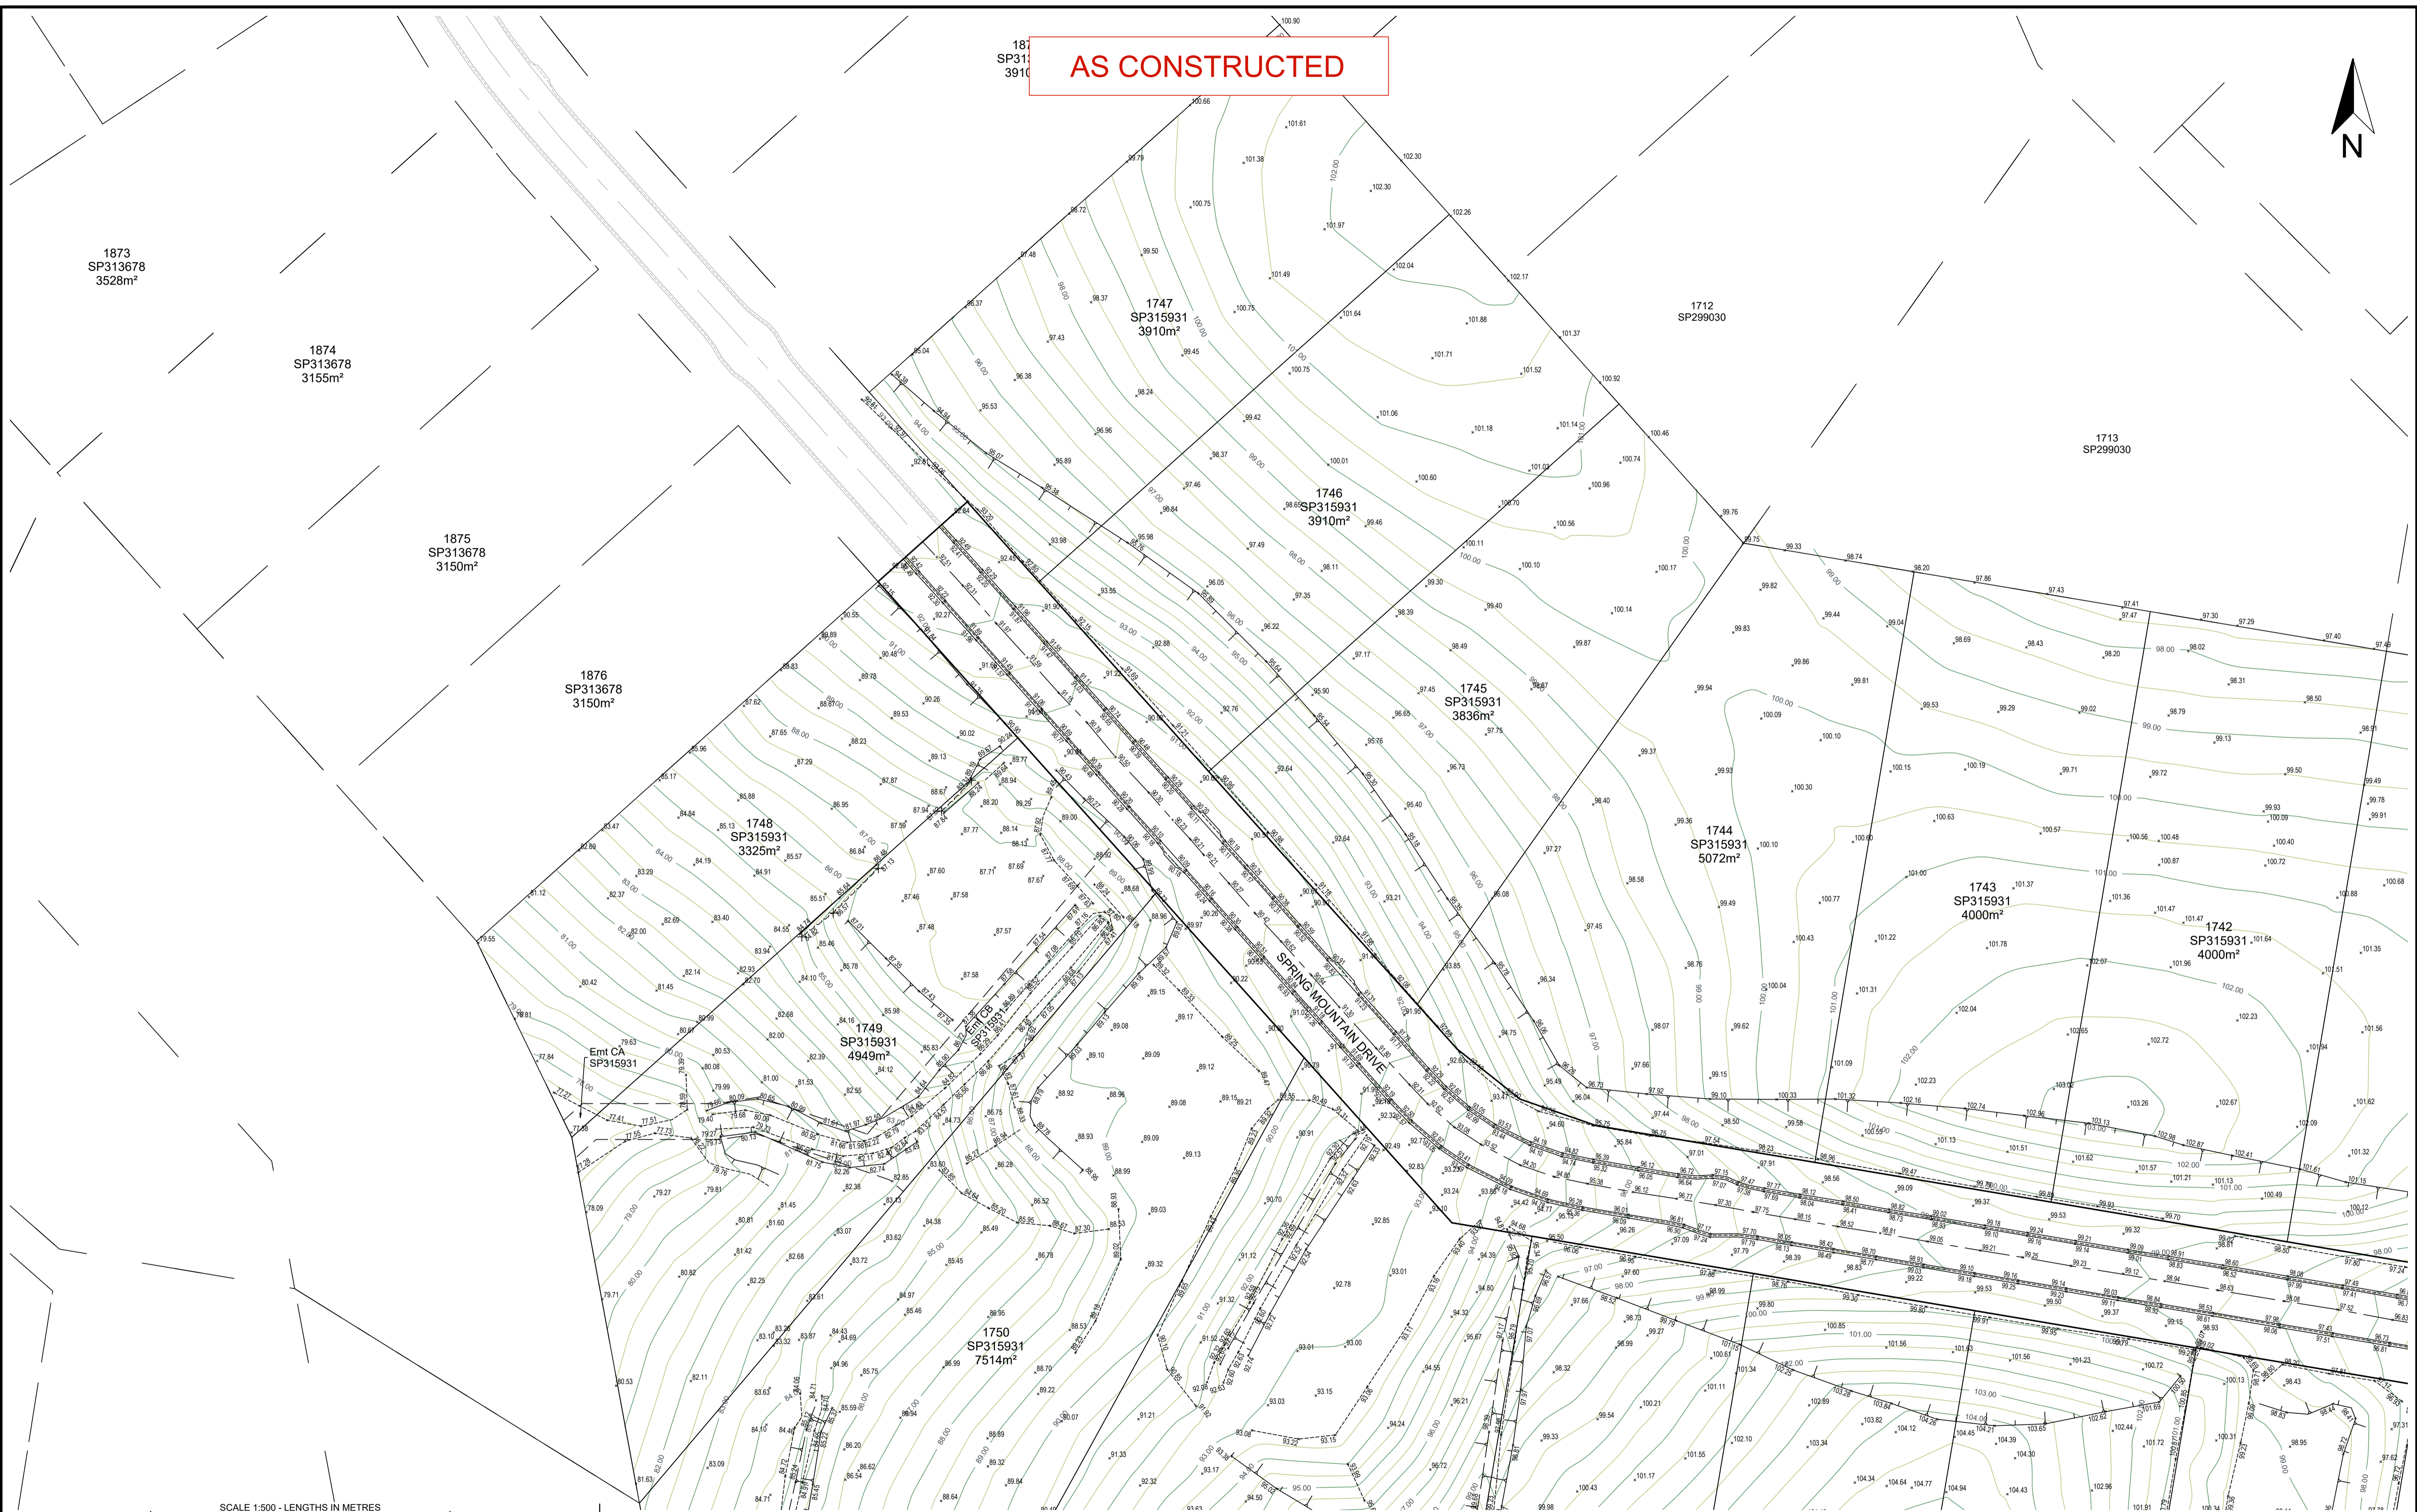

SCALE 1:500 - LENGTHS IN METRES

A1	A	21/6/2021	Amendment to lot levels after remedial work	ASS	BVD
	INDEX	DATE	REVISIONS	DRAWN	CHECKED PASSED

SCHLENCKER SURVEYING (QLD)
 Gold Coast - Brisbane
 Consultants in Surveying,
 Mapping & Development



A.B.N. 38 909 833 411
 PO Box 41,
 Helensvale QLD 4212.

Suite 206,
 Helensvale Professional Centre
 3 Sir John Overall Dr,
 Helensvale QLD 4212. EMAIL: mail@ssq.net.au

Ph: (07) 5573 6744
 Fax: (07) 5573 6755
 Mob: 0413 945 959

REGISTERED SURVEYOR'S CERTIFICATION

I, Bruce Victor Dalton, hereby certify that the vertical and horizontal locations and dimensions shown on this plan are a true and correct record of the As Constructed information and were located by survey.

BVD Date: 10/05/2021

Registered Surveyor (sig.) Reg. Surveyor No. 3239
 For and on behalf of Schlencker Surveying (Qld) Pty Ltd.

REGISTERED ENGINEER'S CERTIFICATION

I, _____, hereby certify that:

1. I state the the works described on this drawing have been constructed under my supervision, and I or my authorised representatives have inspected the work at all stages of construction.

2. I certify that the works have been constructed in accordance with the development approval, the approved drawings, the Scenic Rim Planning Scheme 2006 and any relevant planning scheme policies and standards specifications.

Project Name
 Company
 Consultant: KN GROUP
 RPEQ/CPENG Membership No. _____

Date: _____

This Plan has been prepared for Logan City Council for the purpose of recording the As Constructed details of a new service constructed under a specific Council Approval and should not be used for any other purpose. No report is made on any other services, nor any services that may exist before or be constructed after, the time of survey, or constructed under any other approval. The property boundaries, easements and lot numbers shown herein may be proposed only and subject to registration by the Department of Natural Resources & Mines. All property information should be determined from the registered Survey Plans.

THIS NOTE IS AN INTEGRAL PART OF THIS PLAN.


SURFACE AS CONSTRUCTED

STAGE 17C

SPRING MOUNTAIN

OW/116/2020

LOCAL AUTHORITY	LOGAN CITY COUNCIL		
LOCALITY	NEW BEITH		
LEVEL DATUM	AHD DERIVED		
SURVEYED	JRM	DRAWN	ASS
SCALE	1 : 500	SHEET	1 OF 3
DRAWING NO.	15159 - 112A		

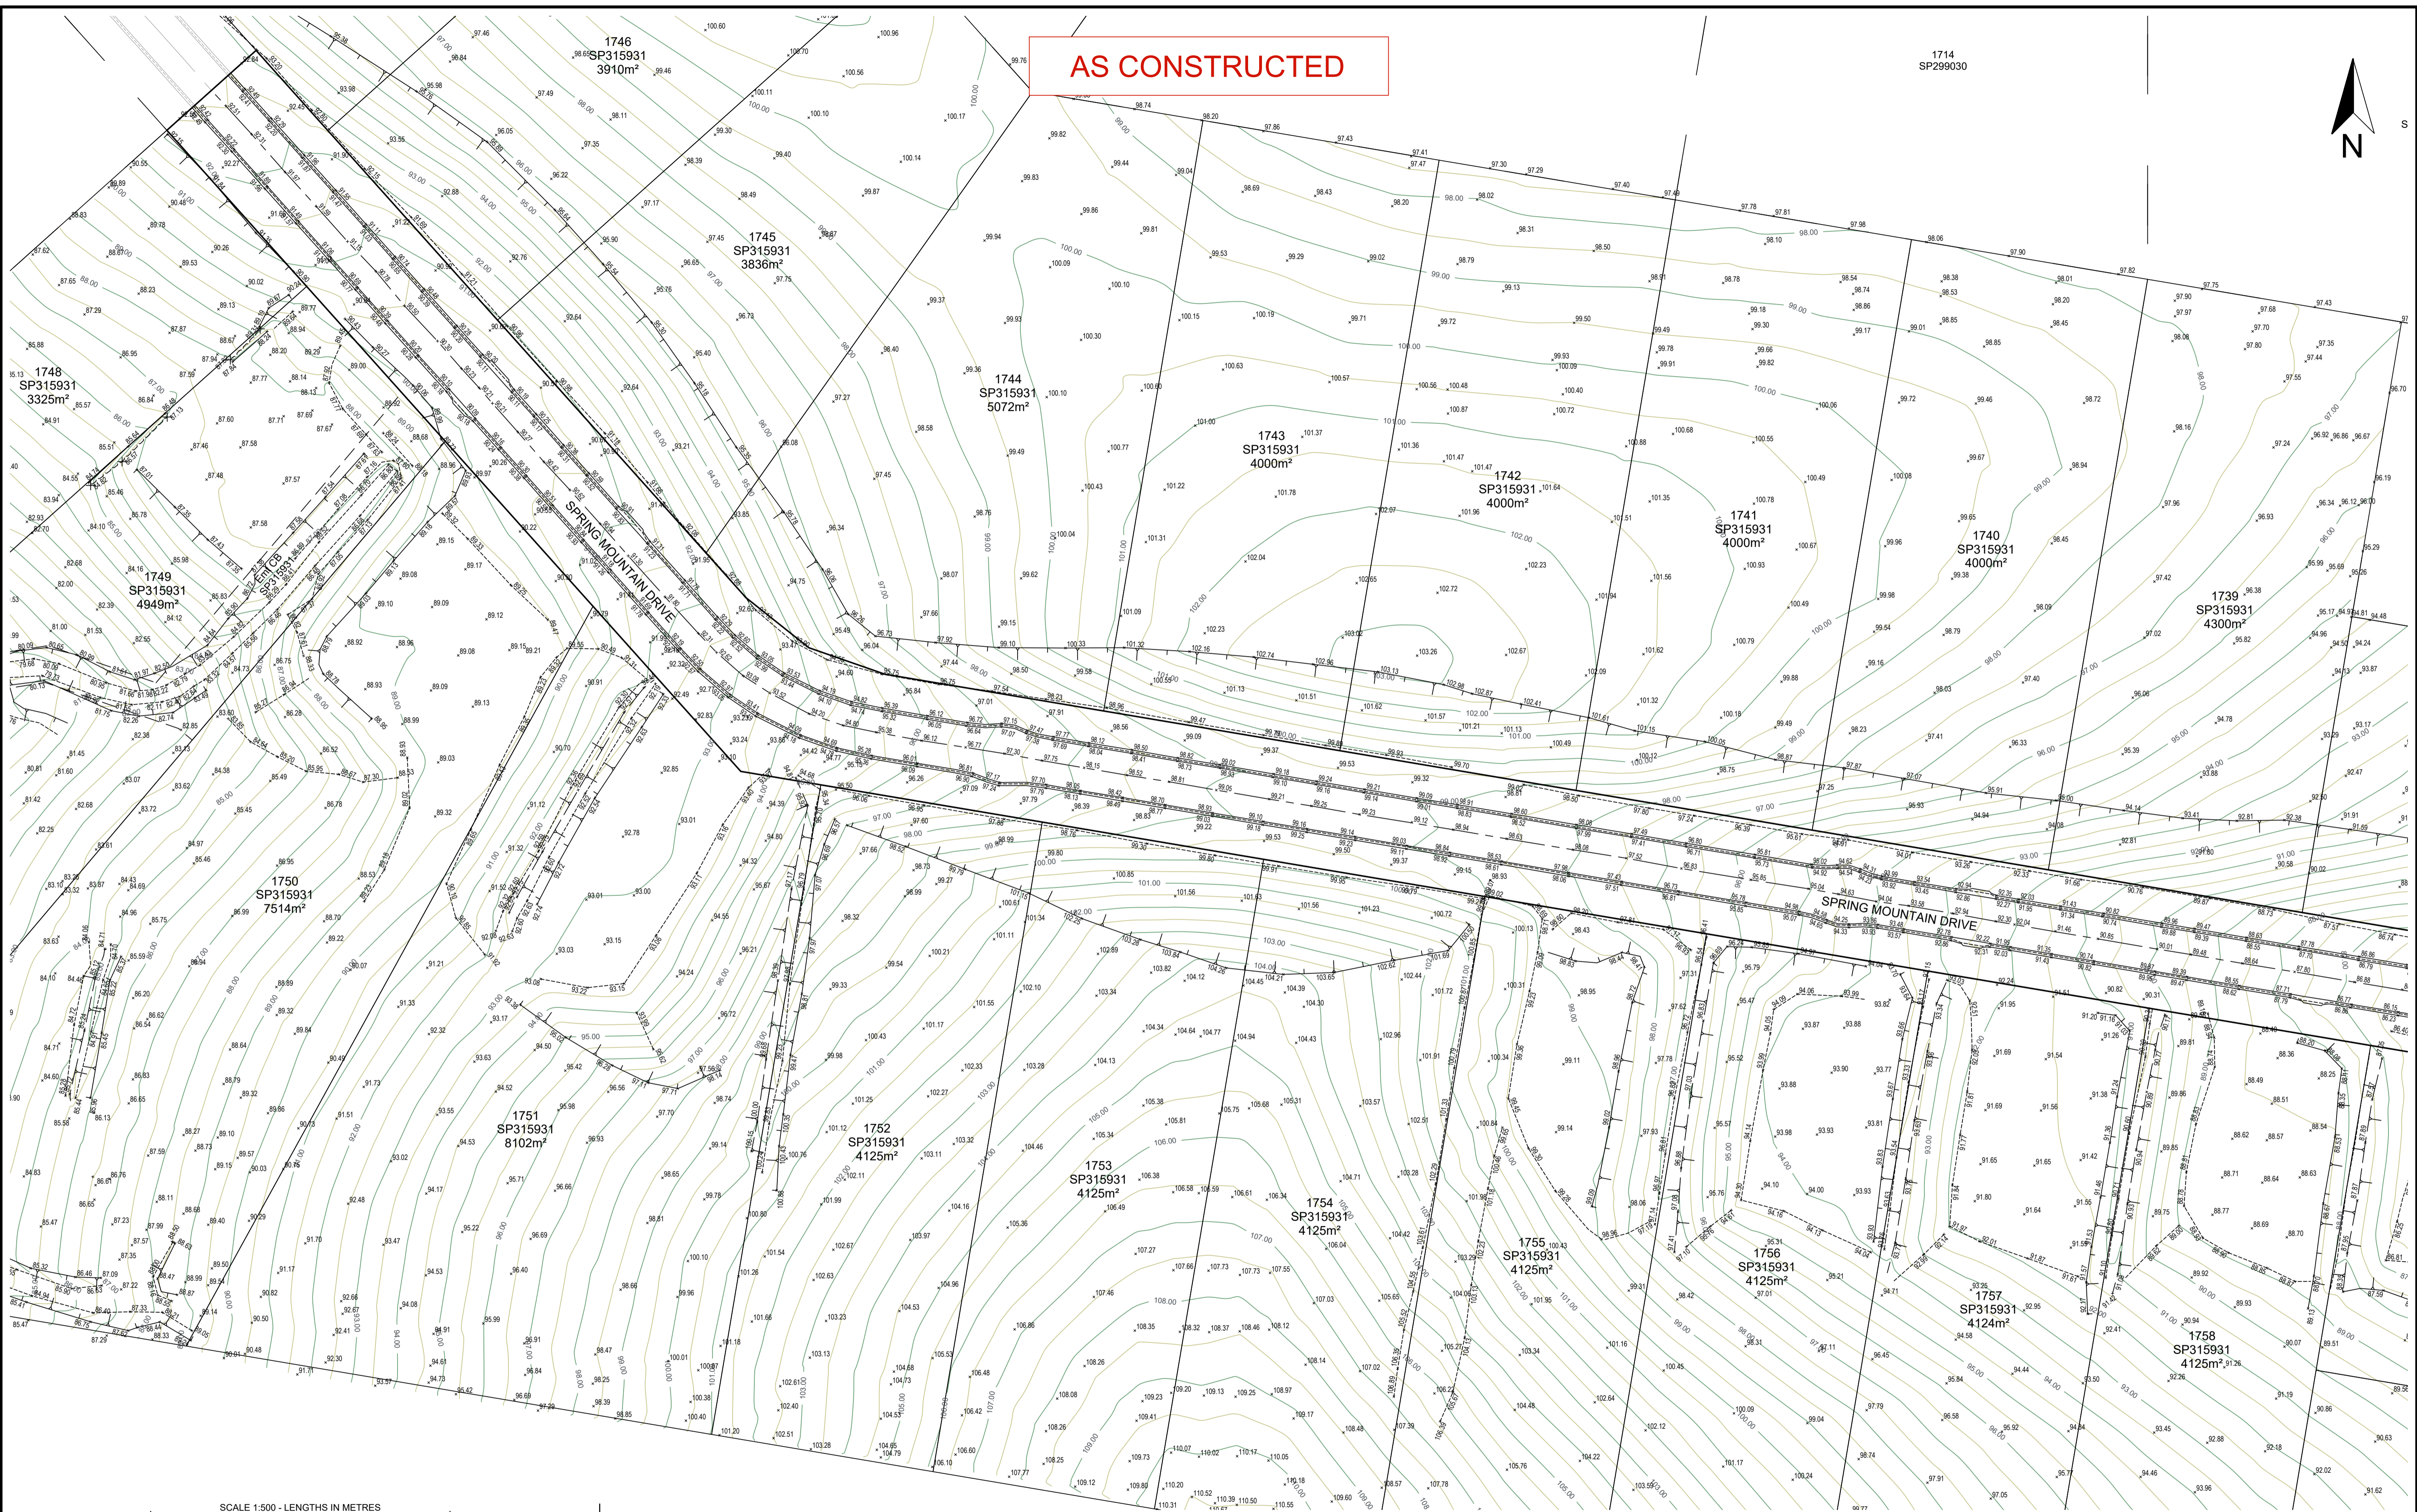

AS CONSTRUCTED

SCALE 1:500 - LENGTHS IN METRES

A1	INDEX	DATE	REVISIONS	DRAWN	CHECKED	PASSED
	A	21/6/2021	Amendment to lot levels after remedial work	ASS	BVD	

SCHLENCKER SURVEYING (QLD)
 Gold Coast - Brisbane
 Consultants in Surveying
 Mapping & Development



A.B.N. 38 909 833 411
 PO Box 41,
 Helensvale QLD 4212.

Suite 206,
 Helensvale Professional Centre
 3 Sir John Overall Dr,
 Helensvale QLD 4212. EMAIL: mail@ssq.net.au

Ph: (07) 5573 8744
 Fax: (07) 5573 8755
 Mob: (0413) 945 959

REGISTERED SURVEYOR'S CERTIFICATION

I, Bruce Victor Dalton, hereby certify that the vertical and horizontal locations and dimensions shown on this plan are a true and correct record of the As Constructed information and were located by survey.

B.V. Dalton Date: 10/05/2021

Registered Surveyor (sig.) Reg. Surveyor No. 3239
 For and on behalf of Schlencker Surveying (Qld) Pty Ltd.

REGISTERED ENGINEER'S CERTIFICATION

I, _____, hereby certify that:

1. I state the works described on this drawing have been constructed under my supervision, and I or my authorised representatives have inspected the work at all stages of construction.

2. I certify that the works have been constructed in accordance with the development approval, the approved drawings, the Scenic Rim Planning Scheme 2006 and any relevant planning scheme policies and standards specifications.

Project Name
 Company
 Consultant: KN GROUP
 RPEQ/CPEng Membership No. _____

Date: _____

This Plan has been prepared for Logan City Council for the purpose of recording the As Constructed details of a new service constructed under a specific Council Approval and should not be used for any other purpose. No report is made on any other services, nor any services that may exist before or be constructed after, the time of survey, or constructed under any other approval. The property boundaries, easements and lot numbers shown herein may be proposed only and subject to registration by the Department of Natural Resources & Mines. All property information should be determined from the registered Survey Plans.


THIS NOTE IS AN INTEGRAL PART OF THIS PLAN.

SURFACE AS CONSTRUCTED

STAGE 17C
 SPRING MOUNTAIN

OW/116/2020

LOCAL AUTHORITY	LOGAN CITY COUNCIL		
LOCALITY	NEW BEITH		
LEVEL DATUM	AHD DERIVED		
LEVEL ORIGIN	PM186509 RL: 94.025 m		
SURVEYED	JRM	DRAWN	ASS
SCALE	1 : 500	SHEET	2 OF 3
DRAWING NO.		15159 - 112A	

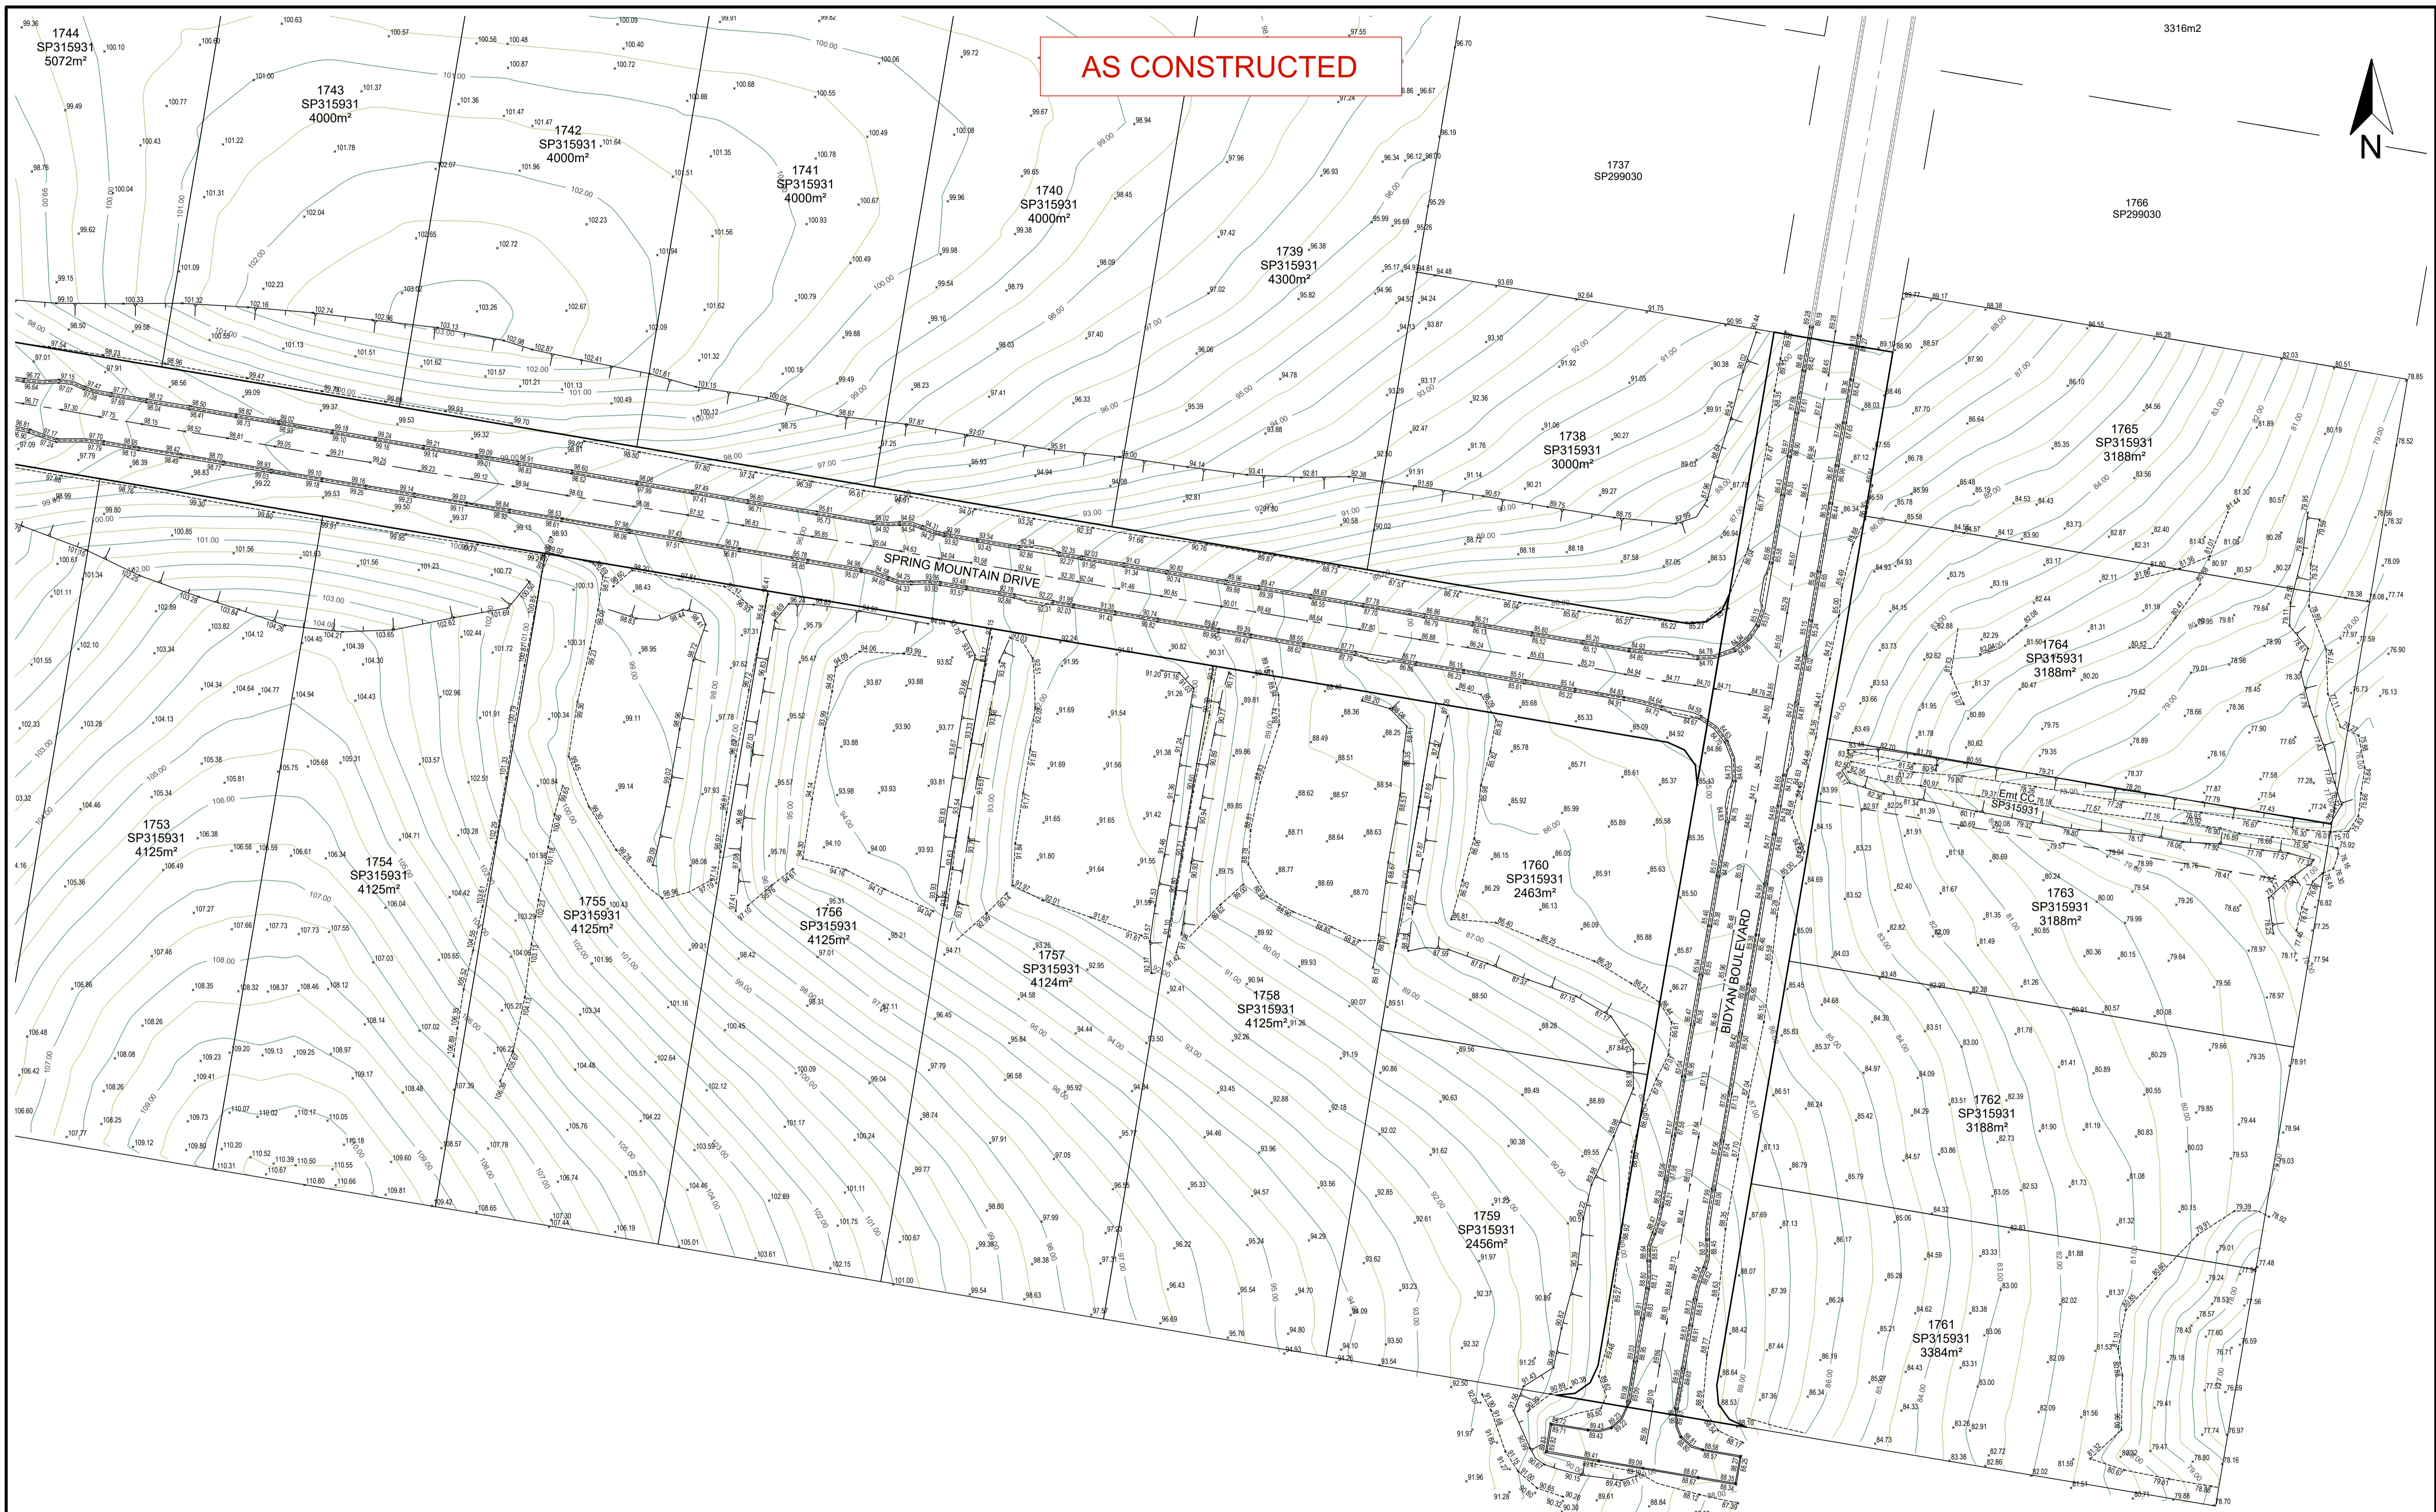

AS CONSTRUCTED

SCALE 1:500 - LENGTHS IN METRES

A1	INDEX	DATE	REVISONS	DRAWN	CHECKED	PASSED
	A	21/6/2021	Amendment to lot levels after remedial work	ASS	BVD	

SCHLENCKER SURVEYING (QLD)
 Gold Coast - Brisbane
 Consultants in Surveying
 Mapping & Development



A.B.N. 38 909 833 411
 PO Box 41,
 Helensvale QLD 4212.

Suite 206,
 Helensvale Professional Centre
 3 Sir John Overall Dr,
 Helensvale QLD 4212. EMAIL: mail@ssq.net.au

Ph: (07) 5573 6744
 Fax: (07) 5573 6755
 Mob: 0413 945 959

REGISTERED SURVEYOR'S CERTIFICATION

I, Bruce Victor Dalton, hereby certify that the vertical and horizontal locations and dimensions shown on this plan are a true and correct record of the As Constructed information and were located by survey.

B.V. Dalton Date: 10/05/2021

Registered Surveyor (sig.) Reg. Surveyor No. 3239
 For and on behalf of Schlencker Surveying (Qld) Pty Ltd.

REGISTERED ENGINEER'S CERTIFICATION

I, _____, hereby certify that:

1. I state the works described on this drawing have been constructed under my supervision, and I or my authorised representatives have inspected the work at all stages of construction.

2. I certify that the works have been constructed in accordance with the development approval, the approved drawings, the Scenic Rim Planning Scheme 2006 and any relevant planning scheme policies and standards specifications.

Project Name
 Company
 Consultant: KN GROUP
 RPEQ/CPENG Membership No. _____

Date: _____

This Plan has been prepared for Logan City Council for the purpose of recording the As Constructed details of a new service constructed under a specific Council Approval and should not be used for any other purpose. No report is made on any other services, nor any services that may exist before or be constructed after, the time of survey, or constructed under any other approval. The property boundaries, easements and lot numbers shown herein may be proposed only and subject to registration by the Department of Natural Resources & Mines. All property information should be determined from the registered Survey Plans.

THIS NOTE IS AN INTEGRAL PART OF THIS PLAN.


SURFACE AS CONSTRUCTED

STAGE 17C
 SPRING MOUNTAIN

OW/116/2020

LOCAL AUTHORITY	LOGAN CITY COUNCIL		
LOCALITY	NEW BEITH		
LEVEL DATUM	AHD DERIVED		
LEVEL ORIGIN	PM186509 RL: 94.025 m		
SURVEYED	JRM	DRAWN	ASS
SCALE	1:500	SHEET	3 OF 3
DRAWING NO.	15159 - 112A		

AS CONSTRUCTED

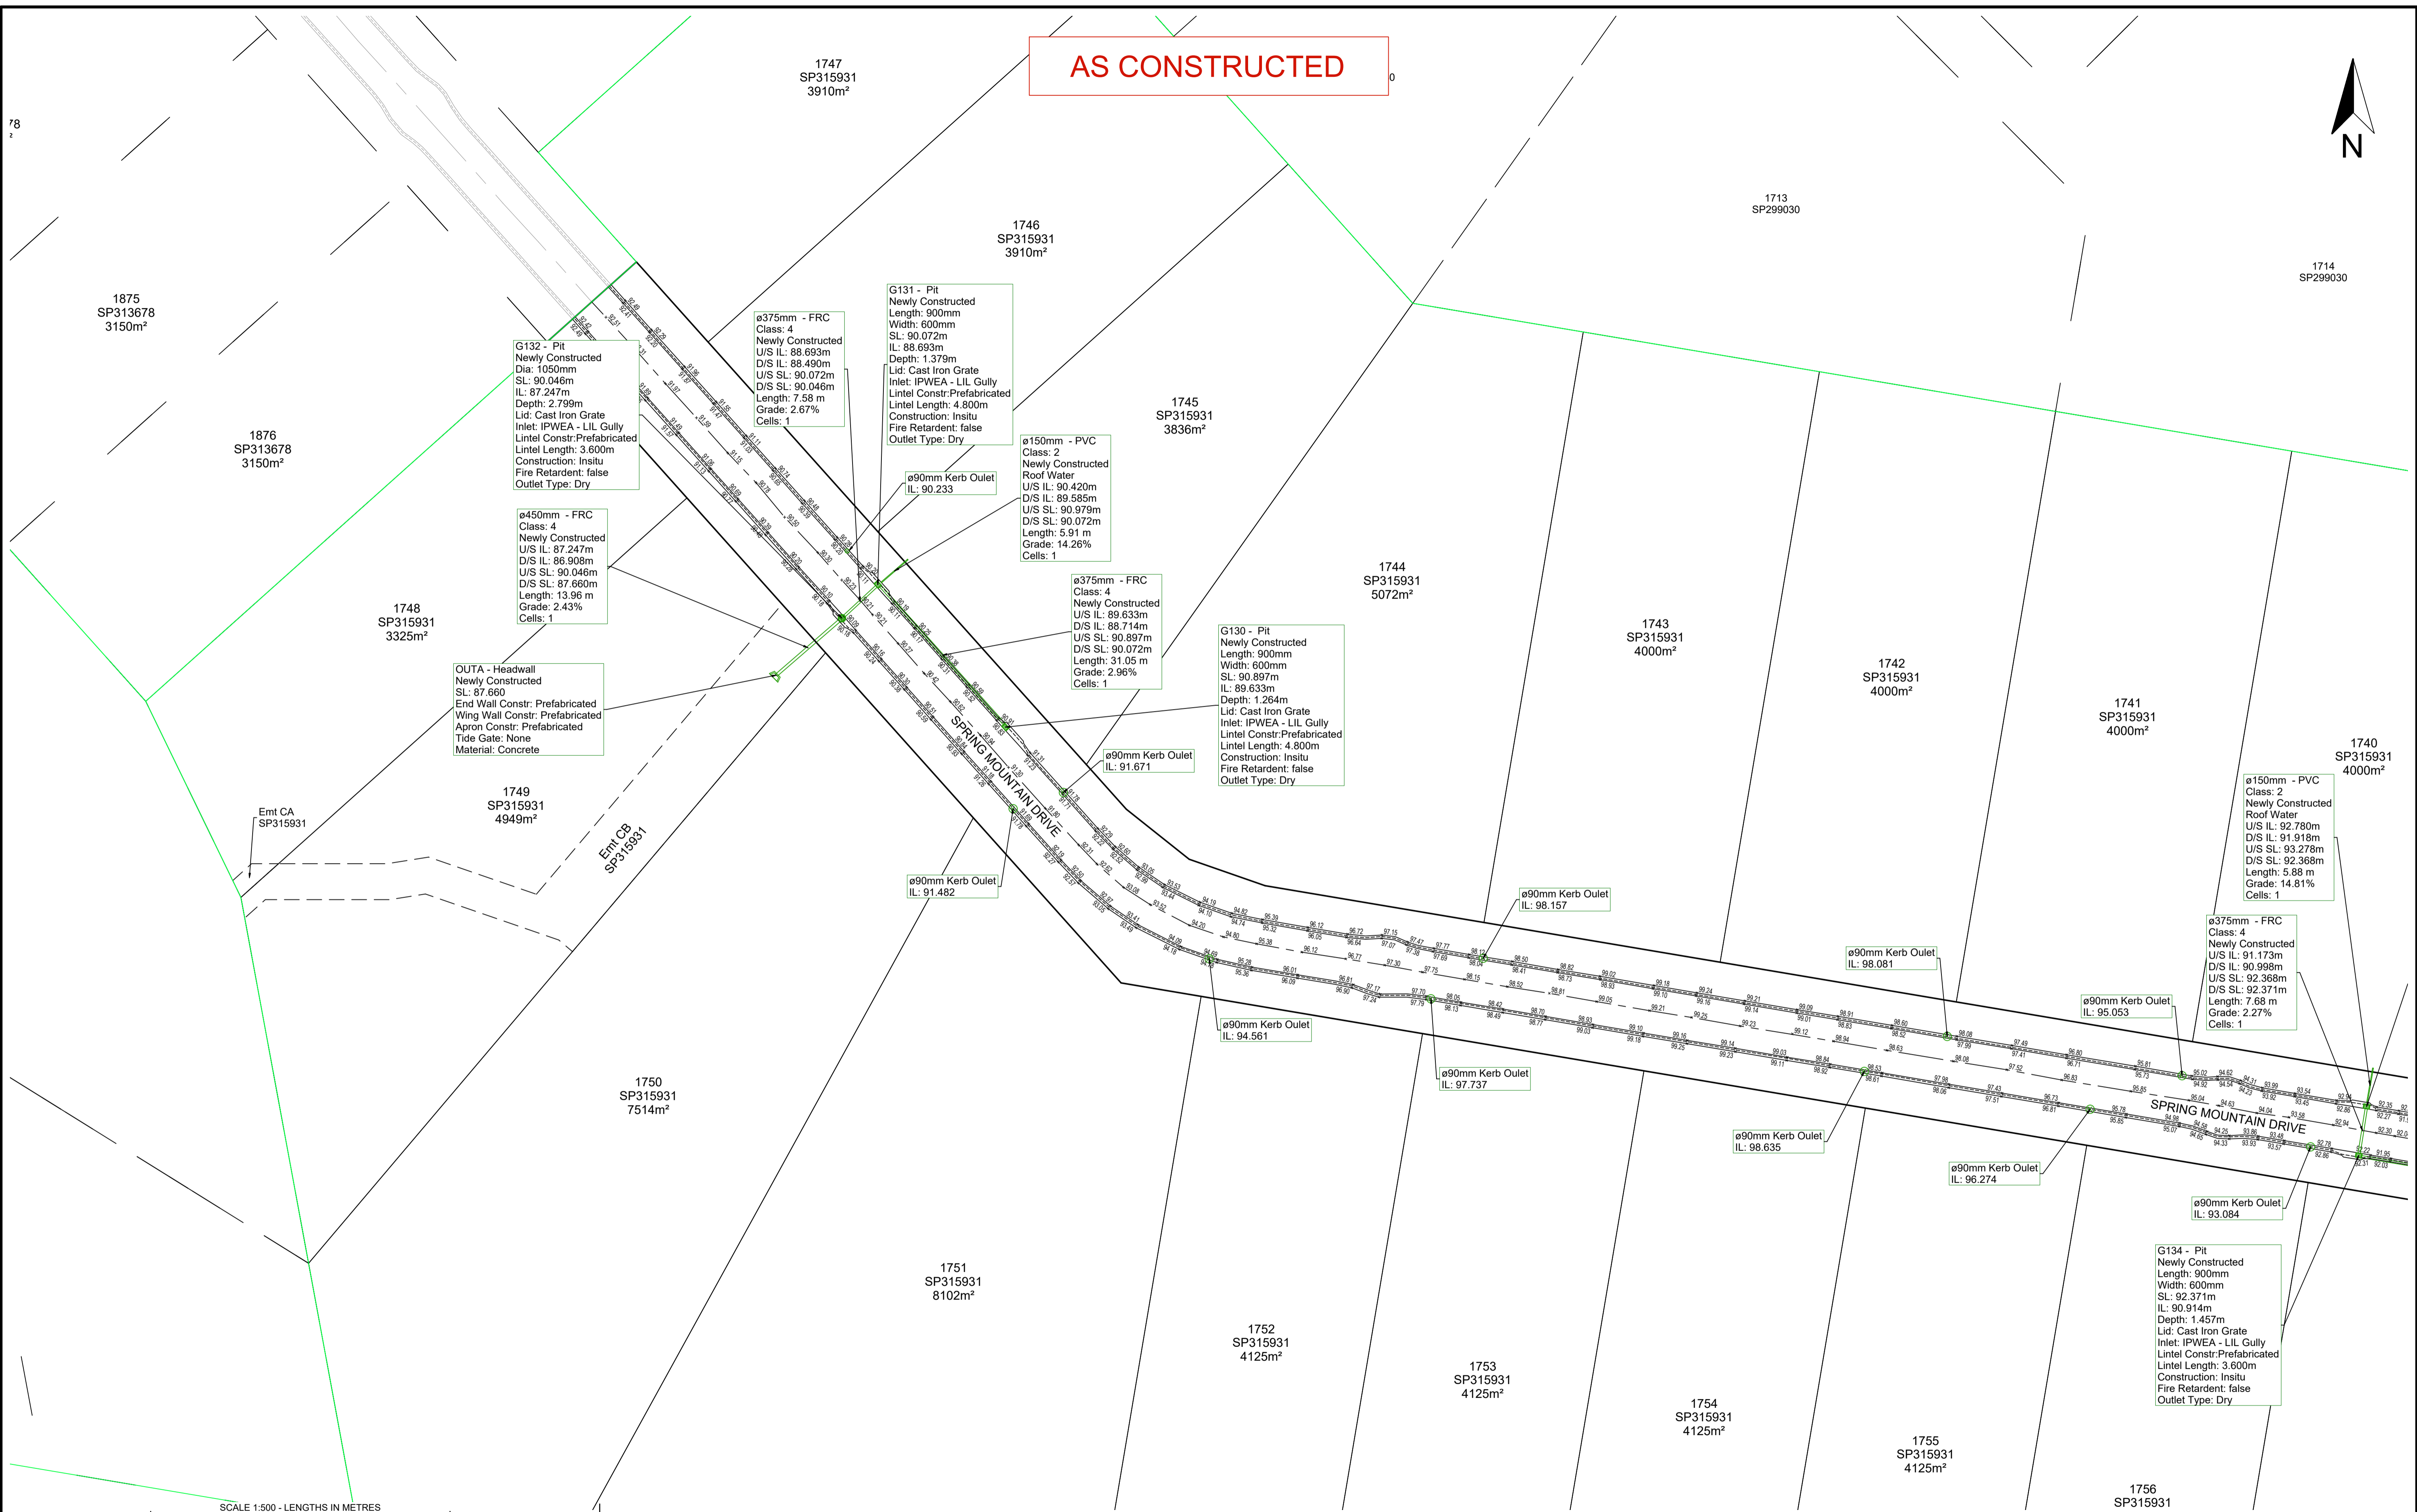

SCALE 1:500 - LENGTHS IN METRES

A1	INDEX	DATE	REVISIONS	DRAWN	CHECKED	PASSED
	A	4/8/2021	Pipe Material Changed	ASS	BVD	

SCHLENCKER SURVEYING (QLD)
 Gold Coast - Brisbane
 Consultants in Surveying,
 Mapping & Development

A.B.N. 38 909 833 411
 PO Box 41,
 Helensvale QLD 4212.

Suite 206,
 Helensvale Professional Centre
 3 Sir John Overall Dr,
 Helensvale QLD 4212. EMAIL: mail@ssq.net.au

Ph: (07) 5573 6744
 Fax: (07) 5573 6755
 Mob: 0413 945 959

REGISTERED SURVEYOR'S CERTIFICATION

I, Bruce Victor Dalton, hereby certify that the vertical and horizontal locations and dimensions shown on this plan are a true and correct record of the As Constructed information and were located by survey.

B.V. Dalton Date: 10/05/2021

Registered Surveyor (sig.) Reg. Surveyor No. 3239
 For and on behalf of Schlencker Surveying (Qld) Pty Ltd.

REGISTERED ENGINEER'S CERTIFICATION

I, _____, hereby certify that:

1. I state the works described on this drawing have been constructed under my supervision, and I or my authorised representatives have inspected the work at all stages of construction.

2. I certify that the works have been constructed in accordance with the development approval, the approved drawings, the Scenic Rim Planning Scheme 2006 and any relevant planning scheme policies and standards specifications.

3. I certify the approved drawings have been carefully compared with the site works as to line, levels and dimensions, and this drawing has been accurately amended: all respects as to constitute a true record.

Project Name
 Company
 Consultant: KN GROUP
 RPEQ/CPENG Membership No. _____

Date: _____

This Plan has been prepared for Logan City Council for the purpose of recording the As Constructed details of a new service constructed under a specific Council Approval and should not be used for any other purpose. No report is made on any other services, nor any services that may exist before or be constructed after, the time of survey, or constructed under any other approval. The property boundaries, easements and lot numbers shown hereon may be proposed only and subject to registration by the Department of Natural Resources & Mines. All property information should be determined from the registered Survey Plans.



THIS NOTE IS AN INTEGRAL PART OF THIS PLAN.

STORMWATER AS CONSTRUCTED

STAGE 17C
SPRING MOUNTAIN
 OW/116/2020

LOCAL AUTHORITY	LOGAN CITY COUNCIL		
LOCALITY	NEW BEITH		
LEVEL DATUM	AHD DERIVED		
LEVEL ORIGIN	PM186509 RL: 94.025 m		
SURVEYED	JRM	DRAWN	ASS
SCALE	1: 500	SHEET	1 OF 2
DRAWING NO.			
15159 - 113A			

AS CONSTRUCTED

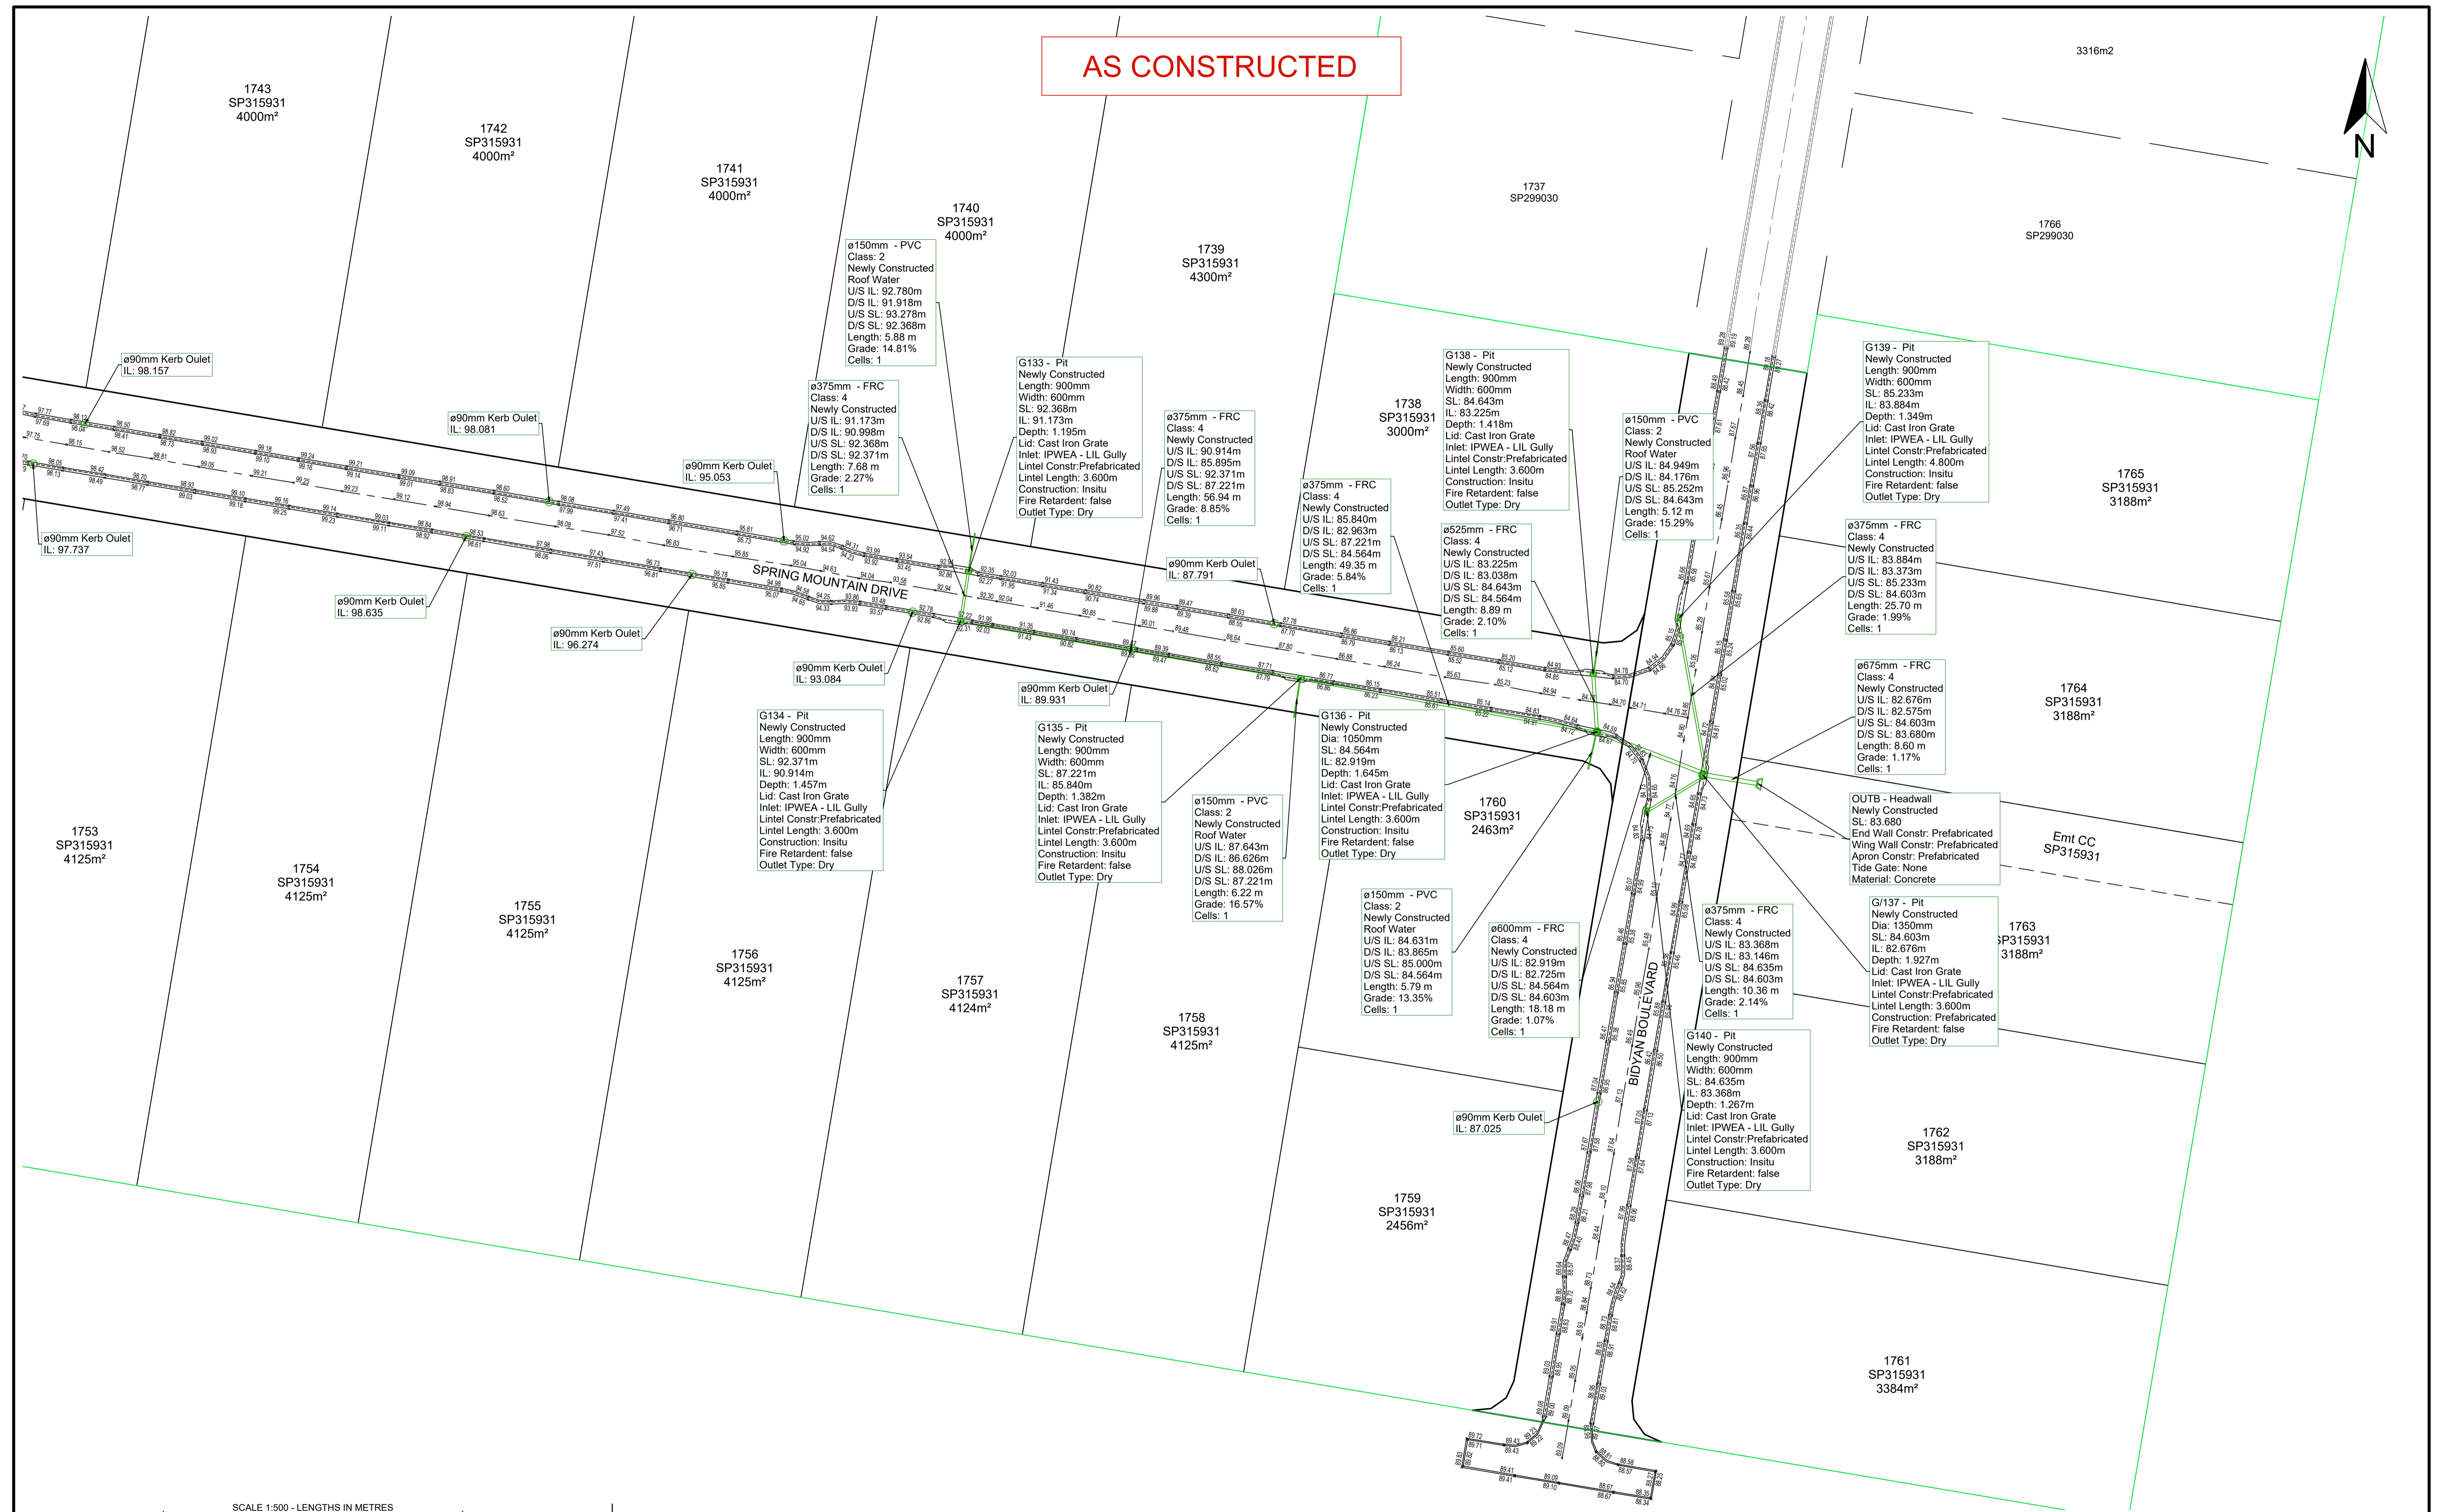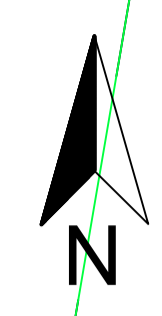

SCALE 1:500 - LENGTHS IN METRES

A1

SCHLENCKER SURVEYING (QLD)
 Gold Coast - Brisbane
 Consultants in Surveying,
 Mapping & Development

A.B.N. 38 909 833 411
 PO Box 41,
 Helensvale QLD 4212.

Suite 206,
 Helensvale Professional Centre
 3 Sir John Overall Dr,
 Helensvale QLD 4212. EMAIL: mail@ssq.net.au

Ph: (07) 5573 6744
 Fax: (07) 5573 6755
 Mob: 0413 945 959

REGISTERED SURVEYOR'S CERTIFICATION

I, Bruce Victor Dalton, hereby certify that the vertical and horizontal locations and dimensions shown on this plan are a true and correct record of the As Constructed information and were located by survey.

Bruce Dalton Date: 10/05/2021

Registered Surveyor (sig.) Reg. Surveyor No. 3239
 For and on behalf of Schlencker Surveying (Qld) Pty Ltd.

REGISTERED ENGINEER'S CERTIFICATION

I, _____, hereby certify that:

1. I state the works described on this drawing have been constructed under my supervision, and I or my authorised representatives have inspected the work at all stages of construction.

2. I certify that the works have been constructed in accordance with the development approval, the approved drawings, the Scenic Rim Planning Scheme 2006 and any relevant planning scheme policies and standards specifications.

3. I certify the approved drawings have been carefully compared with the site works as to line, levels and dimensions, and this drawing has been accurately amended: all respects as to constitute a true record.

Project Name
 Company
 Consultant: KN GROUP
 RPEQ/CPENG Membership No. _____

Date: _____

This Plan has been prepared for Logan City Council for the purpose of recording the As Constructed details of a new service constructed under a specific Council Approval and should not be used for any other purpose. No report is made on any other services, nor any services that may exist before or be constructed after, the time of survey, or constructed under any other approval. The property boundaries, easements and lot numbers shown herein may be proposed only and subject to registration by the Department of Natural Resources & Mines. All property information should be determined from the registered Survey Plans.

THIS NOTE IS AN INTEGRAL PART OF THIS PLAN.

STORMWATER AS CONSTRUCTED

STAGE 17C

SPRING MOUNTAIN

OW/116/2020

LOCAL AUTHORITY	LOGAN CITY COUNCIL
LOCALITY	NEW BEITH
LEVEL DATUM	AHD DERIVED
LEVEL ORIGIN	PM186509 RL: 94.025 m
SURVEYED	JRM DRAWN ASS
SCALE	1:500 SHEET 2 OF 2
DRAWING NO.	15159 - 113A