



ITEM	DESCRIPTION
1	Ø100x1.25" BEND
2	Ø100x2.25" BEND
3	Ø100x45" BEND
4	Ø150x11.25" BEND
5	Ø150x22.5" BEND
6	Ø150xØ150 TEE
7	Ø150xØ100 REDUCER
8	Ø100xØ50 REDUCER

DETAIL B

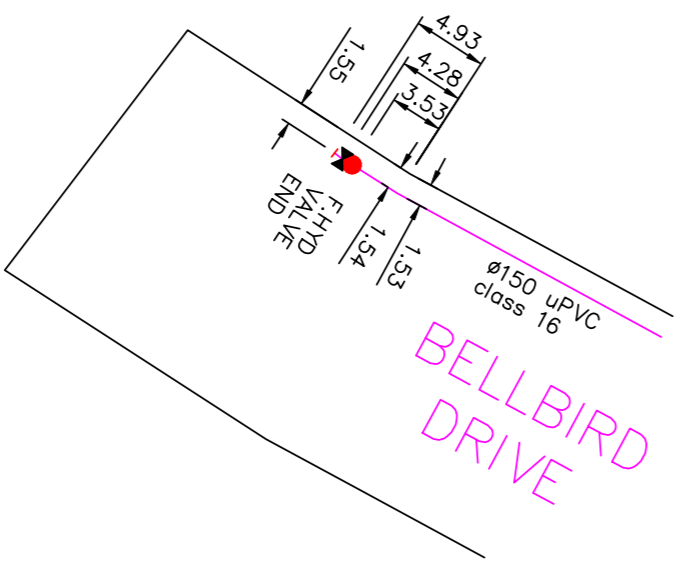

DETAIL A

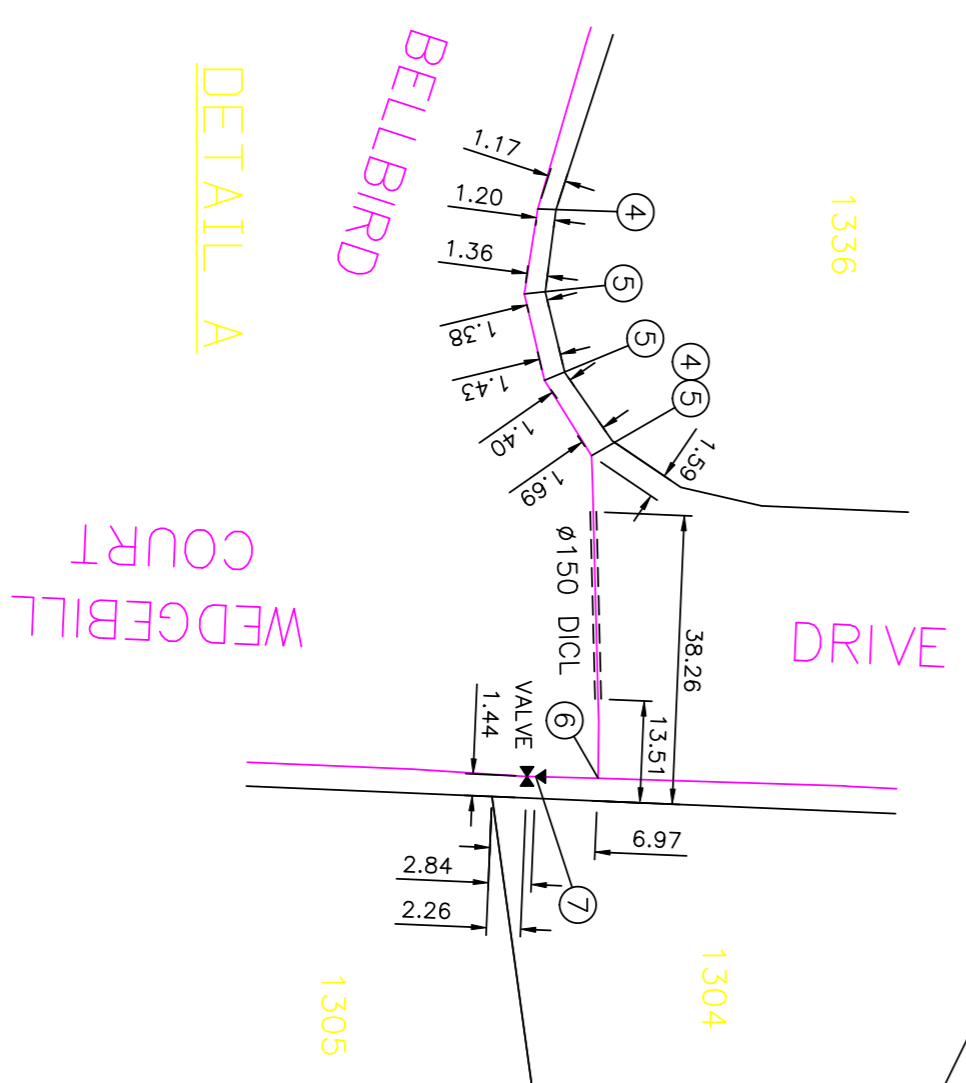

STEPHEN HOSKING SURVEYS PTY LTD
HEREBY CERTIFY THAT THE AS CONSTRUCTED
INFORMATION SHOWN HEREON IS CORRECT

CADASTRAL SURVEYOR / DIRECTOR

DATE

PSM REFERENCE:		491823594	
PSM106579	East	6933782014	RL
PSM121309	East	491811942	RL
	North	6933681393	RL

SPRING MOUNTAIN ESTATE STAGE 13 AS CONSTRUCTED WATER SUPPLY	STEPHEN HOSKING SURVEYS PTY. LTD. CONSULTING SURVEYORS ACN 056 982 293 OFFICE ADDRESS SHOP 1, 25 ALICA ST. SOUTHPORT QLD 4215 Email: shsurveys@optusnet.com.au PHONE (07) 55917703 FAX (07) 55917709
DRAWN: GWH CHECKED: SRH APPROVED: SRH DATE: 11/01/10 SCALE: E3000 AT A1 CADD DWG: 419-13-AC-WM	DRAINAGE NO: SHEET: 1 OF 1

889
CONNECTION TO EXISTING
WATER MAIN BY COUNCIL