

DRAWING REVISIONS		REFERENCE DRAWINGS		DESIGN FILE No.	DESIGNED
REV.	REVISION DESCRIPTION	DRG. No.	DESCRIPTION	CONSTRUCT. No.	DATE
0	AS-CONSTRUCTED DRAWINGS				

DESIGNED	CHECKED	DATE
LG	BS	27/07/2021


THIS WORK WAS PREPARED BY:
Lion Systems on behalf of RPS

SCALE 1:250 ORIGINAL SIZE A1

MORETON BAY REGIONAL COUNCIL
PINE DISTRICT OFFICE
220 GYMPIE ROAD STRATHPINE QLD 4500
PO BOX 159 CABOOLTURE QLD 4510
Telephone: (07) 3480 8686
Fax: (07) 3480 6710

ROADS AND DRAINAGE
AS CONSTRUCTED
84 SAMSONVALE ROAD, STRATHPINE
STAGE 5

MBRC SUBDIVISION REFERENCE	
DA/38361/2019/XA/1	
No. 1 OF 5 PLANS	
ASCAN GRID NUMBER	REV.
	0

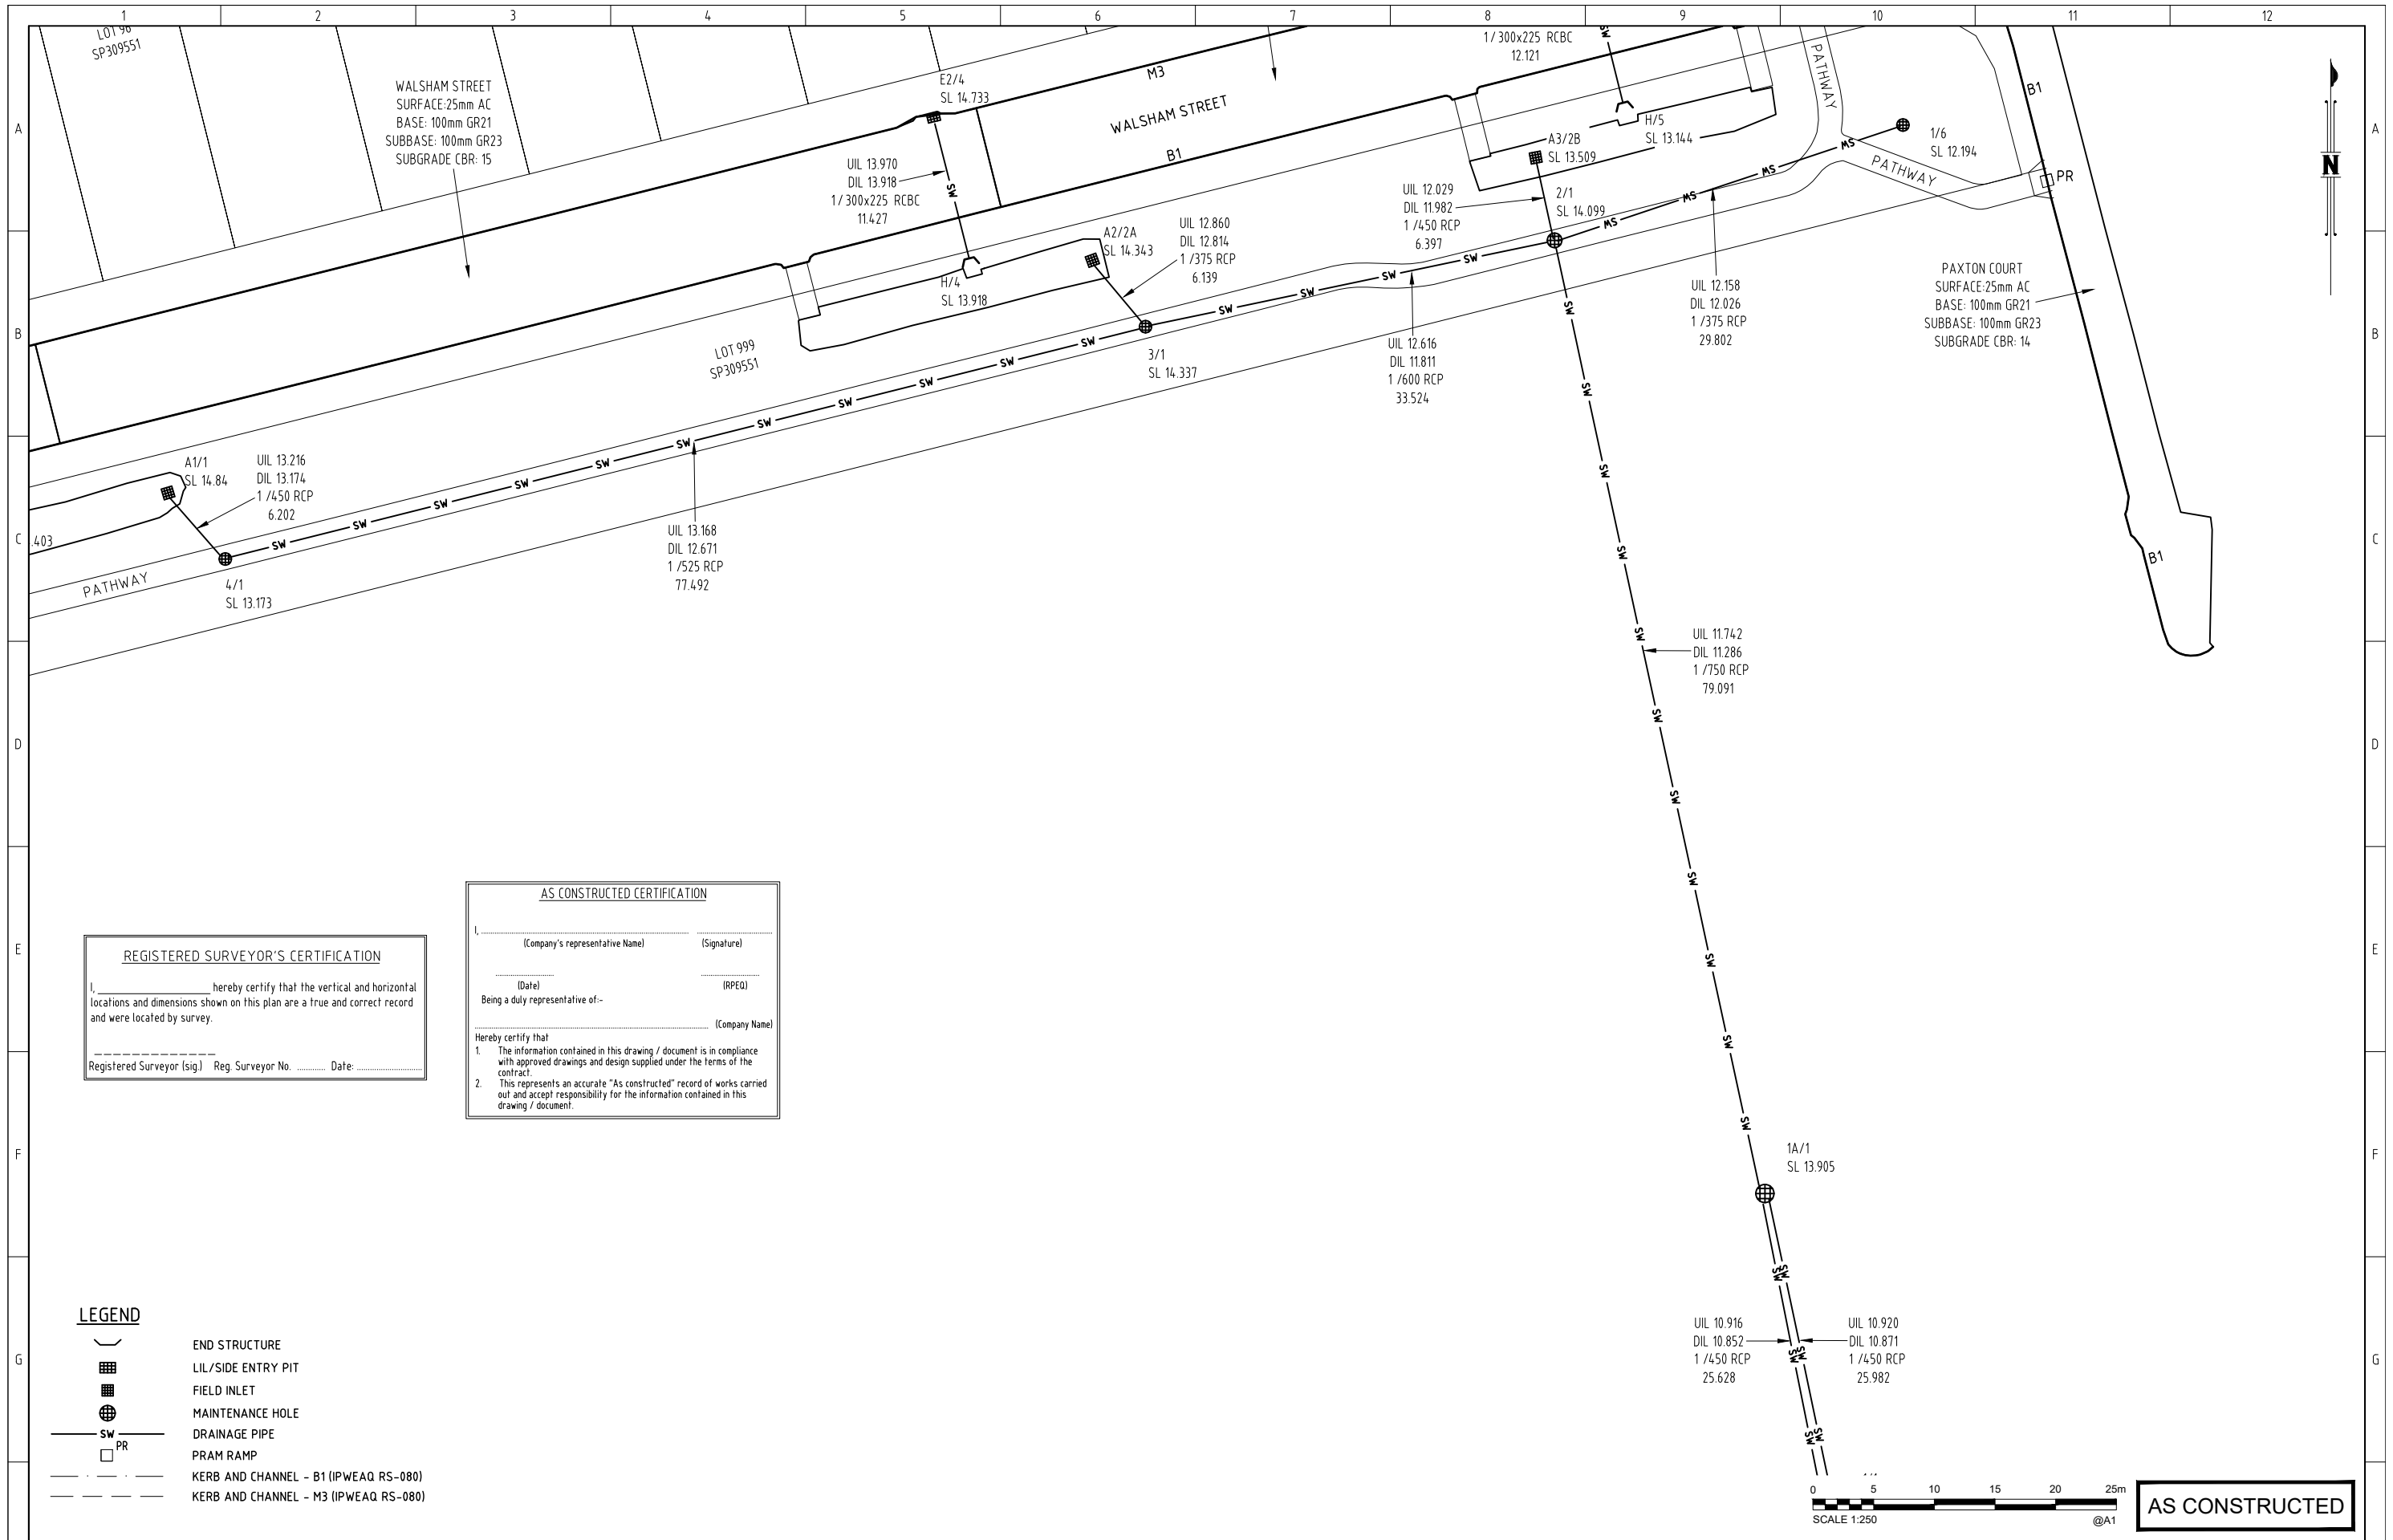

REGISTERED SURVEYOR'S CERTIFICATION

I, _____ hereby certify that the vertical and horizontal locations and dimensions shown on this plan are a true and correct record and were located by survey.

Registered Surveyor (sig) Reg. Surveyor No. _____ Date: _____

AS CONSTRUCTED CERTIFICATION

I, _____ (Company's representative Name) _____ (Signature)

_____ (Date) _____ (RPEQ)

Being a duly representative of:- _____ (Company Name)

Hereby certify that

- The information contained in this drawing / document is in compliance with approved drawings and design supplied under the terms of the contract.
- This represents an accurate "As constructed" record of works carried out and accept responsibility for the information contained in this drawing / document.

- LEGEND**
- END STRUCTURE
 - LIL/SIDE ENTRY PIT
 - FIELD INLET
 - MAINTENANCE HOLE
 - DRAINAGE PIPE
 - PRAM RAMP
 - KERB AND CHANNEL - B1 (IPWEAQ RS-080)
 - KERB AND CHANNEL - M3 (IPWEAQ RS-080)



AS CONSTRUCTED

DRAWING REVISIONS		REFERENCE DRAWINGS		DESIGN FILE No.	DESIGNED
REV.	REVISION DESCRIPTION	DRG. No.	DESCRIPTION	CONSTRUCT. No.	DATE
0	AS-CONSTRUCTED DRAWINGS				
				SURVEY FILE No.	DRAWN LG
				FIELD BOOK	DATE 27/07/2021
				LOG BOOK	CHECKED BS
				LEVEL DATUM	DATE 27/07/2021
				DATUM	

THIS WORK WAS PREPARED BY:


Lion Systems on behalf of RPS

SCALE 1:250 ORIGINAL SIZE A1

MORETON BAY REGIONAL COUNCIL
 PINE DISTRICT OFFICE
 220 GYMPIE ROAD STRATHPINE QLD 4500
 PO BOX 159 CABOOLTURE QLD 4510
 Telephone: (07) 3480 8686
 Fax: (07) 3480 6710

ROADS AND DRAINAGE
AS CONSTRUCTED
84 SAMSONVALE ROAD, STRATHPINE
STAGE 5

MBRC SUBDIVISION REFERENCE	
DA/38361/2019/XA/1	
No. 3 OF 5 PLANS	
ASCON GRID NUMBER	REV.
	0

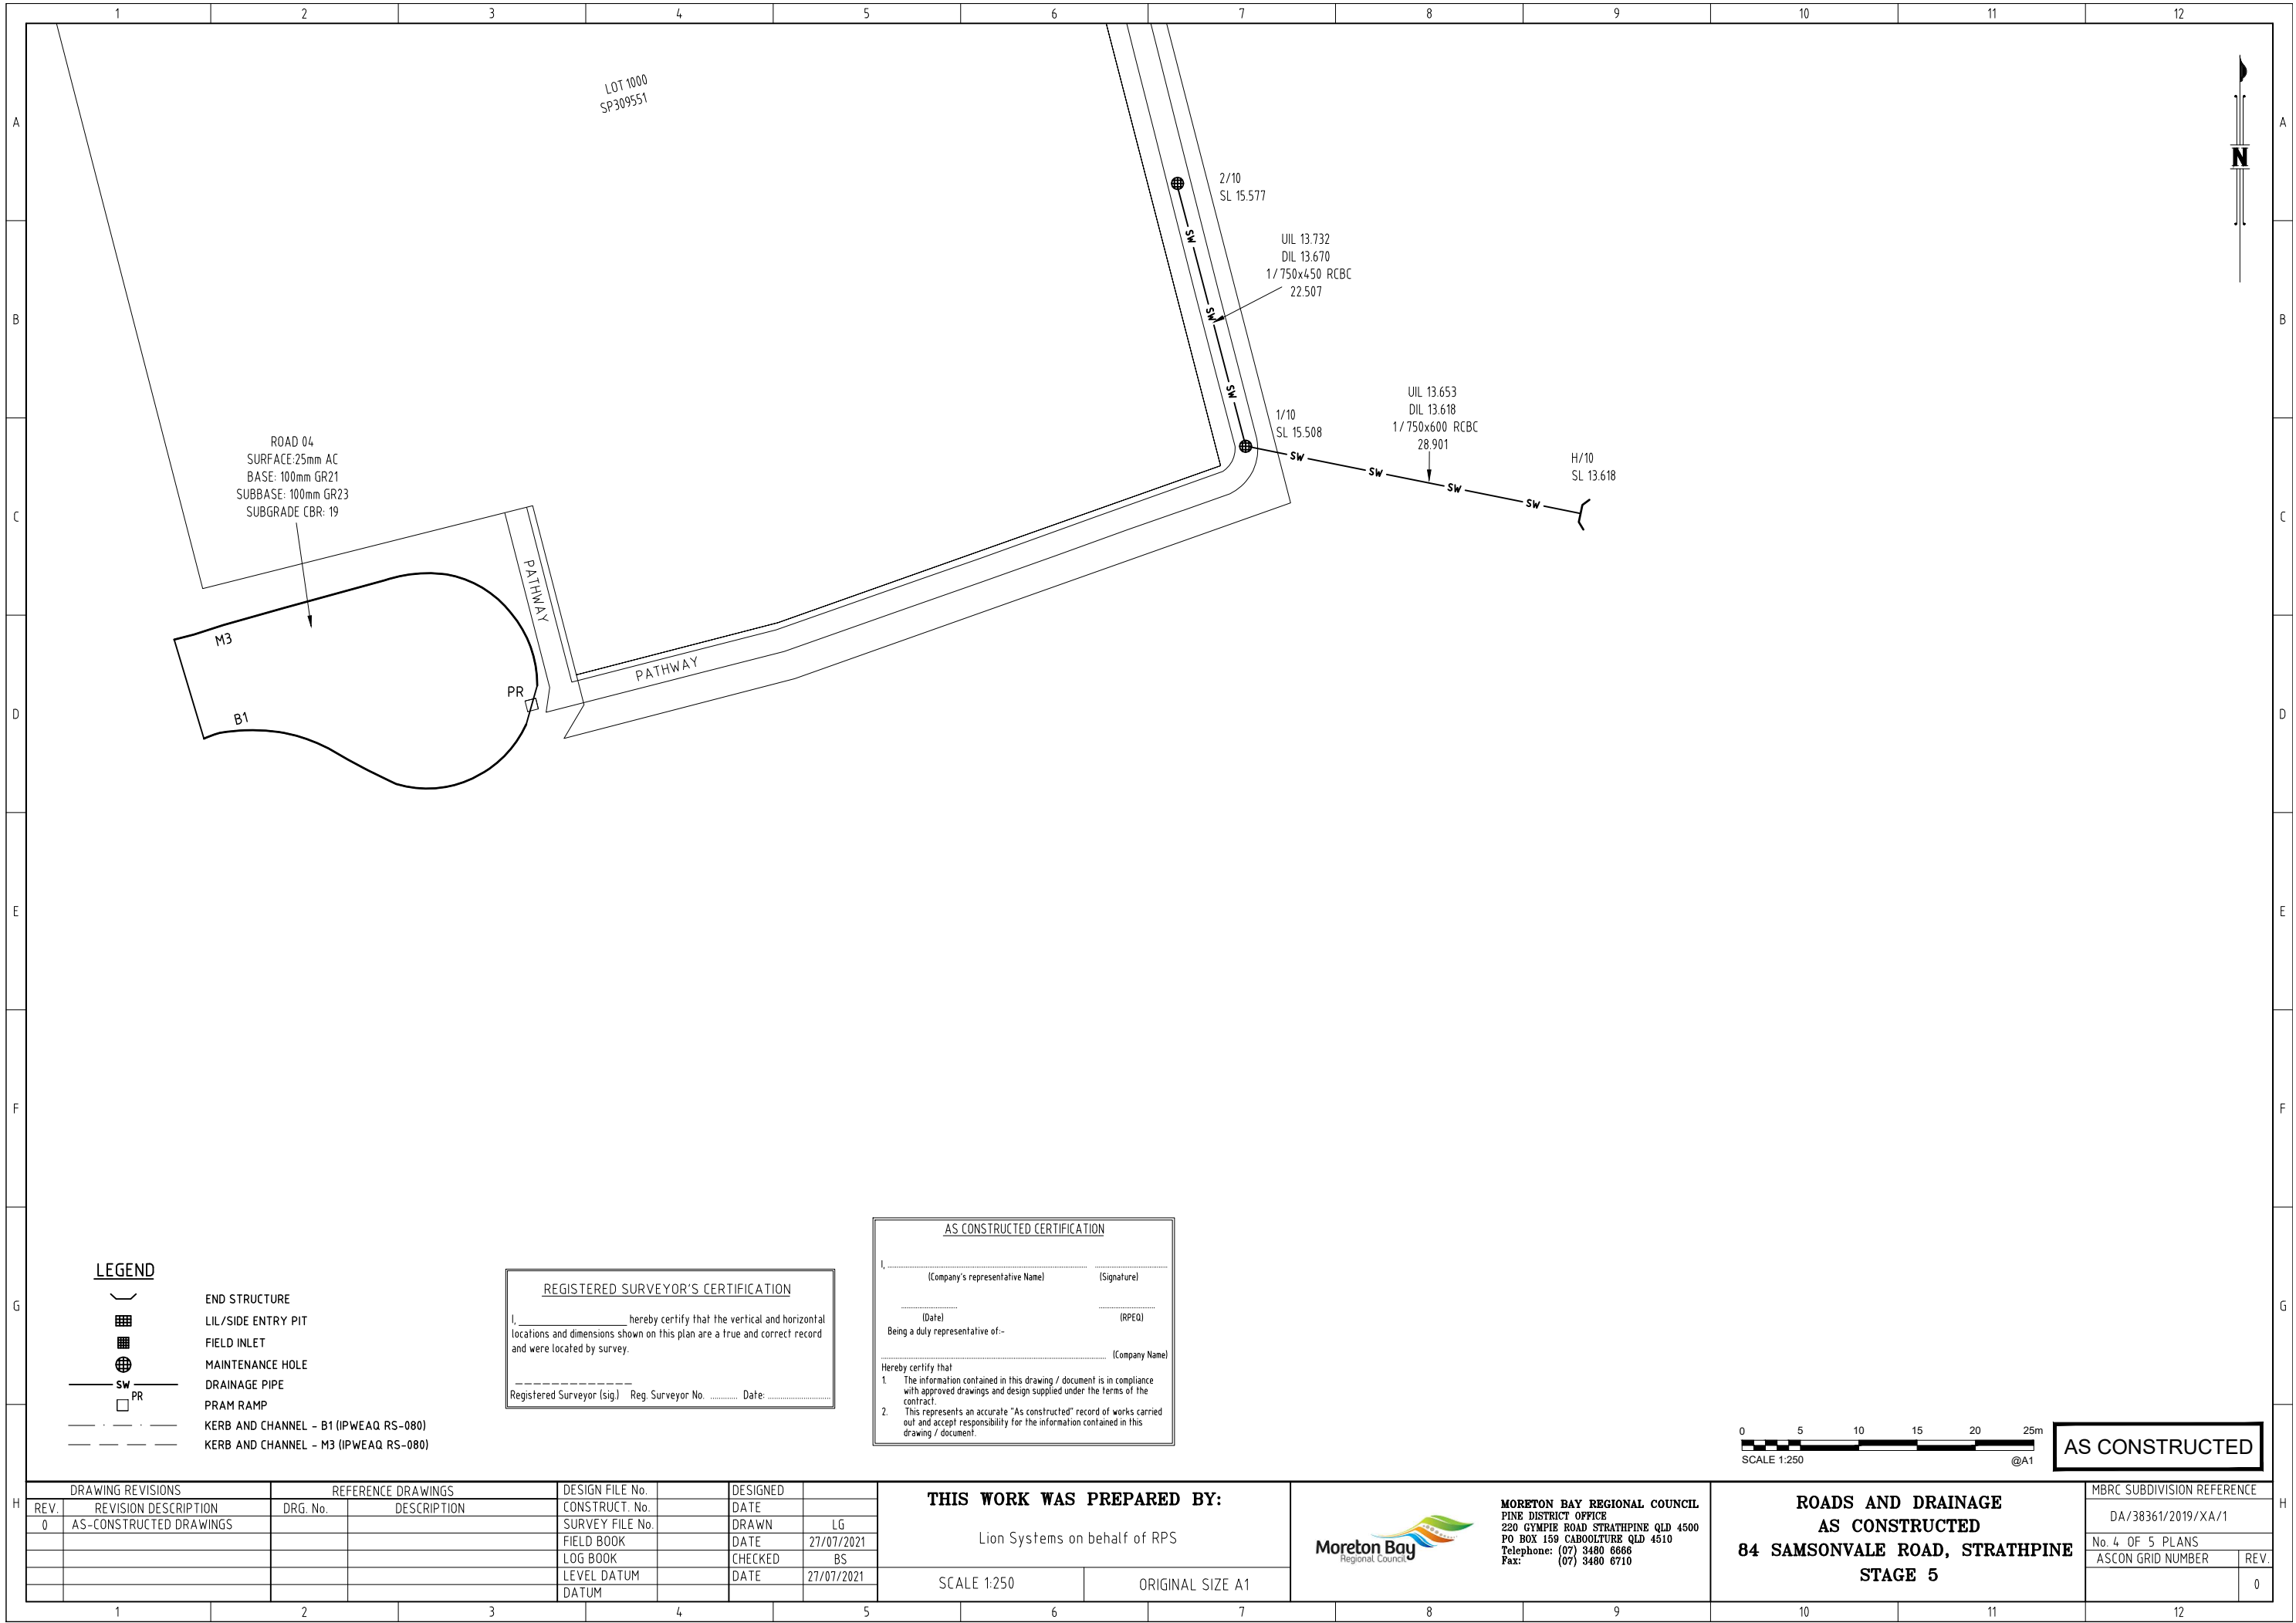

ROAD 04
SURFACE: 25mm AC
BASE: 100mm GR21
SUBBASE: 100mm GR23
SUBGRADE CBR: 19

LOT 1000
SP309551

2/10
SL 15.577

UL 13.732
DIL 13.670
1 / 750x450 RCBC
22.507

1/10
SL 15.508

UL 13.653
DIL 13.618
1 / 750x600 RCBC
28.901

H/10
SL 13.618

- LEGEND**
- END STRUCTURE
 - LIL/SIDE ENTRY PIT
 - FIELD INLET
 - MAINTENANCE HOLE
 - DRAINAGE PIPE
 - PRAM RAMP
 - KERB AND CHANNEL - B1 (IPWEAQ RS-080)
 - KERB AND CHANNEL - M3 (IPWEAQ RS-080)

REGISTERED SURVEYOR'S CERTIFICATION

I, _____ hereby certify that the vertical and horizontal locations and dimensions shown on this plan are a true and correct record and were located by survey.

Registered Surveyor (sig) Reg. Surveyor No. Date:


AS CONSTRUCTED CERTIFICATION

I, _____ (Company's representative Name) _____ (Signature)

(Date) _____ (RPEQ)
Being a duly representative of:- _____ (Company Name)

Hereby certify that

- The information contained in this drawing / document is in compliance with approved drawings and design supplied under the terms of the contract.
- This represents an accurate "As constructed" record of works carried out and accept responsibility for the information contained in this drawing / document.

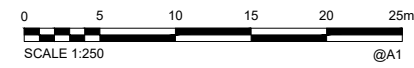

AS CONSTRUCTED

DRAWING REVISIONS		REFERENCE DRAWINGS		DESIGN FILE No.	DESIGNED
REV.	REVISION DESCRIPTION	DRG. No.	DESCRIPTION	CONSTRUCT. No.	DATE
0	AS-CONSTRUCTED DRAWINGS				
				SURVEY FILE No.	DRAWN LG
				FIELD BOOK	DATE 27/07/2021
				LOG BOOK	CHECKED BS
				LEVEL DATUM	DATE 27/07/2021
				DATUM	

THIS WORK WAS PREPARED BY:


Lion Systems on behalf of RPS

SCALE 1:250 ORIGINAL SIZE A1

MORETON BAY REGIONAL COUNCIL
PINE DISTRICT OFFICE
220 GYMPIE ROAD STRATHPINE QLD 4500
PO BOX 159 CABOOLTURE QLD 4510
Telephone: (07) 3480 8686
Fax: (07) 3480 6710

**ROADS AND DRAINAGE
AS CONSTRUCTED
84 SAMSONVALE ROAD, STRATHPINE
STAGE 5**

MBRC SUBDIVISION REFERENCE	
DA/38361/2019/XA/1	
No. 4 OF 5 PLANS	
ASCION GRID NUMBER	REV.
	0

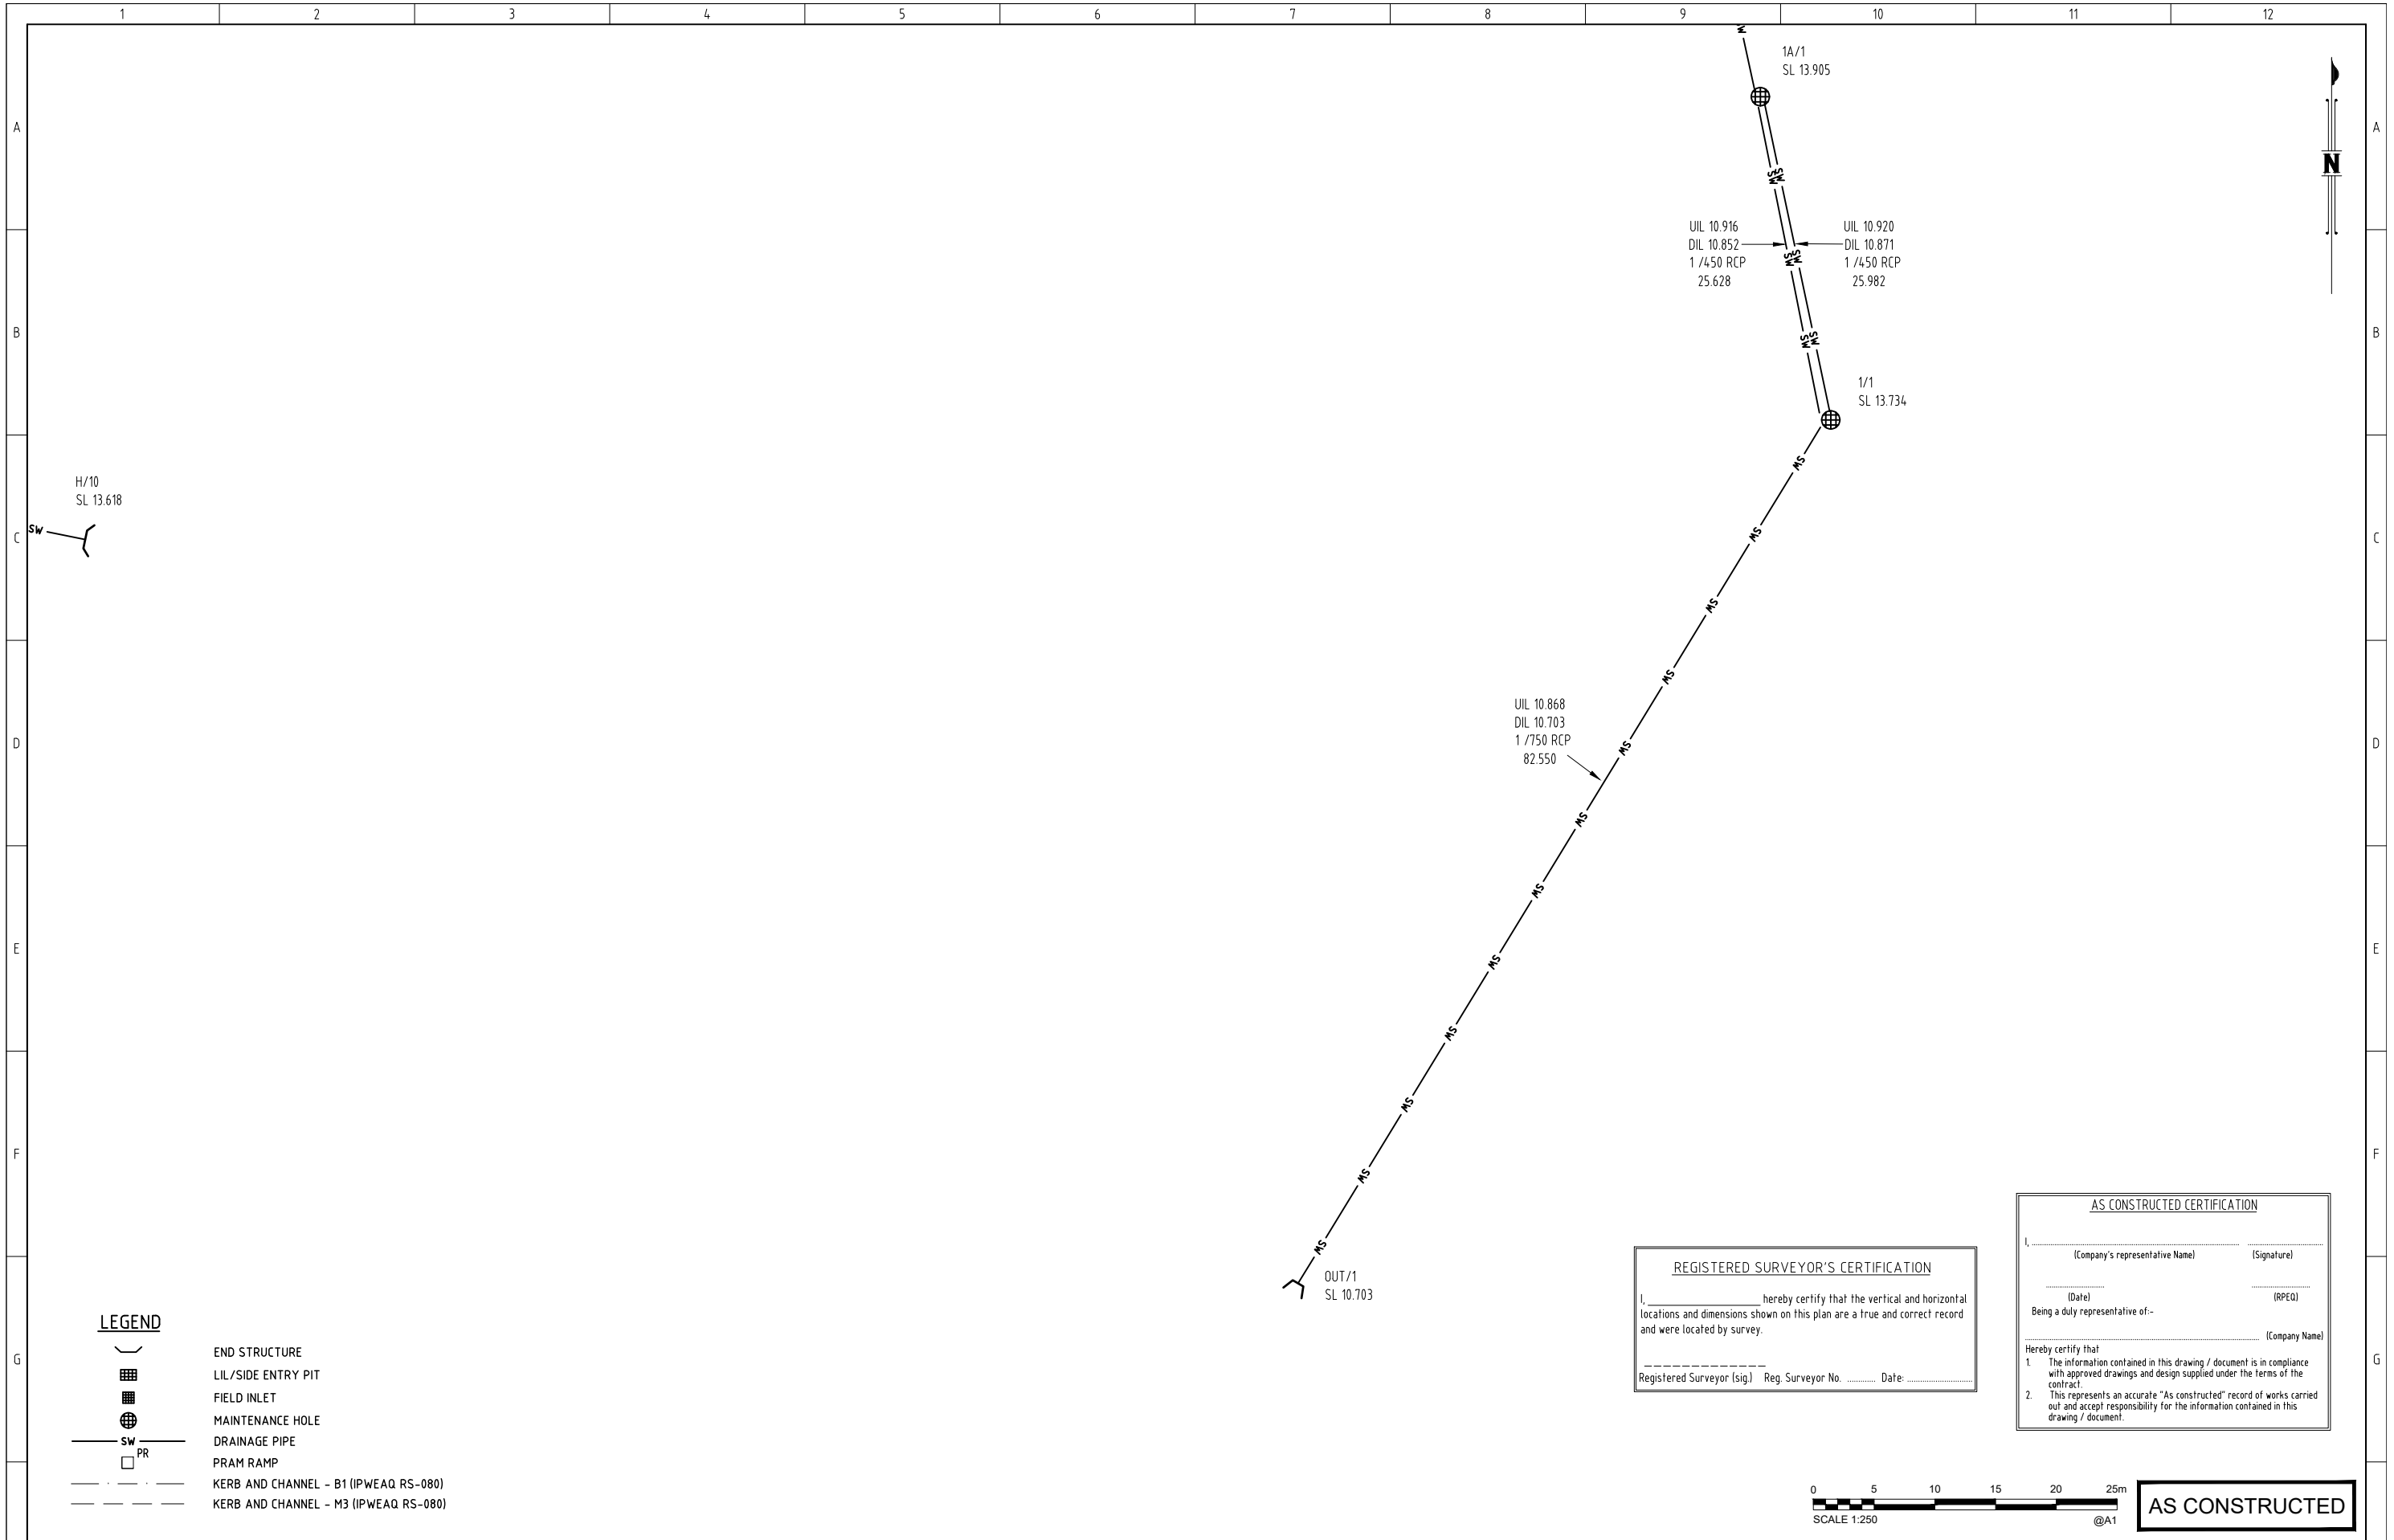

LEGEND

	END STRUCTURE
	LIL/SIDE ENTRY PIT
	FIELD INLET
	MAINTENANCE HOLE
	DRAINAGE PIPE
	PRAM RAMP
	KERB AND CHANNEL - B1 (IPWEAQ RS-080)
	KERB AND CHANNEL - M3 (IPWEAQ RS-080)

REGISTERED SURVEYOR'S CERTIFICATION

I, _____ hereby certify that the vertical and horizontal locations and dimensions shown on this plan are a true and correct record and were located by survey.

Registered Surveyor (sig.) Reg. Surveyor No. Date:

AS CONSTRUCTED CERTIFICATION


I, _____ (Company's representative Name) _____ (Signature)

(Date) _____ (RPEQ)

Being a duly representative of:- _____ (Company Name)


Hereby certify that

- The information contained in this drawing / document is in compliance with approved drawings and design supplied under the terms of the contract.
- This represents an accurate "As constructed" record of works carried out and accept responsibility for the information contained in this drawing / document.

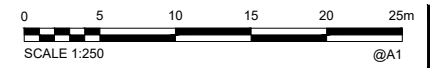


AS CONSTRUCTED

<table border="1"> <thead> <tr> <th colspan="2">DRAWING REVISIONS</th> <th colspan="2">REFERENCE DRAWINGS</th> <th>DESIGN FILE No.</th> <th>DESIGNED</th> </tr> <tr> <th>REV.</th> <th>REVISION DESCRIPTION</th> <th>DRG. No.</th> <th>DESCRIPTION</th> <th>CONSTRUCT. No.</th> <th>DATE</th> </tr> </thead> <tbody> <tr> <td>0</td> <td>AS-CONSTRUCTED DRAWINGS</td> <td></td> <td></td> <td></td> <td></td> </tr> </tbody> </table>		DRAWING REVISIONS		REFERENCE DRAWINGS		DESIGN FILE No.	DESIGNED	REV.	REVISION DESCRIPTION	DRG. No.	DESCRIPTION	CONSTRUCT. No.	DATE	0	AS-CONSTRUCTED DRAWINGS					<table border="1"> <thead> <tr> <th>SURVEY FILE No.</th> <th>DATE</th> <th>CHECKED</th> <th>DATE</th> </tr> </thead> <tbody> <tr> <td>FIELD BOOK</td> <td>27/07/2021</td> <td>BS</td> <td></td> </tr> <tr> <td>LOG BOOK</td> <td></td> <td></td> <td></td> </tr> <tr> <td>LEVEL DATUM</td> <td>27/07/2021</td> <td></td> <td></td> </tr> <tr> <td>DATUM</td> <td></td> <td></td> <td></td> </tr> </tbody> </table>		SURVEY FILE No.	DATE	CHECKED	DATE	FIELD BOOK	27/07/2021	BS		LOG BOOK				LEVEL DATUM	27/07/2021			DATUM				<p>THIS WORK WAS PREPARED BY:</p> <p>Lion Systems on behalf of RPS</p> <p>SCALE 1:250 ORIGINAL SIZE A1</p>		<p>MORETON BAY REGIONAL COUNCIL PINE DISTRICT OFFICE 220 GYMPIE ROAD STRATHPINE QLD 4500 PO BOX 159 CABOOLTURE QLD 4510 Telephone: (07) 3480 8686 Fax: (07) 3480 6710</p>		<p>ROADS AND DRAINAGE AS CONSTRUCTED 84 SAMSONVALE ROAD, STRATHPINE STAGE 5</p>		<table border="1"> <thead> <tr> <th colspan="2">MBRC SUBDIVISION REFERENCE</th> </tr> </thead> <tbody> <tr> <td colspan="2">DA/38361/2019/XA/1</td> </tr> <tr> <td colspan="2">No. 5 OF 5 PLANS</td> </tr> <tr> <td>ASCON GRID NUMBER</td> <td>REV.</td> </tr> <tr> <td></td> <td>0</td> </tr> </tbody> </table>		MBRC SUBDIVISION REFERENCE		DA/38361/2019/XA/1		No. 5 OF 5 PLANS		ASCON GRID NUMBER	REV.		0
DRAWING REVISIONS		REFERENCE DRAWINGS		DESIGN FILE No.	DESIGNED																																																						
REV.	REVISION DESCRIPTION	DRG. No.	DESCRIPTION	CONSTRUCT. No.	DATE																																																						
0	AS-CONSTRUCTED DRAWINGS																																																										
SURVEY FILE No.	DATE	CHECKED	DATE																																																								
FIELD BOOK	27/07/2021	BS																																																									
LOG BOOK																																																											
LEVEL DATUM	27/07/2021																																																										
DATUM																																																											
MBRC SUBDIVISION REFERENCE																																																											
DA/38361/2019/XA/1																																																											
No. 5 OF 5 PLANS																																																											
ASCON GRID NUMBER	REV.																																																										
	0																																																										

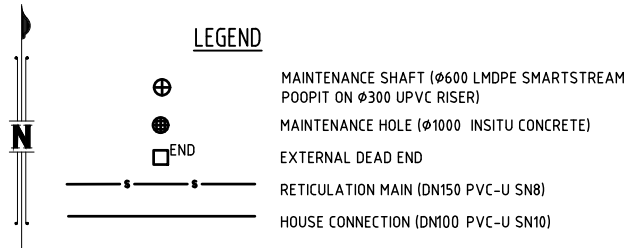

COORDINATE DATUM NOTE:
 HORIZONTAL COORDINATES(E,N) SUPPLIED ARE MAPPING GRID OF AUSTRALIA(MGA), ZONE 56 BASED ON THE UNIVERSAL TRANSVERSE MERCATOR PROJECTION AND THE GEOCENTRIC DATUM OF AUSTRALIA 1994.

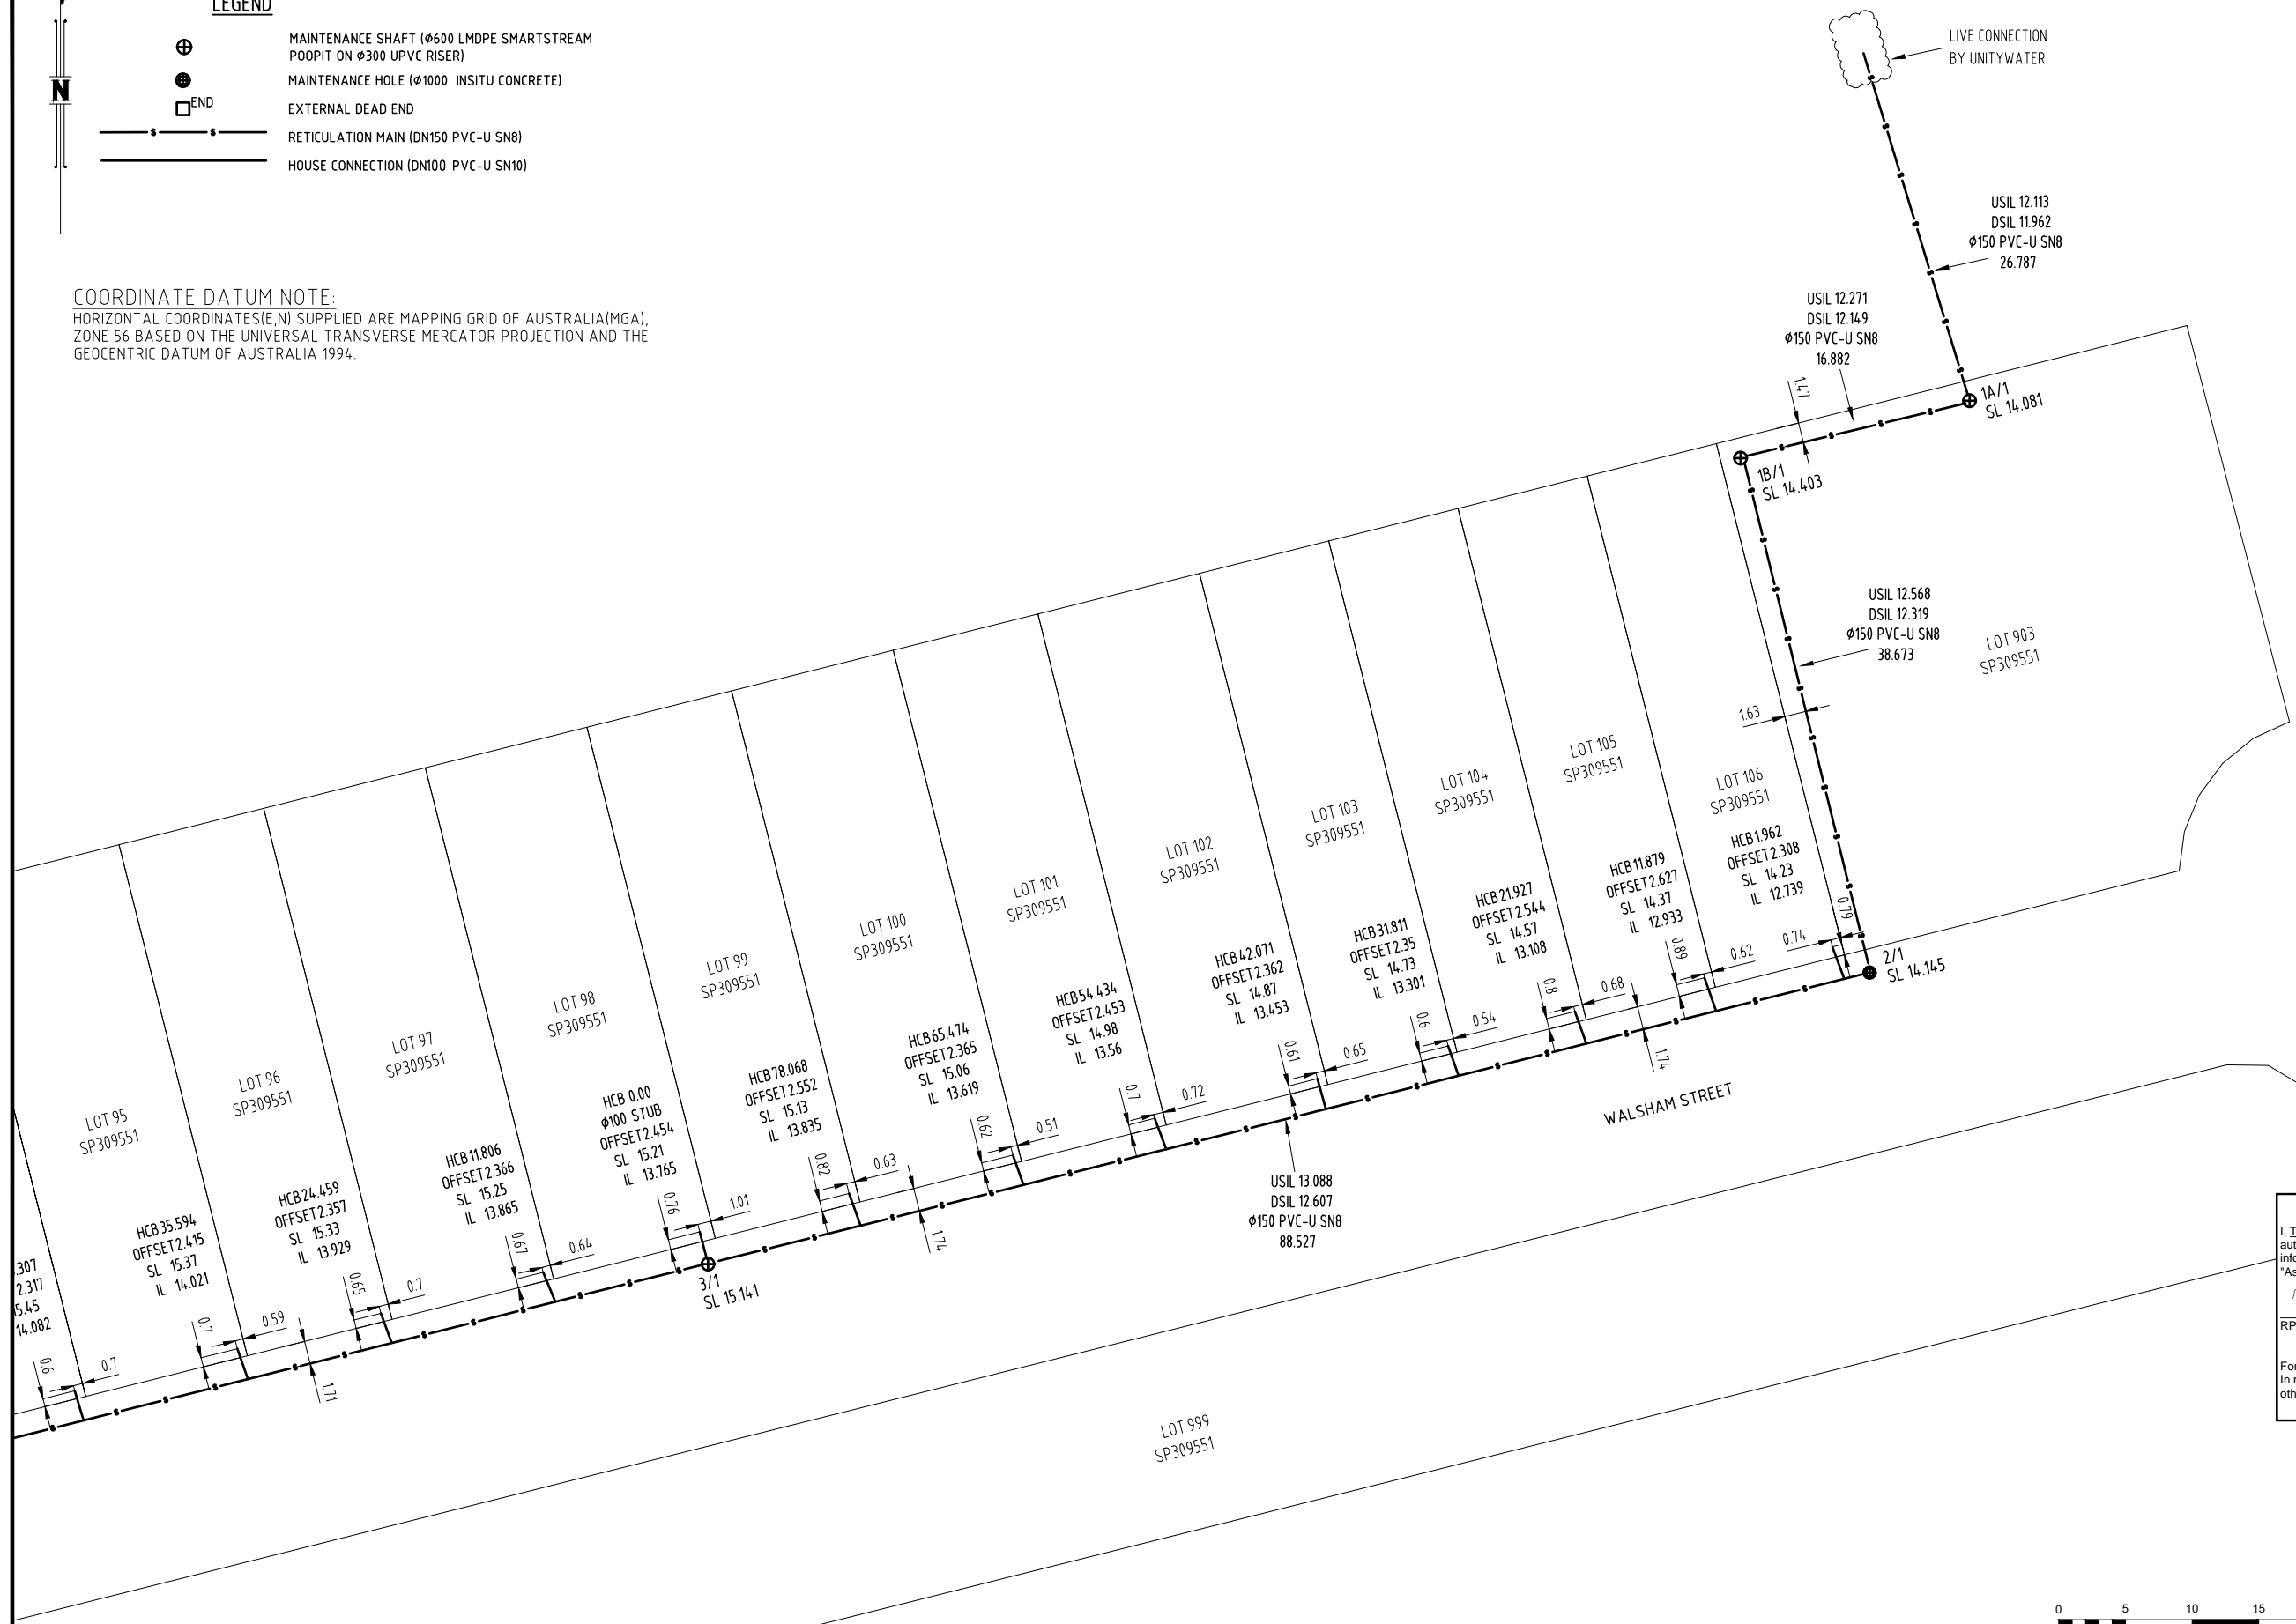

ENGINEER'S CERTIFICATION


I, Troy Schultz, being a Certified/Registered Engineer and duly authorised representative of PEAKURBAN Pty Ltd, hereby certify the information contained in this drawing as generally an accurate "As Constructed" representation of the works.

RPEQ (Signature) 20631 RPEQ No. Date: 21/07/2021

For and on behalf of PEAKURBAN Pty Ltd.
 In making this certificate we have relied upon information provided by others.

Registered Surveyor's certification
 I, Daniel Coates, hereby certify that the vertical and horizontal locations, and dimensions shown on this plan are a true and correct record and were located by survey.

 Registered Surveyor Reg Surveyor No 554 (RPS) Date 21/07/21

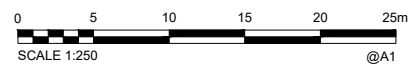

AS CONSTRUCTED

A1	0	06/07/2021	AS CONSTRUCTED	JK	LG				
	INDEX	DATE	REVISIONS	DRAWN	CHECKED	PASSED	INITIALS	DATE	

PEAKURBAN
 DEVELOPMENT ENGINEERS + ADVISORS

DRAWN JK 06/07/2021
 CHECKED LG 06/07/2021
 PASSED













Unitywater


UW201901386856
 WATER RETICULATION AS CONSTRUCTED
 SAMSONVALE ROAD STRATHPINE STAGE 5


SHEET 2 OF 2 SHEETS	SCALE 1:250
REVISION DATE 06/07/2021	REVISION 0
DISCIPLINE CODE	
DRAWING NO.	

 PSM108388
 E: 4.97935.052
 N: 6980351.382
 RL: 19.89m

  
LEGEND

-  WATER MAIN (DN100 PVC-O PN16)
-  SERVICE PIPE (OD25 PE100 PN16)
-  CONDUIT PIPE (DN100 PVC-U PN9)
-  WATER METER - 20mm ITRON
-  FIRE HYDRANT
-  TEE
-  READY TAP
-  BEND
-  END CAP
-  STOP/GATE VALVE

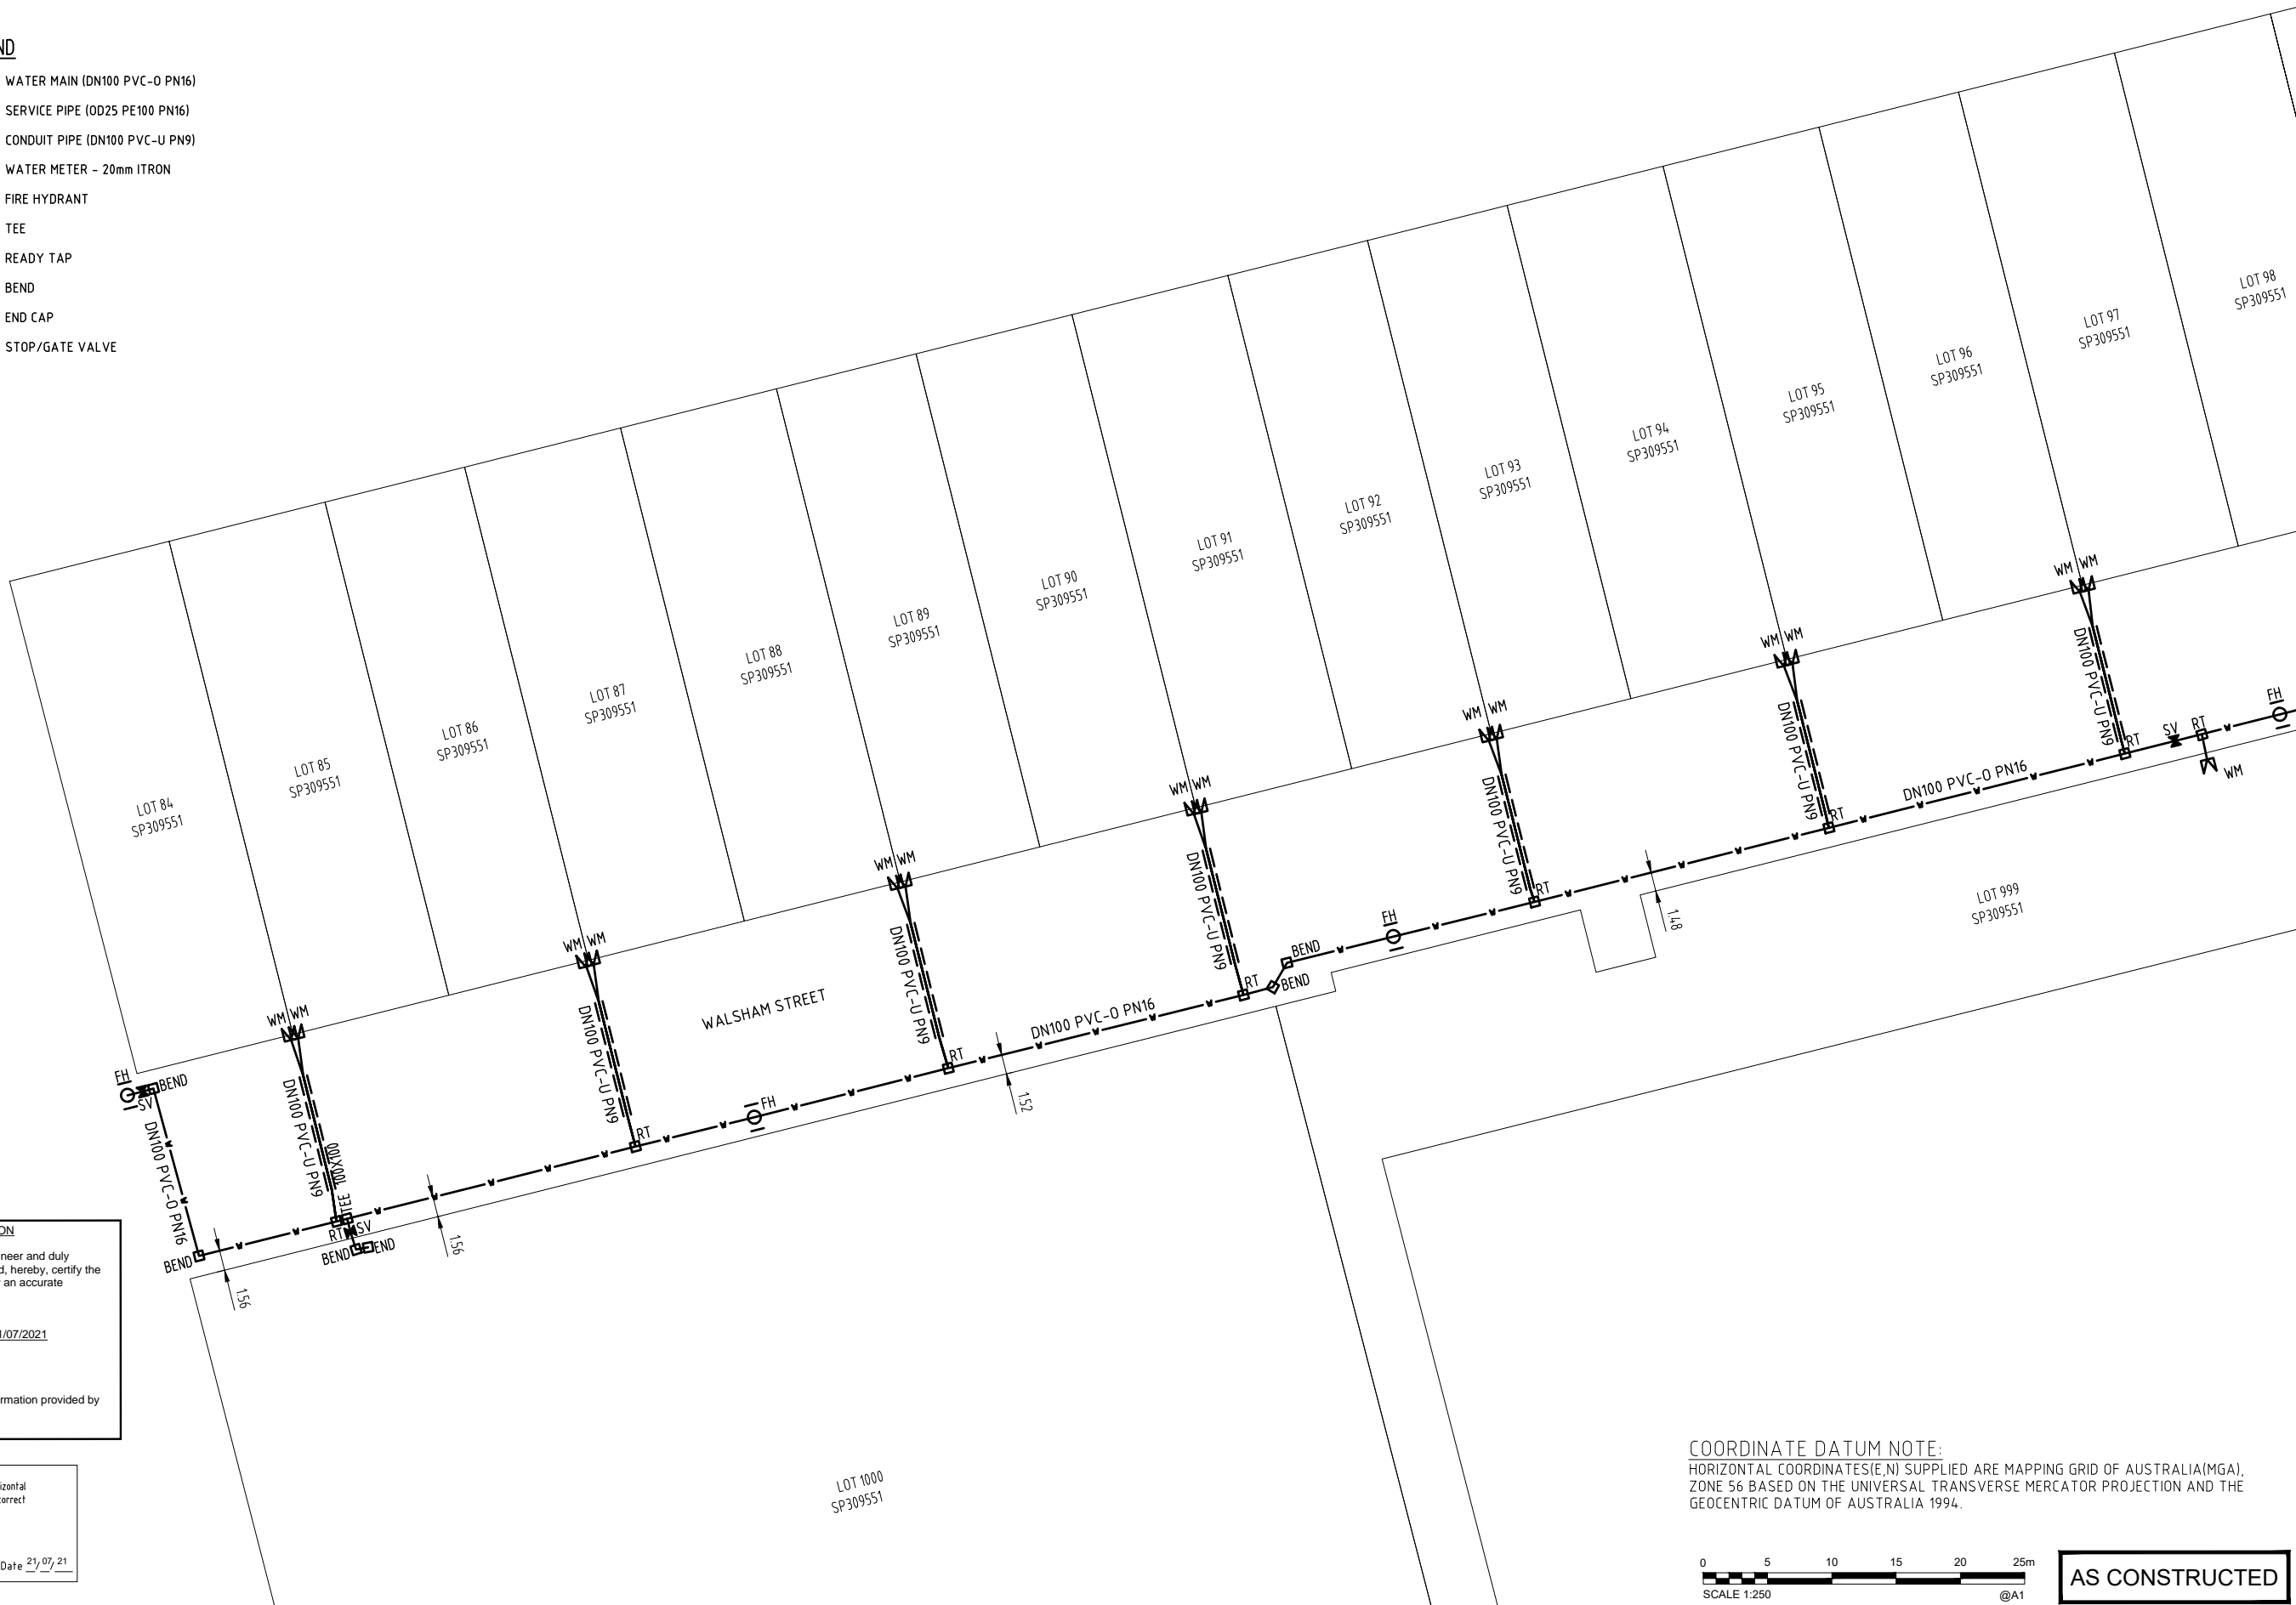


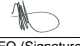ENGINEER'S CERTIFICATION
 I, Troy Schultz, being a Certified/Registered Engineer and duly authorised representative of PEAKURBAN Pty Ltd, hereby certify the information contained in this drawing as generally an accurate "As Constructed" representation of the works.
 Date: 21/07/2021
 RPEQ (Signature) 20631 RPEQ No.

For and on behalf of PEAKURBAN Pty Ltd.
 In making this certificate we have relied upon information provided by others.

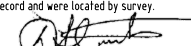Registered Surveyor's certification
 I, Daniel Coates, hereby certify that the vertical and horizontal locations, and dimensions shown on this plan are a true and correct record and were located by survey.

 Registered Surveyor Reg Surveyor No 4554 (RPS) Date 21/07/21

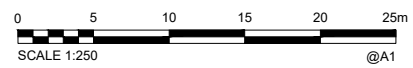COORDINATE DATUM NOTE:
 HORIZONTAL COORDINATES(E,N) SUPPLIED ARE MAPPING GRID OF AUSTRALIA(MGA), ZONE 56 BASED ON THE UNIVERSAL TRANSVERSE MERCATOR PROJECTION AND THE GEOCENTRIC DATUM OF AUSTRALIA 1994.



AS CONSTRUCTED

A1	0	09/07/2021	AS CONSTRUCTED	JK	LG				
	INDEX	DATE	REVISIONS	DRAWN	CHECKED	PASSED	INITIALS	DATE	

DRAWN	JK	09/07/2021
CHECKED	LG	09/07/2021
PASSED		



Unitywater
 UW201901386856
 WATER RETICULATION AS CONSTRUCTED
 SAMSONVALE ROAD STRATHPINE STAGE 5


SHEET 1 OF 2 SHEETS	SCALE 1:250
REVISION DATE 09/07/2021	REVISION 0
DISCIPLINE CODE C	
DRAWING NO. U-2021-3494	

PSM108388
 E: 497935.052
 N: 6980351.382
 RL: 19.89m



LEGEND

- WATER MAIN (DN100 PVC-O PN16)
- SERVICE PIPE (OD25 PE100 PN16)
- CONDUIT PIPE (DN100 PVC-U PN9)
- WATER METER - 20mm ITRON
- FIRE HYDRANT
- TEE
- READY TAP
- BEND
- END CAP
- STOP/GATE VALVE

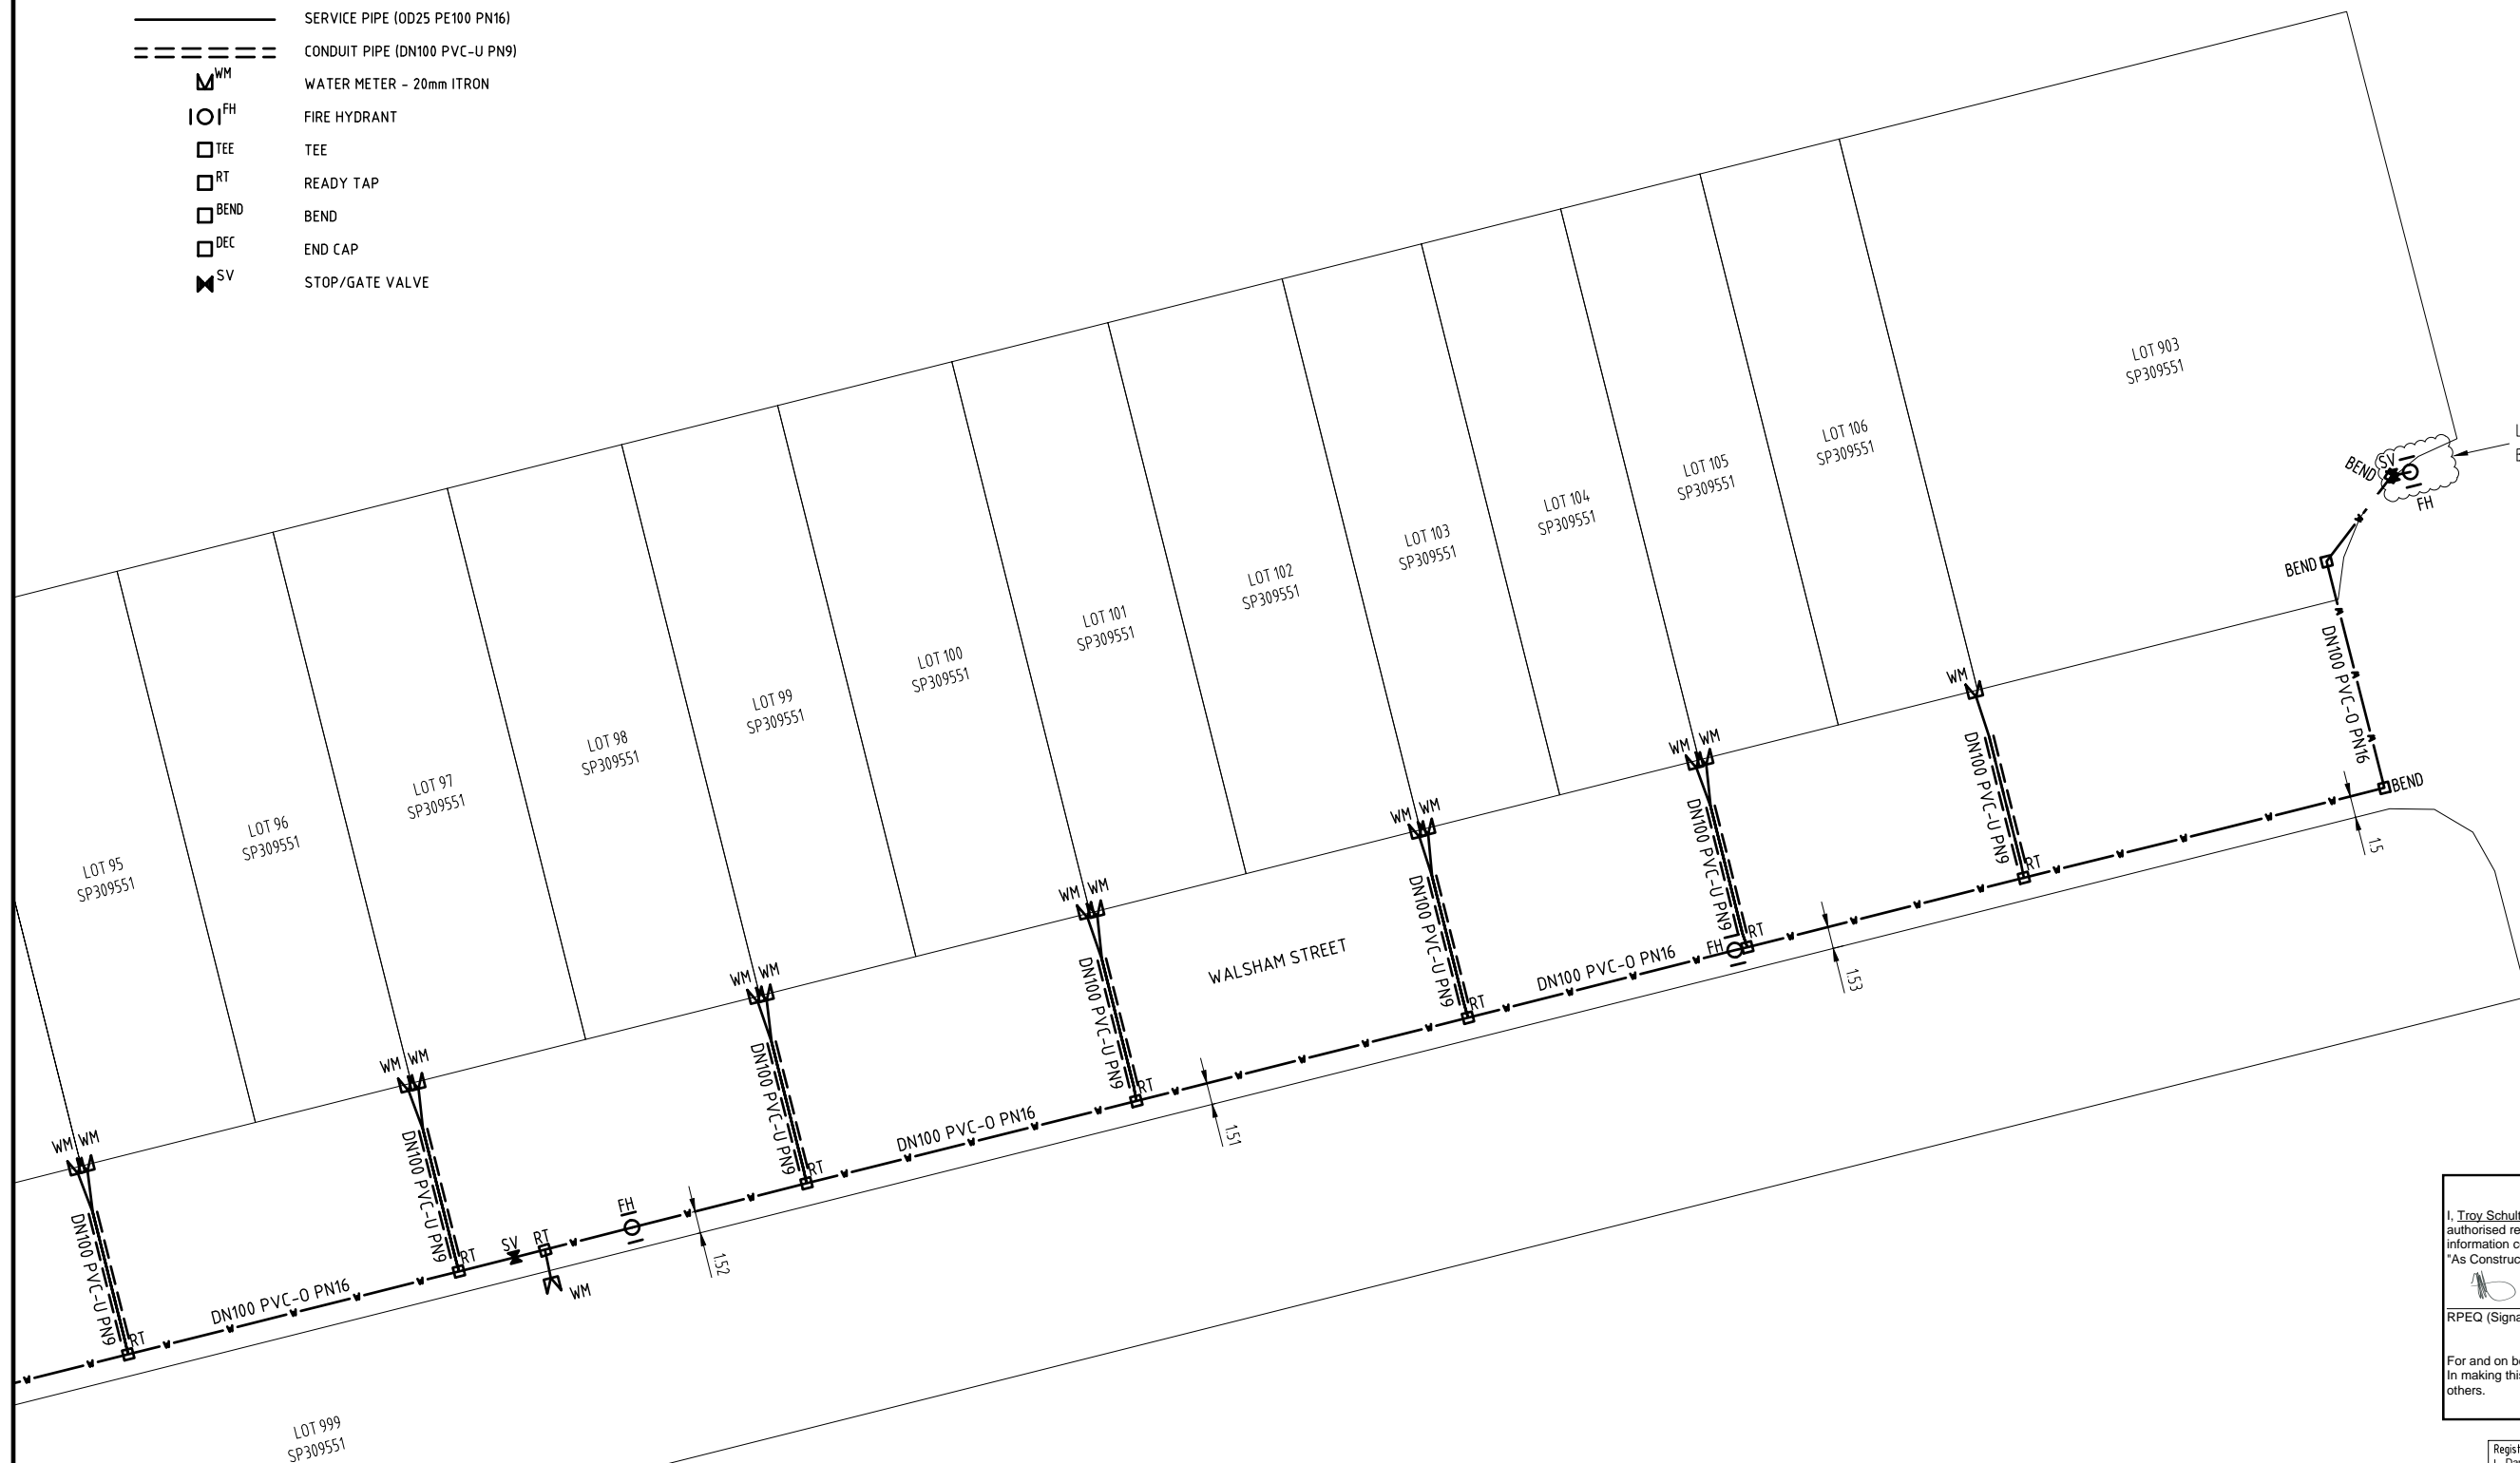

ENGINEER'S CERTIFICATION

I, Troy Schultz, being a Certified/ Registered Engineer and duly authorised representative of PEAKURBAN Pty Ltd, hereby certify the information contained in this drawing as generally an accurate "As Constructed" representation of the works.


RPEQ (Signature) 20631 RPEQ No. Date: 21/07/2021

For and on behalf of PEAKURBAN Pty Ltd.
 In making this certificate we have relied upon information provided by others.

Registered Surveyor's certification
 I, Daniel Coates, hereby certify that the vertical and horizontal locations, and dimensions shown on this plan are a true and correct record and were located by survey.

Registered Surveyor Reg Surveyor No. 4554 (RPS) Date 21/07/21

COORDINATE DATUM NOTE:
 HORIZONTAL COORDINATES (E, N) SUPPLIED ARE MAPPING GRID OF AUSTRALIA (MGA), ZONE 56 BASED ON THE UNIVERSAL TRANSVERSE MERCATOR PROJECTION AND THE GEOCENTRIC DATUM OF AUSTRALIA 1994.

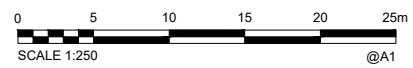

AS CONSTRUCTED

A1	0	09/07/2021	AS CONSTRUCTED	JK	LG					
	INDEX	DATE	REVISIONS	DRAWN	CHECKED	PASSED	INITIALS	DATE		

DRAWN	JK	09/07/2021
CHECKED	LG	09/07/2021
PASSED		



Unitywater

UW201901386856
 WATER RETICULATION AS CONSTRUCTED
 SAMSONVALE ROAD STRATHPINE STAGE 5

SHEET 2 OF 2 SHEETS	SCALE 1:250
REVISION DATE 09/07/2021	REVISION 0
DISCIPLINE CODE C	
DRAWING NO. U-2021-3494	