

LEGEND

- Trees
- Landscape – Grass
- Landscape – Revegetation
- Concrete Path or Driveway
- Kerb and Channel

"I, _____, being a certified / registered engineer and duly authorised representative of hereby -

- × Certify the information contained in this drawing is an accurate "AS CONSTRUCTED" representation of the works.
- × Accept responsibility for the "AS CONSTRUCTED" information contained in this drawing.
- × Acknowledge the "AS CONSTRUCTED" information contained in the drawing may be relied on by Council and others.



Certification for Stage by on

for
Registered Professional Engineer of Queensland - No.

We RPS Australia East Pty Ltd, Registered Surveyor – Land hereby certify that the Levels and Dimensions shown hereon are a correct record of our Survey which was performed in accordance with Council Accuracy Standards

..... 24/6/2020
Date

.....
Authorised Delegate

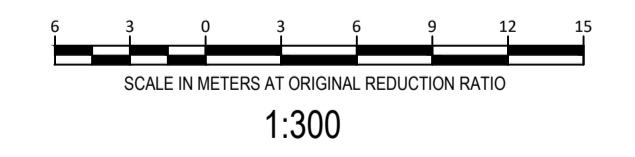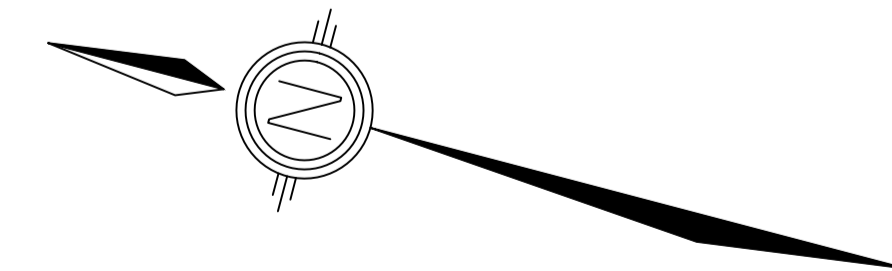

PROJECT SAMSONVALE ROAD		CLIENT PEET LIMITED	
LEVEL DATUM AHD	SCALE 1:300 @ A1	AS CONSTRUCTED LANDSCAPE STAGES 2	
ORIGIN PM 108388 RL 19.893	Date: JUNE 2020 Surveyed: RPS		
Comp. by: TJE	Parish: STRATHPINE Local Authority: MORETON BAY REGIONAL COUNCIL		
FB :	LB :	DWG: 142823 Stage2LANDSCAPE	Job Ref 142823-2

rps

RPS Australia East Pty Ltd
ACN 140 292 762
ABN 44 140 292 762
Level 4 HQ South, 520 Wickham St
PO Box 1559
Fortitude Valley QLD 4006
T +61 7 3539 9500
F +61 7 3237 8833
W rpsgroup.com.au


©COPYRIGHT PROTECTS THIS PLAN
Unauthorised reproduction or amendment
not permitted. Please contact the author.

Reference
142823-13

Rev

VIENNA

WAY

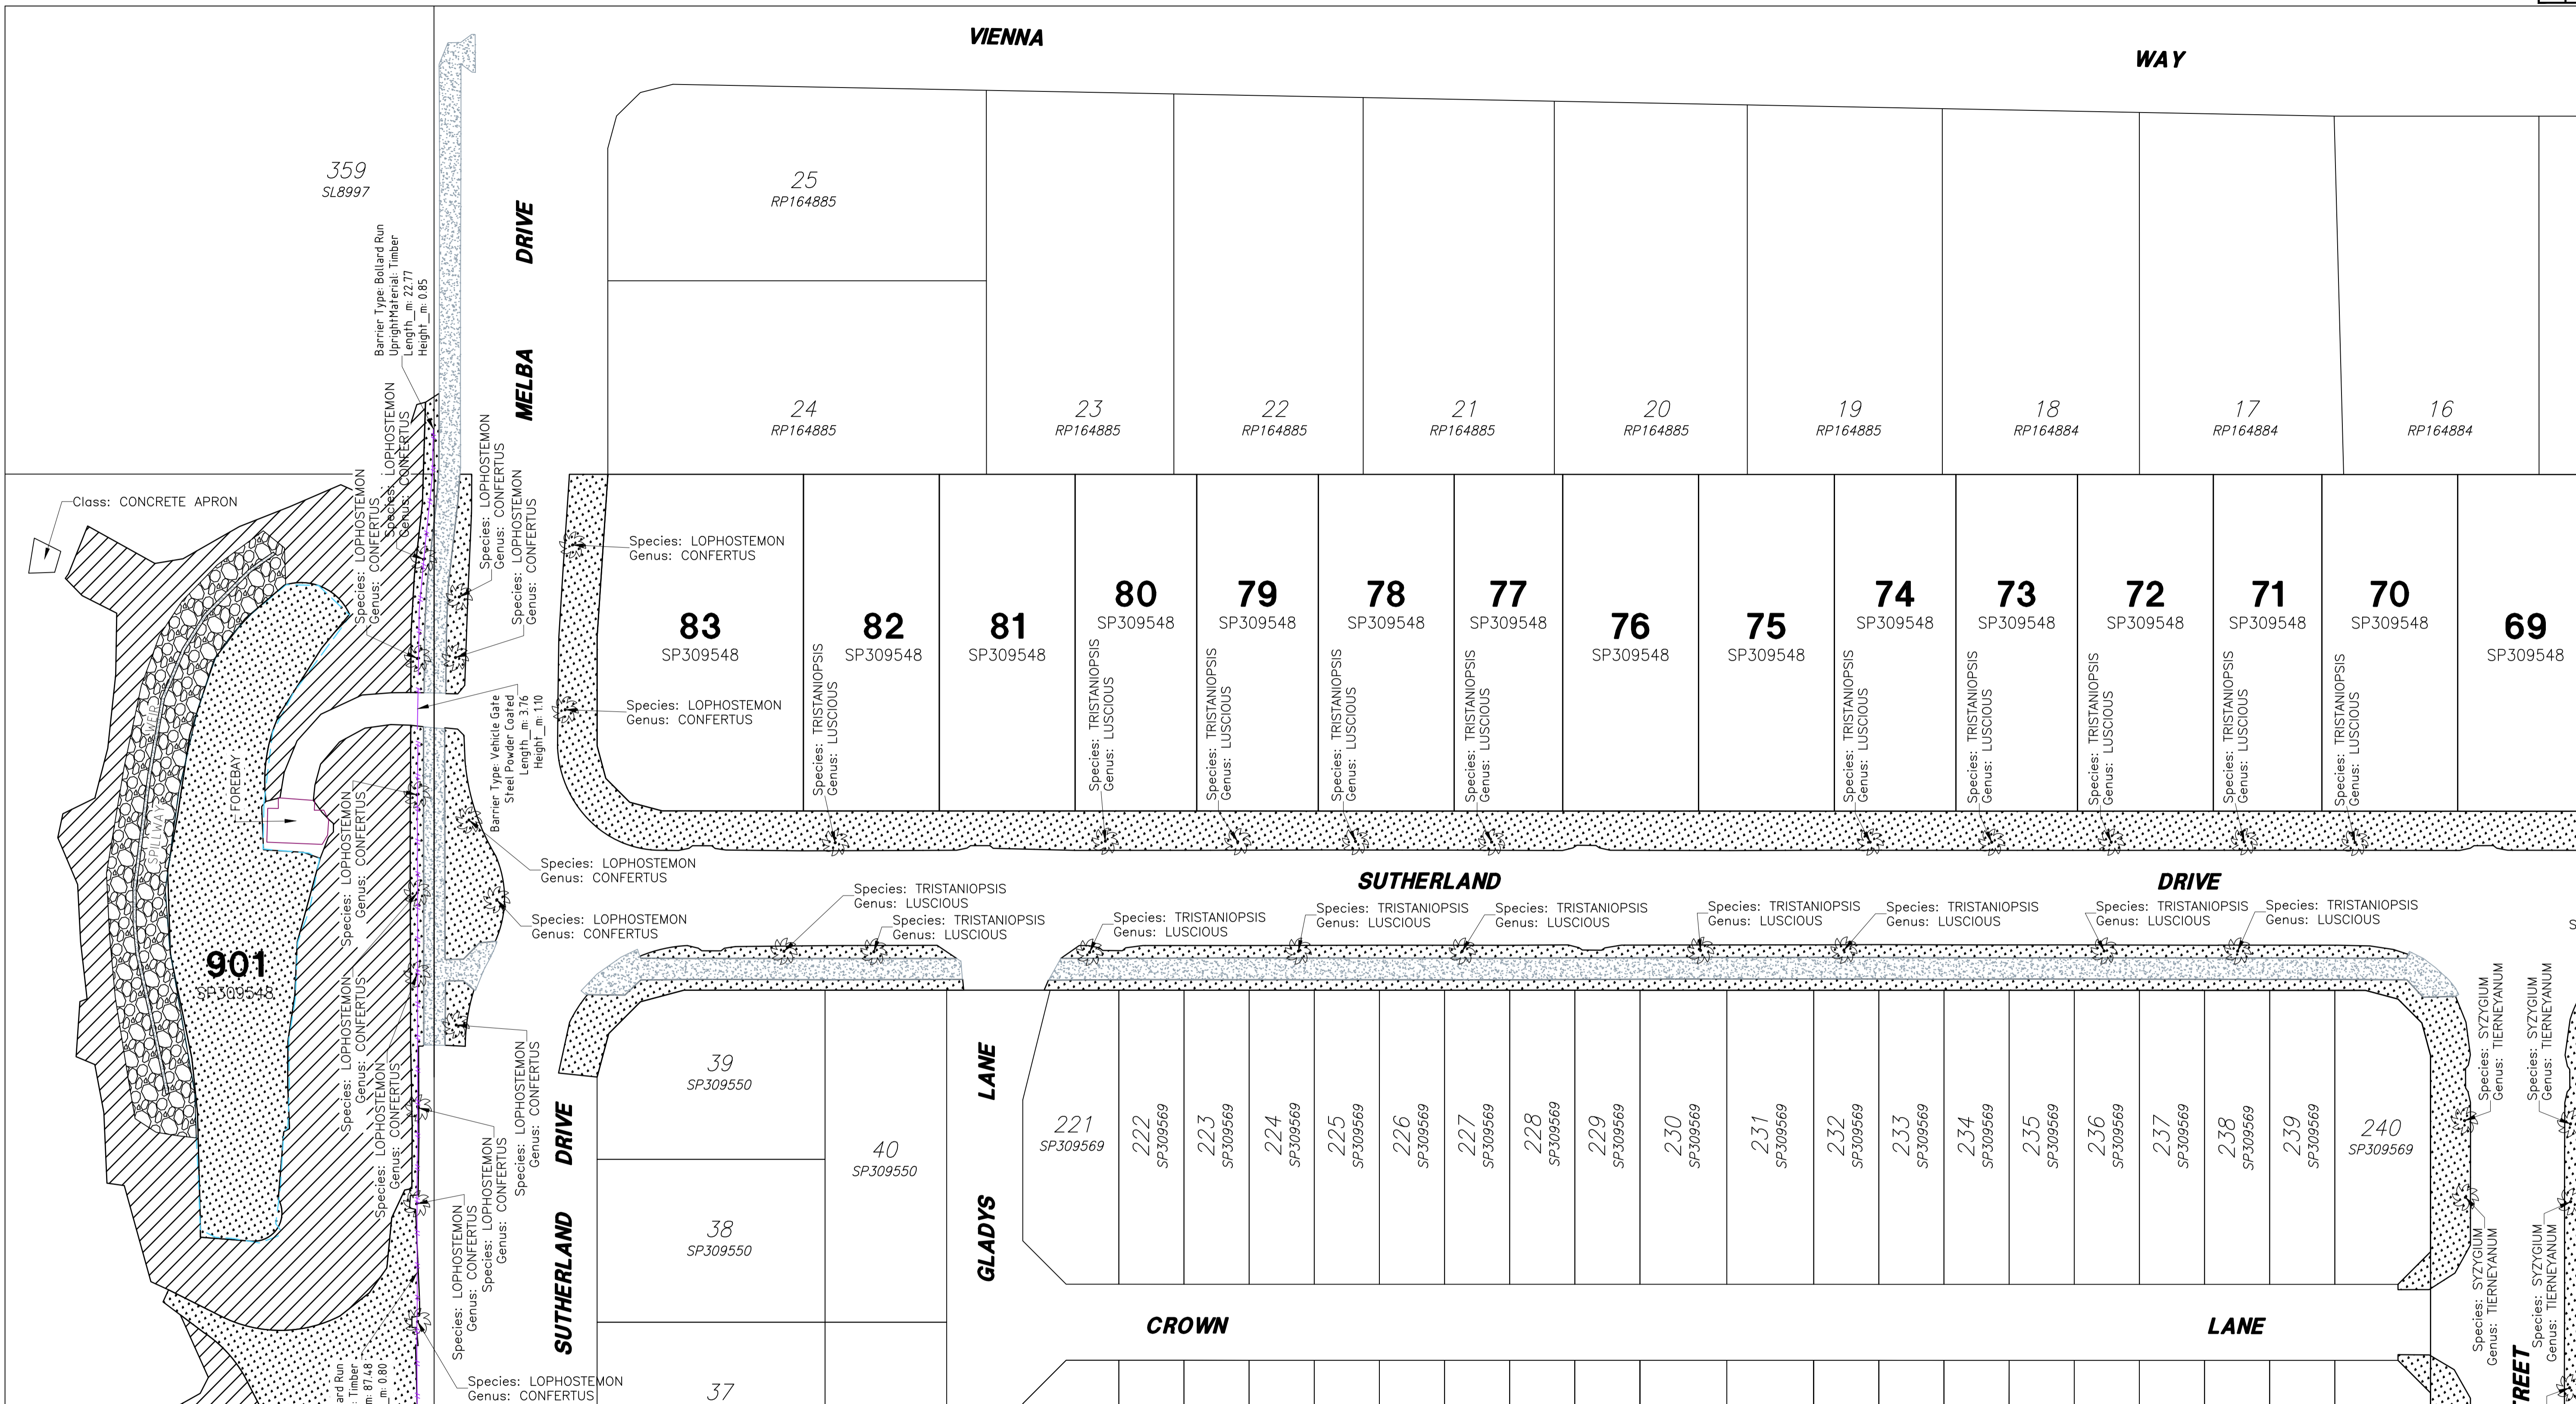

LEGEND

- Trees
- Landscape - Grass
- Landscape - Revegetation
- Concrete Path or Driveway
- Kerb and Channel

"I, _____, being a certified / registered engineer and duly authorised representative of hereby -

- × Certify the information contained in this drawing is an accurate "AS CONSTRUCTED" representation of the works.
- × Accept responsibility for the "AS CONSTRUCTED" information contained in this drawing.
- × Acknowledge the "AS CONSTRUCTED" information contained in the drawing may be relied on by Council and others.


Certification for Stage by on

for
Registered Professional Engineer of Queensland - No.

We RPS Australia East Pty Ltd, Registered Surveyor - Land hereby certify that the Levels and Dimensions shown hereon are a correct record of our Survey which was performed in accordance with Council Accuracy Standards

..... 24/6/2020
Date

.....
Authorised Delegate

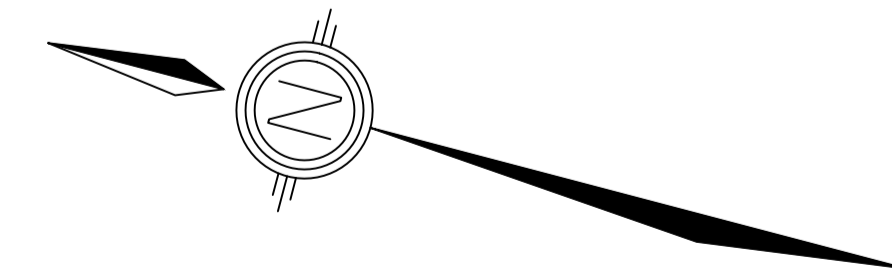

PROJECT SAMSONVALE ROAD		CLIENT PEET LIMITED	
LEVEL DATUM AHD	SCALE 1:300 @ A1	AS CONSTRUCTED LANDSCAPE STAGES 2	
ORIGIN PM 108388 RL 19.893	Date: JUNE 2020 Surveyed: RPS		
Comp. by: TJE	Parish: STRATHPINE Local Authority: MORETON BAY REGIONAL COUNCIL		
FB :	LB :	DWG: 142823 Stage2LANDSCAPE	Job Ref 142823-2


rps

RPS Australia East Pty Ltd
ACN 140 292 762
ABN 44 140 292 762
Level 4 HQ South, 520 Wickham St
PO Box 1559
Fortitude Valley QLD 4006
T +61 7 3539 9500
F +61 7 3237 8833
W rpsgroup.com.au

© COPYRIGHT PROTECTS THIS PLAN
Unauthorized reproduction or amendment
not permitted. Please contact the author.

Reference
142823-13

Rev

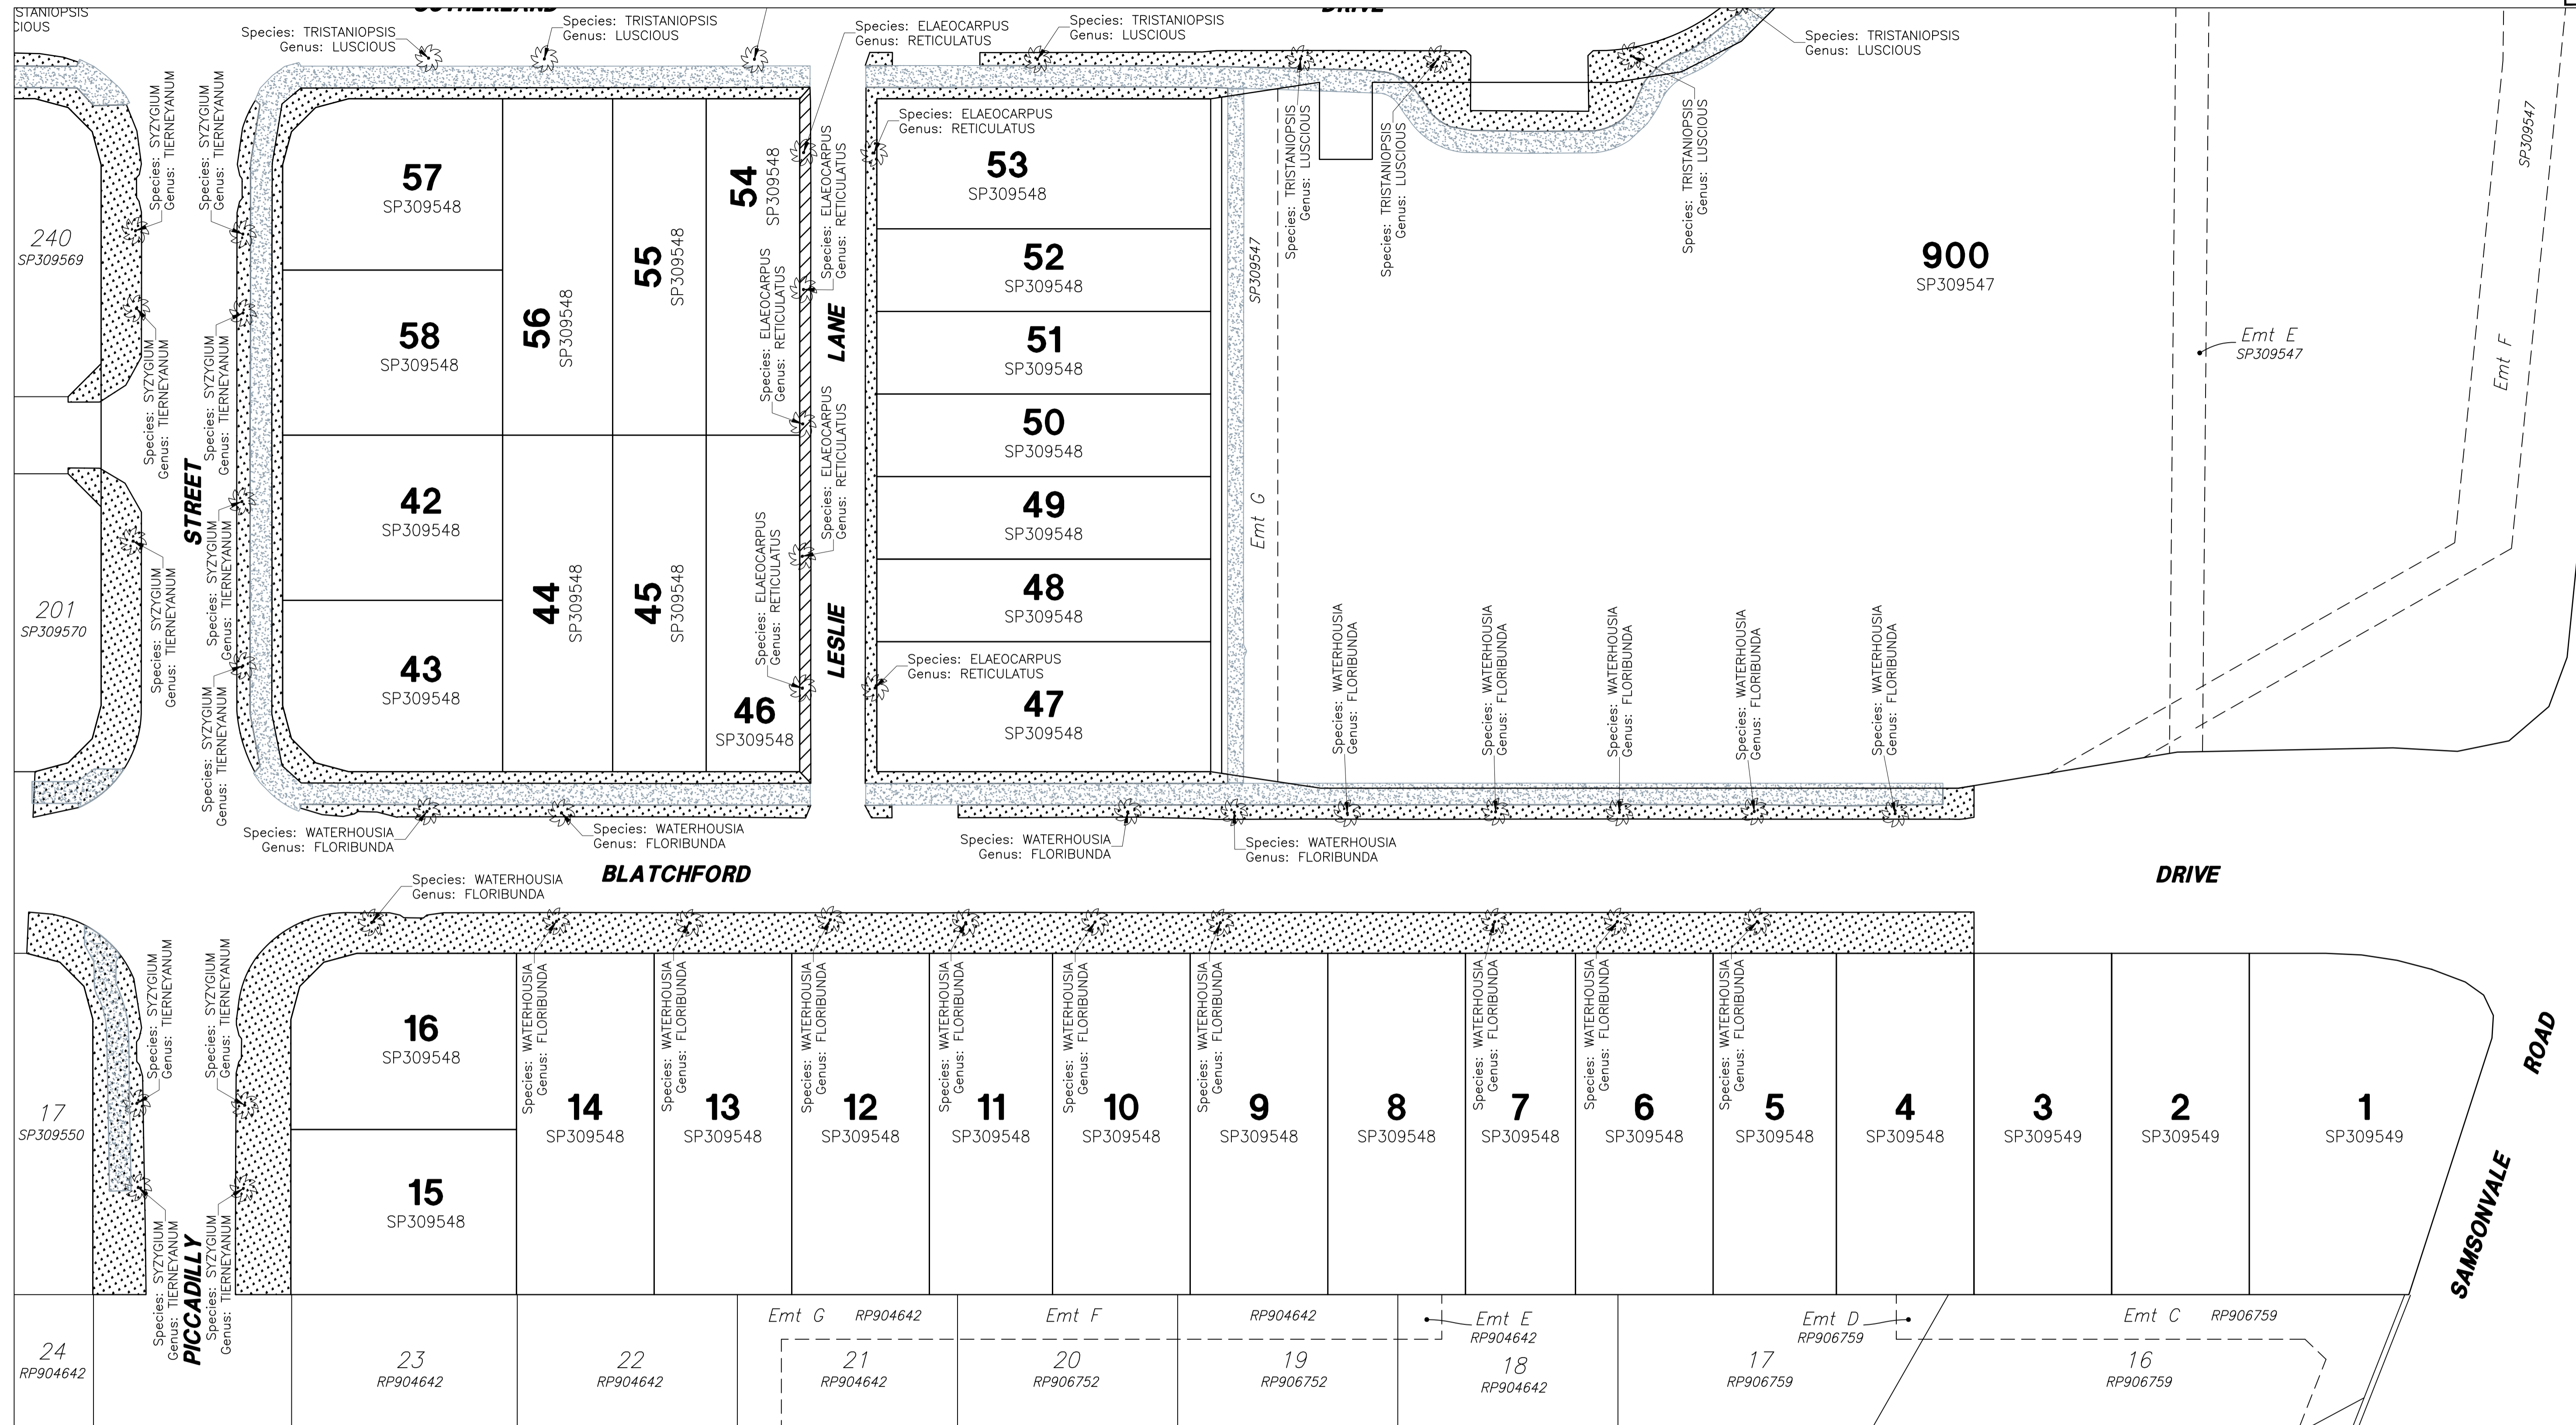

LEGEND

- Trees
- Landscape – Grass
- Landscape – Revegetation
- Concrete Path or Driveway
- Kerb and Channel

"I, _____, being a certified / registered engineer and duly authorised representative of hereby -

- × Certify the information contained in this drawing is an accurate "AS CONSTRUCTED" representation of the works.
- × Accept responsibility for the "AS CONSTRUCTED" information contained in this drawing.
- × Acknowledge the "AS CONSTRUCTED" information contained in the drawing may be relied on by Council and others.


Certification for Stage by on

for
Registered Professional Engineer of Queensland - No.

We RPS Australia East Pty Ltd, Registered Surveyor – Land hereby certify that the Levels and Dimensions shown hereon are a correct record of our Survey which was performed in accordance with Council Accuracy Standards

..... 24/6/2020
Date


.....
Authorised Delegate

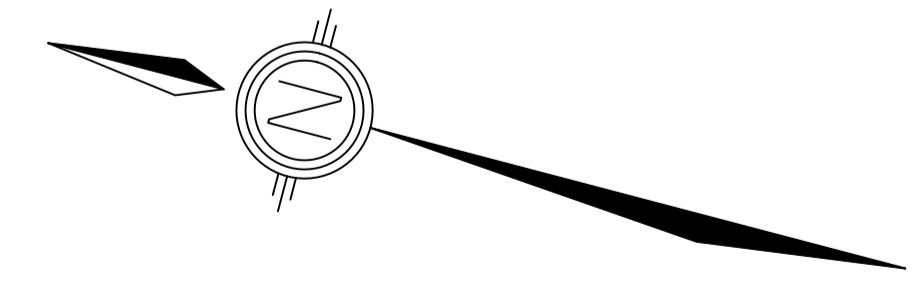

PROJECT SAMSONVALE ROAD		CLIENT PEET LIMITED	
LEVEL DATUM AHD	SCALE 1:300 @ A1	AS CONSTRUCTED LANDSCAPE STAGES 2	
ORIGIN PM 108388 RL 19.893	Date: JUNE 2020 Surveyed: RPS		
Comp. by: TJE	Parish: STRATHPINE	Job Ref: 142823-2	
FB : LB :	DWG: 142823 Stage2LANDSCAPE	Local Authority: MORETON BAY REGIONAL COUNCIL	Reference 142823-13

RPS Australia East Pty Ltd
ACN 140 292 762
ABN 44 140 292 762
Level 4 HQ South, 520 Wickham St
PO Box 1559
Fortitude Valley QLD 4006
T +61 7 3539 9500
F +61 7 3237 8833
W rpsgroup.com.au

© COPYRIGHT PROTECTS THIS PLAN
Unauthorised reproduction or amendment
not permitted. Please contact the author.

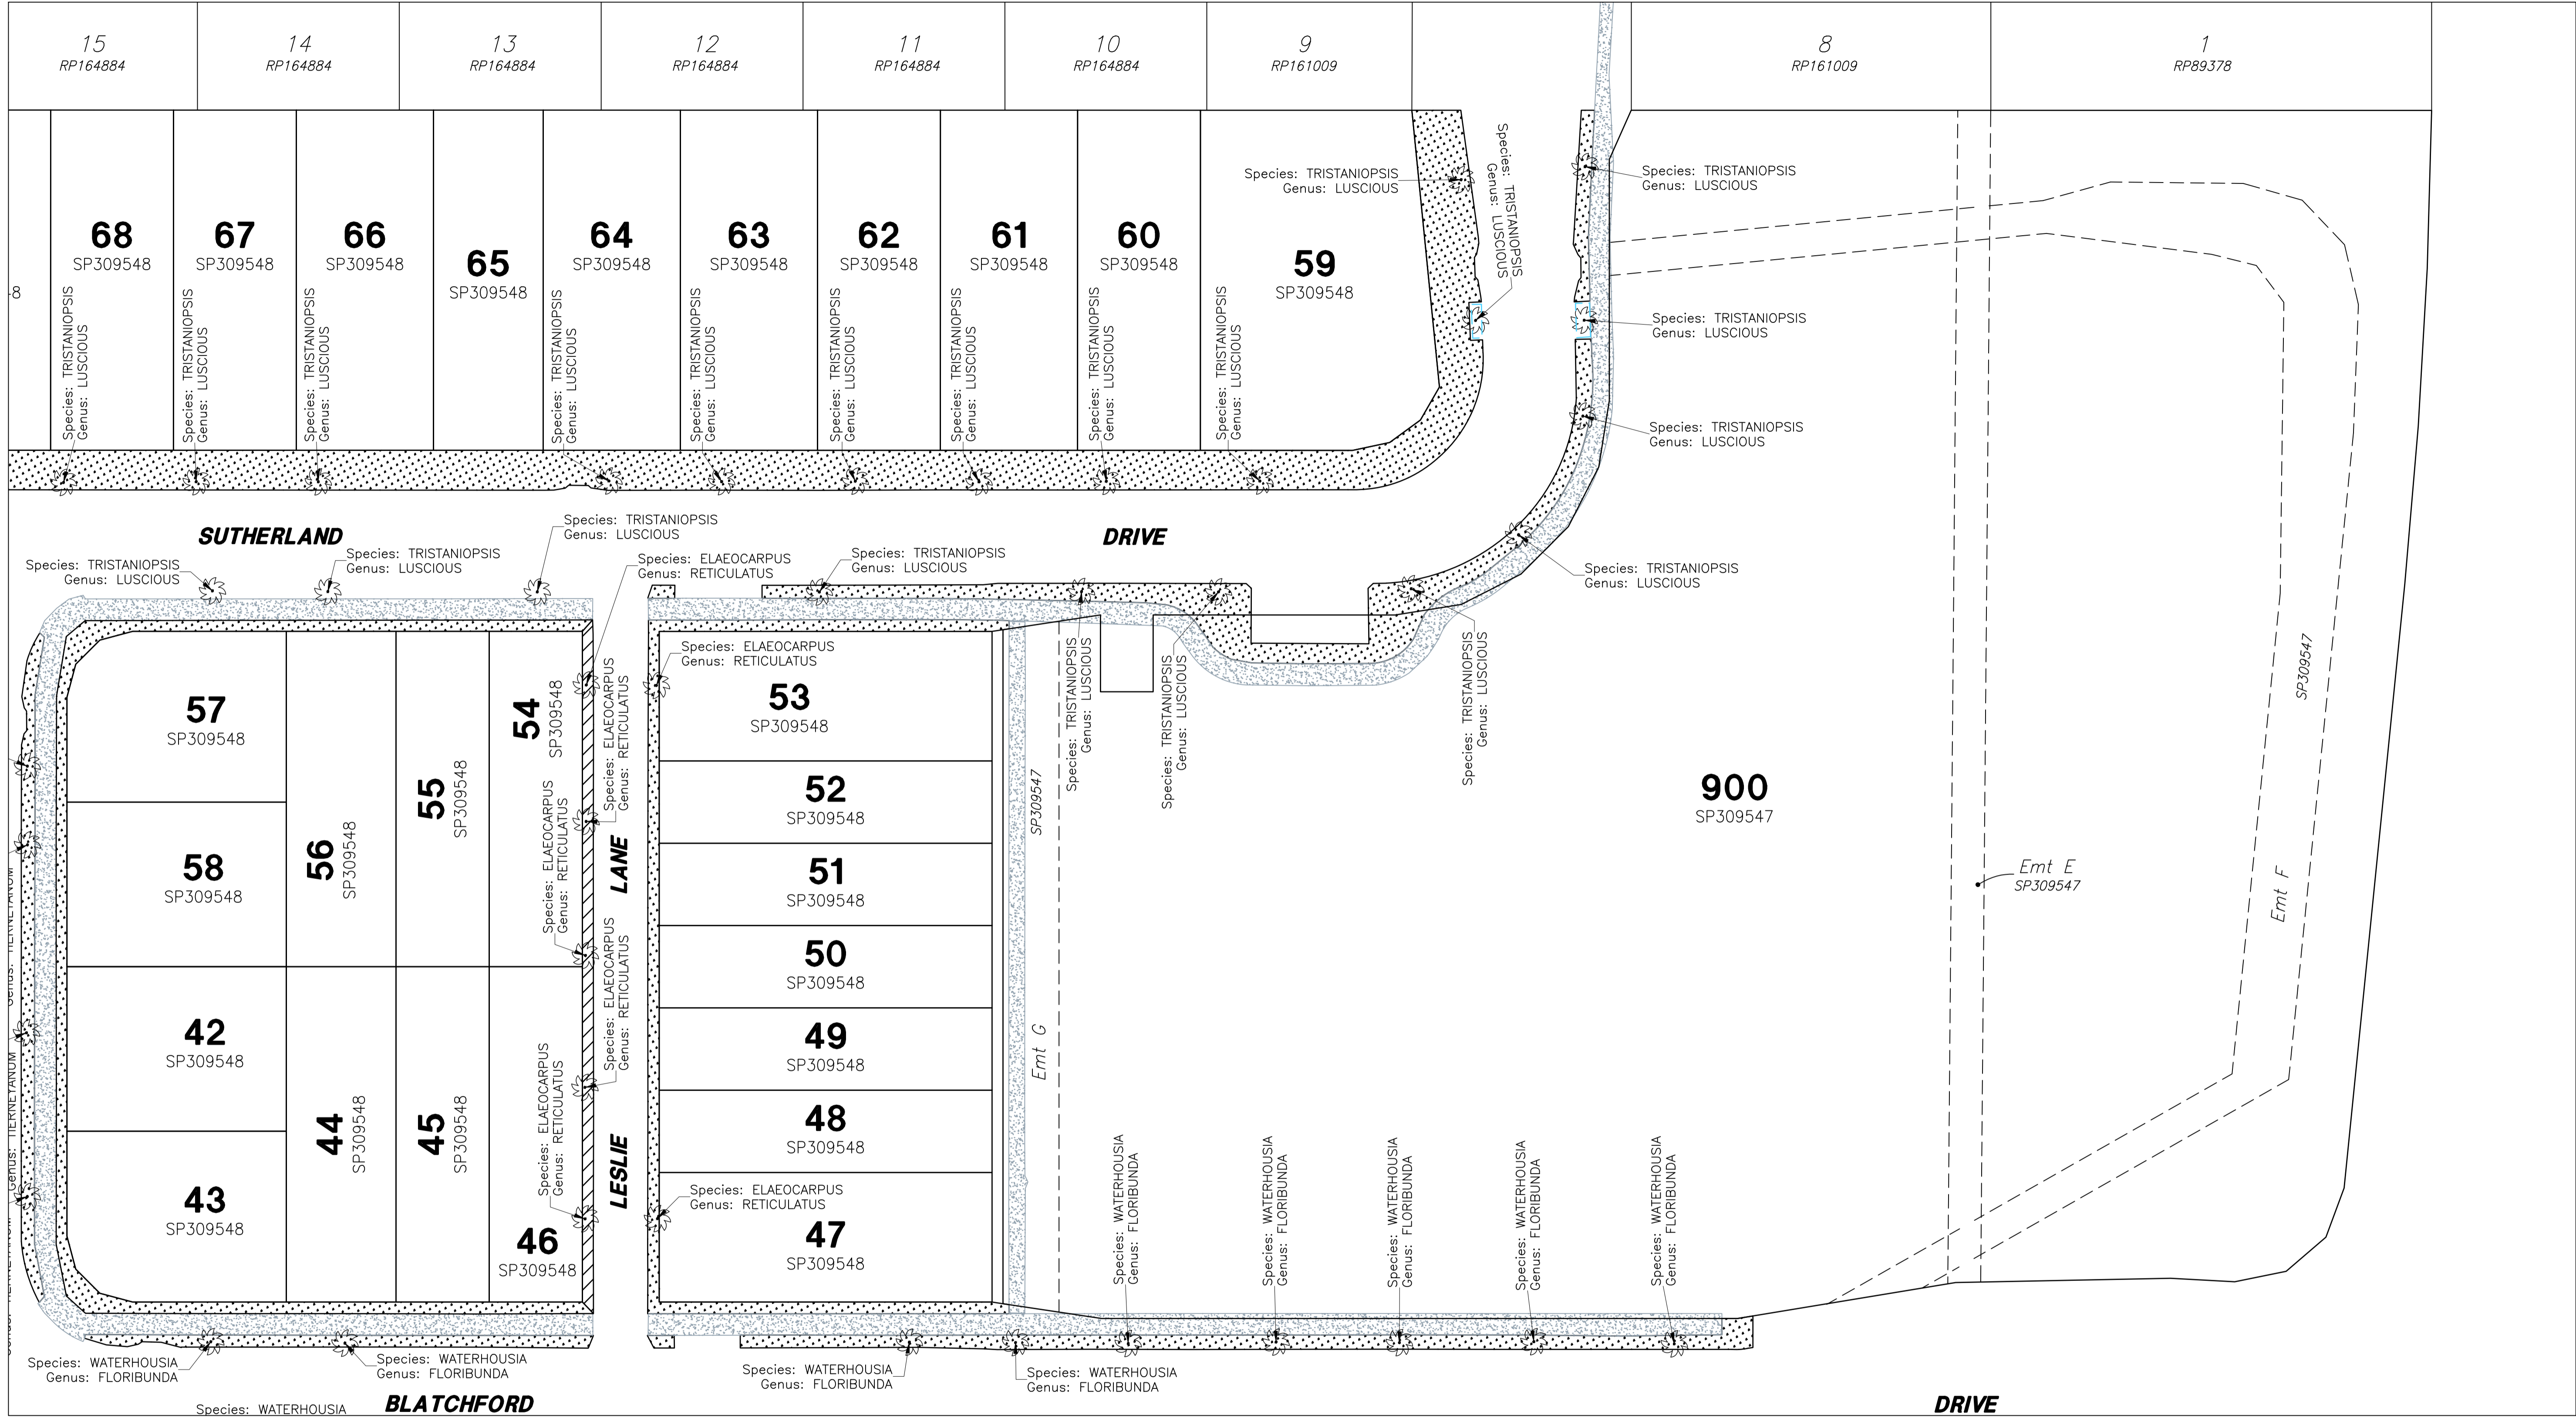

LEGEND	
	Trees
	Landscape - Grass
	Landscape - Revegetation
	Concrete Path or Driveway
	Kerb and Channel

"I, _____, being a certified / registered engineer and duly authorised representative of hereby -

- × Certify the information contained in this drawing is an accurate "AS CONSTRUCTED" representation of the works.
- × Accept responsibility for the "AS CONSTRUCTED" information contained in this drawing.
- × Acknowledge the "AS CONSTRUCTED" information contained in the drawing may be relied on by Council and others.


Certification for Stage by on

for
Registered Professional Engineer of Queensland - No.

We RPS Australia East Pty Ltd, Registered Surveyor - Land hereby certify that the Levels and Dimensions shown hereon are a correct record of our Survey which was performed in accordance with Council Accuracy Standards

24/6/2020
Date


Authorised Delegate

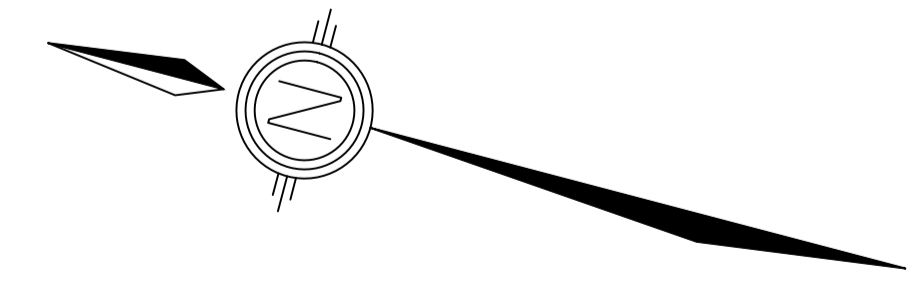

PROJECT SAMSONVALE ROAD		CLIENT PEET LIMITED	
LEVEL DATUM AHD	SCALE 1:300 @ A1	AS CONSTRUCTED LANDSCAPE STAGES 2	
ORIGIN PM 108388 RL 19.893	Date: JUNE 2020 Surveyed: RPS		
Comp. by: TJE	Parish: STRATHPINE	Job Ref: 142823-2	Reference: 142823-13
FB : LB :	DWG: 142823 Stage2LANDSCAPE	Local Authority: MORETON BAY REGIONAL COUNCIL	Rev

RPS Australia East Pty Ltd
ACN 140 292 762
ABN 44 140 292 762
Level 4 HQ South, 520 Wickham St
PO Box 1559
Fortitude Valley QLD 4006
T +61 7 3539 9500
F +61 7 3237 8833
W rpsgroup.com.au

© COPYRIGHT PROTECTS THIS PLAN
Unauthorized reproduction or amendment
not permitted. Please contact the author.

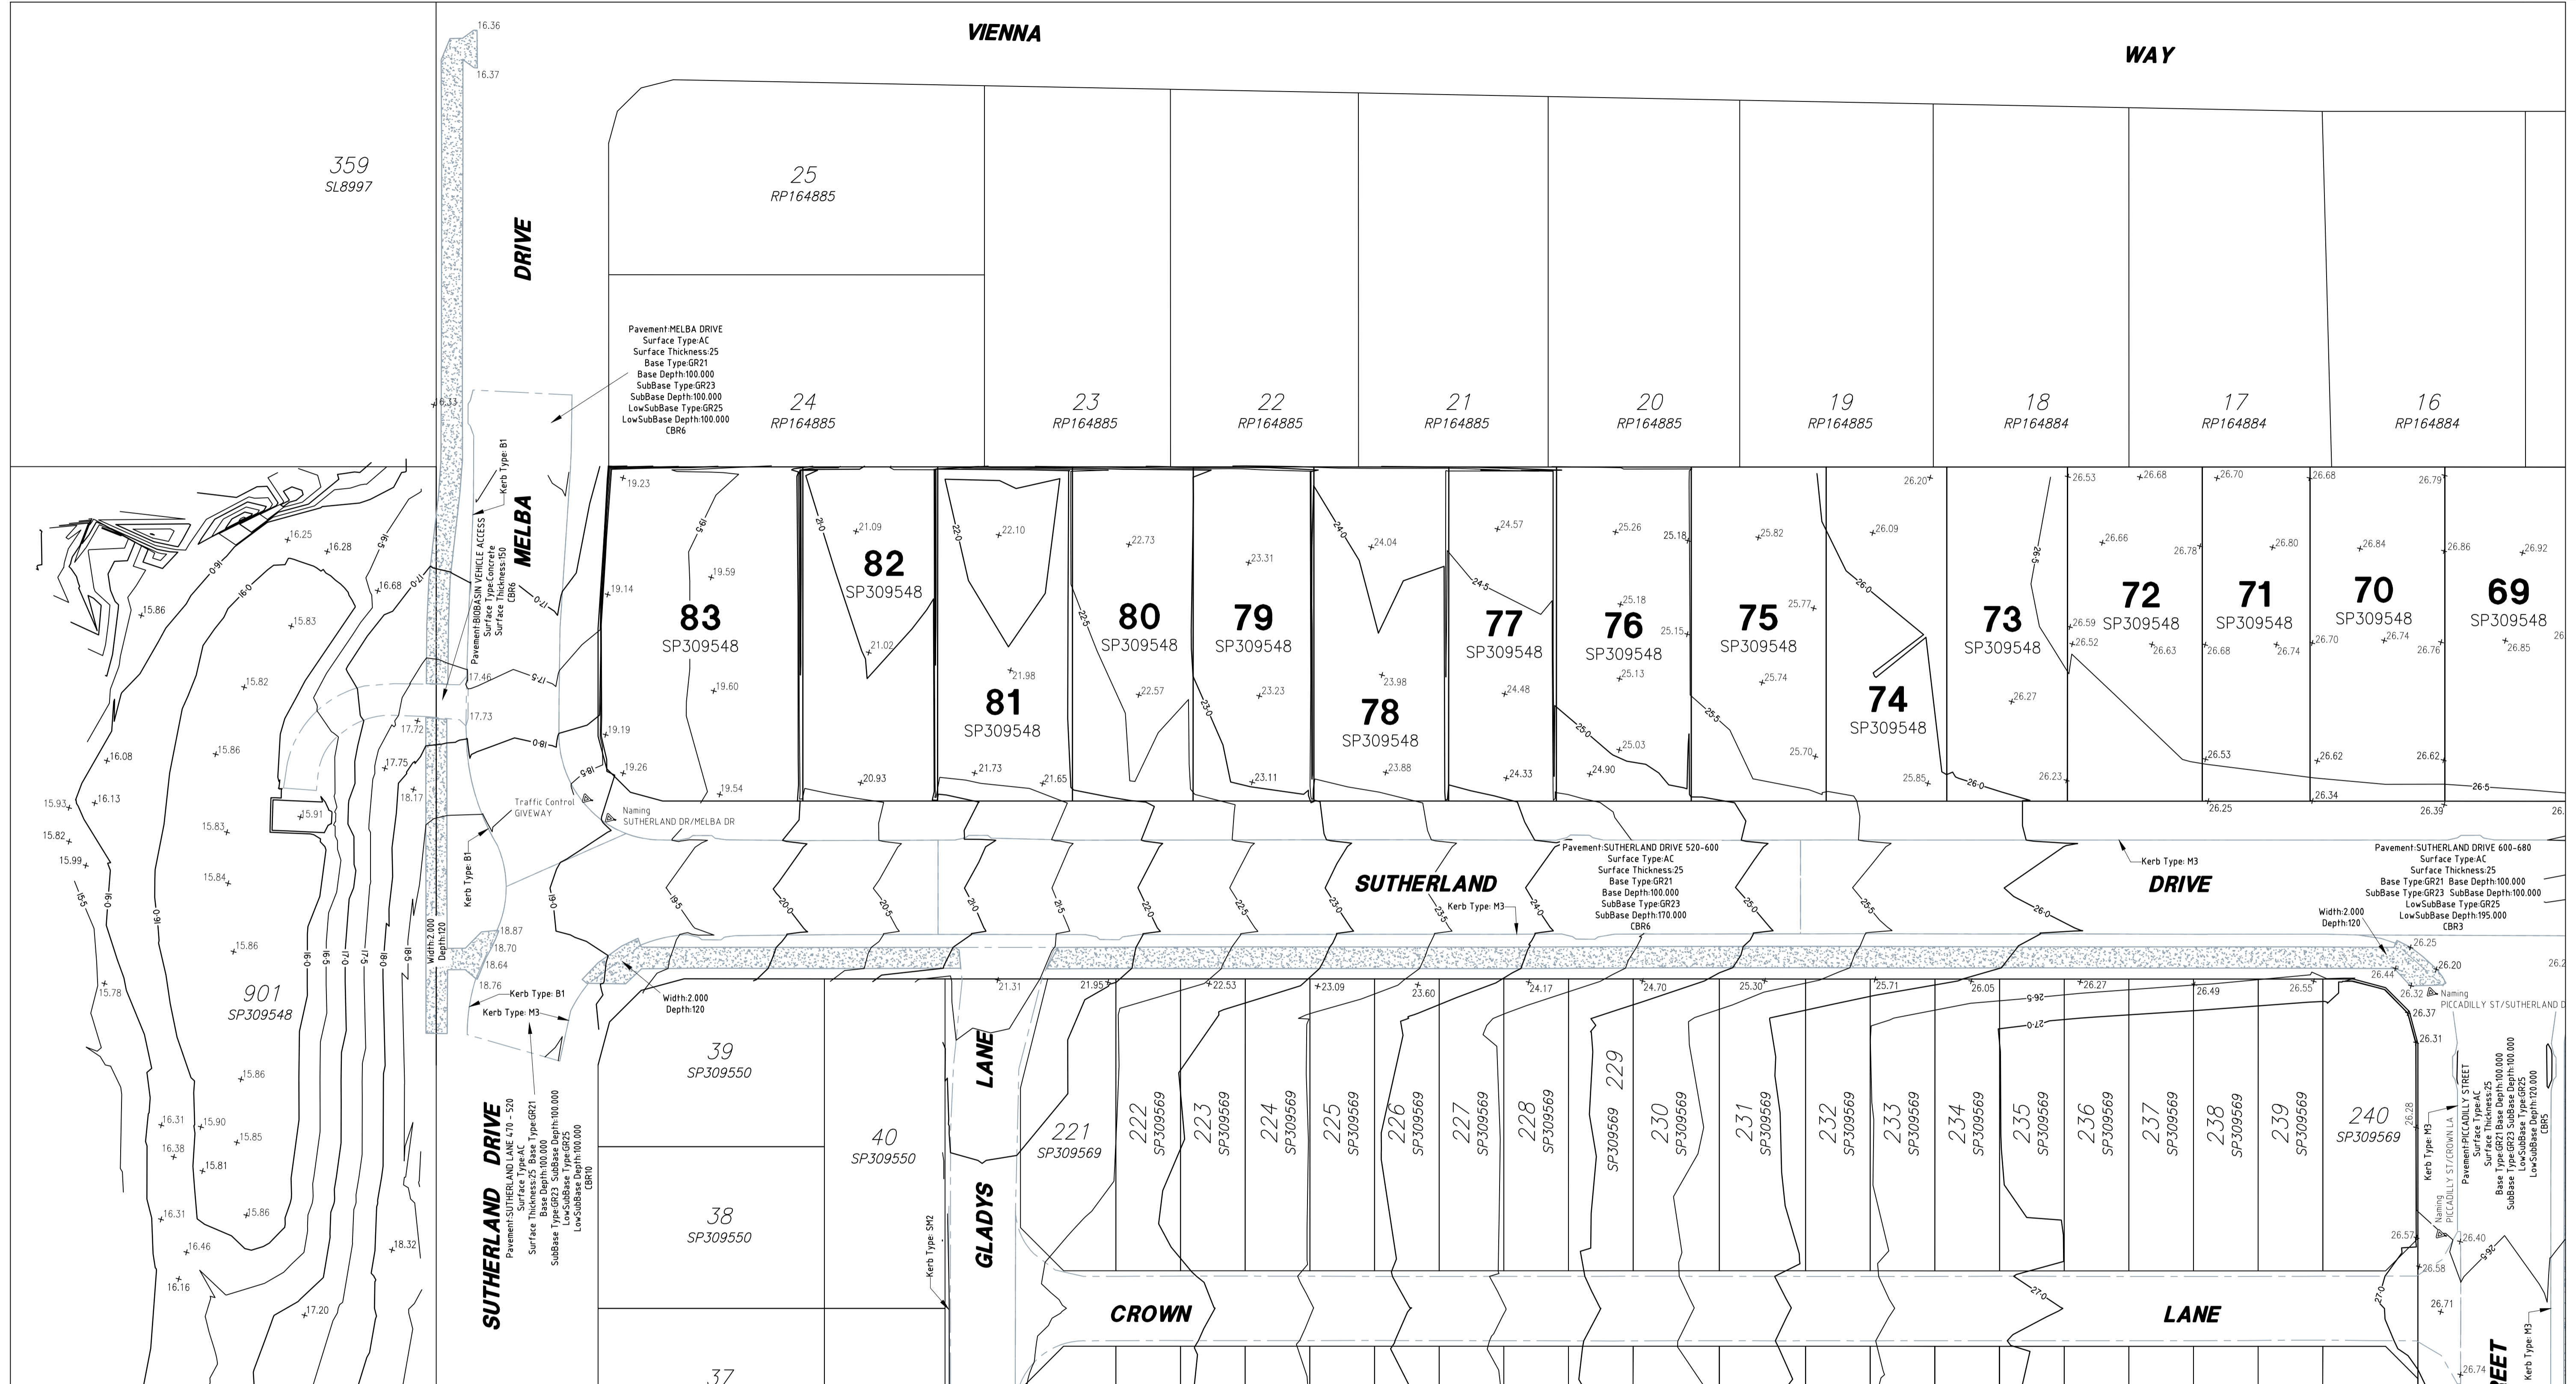

LEGEND

	Post Construction Contours
	Topographic Change In Grade
	Post Construction Surface Level
	Concrete Path or Driveway
	Kerb and Channel

"I, _____, being a certified / registered engineer and duly authorised representative of _____ hereby -



- × Certify the information contained in this drawing is an accurate "AS CONSTRUCTED" representation of the works.
- × Accept responsibility for the "AS CONSTRUCTED" information contained in this drawing.
- × Acknowledge the "AS CONSTRUCTED" information contained in the drawing may be relied on by Council and others.

Certification for Stage by on

for
Registered Professional Engineer of Queensland - No.

We RPS Australia East Pty Ltd, Registered Surveyor - Land hereby certify that the Levels and Dimensions shown hereon are a correct record of our Survey which was performed in accordance with Council Accuracy Standards

Authorised Delegate _____ Date 02/07/2020

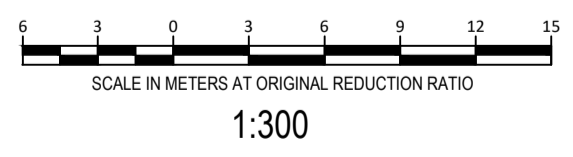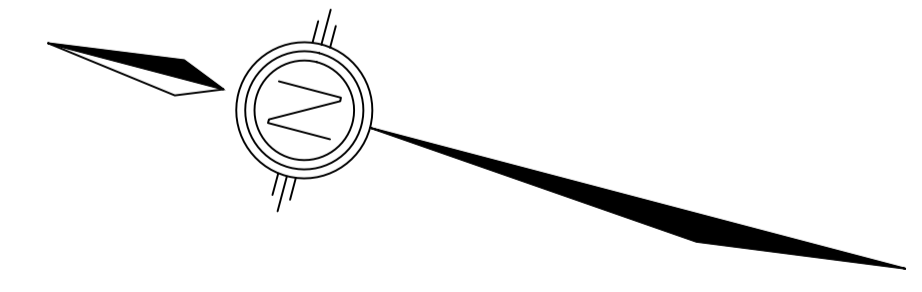


PROJECT SAMSONVALE ROAD		CLIENT PEET LIMITED	
LEVEL DATUM AHD	SCALE 1:300 @ A1	AS CONSTRUCTED POST CONSTRUCTION CONTOURS STAGES 2	
ORIGIN PM 108388 RL 19.893	Date. JULY 2020		
FB : _____	LB : _____		
Comp. by. TJE	Parish STRATHPINE	Job Ref 142823-2	
DWG. 142823 Stage2POST	Local Authority MORETON BAY REGIONAL COUNCIL		

rps

RPS Australia East Pty Ltd
ACN 140 292 762
ABN 44 140 292 762
Level 4 HQ South, 520 Wickham St
PO Box 1559
Fortitude Valley QLD 4006
T +61 7 3539 9500
F +61 7 3237 8833
W rpsgroup.com.au

Reference **142823-14**

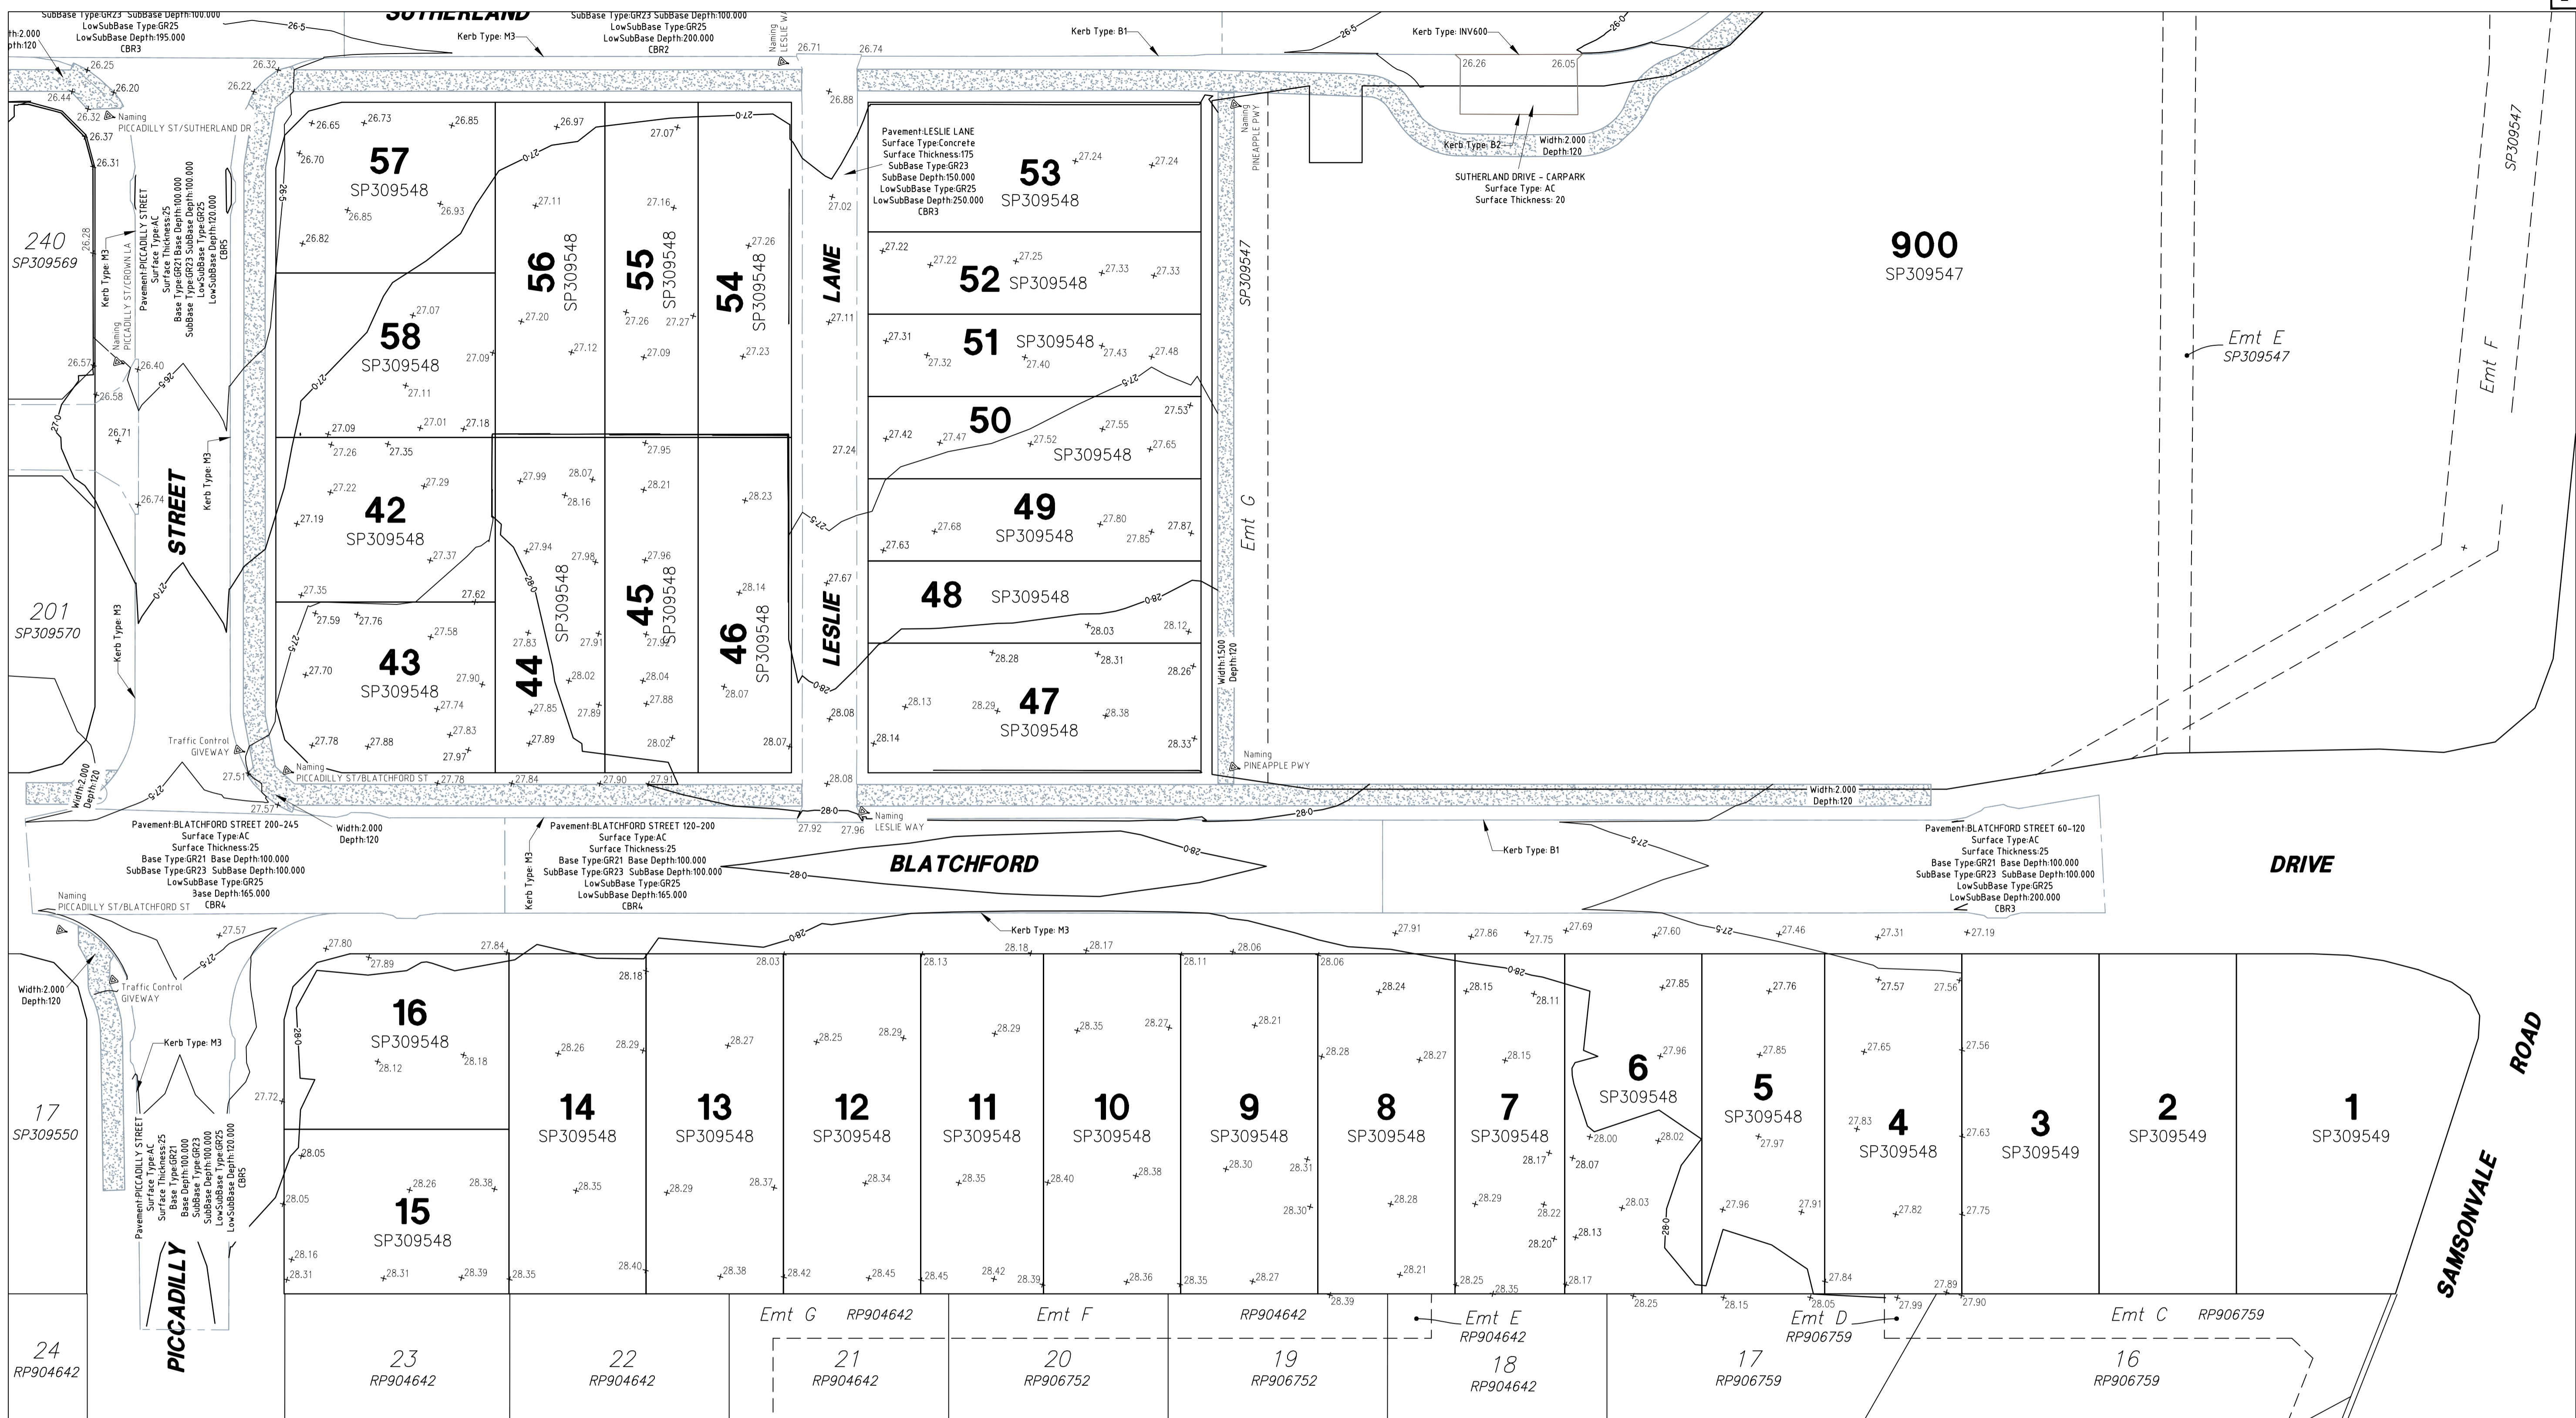

LEGEND

- Post Construction Contours
- Topographic Change In Grade
- Post Construction Surface Level
- Concrete Path or Driveway
- Kerb and Channel

"I, _____, being a certified / registered engineer and duly authorised representative of _____ hereby -


- × Certify the information contained in this drawing is an accurate "AS CONSTRUCTED" representation of the works.
- × Accept responsibility for the "AS CONSTRUCTED" information contained in this drawing.
- × Acknowledge the "AS CONSTRUCTED" information contained in the drawing may be relied on by Council and others.

Certification for Stage by on

for
Registered Professional Engineer of Queensland - No.

We RPS Australia East Pty Ltd, Registered Surveyor – Land hereby certify that the Levels and Dimensions shown hereon are a correct record of our Survey which was performed in accordance with Council Accuracy Standards

Authorised Delegate _____ Date 02/07/2020

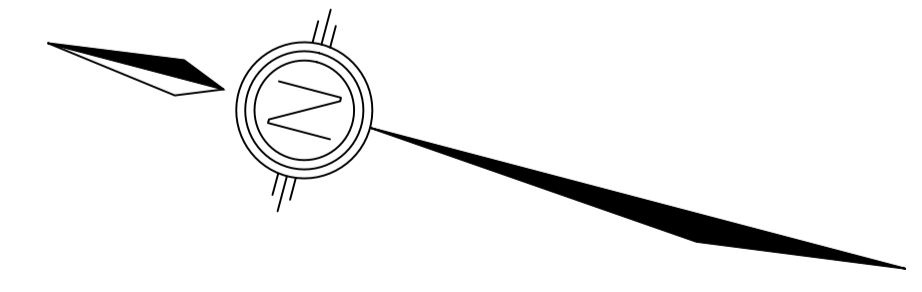


PROJECT SAMSONVALE ROAD		CLIENT PEET LIMITED	
LEVEL DATUM AHD	SCALE 1:300 @ A1	AS CONSTRUCTED POST CONSTRUCTION CONTOURS STAGES 2	
ORIGIN PM 108388 RL 19.893	Date: JULY 2020 Surveyed: RPS		
Comp. by: TJE	Parish: STRATHPINE		
FB : _____	LB : _____	DWG. 142823 Stage2POST	Local Authority MORETON BAY REGIONAL COUNCIL
		Job Ref 142823-2	Reference 142823-14

rps

RPS Australia East Pty Ltd
ACN 140 292 762
ABN 44 140 292 762
Level 4 HQ South, 520 Wickham St
PO Box 1559
Fortitude Valley QLD 4006
T +61 7 3539 9500
F +61 7 3237 8833
W rpsgroup.com.au

© COPYRIGHT PROTECTS THIS PLAN
Unauthorized reproduction or amendment
not permitted. Please contact the author.

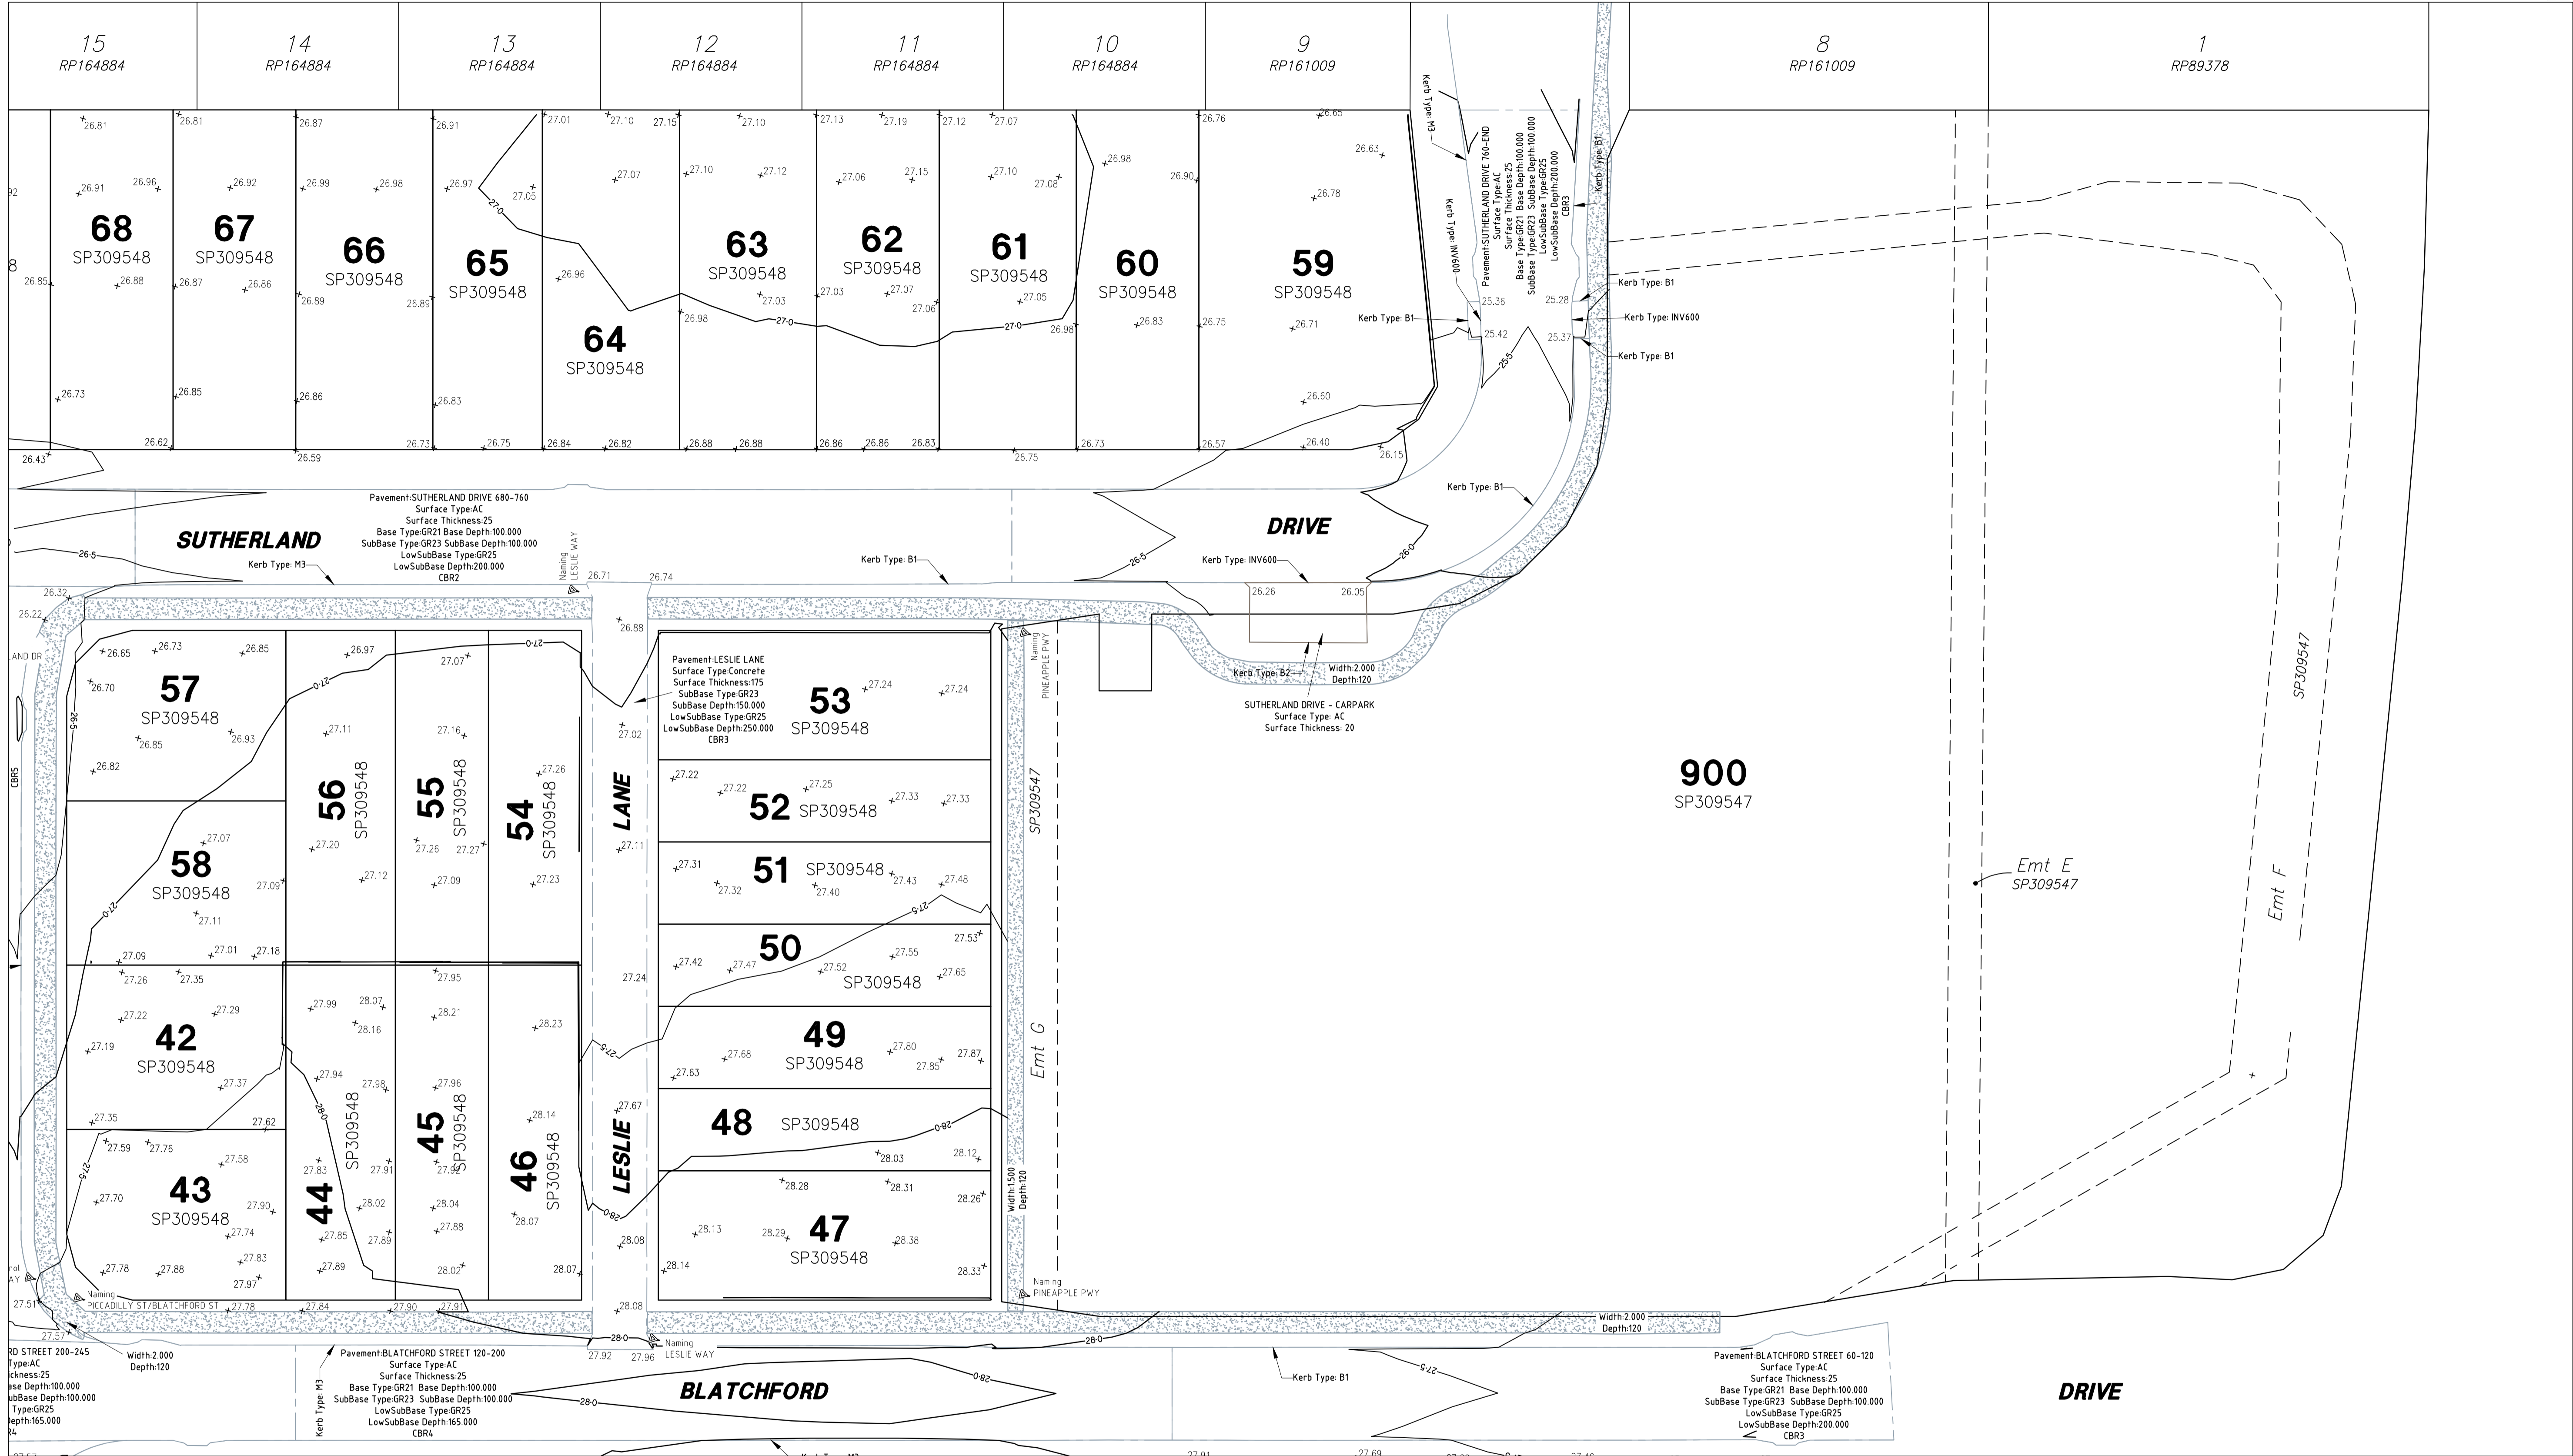

LEGEND

- ₅₆— Post Construction Contours
- - - - - Topographic Change In Grade
- + 35.53 Post Construction Surface Level
- [Pattern] Concrete Path or Driveway
- [Line] Kerb and Channel

"I, _____, being a certified / registered engineer and duly authorised representative of _____ hereby -


- × Certify the information contained in this drawing is an accurate "AS CONSTRUCTED" representation of the works.
- × Accept responsibility for the "AS CONSTRUCTED" information contained in this drawing.
- × Acknowledge the "AS CONSTRUCTED" information contained in the drawing may be relied on by Council and others.

Certification for Stage by on

for
 Registered Professional Engineer of Queensland - No. _____

We RPS Australia East Pty Ltd, Registered Surveyor – Land hereby certify that the Levels and Dimensions shown hereon are a correct record of our Survey which was performed in accordance with Council Accuracy Standards

Authorised Delegate _____ Date 02/07/2020

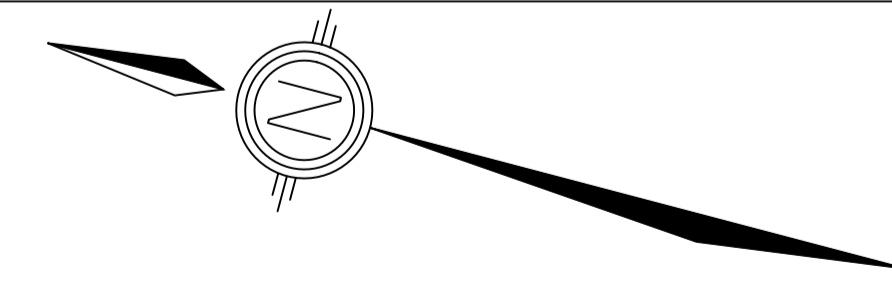


PROJECT SAMSONVALE ROAD		CLIENT PEET LIMITED	
LEVEL DATUM AHD	SCALE 1:300 @ A1	AS CONSTRUCTED POST CONSTRUCTION CONTOURS STAGES 2	
ORIGIN PM 108388 RL 19.893	Date: JULY 2020 Surveyed: RPS		
Comp. by: TJE	Parish: STRATHPINE	Job Ref: 142823-2	Reference: 142823-14
DWG: 142823 Stage2POST	Local Authority: MORETON BAY REGIONAL COUNCIL		Rev

RPS

RPS Australia East Pty Ltd
 ACN 140 292 762
 ABN 44 140 292 762
 Level 4 HQ South, 520 Wickham St
 PO Box 1559
 Fortitude Valley QLD 4006
 T +61 7 3539 9500
 F +61 7 3237 8833
 W rpsgroup.com.au

©COPYRIGHT PROTECTS THIS PLAN
 Unauthorised reproduction or amendment
 not permitted. Please contact the author.

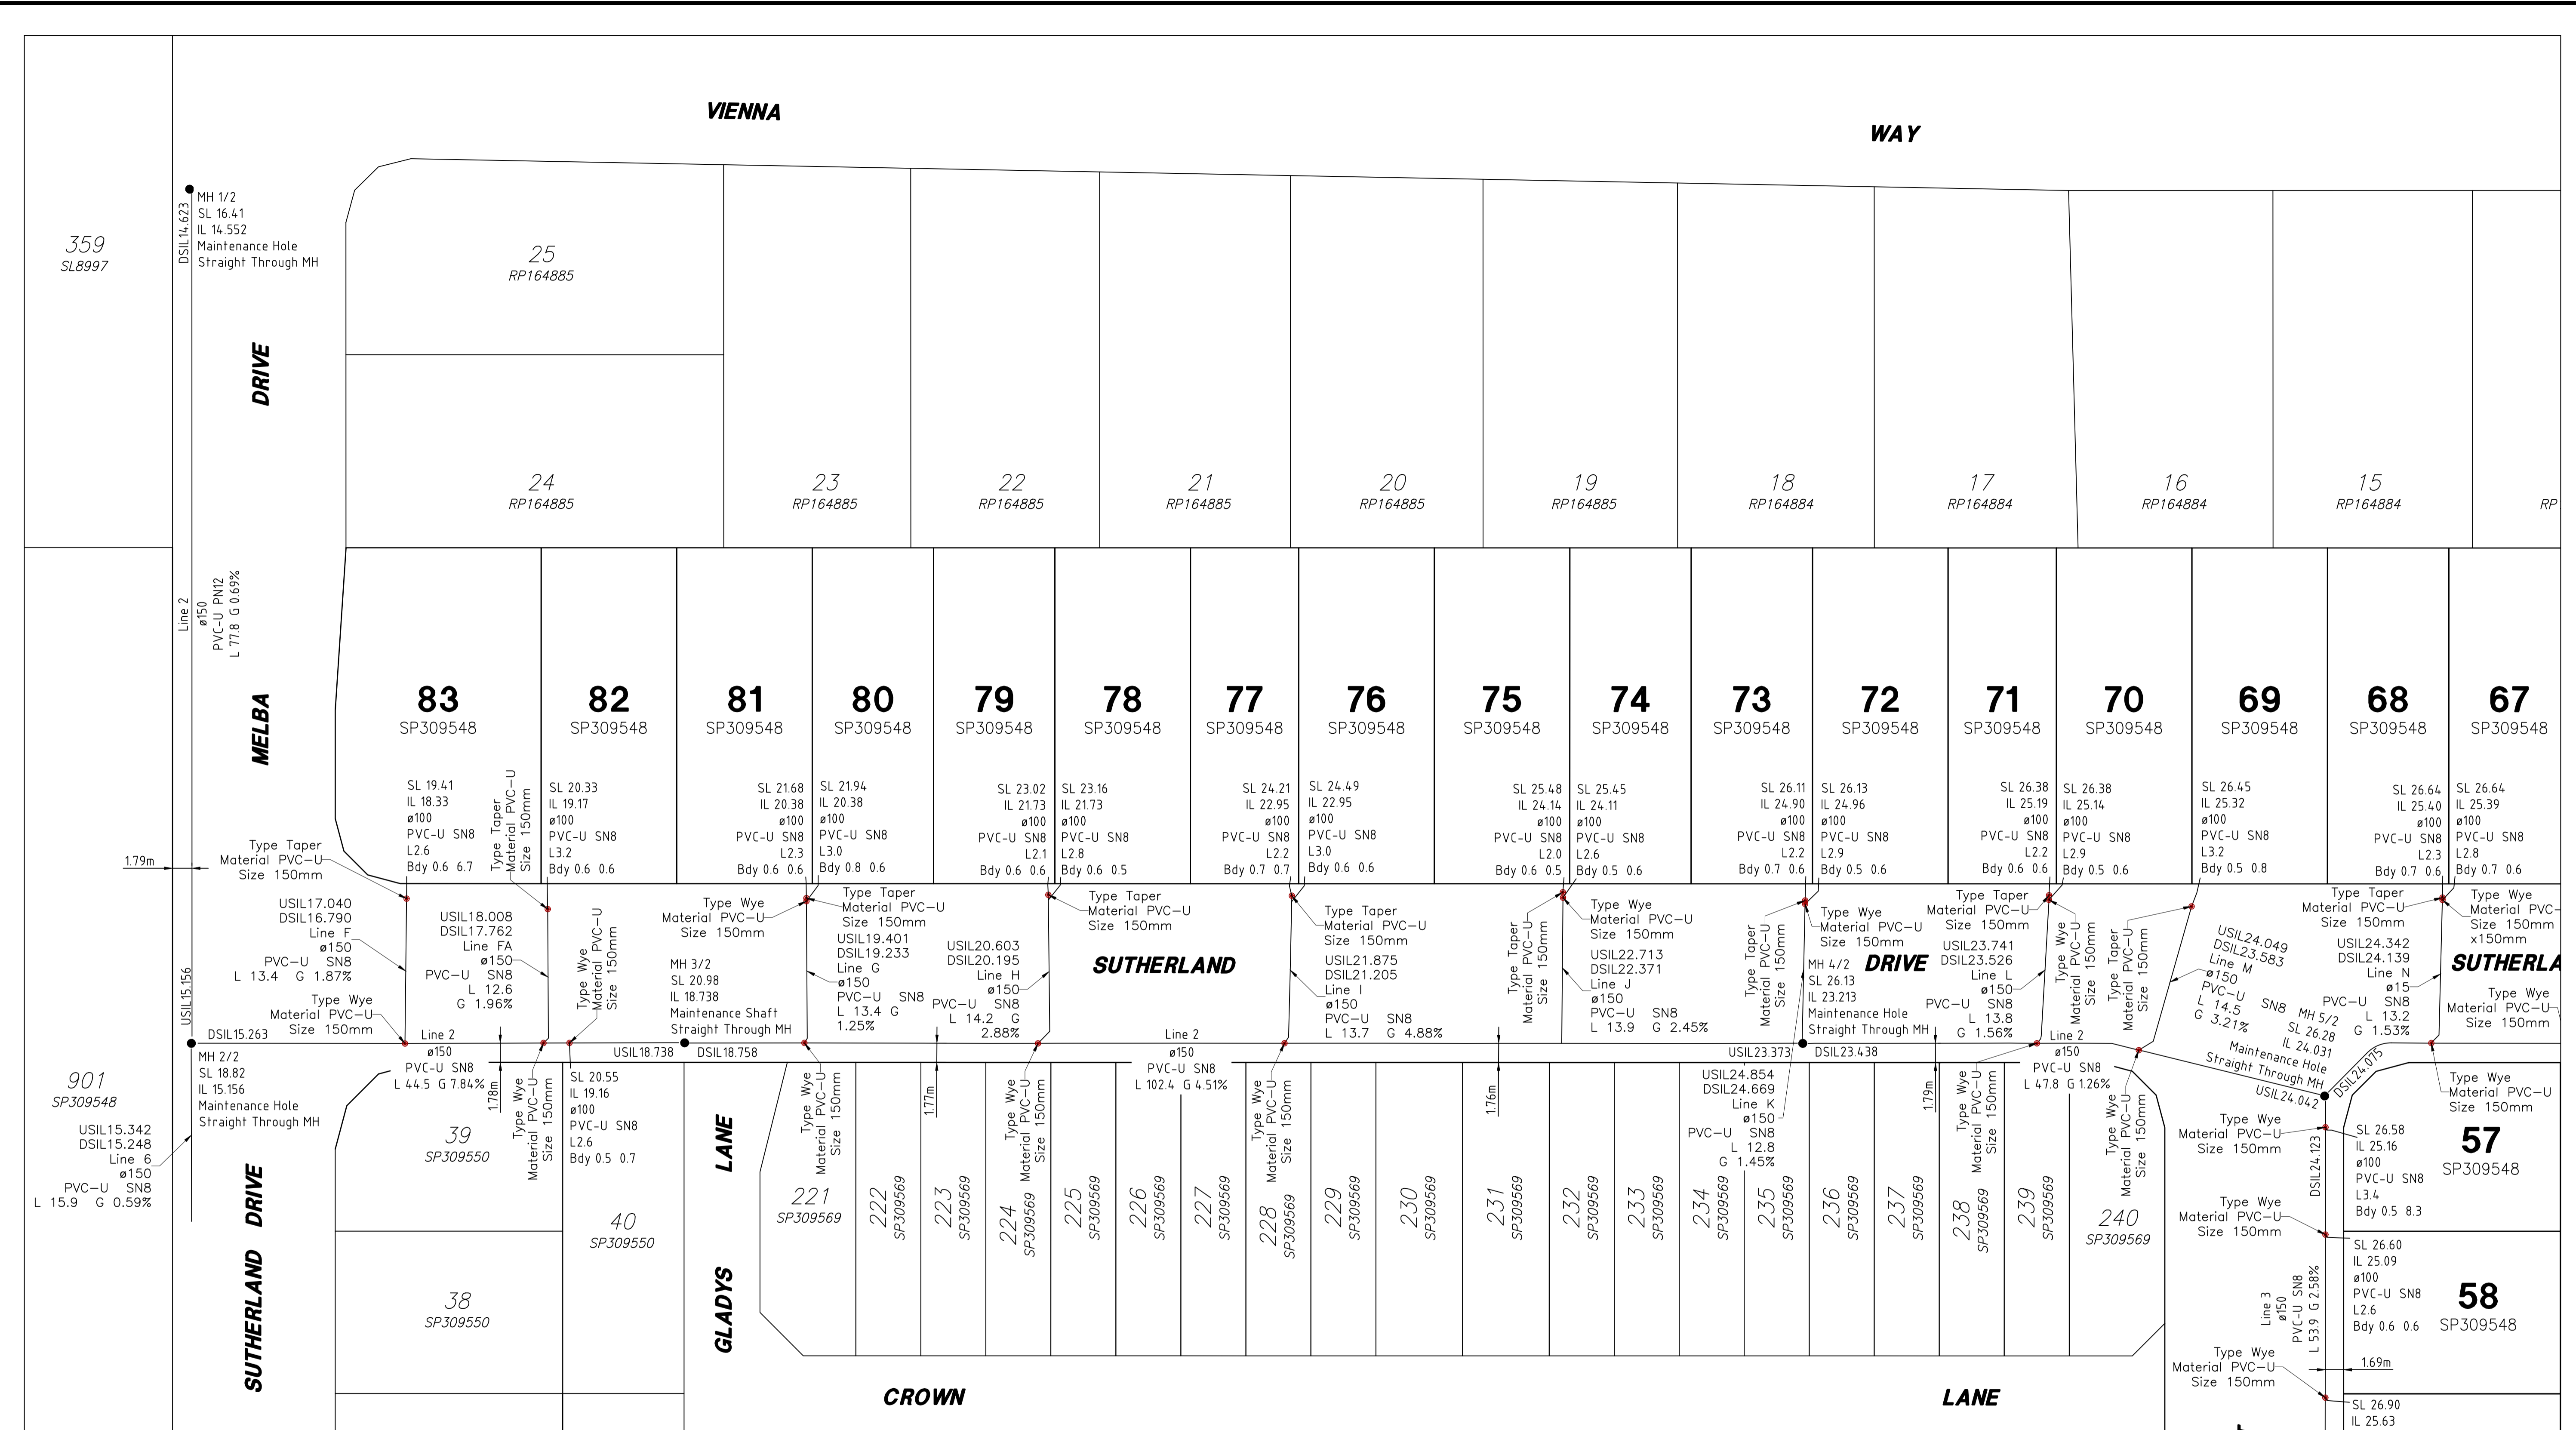

"I, _____ being a certified / registered engineer and duly authorised representative of hereby -

- × Certify the information contained in this drawing is an accurate "AS CONSTRUCTED" representation of the works.
- × Accept responsibility for the "AS CONSTRUCTED" information contained in this drawing.
- × Acknowledge the "AS CONSTRUCTED" information contained in the drawing may be relied on by Council and others.

We RPS Australia East Pty Ltd, Registered Surveyor - Land hereby certify that the Levels and Dimensions shown hereon are a correct record of our Survey which was performed in accordance with Council Accuracy Standards

Certification for Stage by on for Registered Professional Engineer of Queensland - No. _____

[Signature]
Authorised Delegate
Date 06/07/2020

SEWERAGE RETICULATION	
ESTATE/STAGE	STAGES 1 - 3
SITE ADDRESS	84 SAMSONVALE ROAD, STRATHPINE




A1	-	-	-	-	-	-	
	-	-	-	-	-	-	
	-	-	-	-	-	-	
	-	-	-	-	-	-	
	-	-	-	-	-	-	
INDEX	DATE	REVISIONS			DRAWN	CHECKED	PASSED

DRAWN	RPS	23/06/2020
CHECKED	RPS	23/06/2020
PASSED	-	-
INITIALS	DATE	

Unitywater
AS - CONSTRUCTED
SEWERAGE RETICULATION

SCALE	1:300 @ A1
SHEET	1 OF 3 SHEETS
DRAWING NO.	142823-10

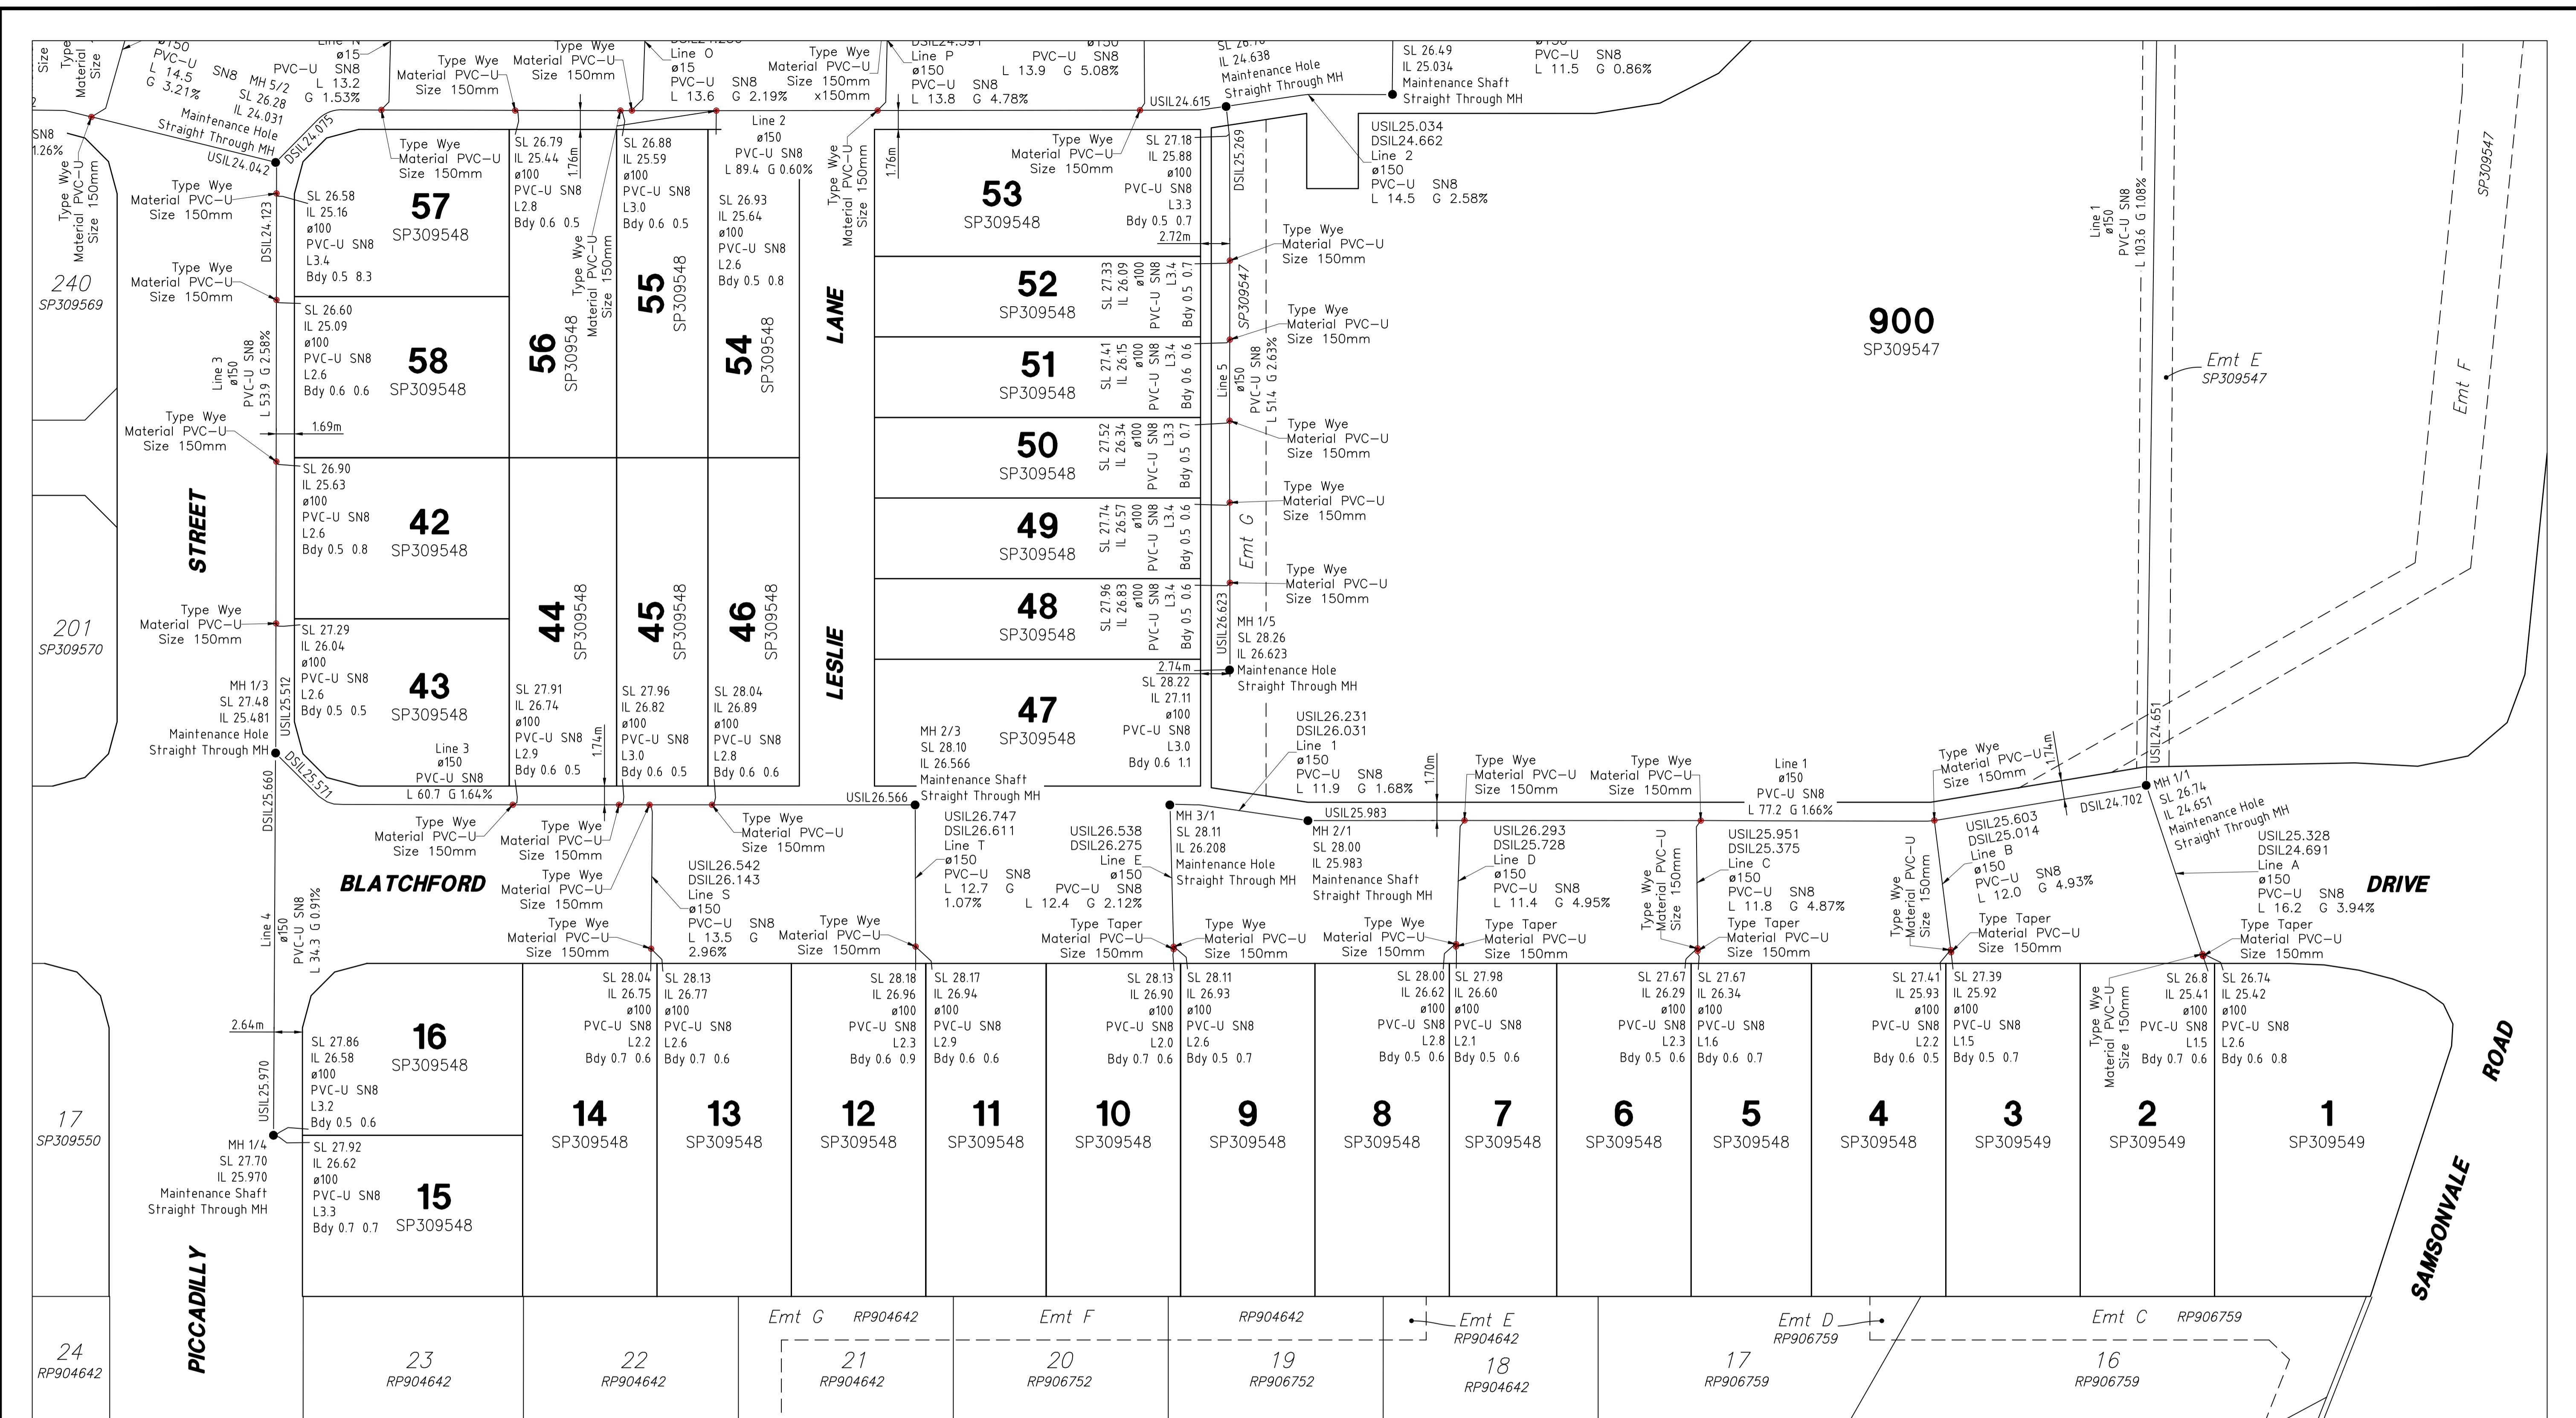

"I, _____ being a certified / registered engineer and duly authorised representative of hereby -

- × Certify the information contained in this drawing is an accurate "AS CONSTRUCTED" representation of the works.
- × Accept responsibility for the "AS CONSTRUCTED" information contained in this drawing.
- × Acknowledge the "AS CONSTRUCTED" information contained in the drawing may be relied on by Council and others.

Certification for Stage _____ by _____ on _____ for Registered Professional Engineer of Queensland - No. _____

We RPS Australia East Pty Ltd, Registered Surveyor - Land hereby certify that the Levels and Dimensions shown hereon are a correct record of our Survey which was performed in accordance with Council Accuracy Standards

[Signature]
 Authorised Delegate
 06/07/2020
 Date

SEWERAGE RETICULATION	
ESTATE/STAGE	STAGES 1 - 3
SITE ADDRESS	84 SAMSONVALE ROAD, STRATHPINE



A1	-	-	-	-	-	-	
	-	-	-	-	-	-	
	-	-	-	-	-	-	
	-	-	-	-	-	-	
	-	-	-	-	-	-	
INDEX	DATE	REVISIONS			DRAWN	CHECKED	PASSED

DRAWN	RPS	23/06/2020
CHECKED	RPS	23/06/2020
PASSED	-	-
INITIALS	-	-
DATE	-	-


RPS Australia Asia Pacific
 Level 4 HQ South
 520 Wickham St
 Fortitude Valley
 QLD 4006
 T +61 7 3539 9500
 W rpsgroup.com

Unitywater

Unitywater

AS - CONSTRUCTED
SEWERAGE RETICULATION

SCALE	1:300 @ A1
SHEET	2 OF 3 SHEETS
DRAWING NO.	142823-10

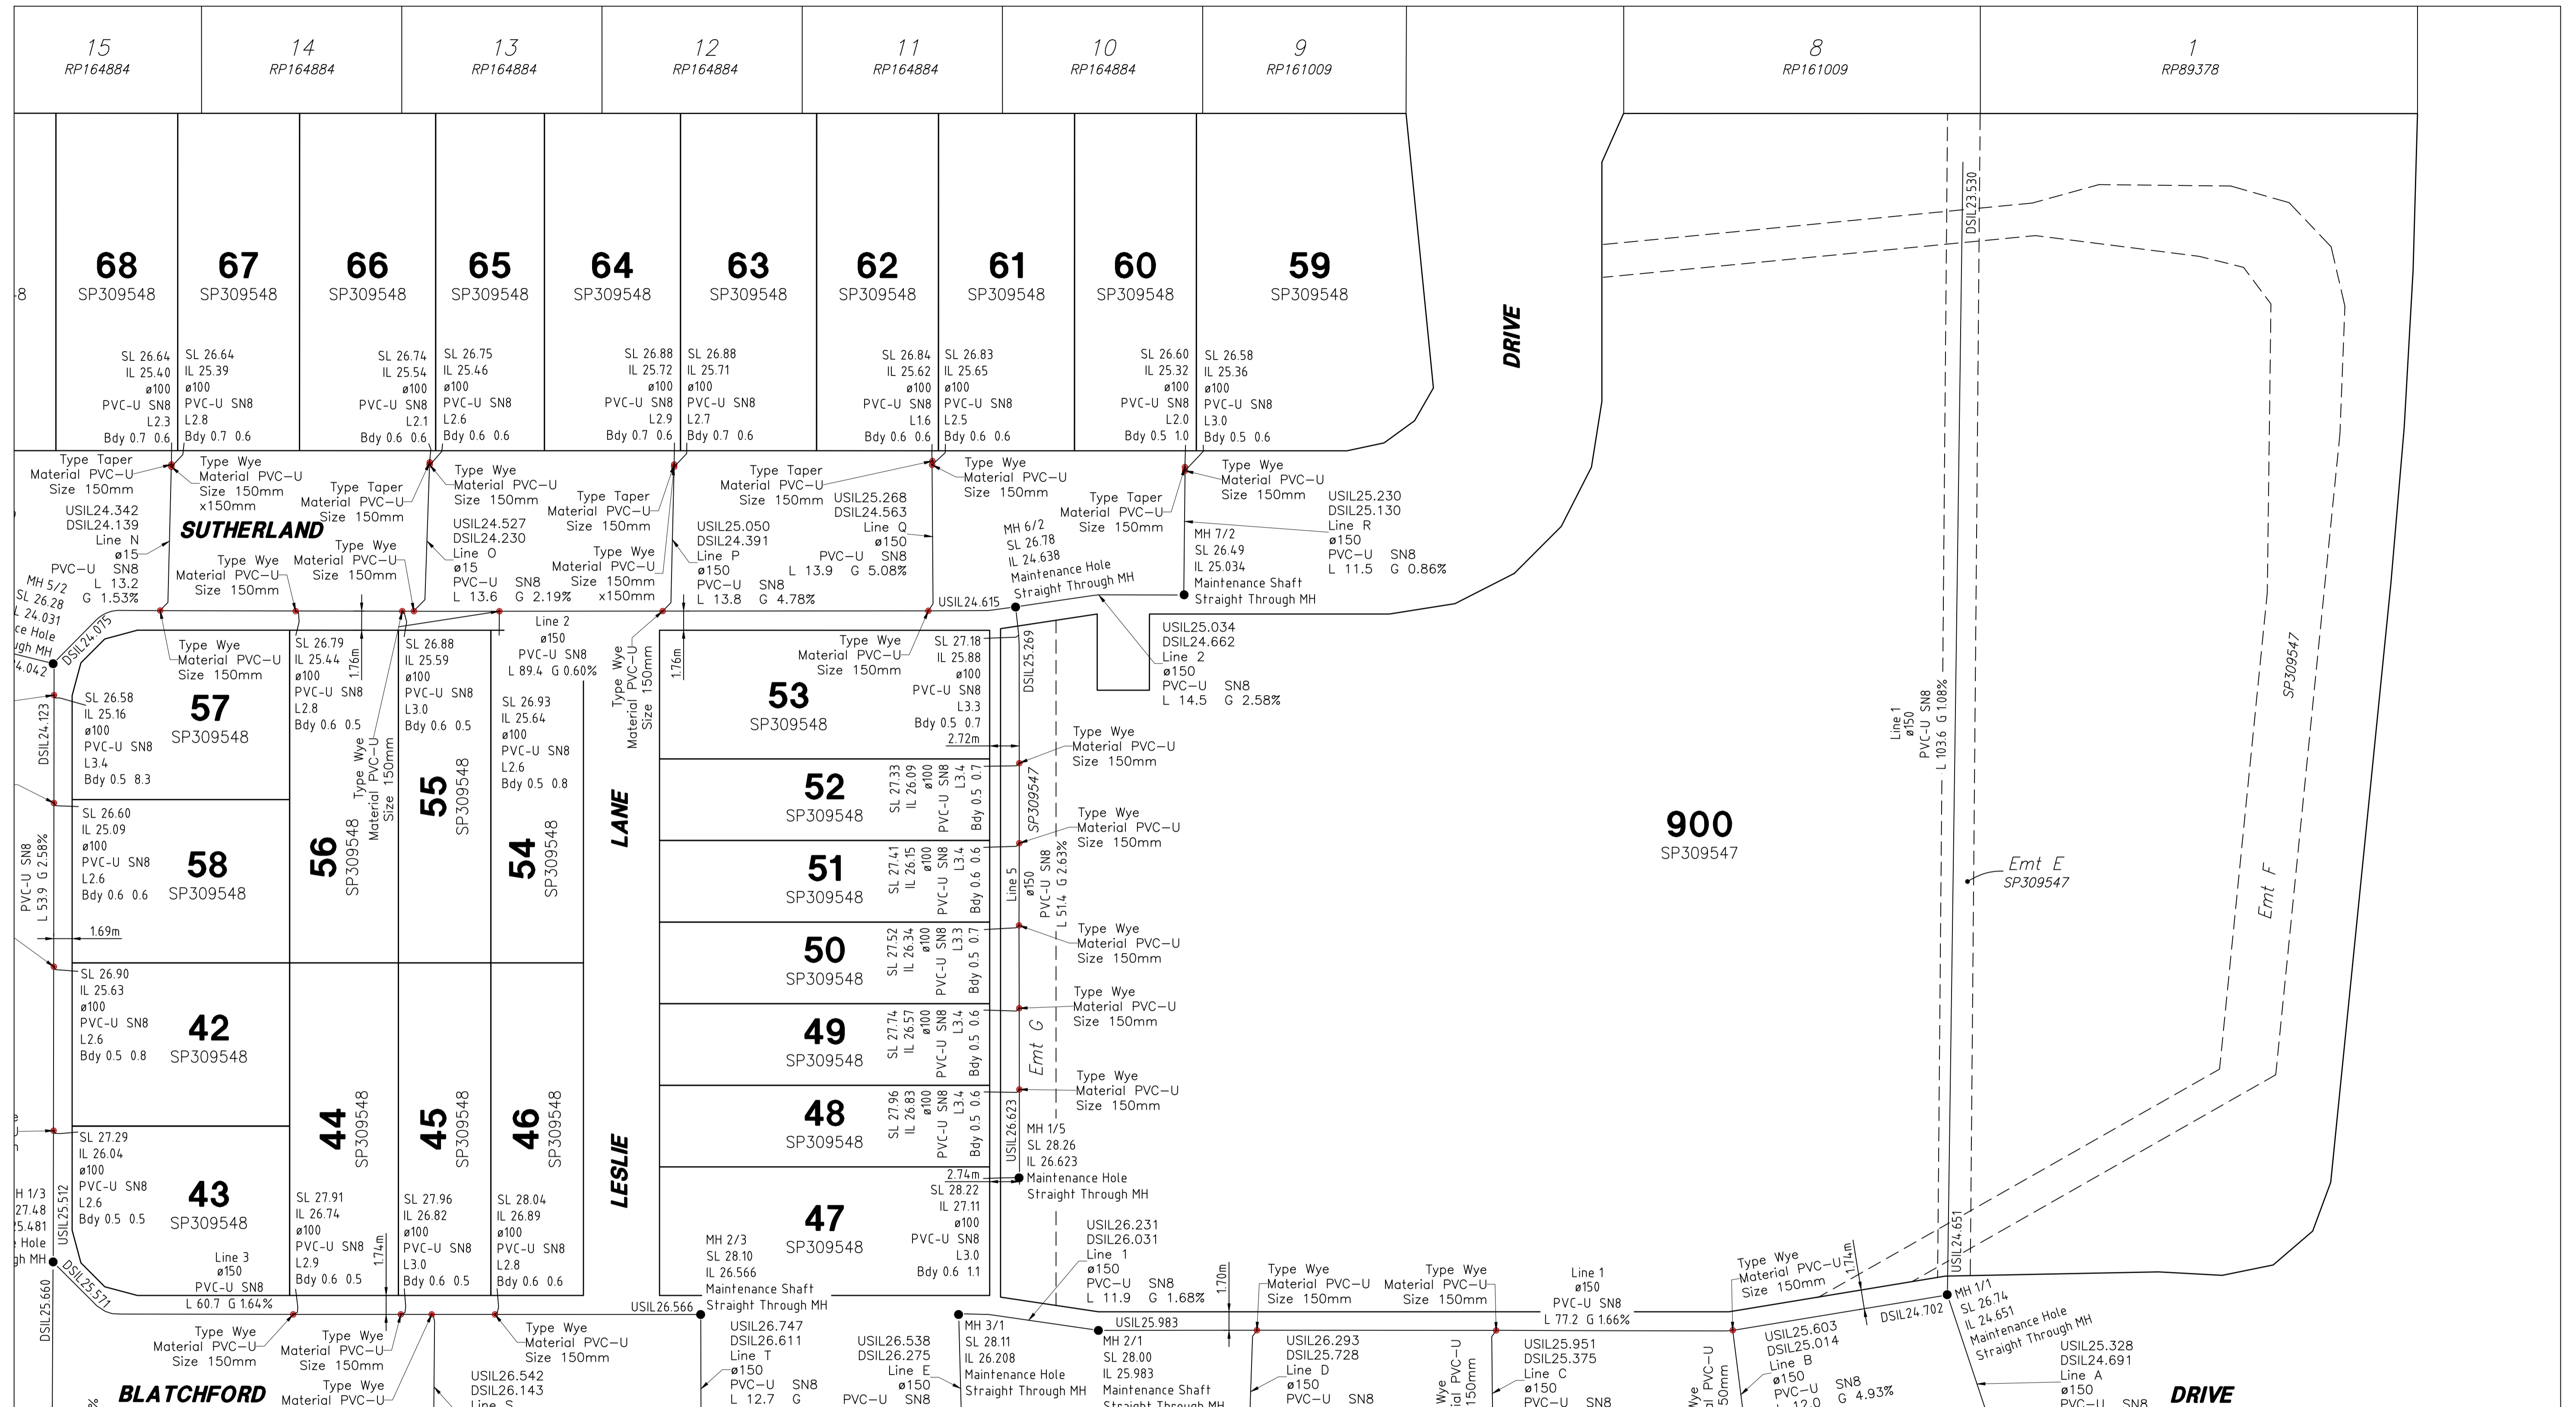

"I, _____ being a certified / registered engineer and duly authorised representative of _____ hereby -


- × Certify the information contained in this drawing is an accurate "AS CONSTRUCTED" representation of the works.
- × Accept responsibility for the "AS CONSTRUCTED" information contained in this drawing.
- × Acknowledge the "AS CONSTRUCTED" information contained in the drawing may be relied on by Council and others.

Certification for Stage _____ by _____ on _____ for _____
 Registered Professional Engineer of Queensland - No. _____

We RPS Australia East Pty Ltd, Registered Surveyor - Land hereby certify that the Levels and Dimensions shown hereon are a correct record of our Survey which was performed in accordance with Council Accuracy Standards

[Signature]
 Authorised Delegate
 06/07/2020
 Date

SEWERAGE RETICULATION	
ESTATE/STAGE	STAGES 1 - 3
SITE ADDRESS	84 SAMSONVALE ROAD, STRATHPINE

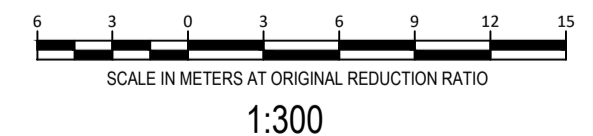

A1	-	-	-	-	-	-	
	-	-	-	-	-	-	
	-	-	-	-	-	-	
	-	-	-	-	-	-	
	-	-	-	-	-	-	
INDEX	DATE	REVISIONS			DRAWN	CHECKED	PASSED

DRAWN	RPS	23/06/2020
CHECKED	RPS	23/06/2020
PASSED	-	-
INITIALS	DATE	


RPS Australia Asia Pacific
 Level 4 HQ South
 520 Wickham St
 Fortitude Valley
 QLD 4006
 T +61 7 3539 9500
 W rpsgroup.com



Unitywater

AS - CONSTRUCTED
 SEWERAGE RETICULATION

SCALE	1:300 @ A1
SHEET	3 OF 3 SHEETS
DRAWING NO.	142823-10

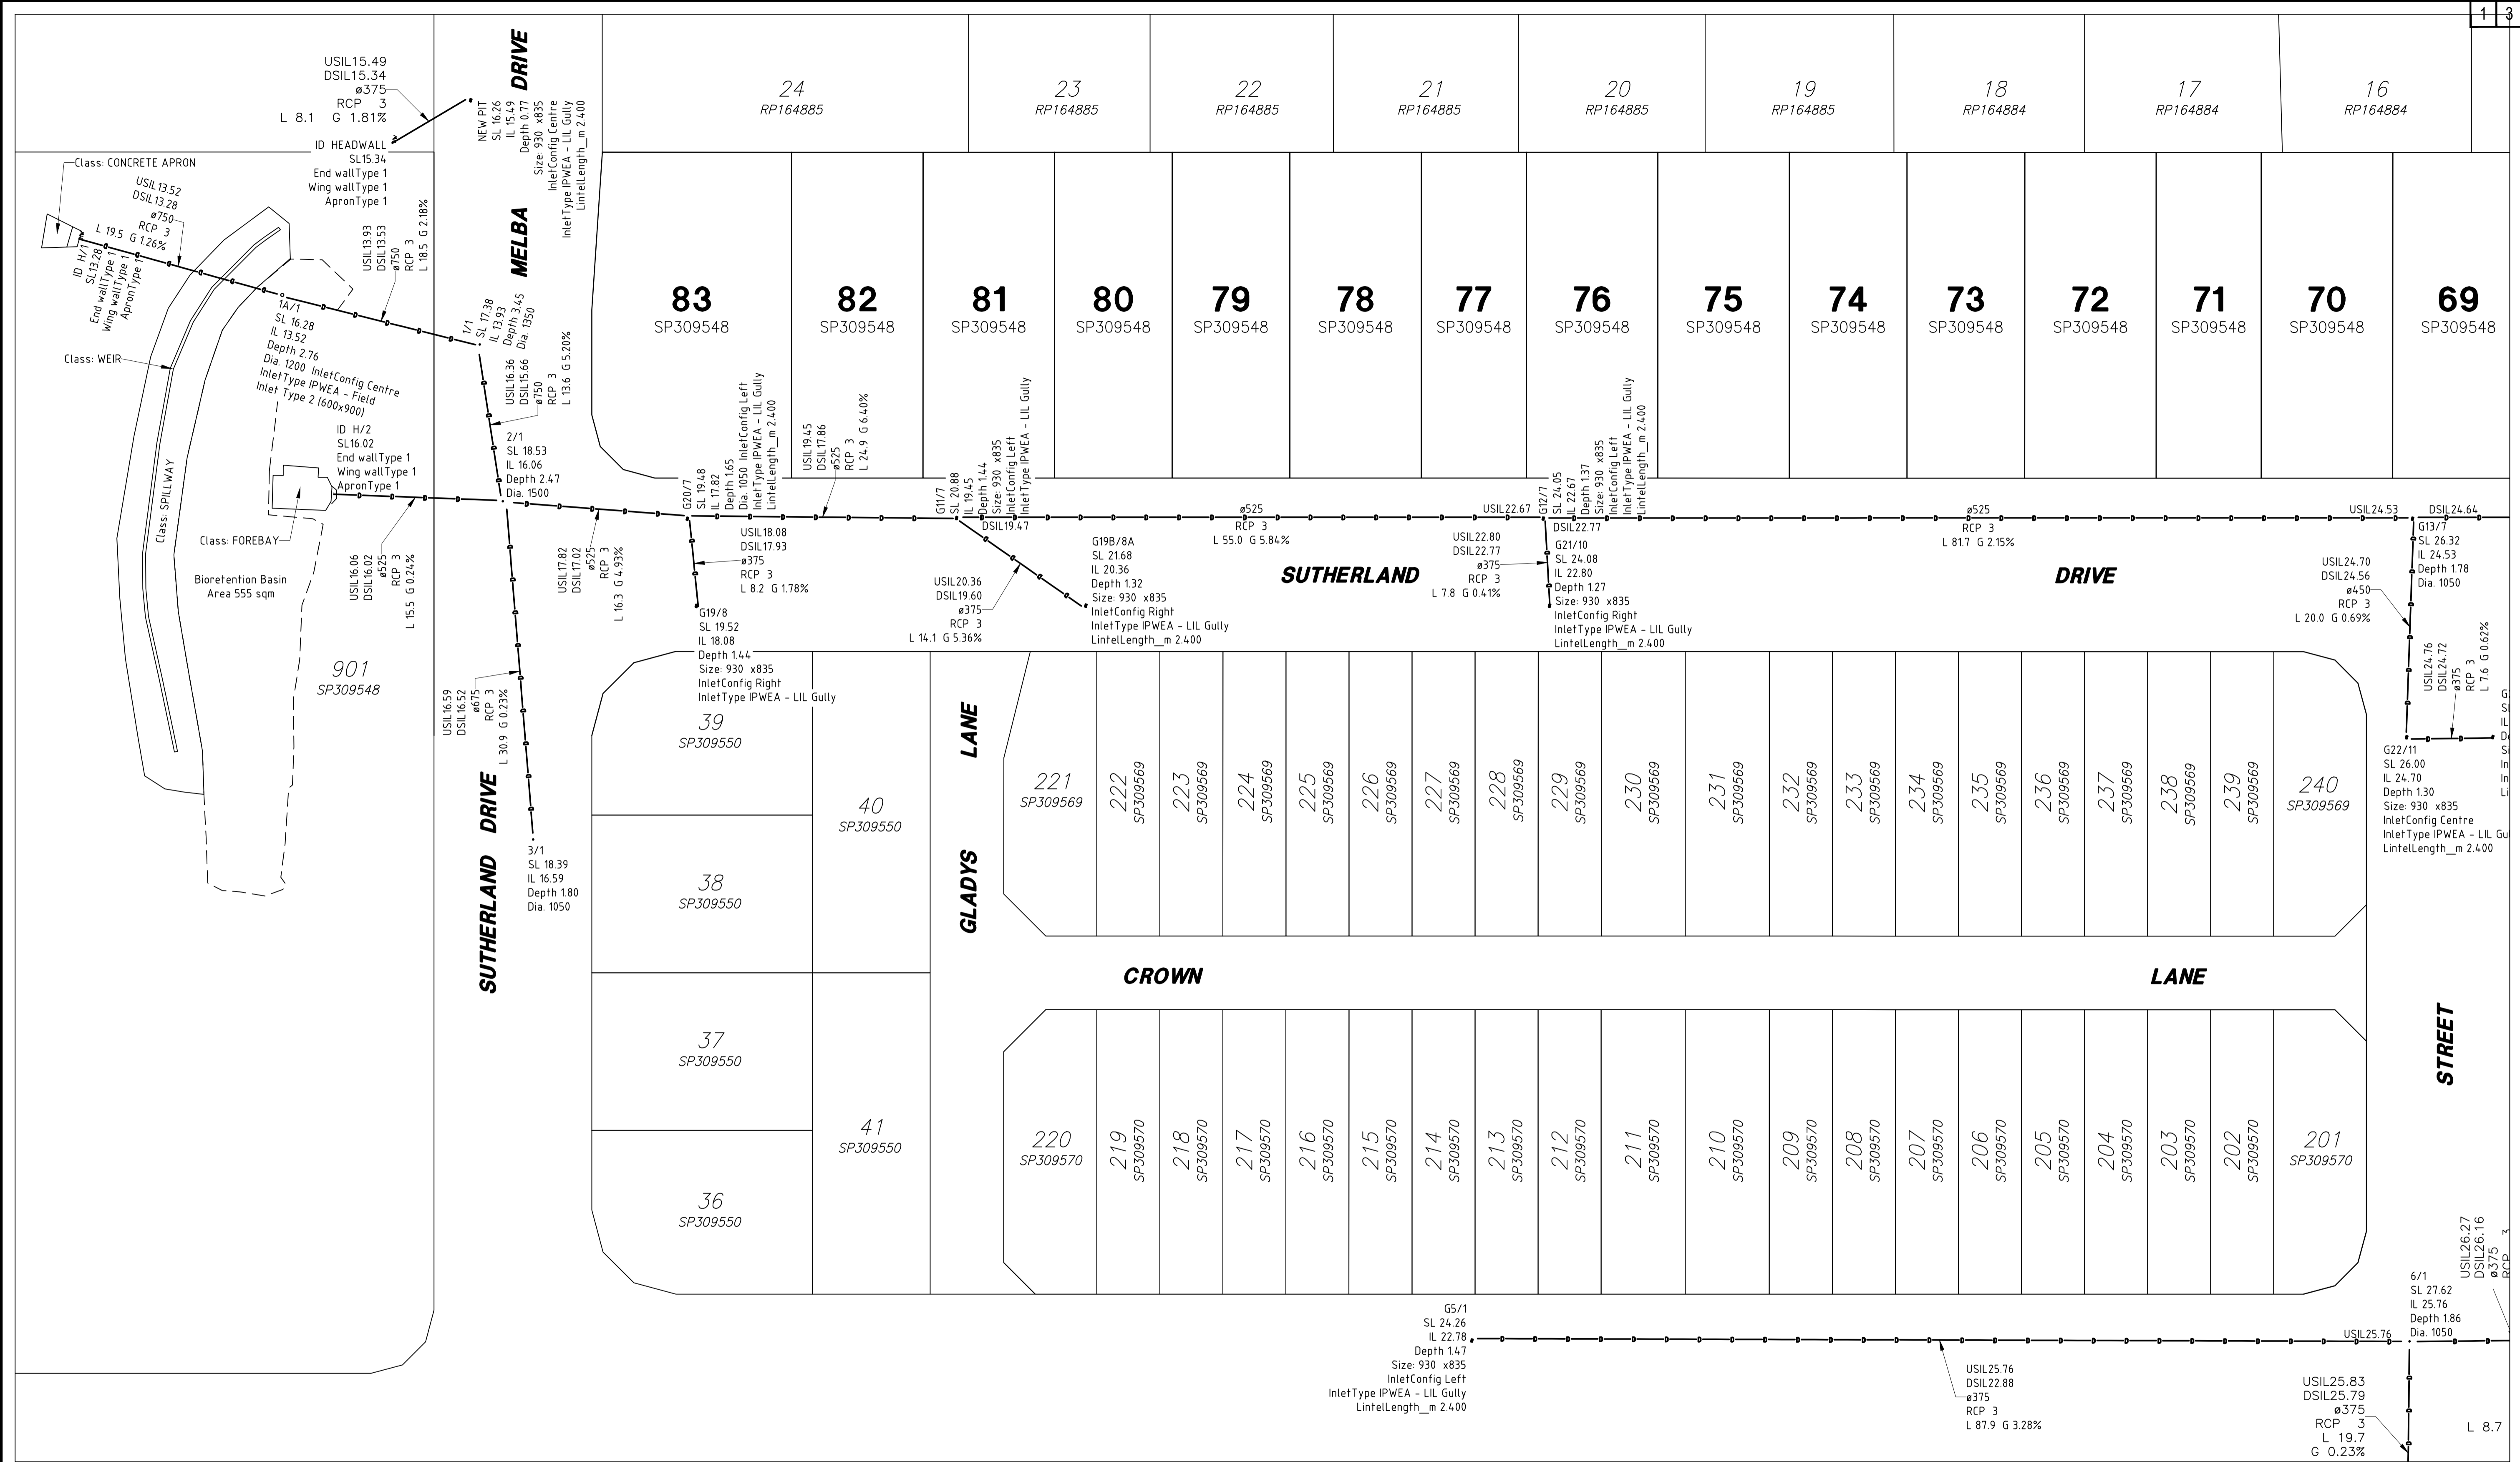

"I, _____ being a certified / registered engineer and duly authorised representative of _____ hereby -

× Certify the information contained in this drawing is an accurate "AS CONSTRUCTED" representation of the works.

× Accept responsibility for the "AS CONSTRUCTED" information contained in this drawing.



× Acknowledge the "AS CONSTRUCTED" information contained in the drawing may be relied on by Council and others.

Certification for Stage _____ by _____ on _____

for _____ Registered Professional Engineer of Queensland - No. _____

We RPS Australia East Pty Ltd, Registered Surveyor - Land hereby certify that the Levels and Dimensions shown hereon are a correct record of our Survey which was performed in accordance with Council Accuracy Standards


_____ 02/07/2020 _____
 Authorised Delegate Date

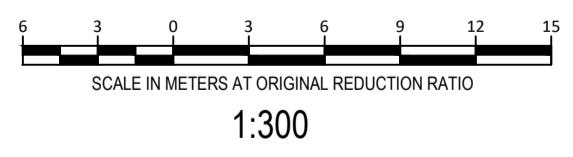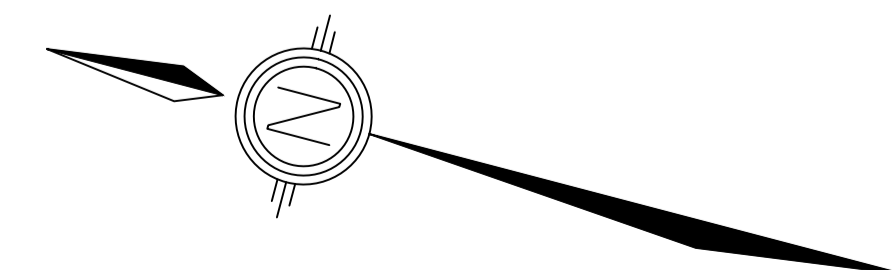

PROJECT SAMSONVALE ROAD		CLIENT PEET LIMITED	
LEVEL DATUM AHD	SCALE 1:300 @ A1	AS CONSTRUCTED STORMWATER DRAINAGE STAGES 1 - 3	
ORIGIN PM 108388 RL 19.893	Date: JULY 2020 Surveyed: RPS		
Comp. by: TJE	Parish: STRATHPINE		
FB :	LB :	DWG. 142823 Stage2STORM	Local Authority MORETON BAY REGIONAL COUNCIL
		Job Ref 142823-2	Reference 142823-12
			Rev

RPS Australia East Pty Ltd
 ACN 140 292 762
 ABN 44 140 292 762
 Level 4 HQ South, 520 Wickham St
 PO Box 1559
 Fortitude Valley QLD 4006
 T +61 7 3539 9500
 F +61 7 3237 8833
 W rpsgroup.com.au

©COPYRIGHT PROTECTS THIS PLAN
 Unauthorised reproduction or amendment
 not permitted. Please contact the author.

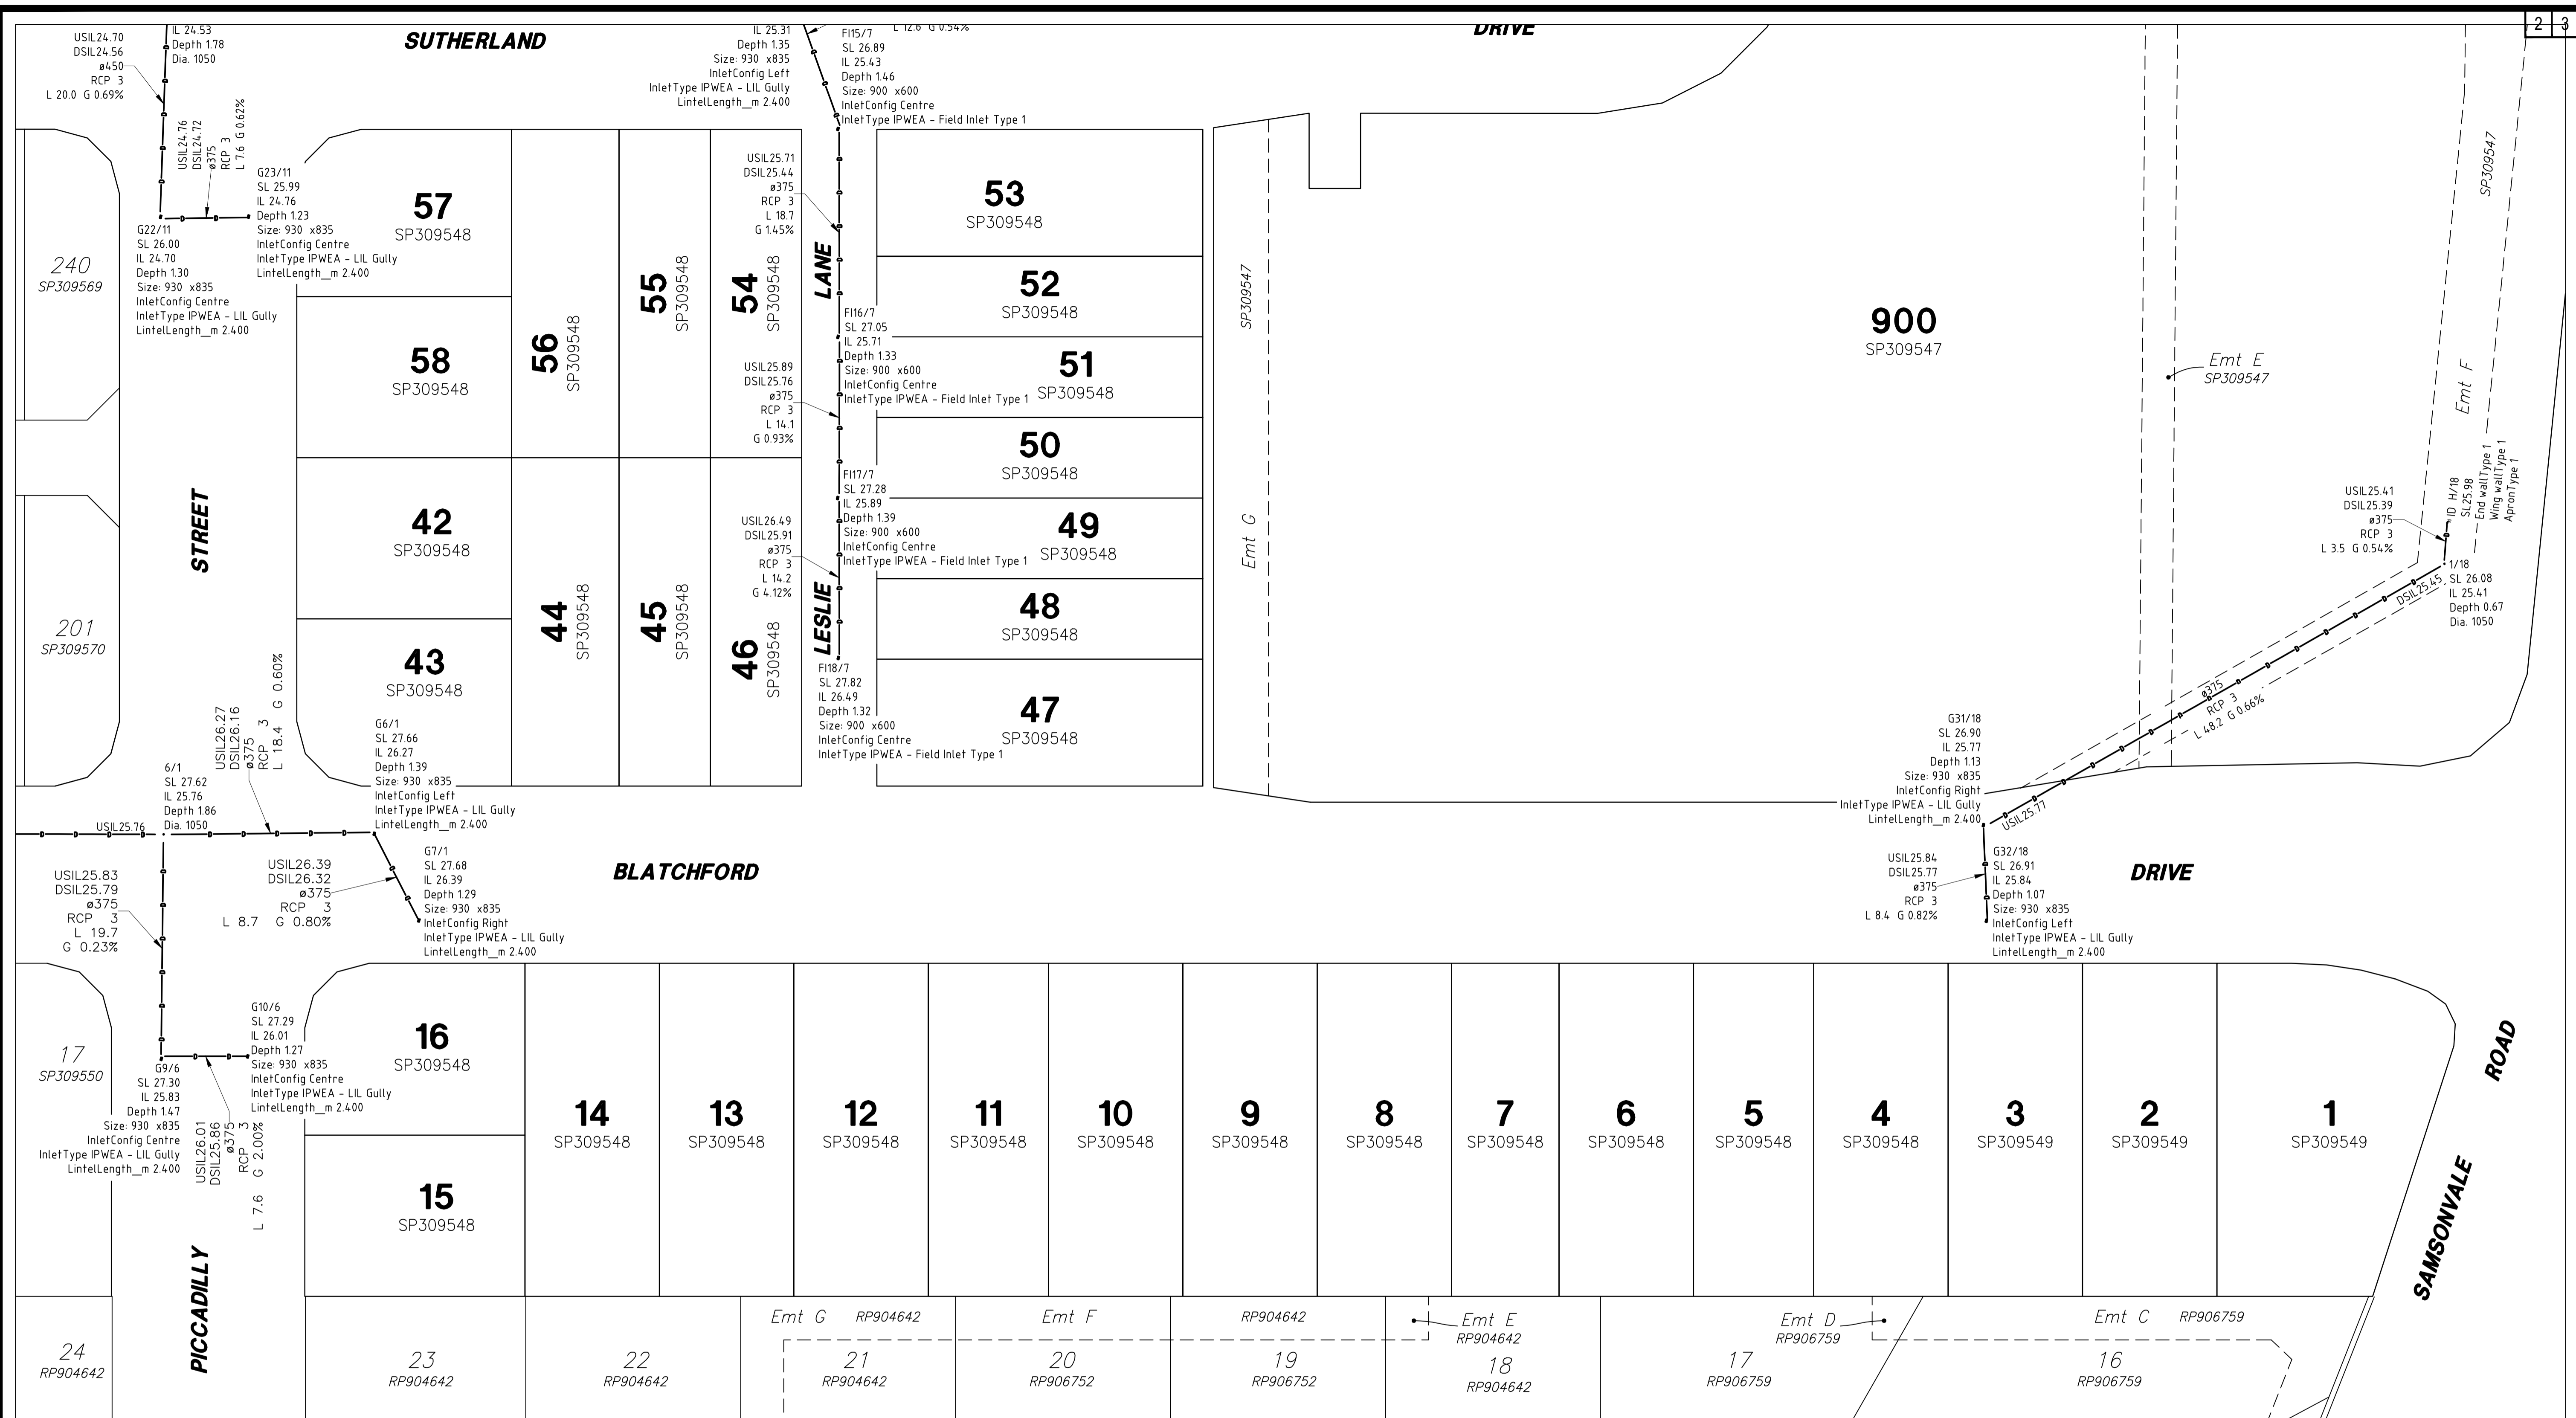


"I, _____, being a certified / registered engineer and duly authorised representative of hereby -

- × Certify the information contained in this drawing is an accurate "AS CONSTRUCTED" representation of the works.
- × Accept responsibility for the "AS CONSTRUCTED" information contained in this drawing.
- × Acknowledge the "AS CONSTRUCTED" information contained in the drawing may be relied on by Council and others.

Certification for Stage by on
 for
 Registered Professional Engineer of Queensland - No.

We RPS Australia East Pty Ltd, Registered Surveyor - Land hereby certify that the Levels and Dimensions shown hereon are a correct record of our Survey which was performed in accordance with Council Accuracy Standards


Authorised Delegate Date 02/07/2020

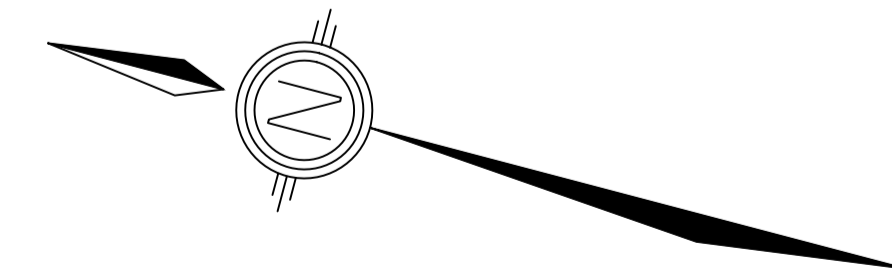

PROJECT SAMSONVALE ROAD		CLIENT PEET LIMITED	
LEVEL DATUM AHD	SCALE 1:300 @ A1	AS CONSTRUCTED STORMWATER DRAINAGE STAGES 1 - 3	
ORIGIN PM 108388 RL 19.893	Date: JULY 2020		
FB : LB :	Surveyed: RPS		
Comp. by: TJE		Parish: STRATHPINE	Job Ref: 142823-2
DWG: 142823 Stage2STORM		Local Authority: MORETON BAY REGIONAL COUNCIL	

RPS Australia East Pty Ltd
 ACN 140 292 762
 ABN 44 140 292 762
 Level 4 HQ South, 520 Wickham St
 PO Box 1559
 Fortitude Valley QLD 4006
 T +61 7 3539 9500
 F +61 7 3237 8833
 W rpsgroup.com.au

Reference 142823-12	Rev
-------------------------------	-----

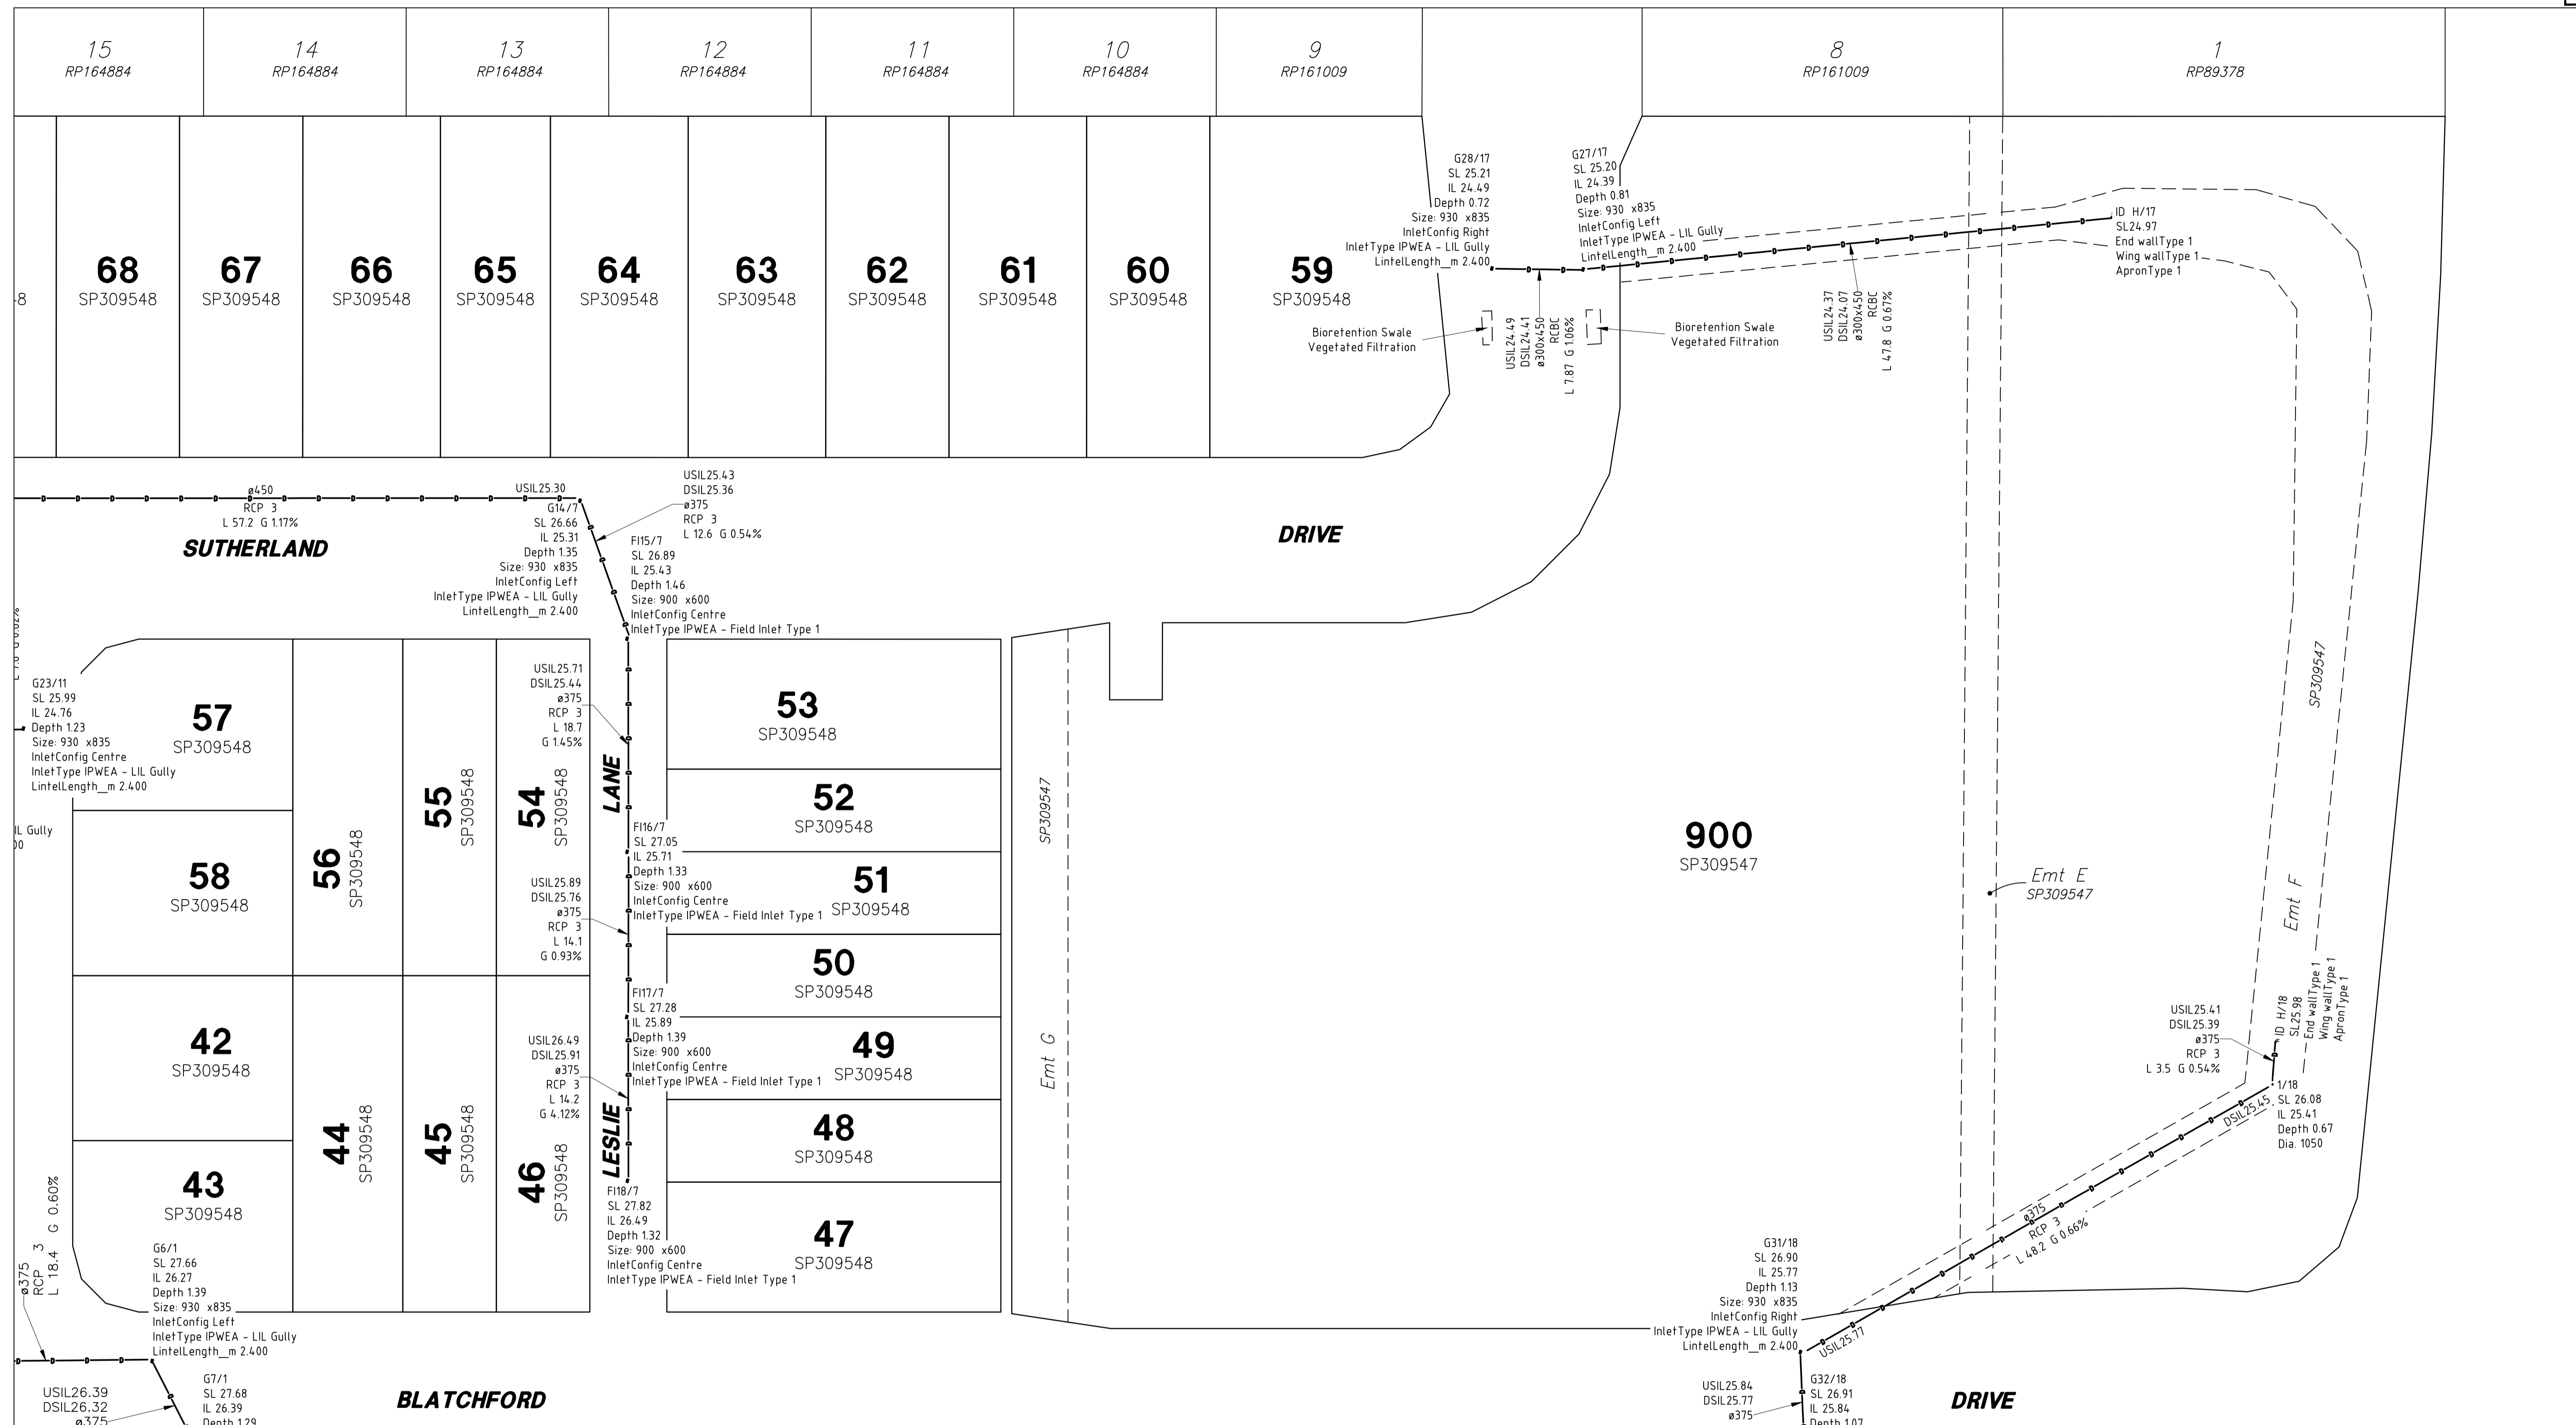


"I, _____, being a certified / registered engineer and duly authorised representative of _____ hereby -

- × Certify the information contained in this drawing is an accurate "AS CONSTRUCTED" representation of the works.
- × Accept responsibility for the "AS CONSTRUCTED" information contained in this drawing.
- × Acknowledge the "AS CONSTRUCTED" information contained in the drawing may be relied on by Council and others.

Certification for Stage _____ by _____ on _____
 for _____
 Registered Professional Engineer of Queensland - No. _____

We RPS Australia East Pty Ltd, Registered Surveyor - Land hereby certify that the Levels and Dimensions shown hereon are a correct record of our Survey which was performed in accordance with Council Accuracy Standards


Authorised Delegate _____ Date 02/07/2020

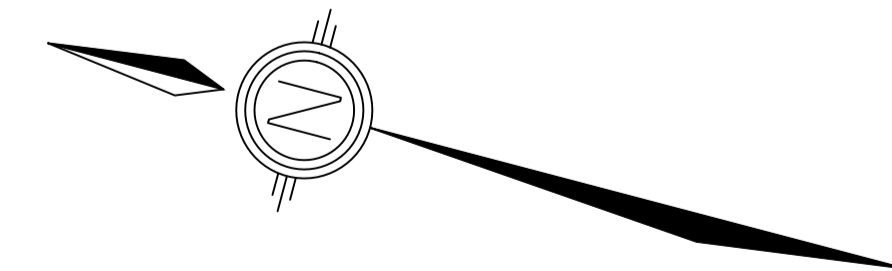

PROJECT SAMSONVALE ROAD		CLIENT PEET LIMITED	
LEVEL DATUM AHD	SCALE 1:300 @ A1	AS CONSTRUCTED STORMWATER DRAINAGE STAGES 1 - 3	
ORIGIN PM 108388 RL 19.893	Date: JULY 2020 Surveyed: RPS		
FB :	LB :	Comp by: TJE	Parish: STRATHPINE
DWG: 142823 Stage2STORM		Local Authority: MORETON BAY REGIONAL COUNCIL	Job Ref: 142823-2
Reference 142823-12		Rev	

RPS Australia East Pty Ltd
 ACN 140 292 762
 ABN 44 140 292 762
 Level 4 HQ South, 520 Wickham St
 PO Box 1559
 Fortitude Valley QLD 4006
 T +61 7 3539 9500
 F +61 7 3237 8833
 W rpsgroup.com.au

© COPYRIGHT PROTECTS THIS PLAN
 Unauthorised reproduction or amendment
 not permitted. Please contact the author.

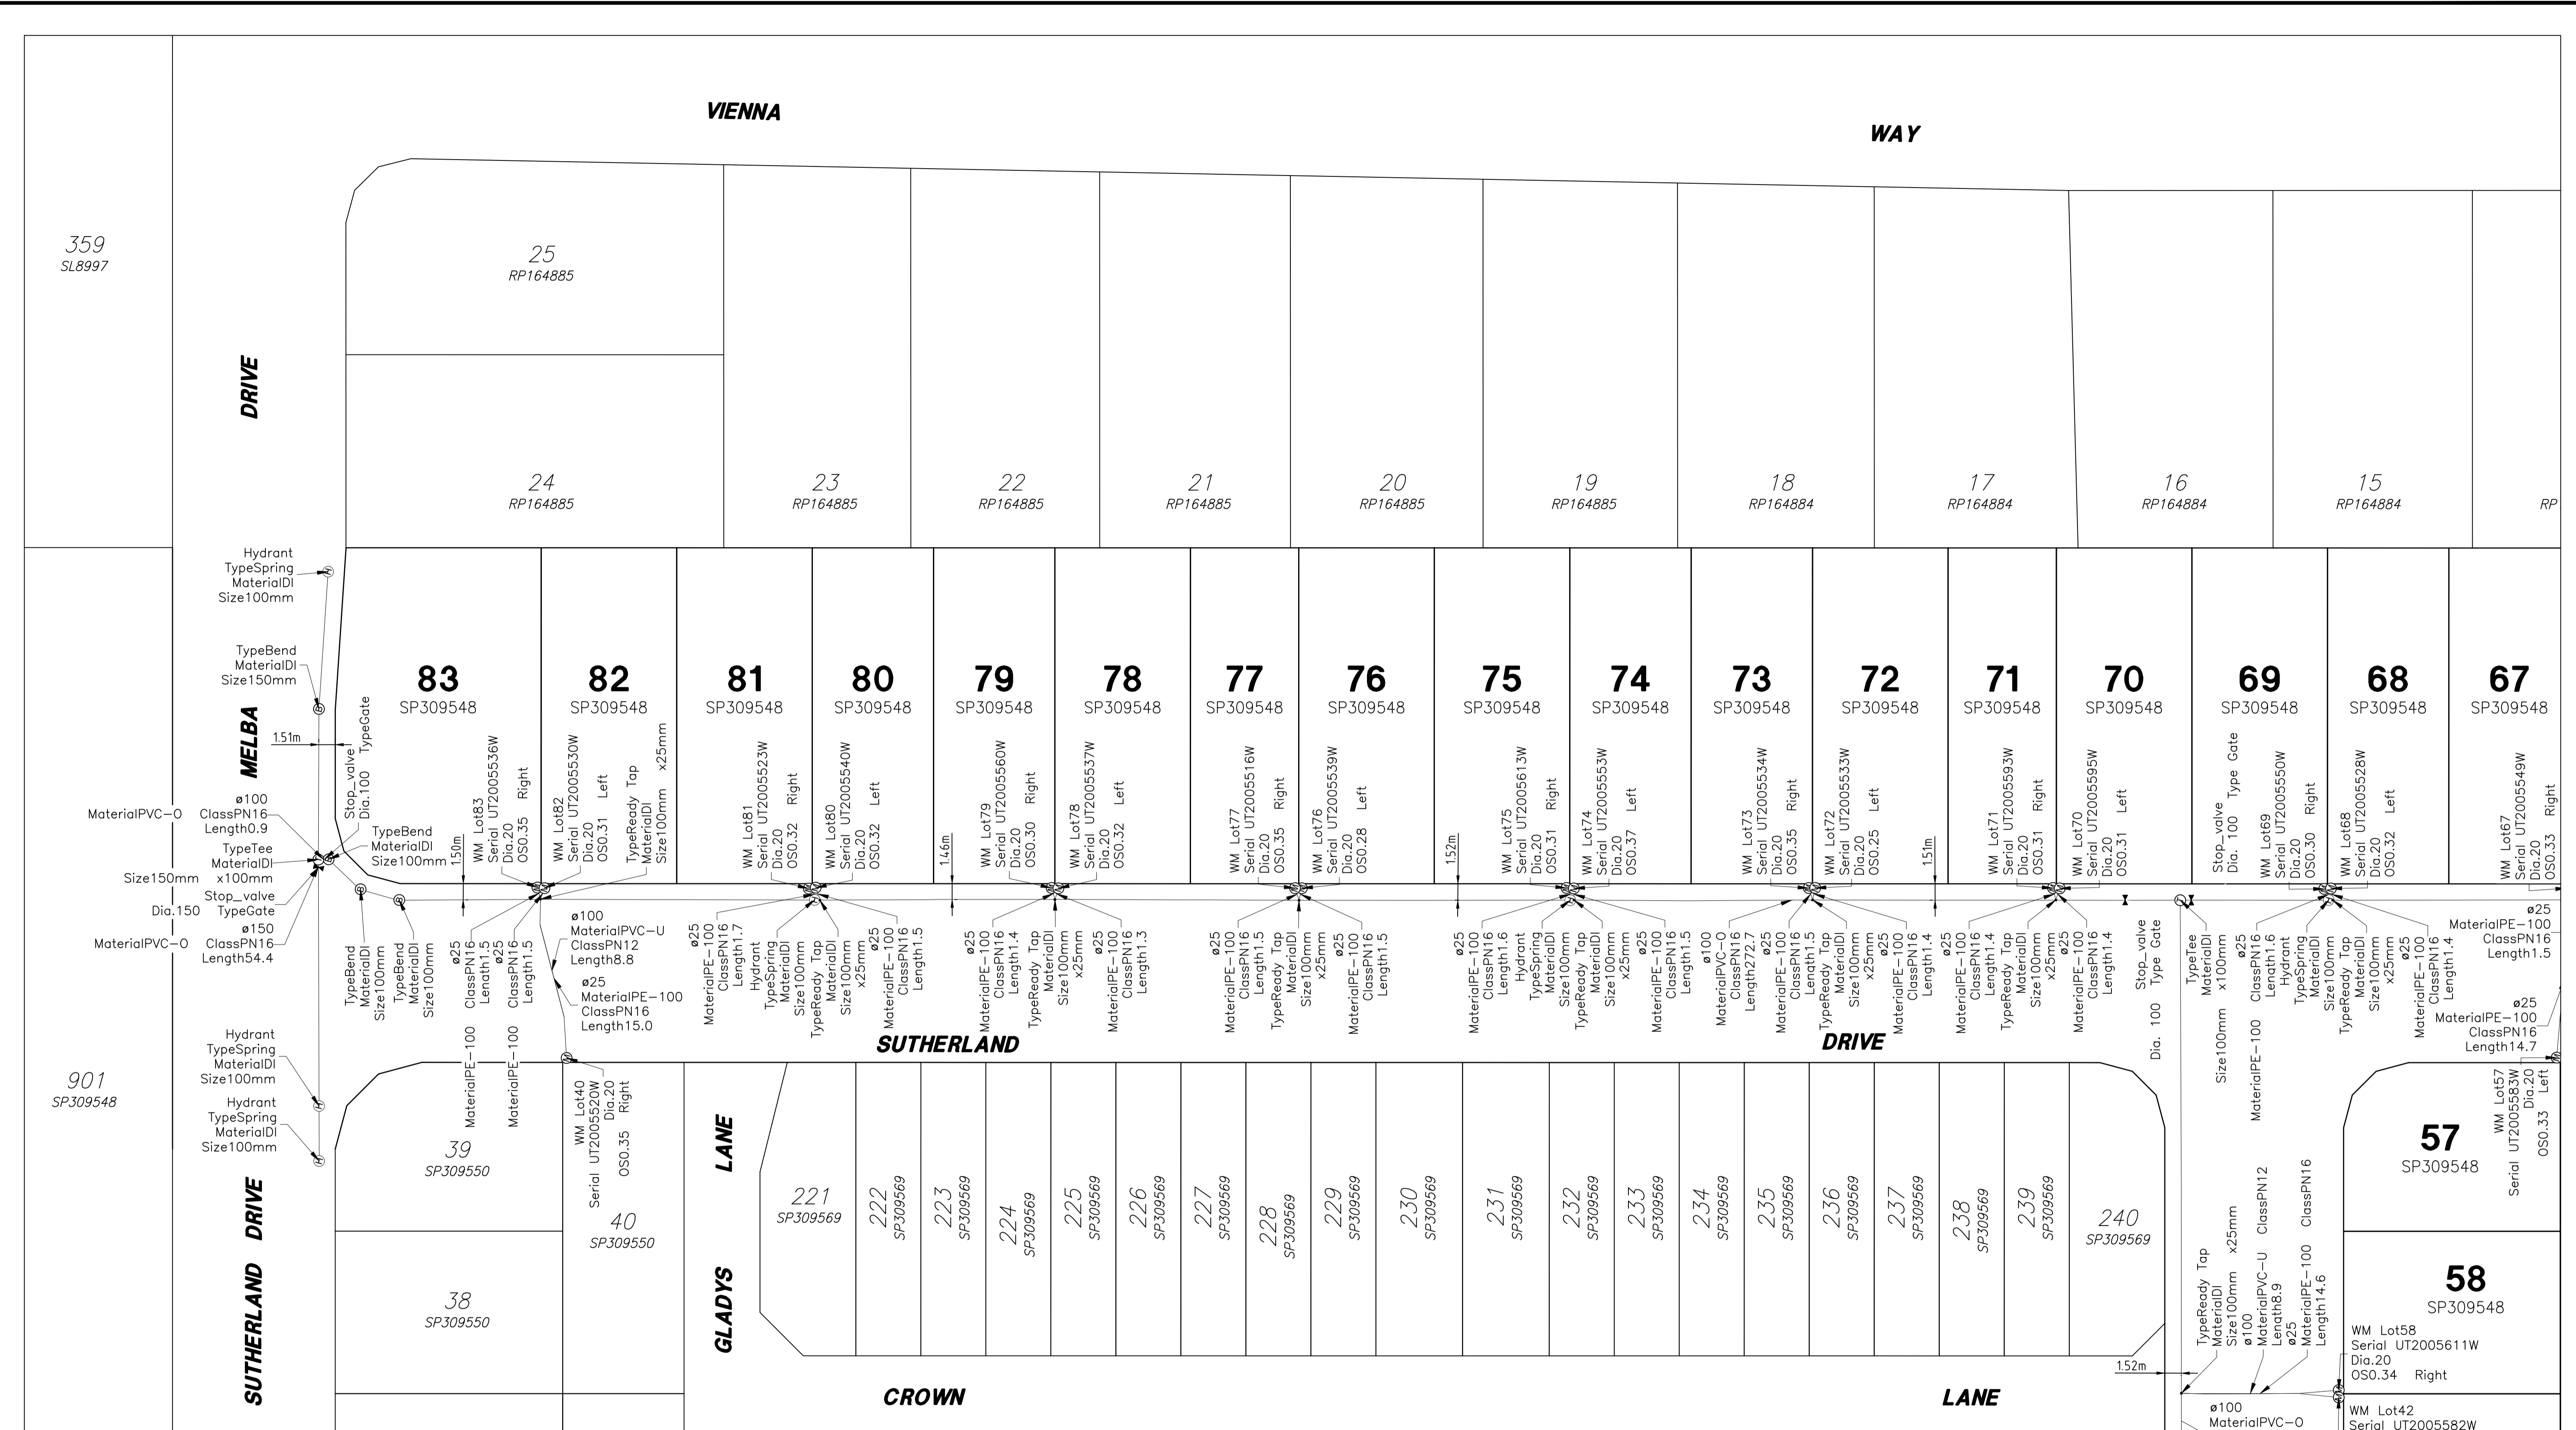


"I, _____ being a certified / registered engineer and duly authorised representative of hereby -

- × Certify the information contained in this drawing is an accurate "AS CONSTRUCTED" representation of the works.
- × Accept responsibility for the "AS CONSTRUCTED" information contained in this drawing.
- × Acknowledge the "AS CONSTRUCTED" information contained in the drawing may be relied on by Council and others.


We RPS Australia East Pty Ltd, Registered Surveyor - Land hereby certify that the Levels and Dimensions shown hereon are a correct record of our Survey which was performed in accordance with Council Accuracy Standards

Certification for Stage _____ by _____ on _____ for Registered Professional Engineer of Queensland - No. _____


 Authorised Delegate
 30/6/2020
 Date



A1	-	-	-	-	-	DRAWN RPS 23/06/2020	RPS	23/06/2020	 <p>RPS Australia Asia Pacific Level 4 HQ South 520 Wickham St Fortitude Valley QLD 4006 T +61 7 3539 9500 W rpsgroup.com</p>	 <p>Unitywater</p>	SCALE 1300 @ A1
	INDEX	DATE	REVISIONS	DRAWN	CHECKED						PASSED

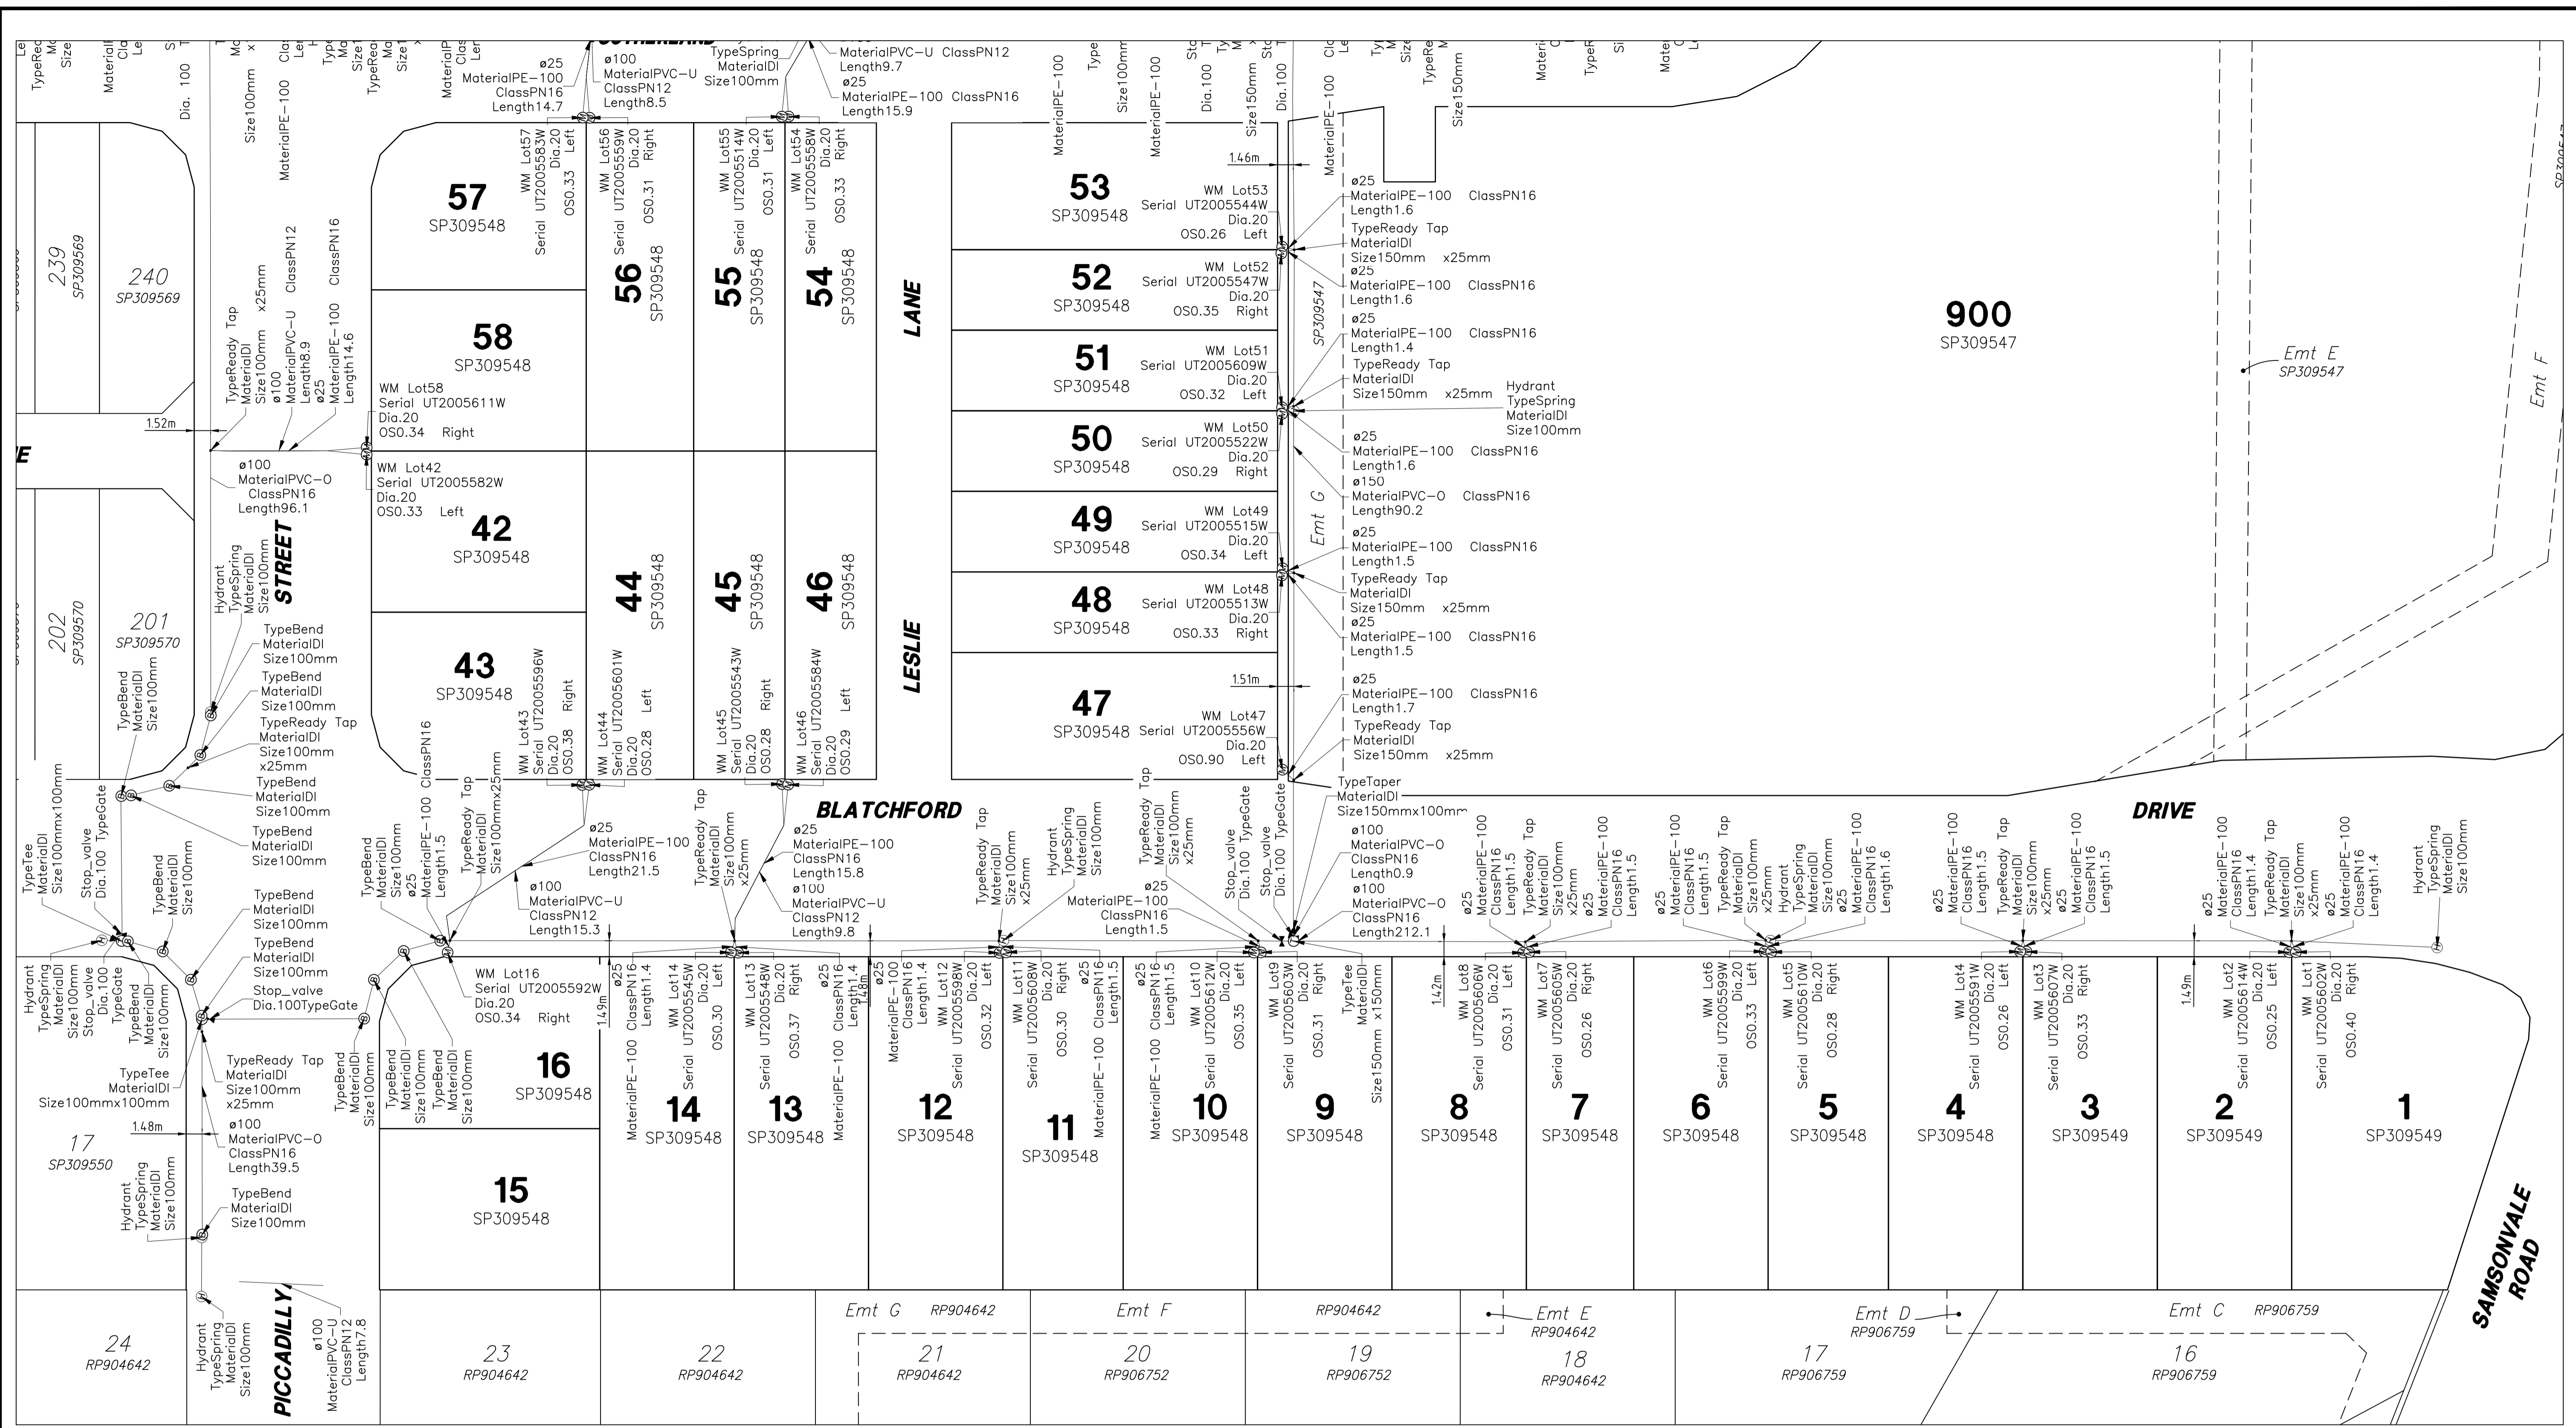

"I, _____, being a certified / registered engineer and duly authorised representative of hereby -

- × Certify the information contained in this drawing is an accurate "AS CONSTRUCTED" representation of the works.
- × Accept responsibility for the "AS CONSTRUCTED" information contained in this drawing.
- × Acknowledge the "AS CONSTRUCTED" information contained in the drawing may be relied on by Council and others.

Certification for Stage by on for Registered Professional Engineer of Queensland - No. _____

We RPS Australia East Pty Ltd, Registered Surveyor - Land hereby certify that the Levels and Dimensions shown hereon are a correct record of our Survey which was performed in accordance with Council Accuracy Standards

[Signature]
 Authorised Delegate
 30/6/2020
 Date

A1	INDEX	DATE	REVISIONS	DRAWN	CHECKED	PASSED
	-	-	-	-	-	-

DRAWN	RPS	23/06/2020
CHECKED	RPS	23/06/2020
PASSED	-	-
INITIALS	-	-
DATE	-	-




RPS Australia Asia Pacific
 Level 4 HQ South
 520 Wickham St
 Fortitude Valley
 QLD 4006
 T +61 7 3539 9500
 W rpsgroup.com



Unitywater

AS - CONSTRUCTED
 WATER RETICULATION

SCALE	1:300 @ A1
SHEET 2 OF 3 SHEETS	
DRAWING NO.	142823-11

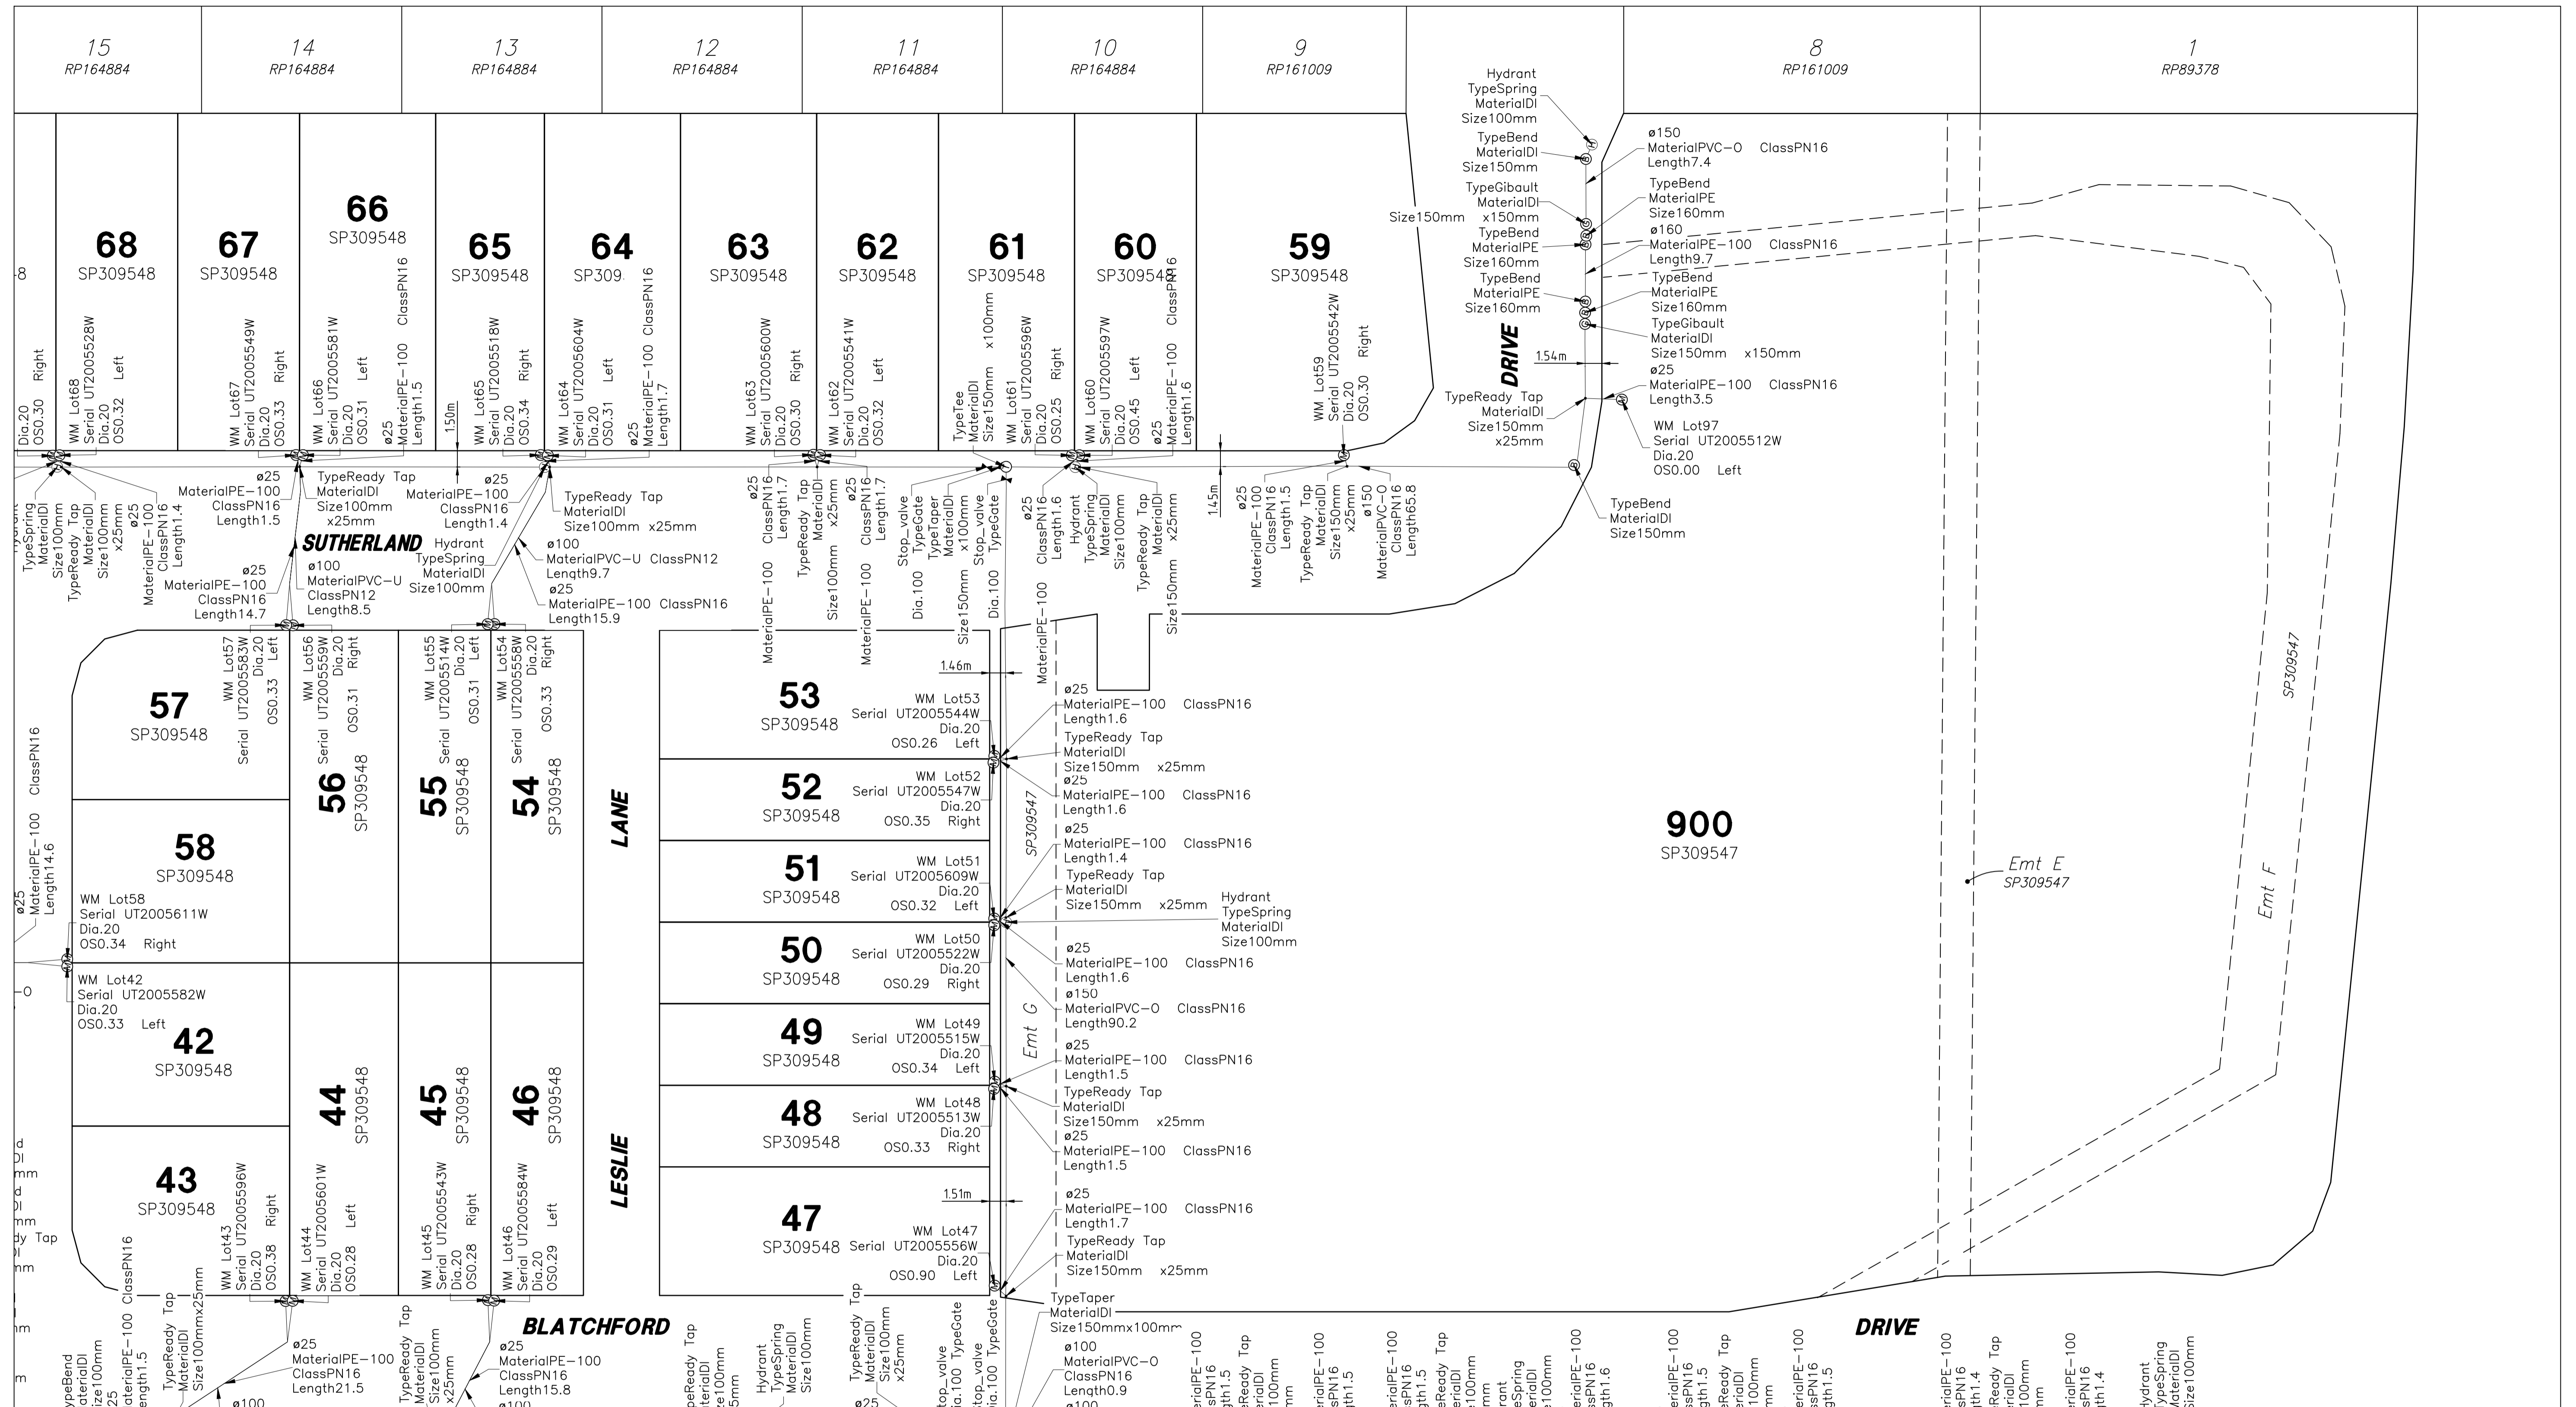


"I, _____ being a certified / registered engineer and duly authorised representative of hereby -

- × Certify the information contained in this drawing is an accurate "AS CONSTRUCTED" representation of the works.
- × Accept responsibility for the "AS CONSTRUCTED" information contained in this drawing.
- × Acknowledge the "AS CONSTRUCTED" information contained in the drawing may be relied on by Council and others.

Certification for Stage by on

for
Registered Professional Engineer of Queensland - No. _____

We RPS Australia East Pty Ltd, Registered Surveyor - Land hereby certify that the Levels and Dimensions shown hereon are a correct record of our Survey which was performed in accordance with Council Accuracy Standards


Authorised Delegate
30/6/2020
Date

6 3 0 3 6 9 12 15
SCALE IN METERS AT ORIGINAL REDUCTION RATIO
1:300

A1

INDEX	DATE	REVISIONS	DRAWN	CHECKED	PASSED
-	-	-	-	-	-
-	-	-	-	-	-
DRAWN	CHECKED	PASSED	INITIALS	DATE
RPS	RPS	-	-	23/06/2020
RPS	RPS	-	-	23/06/2020
-	-	-	-	-
-	-	-	-	-



RPS Australia Asia Pacific
Level 4 HQ South
520 Wickham St
Fortitude Valley
QLD 4006
T +61 7 3539 9500
W rpsgroup.com



Unitywater
AS - CONSTRUCTED
WATER RETICULATION

SCALE 1:300 @ A1
SHEET 3 OF 3 SHEETS
DRAWING NO.
142823-11