

LEGEND
 CONCRETE PATH
 CONTOUR MAJOR
 CONTOUR MINOR
 SPOT HEIGHT

CERTIFICATION OF AS-CONSTRUCTED WORKS BY CIVIL CONTRACTOR
 AS THE PRINCIPAL CONTRACTOR FOR THE ABOVE CIVIL WORKS, BMD URBAN DO CERTIFY THAT ALL CIVIL WORKS FOR THE DEVELOPMENT AT VANTAGE ESTATE STAGE 7 HAVE BEEN CONSTRUCTED UNDER THE SUPERVISION OF A BMD URBAN REPRESENTATIVE IN ACCORDANCE WITH THE RELEVANT AUTHORITY STANDARDS, THE APPROVED CIVIL ENGINEERING PLANS AND SPECIFICATION, AND ANY ASSOCIATED APPROVED PLAN AMENDMENTS. WE CONFIRM THAT THE AS CONSTRUCTED DATA AND TESTING CERTIFICATES PROVIDED TO WOOD & GRIEVE ENGINEERS REPRESENT A TRUE AND ACCURATE REFLECTION OF THE WORKS COMPLETED ON SITE.

SIGNATURE:
 NAME:
 DULY AUTHORISED ON BEHALF OF: BMD URBAN PTY LTD
 DATE:

IMPORTANT NOTE

- This plan was prepared as an As Constructed drawing for the Gladstone Regional Council and should not be used for any other purpose. This plan is strictly limited to that purpose and does not apply directly or indirectly and will not be used for any other application, use or matter. The plan is presented without the assumption of a duty of care to any other person (other than the Client) ("Third Party") and may not be relied on by Third Party.
- MPA Surveying will not be liable (in negligence or otherwise) for any direct or indirect loss, damage, liability or claim arising out of or incidental to:
 - a Third Party publishing, using or relying on the plan;
 - MPA Surveying relying on information provided to it by the Client or a Third Party where the information is incorrect, incomplete, inaccurate, out-of-date or unreasonable;
 - any inaccuracies or other faults with information or data sourced from a Third Party;
 - MPA Surveying relying on surface indicators that are incorrect or inaccurate;
 - the Client or any Third Party not verifying information in this plan where recommended by MPA Surveying
 - the accuracy, reliability, suitability or completeness of any approximations or estimates made or referred to by MPA Surveying
- Without limiting paragraph 1 or 2 above, this plan may not be copied, distributed, or reproduced by any process unless this note is clearly displayed on the plan.
- As this plan is also presented in a digital format, no responsibility is accepted by MPA Surveying for any alterations, amendments to the plan.

CERTIFICATION OF AS-CONSTRUCTED WORKS BY SURVEYOR
 MPA SURVEYING DO CERTIFY THAT THE AS CONSTRUCTED DATA AND PLANS PROVIDED TO BMD URBAN (AS THE PRINCIPAL CIVIL CONTRACTOR) FOR THE DEVELOPMENT AT VANTAGE ESTATE STAGE 7 IS A TRUE AND ACCURATE REFLECTION OF THE WORKS COMPLETED ON SITE. WE CONFIRM THAT ALL DATA AND PLANS HAVE BEEN PRESENTED USING THE CORRECT DATUM AND ORIENTATION APPROPRIATE TO THE SITE IN A FORMAT AS REQUIRED BY THE RELEVANT LOCAL AUTHORITY STANDARDS.

SIGNATURE:
 NAME:
 DULY AUTHORISED ON BEHALF OF: MPA SURVEYING
 DATE:

WORKS AS-CONSTRUCTED
 BASED ON THE INFORMATION SUPPLIED BY THE PROJECT SURVEYOR MPA SURVEYING, THE QUALITY ASSURANCE DOCUMENTATION RECEIVED FROM THE PRINCIPAL CIVIL CONTRACTOR BMD URBAN, AND THE REGULAR SITE INSPECTIONS CARRIED OUT, WE VERIFY THAT THE INTENT OF THE APPROVED DESIGN DRAWINGS HAS BEEN ACHIEVED, AND THIS DRAWING IS AN ACCURATE REPRESENTATION OF THE COMPLETED WORKS.

PROJECT:- VANTAGE STAGE 7
 PROJECT NUMBER:- 23520


SIGNATURE:.....(RPEQ 13360) DATE:.....
 A SAUNDERS
 ON BEHALF OF:
 WOOD & GRIEVE ENGINEERS LTD



Rev.	Reason for Issue or Amendment	Date	Drawn	Checked	Surveyed
A	Original Issue	30/9/13	KN	WF	MPA

MPA SURVEYING
 Head Office L6, 345 Ann St, Brisbane Q 4000 P 07 3002 2300
 mpa surveying.com.au
 Mackay Emerald Gladstone Brisbane Sunshine Coast
 ENGINEERING MINING CONSTRUCTION CADASTRAL

Project: Vantage Estate Stage 7	MPA Job No: G12020	Scale: 1:500 at A1
Title: Asconstructed Final Surface	Level Datum: AHD D RL57.996	Origin: PSM 95145
Client: Peet Pty Ltd	Co-ord System: MGA Zone 56	MPA Drawing No: G12020-FS7-01
	Revision: A	Sheet: 1 of 2

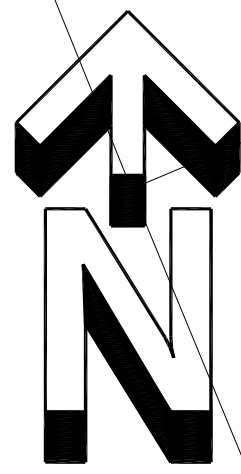

LEGEND
 CONCRETE PATH
 CONTOUR MAJOR
 CONTOUR MINOR
 SPOT HEIGHT

CERTIFICATION OF AS-CONSTRUCTED WORKS BY CIVIL CONTRACTOR

AS THE PRINCIPAL CONTRACTOR FOR THE ABOVE CIVIL WORKS, BMD URBAN DO CERTIFY THAT ALL CIVIL WORKS FOR THE DEVELOPMENT AT VANTAGE ESTATE STAGE 7 HAVE BEEN CONSTRUCTED UNDER THE SUPERVISION OF A BMD URBAN REPRESENTATIVE IN ACCORDANCE WITH THE RELEVANT AUTHORITY STANDARDS, THE APPROVED CIVIL ENGINEERING PLANS AND SPECIFICATION, AND ANY ASSOCIATED APPROVED PLAN AMENDMENTS. WE CONFIRM THAT THE AS CONSTRUCTED DATA AND TESTING CERTIFICATES PROVIDED TO WOOD & GRIEVE ENGINEERS REPRESENT A TRUE AND ACCURATE REFLECTION OF THE WORKS COMPLETED ON SITE.

SIGNATURE:
 NAME:
 DULY AUTHORISED ON BEHALF OF: BMD URBAN PTY LTD
 DATE:

IMPORTANT NOTE

- This plan was prepared as an As Constructed drawing for the Gladstone Regional Council and should not be used for any other purpose. This plan is strictly limited to that purpose and does not apply directly or indirectly and will not be used for any other application, use or matter. The plan is presented without the assumption of a duty of care to any other person (other than the Client) ("Third Party") and may not be relied on by Third Party.
- MPA Surveying will not be liable (in negligence or otherwise) for any direct or indirect loss, damage, liability or claim arising out of or incidental to:
 - a Third Party publishing, using or relying on the plan;
 - MPA Surveying relying on information provided to it by the Client or a Third Party where the information is incorrect, incomplete, inaccurate, out-of-date or unreasonable;
 - any inaccuracies or other faults with information or data sourced from a Third Party;
 - MPA Surveying relying on surface indicators that are incorrect or inaccurate;
 - the Client or any Third Party not verifying information in this plan where recommended by MPA Surveying
 - the accuracy, reliability, suitability or completeness of any approximations or estimates made or referred to by MPA Surveying
- Without limiting paragraph 1 or 2 above, this plan may not be copied, distributed, or reproduced by any process unless this note is clearly displayed on the plan.
- As this plan is also presented in a digital format, no responsibility is accepted by MPA Surveying for any alterations, amendments to the plan.

CERTIFICATION OF AS-CONSTRUCTED WORKS BY SURVEYOR

MPA SURVEYING DO CERTIFY THAT THE AS CONSTRUCTED DATA AND PLANS PROVIDED TO BMD URBAN (AS THE PRINCIPAL CIVIL CONTRACTOR) FOR THE DEVELOPMENT AT VANTAGE ESTATE STAGE 7 IS A TRUE AND ACCURATE REFLECTION OF THE WORKS COMPLETED ON SITE. WE CONFIRM THAT ALL DATA AND PLANS HAVE BEEN PRESENTED USING THE CORRECT DATUM AND ORIENTATION APPROPRIATE TO THE SITE IN A FORMAT AS REQUIRED BY THE RELEVANT LOCAL AUTHORITY STANDARDS.

SIGNATURE:
 NAME:
 DULY AUTHORISED ON BEHALF OF: MPA SURVEYING
 DATE:

WORKS AS-CONSTRUCTED

BASED ON THE INFORMATION SUPPLIED BY THE PROJECT SURVEYOR MPA SURVEYING, THE QUALITY ASSURANCE DOCUMENTATION RECEIVED FROM THE PRINCIPAL CIVIL CONTRACTOR BMD URBAN, AND THE REGULAR SITE INSPECTIONS CARRIED OUT, WE VERIFY THAT THE INTENT OF THE APPROVED DESIGN DRAWINGS HAS BEEN ACHIEVED, AND THIS DRAWING IS AN ACCURATE REPRESENTATION OF THE COMPLETED WORKS.

PROJECT:- VANTAGE STAGE 7
 PROJECT NUMBER:- 23520
 SIGNATURE:.....(RPEU 13360) DATE:.....
 A SAUNDERS
 ON BEHALF OF:
 WOOD & GRIEVE ENGINEERS LTD

Rev.	Original Issue	Reason for Issue or Amendment	Date	Drawn	Checked	Surveyed
A	Original Issue		30/9/13	KN	WF	MPA



Head Office L6, 345 Ann St, Brisbane Q 4000 P 07 3002 2300

mpasurveying.com.au

Mackay Emerald Gladstone Brisbane Sunshine Coast

ENGINEERING MINING CONSTRUCTION CADASTRAL

Project:
Vantage Estate Stage 7

Title:
Asconstructed Final Surface

Client:
Peet Pty Ltd

MPA Job No:
G12020

Level Datum: AHD D RL57.996
Origin: PSM 95145
Co-ord System: MGA Zone 56

MPA Drawing No: G12020-FS7-01
Revision: A
Sheet: 2 of 2

Scale:
1:500 at A1

