


PSM 191027
 E: 495937.616
 N: 7003052.339
 RL: 8.767m

UNITYWATER PROJECT NUMBER 2019013911S8 - VAR01 - ACP VILLAGE GREEN BOULEVARD, PALMVIEW U-2021-3856 SEWER/WATER MAIN

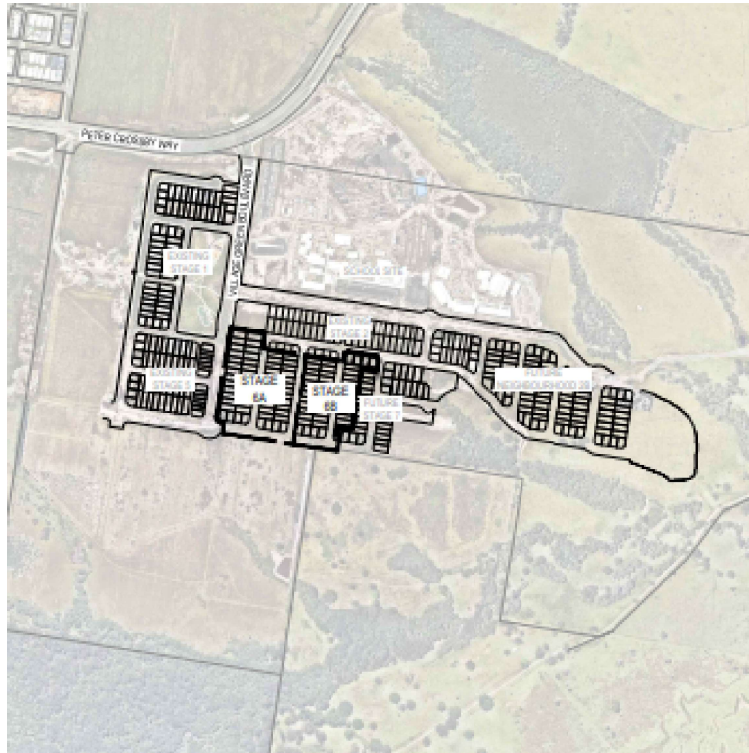

DRAWING NUMBER	DESCRIPTION
U-2021-3856	LOCALITY PLAN AND DRAWING INDEX
U-2021-3856 SE01	SEWER RETICULATION
U-2021-3856 SE02	SEWER RETICULATION
U-2021-3856 SE03	SEWER RETICULATION
U-2021-3856 SE04	SEWER RETICULATION
U-2021-3856 WA01	WATER RETICULATION
U-2021-3856 WA02	WATER RETICULATION
U-2021-3856 WA03	WATER RETICULATION
U-2021-3856 WA04	WATER RETICULATION

REGISTERED SURVEYOR'S CERTIFICATION

I, Andrew Robert Thurston, hereby certify that the vertical and horizontal locations and dimensions shown on this plan are a true and correct record and were located by survey.

A. R. Thurston
 Registered Surveyor (sig) Reg. Surveyor No. 63047 Date: 20/04/2022

ENGINEER'S CERTIFICATION

I, Dan Collins, being a Certified/Registered Engineer and duly authorised representative of PEAKURBAN Pty Ltd, hereby, certify the information contained in this drawing as generally an accurate "As Constructed" representation of the works.

D. Collins
 RPEQ (Signature) 18631 Date: 02/08/2022
 RPEQ No.

For and on behalf of PEAKURBAN Pty Ltd.
 In making this certificate we have relied upon information provided by others.

COORDINATE DATUM NOTE:
 HORIZONTAL COORDINATES(E,N) SUPPLIED ARE MAPPING GRID OF AUSTRALIA(MGA), ZONE 56 BASED ON THE UNIVERSAL TRANSVERSE MERCATOR PROJECTION AND THE GEOCENTRIC DATUM OF AUSTRALIA 1994.



A1	C	20/04/2022	AS CONSTRUCTED - EXISTING SEQ WATER MAIN ADDED	J Brago	A Dihn	A Thurston	DRAWN	JWB	20/04/2022
	B	22/03/2022	AS CONSTRUCTED	J Brago	A Dihn	A Thurston	CHECKED	AMD	20/04/2022
	A	22/12/2021	AS CONSTRUCTED - PRELIMINARY WITH DESIGN SURFACE LEVELS	J Brago	A Dihn	A Thurston	PASSED	ART	20/04/2022
	INDEX	DATE	REVISIONS	DRAWN	CHECKED	PASSED		INITIALS	DATE

WOLTER
consulting group

@ Planning @ Urban Design @ Landscape @ Environment @ Surveying

@ Brisbane: Level 2, 1 Breakfast Ck Road, Newstead, QLD 4006 Phone: (07) 3666 5200

Unitywater

2019013911S8 - VAR01 - ACP
 Village Green Stage 6
 Peter Crossby Way, Palmview
 Sewer and Water Reticulation

SHEET 1 OF 11 SHEETS SCALE 250

REVISION DATE 20/04/2022 REVISION C

DISCIPLINE CODE C

DRAWING NO. U-2021-3856

PSM 191027
 E: 495937.616
 N: 7003052.339
 RL: 8.761m

COORDINATE DATUM NOTE:
 HORIZONTAL COORDINATES (E,N) SUPPLIED ARE MAPPING GRID OF AUSTRALIA (MGA),
 ZONE 56 BASED ON THE UNIVERSAL TRANSVERSE MERCATOR PROJECTION AND THE
 GEOCENTRIC DATUM OF AUSTRALIA 1994.

LEGEND:

- SEWER MAIN NON PRESSURE
- EXISTING SEWER MAIN
- HOUSE CONNECTION
- SEWER MAINTENANCE HOLE
- SEWER MAINTENANCE SHAFT
- SEWER BEND
- SEWER WYE BRANCH
- SEWER TAPER
- SEWER VALVE
- SEWER END OF LINE

NOTE:

- ALL SEWER MAINS DN150 PVC-U CLASS SN8 or SN12 U.N.O.
- ALL MAINTENANCE HOLES (MH) ARE CONCRETE U.N.O.
- ALL MAINTENANCE SHAFTS (MS) 6000

REGISTERED SURVEYOR'S CERTIFICATION

I, Andrew Robert Thurston, hereby certify that the vertical and horizontal locations and dimensions shown on this plan are a true and correct record and were located by survey.

Registered Surveyor (sig) Reg. Surveyor No. 03047 Date: 20/04/2022


ENGINEER'S CERTIFICATION

I, Dan Collins, being a Certified Registered Engineer and duly authorised representative of PEAKURBAN Pty Ltd, hereby, certify the information contained in this drawing as generally an accurate "As Constructed" representation of the works.

RPEQ (Signature) 18631 Date: 03/08/2022
 RPEQ No.

For and on behalf of PEAKURBAN Pty Ltd.
 In making this certificate we have relied upon information provided by others.

LIMIT OF WORKS

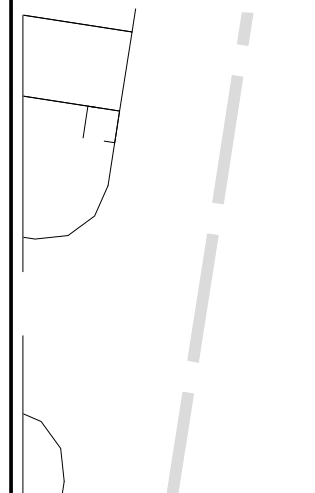

LIMIT OF WORKS

JOIN LINE - SEE SHEET 502

INDEX	DATE	REVISIONS	DRAWN	CHECKED	PASSED	INITIALS	DATE
A1	20/04/2022	AS CONSTRUCTED - EXISTING SEQ WATER MAIN ADDED	J.Brigo	A.Dahn	A.Thurston	DRAWN	JWB 20/04/2022
B	22/03/2022	AS CONSTRUCTED	J.Brigo	A.Dahn	A.Thurston	CHECKED	AMD 20/04/2022
A	22/12/2021	AS CONSTRUCTED - PRELIMINARY WITH DESIGN SURFACE LEVELS	J.Brigo	A.Dahn	A.Thurston	PASSED	ART 20/04/2022

WOLTER consulting group
 Planning Urban Design Landscape Environment Surveying
 Brisbane Level 2 & Breakfast Ck Road, Newstead, QLD 4006 Phone: 1073 5665 5200

Unitywater
 201901391158 - VAR01 - ACP
 Village Green Stage 6
 Peter Crossby Way, Palmview
 Sewer Retification

Unitywater
 201901391158 - VAR01 - ACP
 Village Green Stage 6
 Peter Crossby Way, Palmview
 Sewer Retification

SHEET 2 OF 11 SHEETS	SCALE 250
REVISION DATE 20/04/2022	REVISION C
DISCIPLINE CODE C	
DRAWING NO. U-2021-3856 SE01	

PSM 191027
 E: 495937.616
 N: 7003052.339
 RL: 8.761m

LEGEND:

- SEWER MAIN NON PRESSURE
- EXISTING SEWER MAIN
- HOUSE CONNECTION
- SEWER MAINTENANCE HOLE
- SEWER MAINTENANCE SHAFT
- SEWER BEND
- SEWER WYE BRANCH
- SEWER TAPER
- SEWER VALVE
- SEWER END OF LINE

NOTE:

- ALL SEWER MAINS DN150 PVC-U CLASS SN8 or SN12 U.N.O.
- ALL MAINTENANCE HOLES (MH) ARE CONCRETE U.N.O.
- Ø AS LABELLED
- ALL MAINTENANCE SHAFTS (MS) 6000

REGISTERED SURVEYOR'S CERTIFICATION

I, Andrew Robert Thurston, hereby certify that the vertical and horizontal locations and dimensions shown on this plan are a true and correct record and were located by survey.

Registered Surveyor (sg) Reg. Surveyor No. 83047 Date: 20/04/2022

ENGINEER'S CERTIFICATION

I, Dan Collins, being a Certified/Registered Engineer and duly authorised representative of PEAKURBAN Pty Ltd, hereby, certify the information contained in this drawing as generally an accurate "As Constructed" representation of the works.

RPEQ (Signature) 18631 Date: 03/08/2022
 RPEQ No.

For and on behalf of PEAKURBAN Pty Ltd.
 In making this certificate we have relied upon information provided by others.

LIMIT OF WORKS

LIMIT OF WORKS

COORDINATE DATUM NOTE:
 HORIZONTAL COORDINATES (E,N) SUPPLIED ARE MAPPING GRID OF AUSTRALIA (MGA), ZONE 56 BASED ON THE UNIVERSAL TRANSVERSE MERCATOR PROJECTION AND THE GEOCENTRIC DATUM OF AUSTRALIA 1994.


A1	C	20/04/2022	AS CONSTRUCTED - EXISTING SEQ WATER MAIN ADDED	J.Bravo	A.Dahn	A.Thurston	DRAWN	JWB	20/04/2022
	B	22/03/2022	AS CONSTRUCTED	J.Bravo	A.Dahn	A.Thurston	CHECKED	AMD	20/04/2022
	A	22/12/2021	AS CONSTRUCTED - PRELIMINARY WITH DESIGN SURFACE LEVELS	J.Bravo	A.Dahn	A.Thurston	PASSED	ART	20/04/2022
	INDEX	DATE	REVISIONS	DRAWN	CHECKED	PASSED	PASSED	INITIALS	DATE

WOLTER consulting group
 Planning Urban Design Landscape Environment Surveying
 Brisbane Level 2 & Breakfast Ck Road, Newstead, QLD 4006 Phone: 1073 566520




Unitywater
 20190139158 - VAR01 - ACP
 Village Green Stage 6
 Peter Crossby Way, Palmview
 Sewer Retification

SHEET 3 OF 11 SHEETS	SCALE 250
REVISION DATE 20/04/2022	REVISION C
DISCIPLINE CODE C	
DRAWING NO.	U-2021-3856 SE02

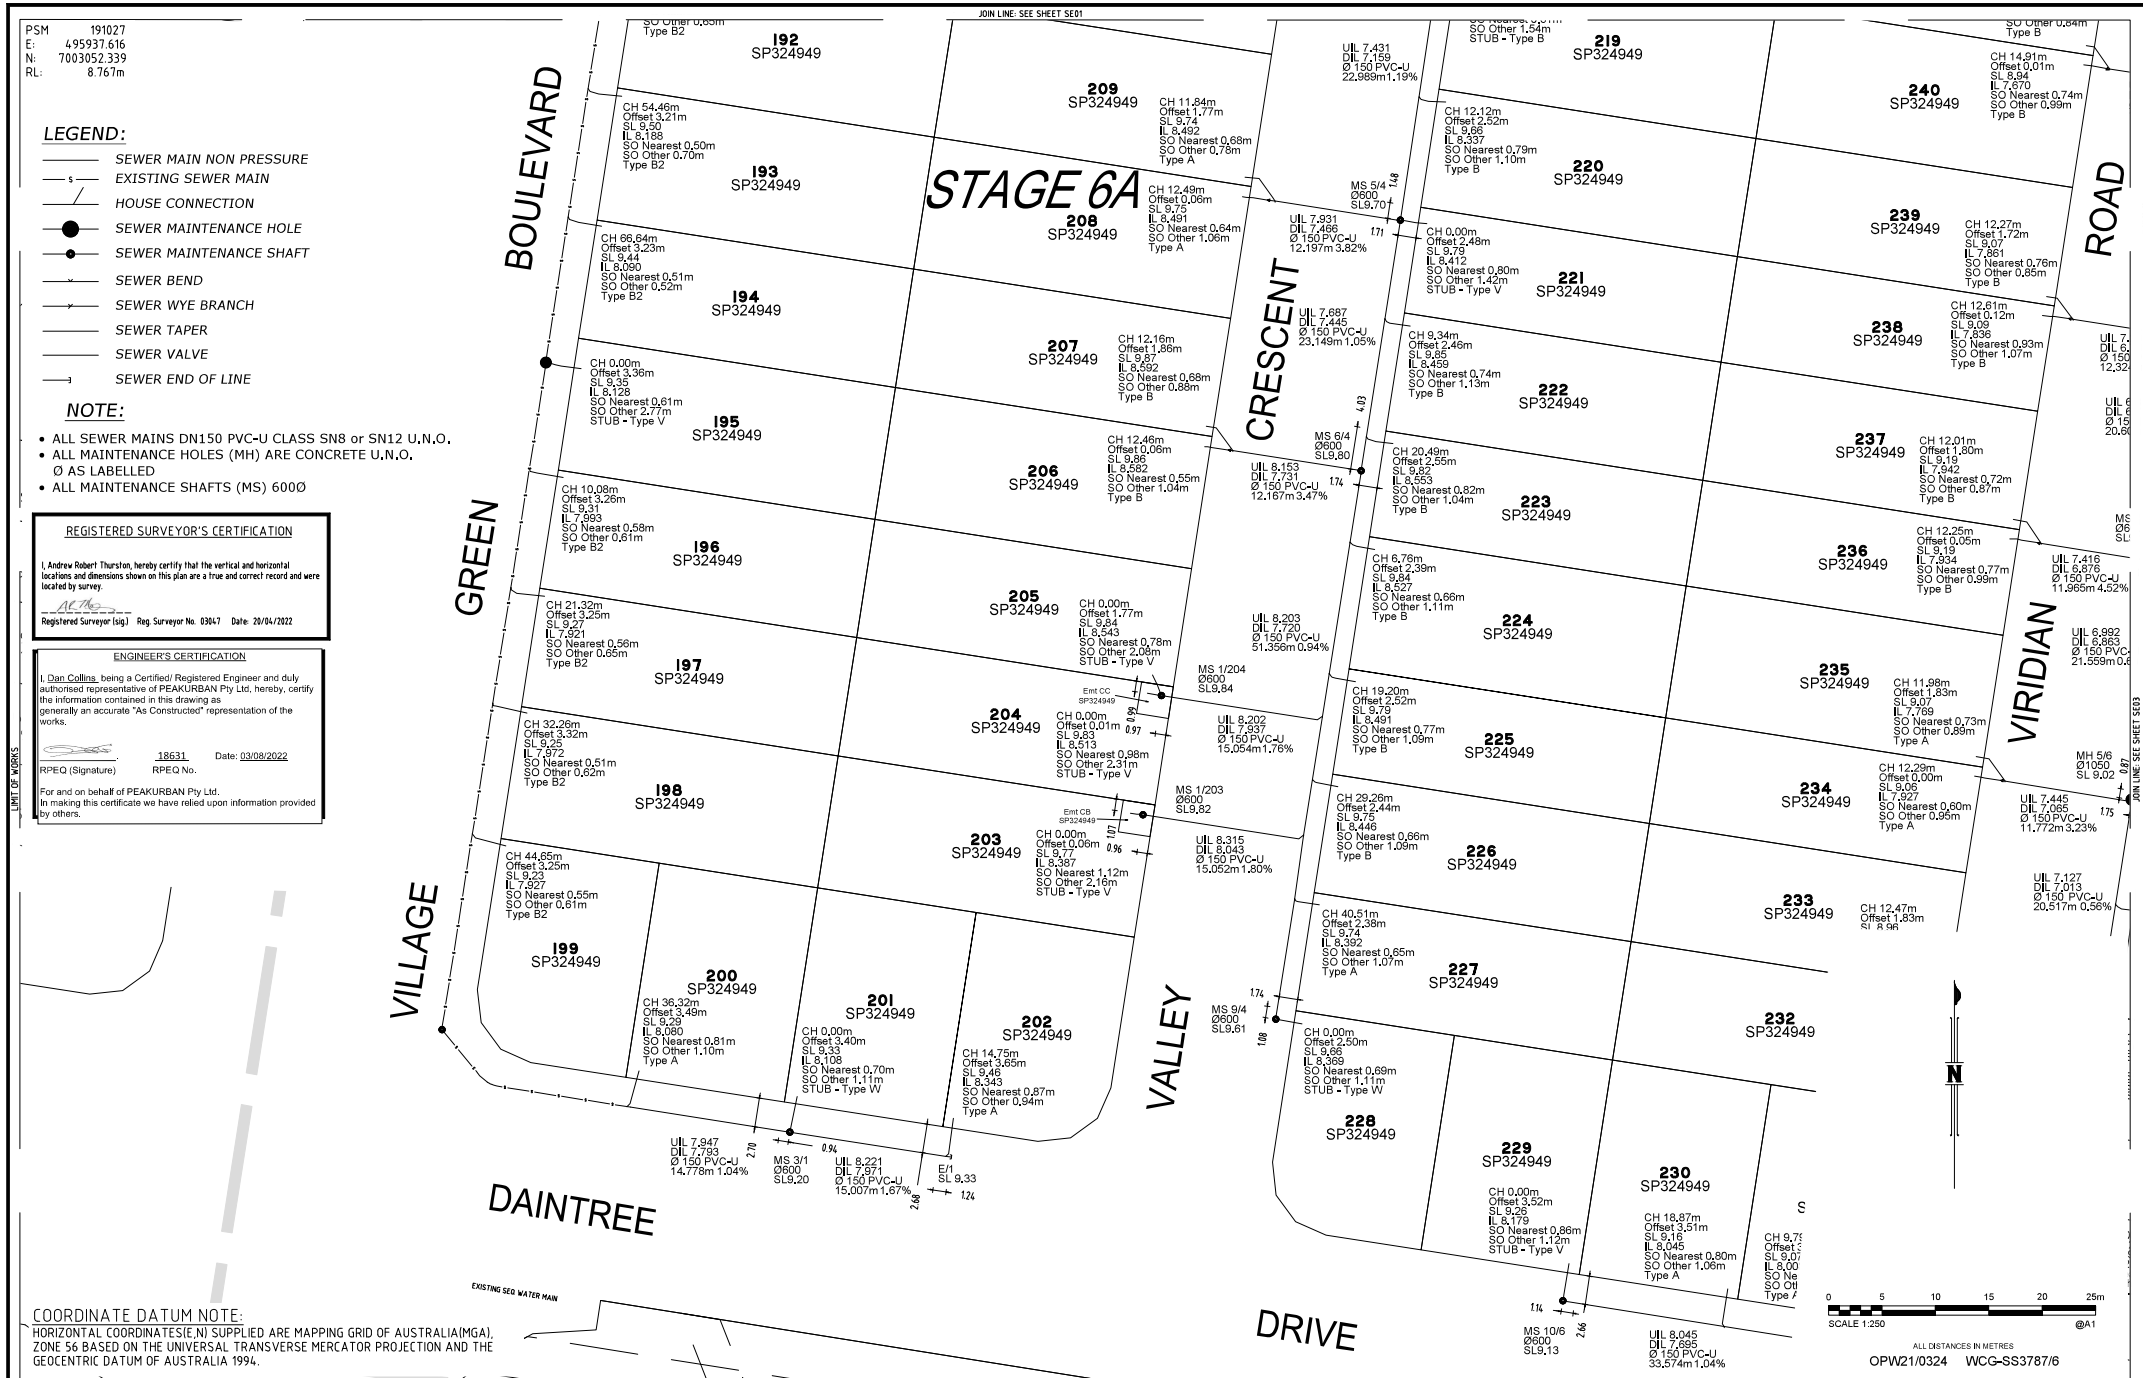


LIMIT OF WORKS

LIMIT OF WORKS

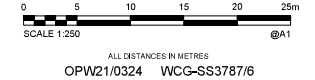

OPW21/0324 WCG-SS3787/6

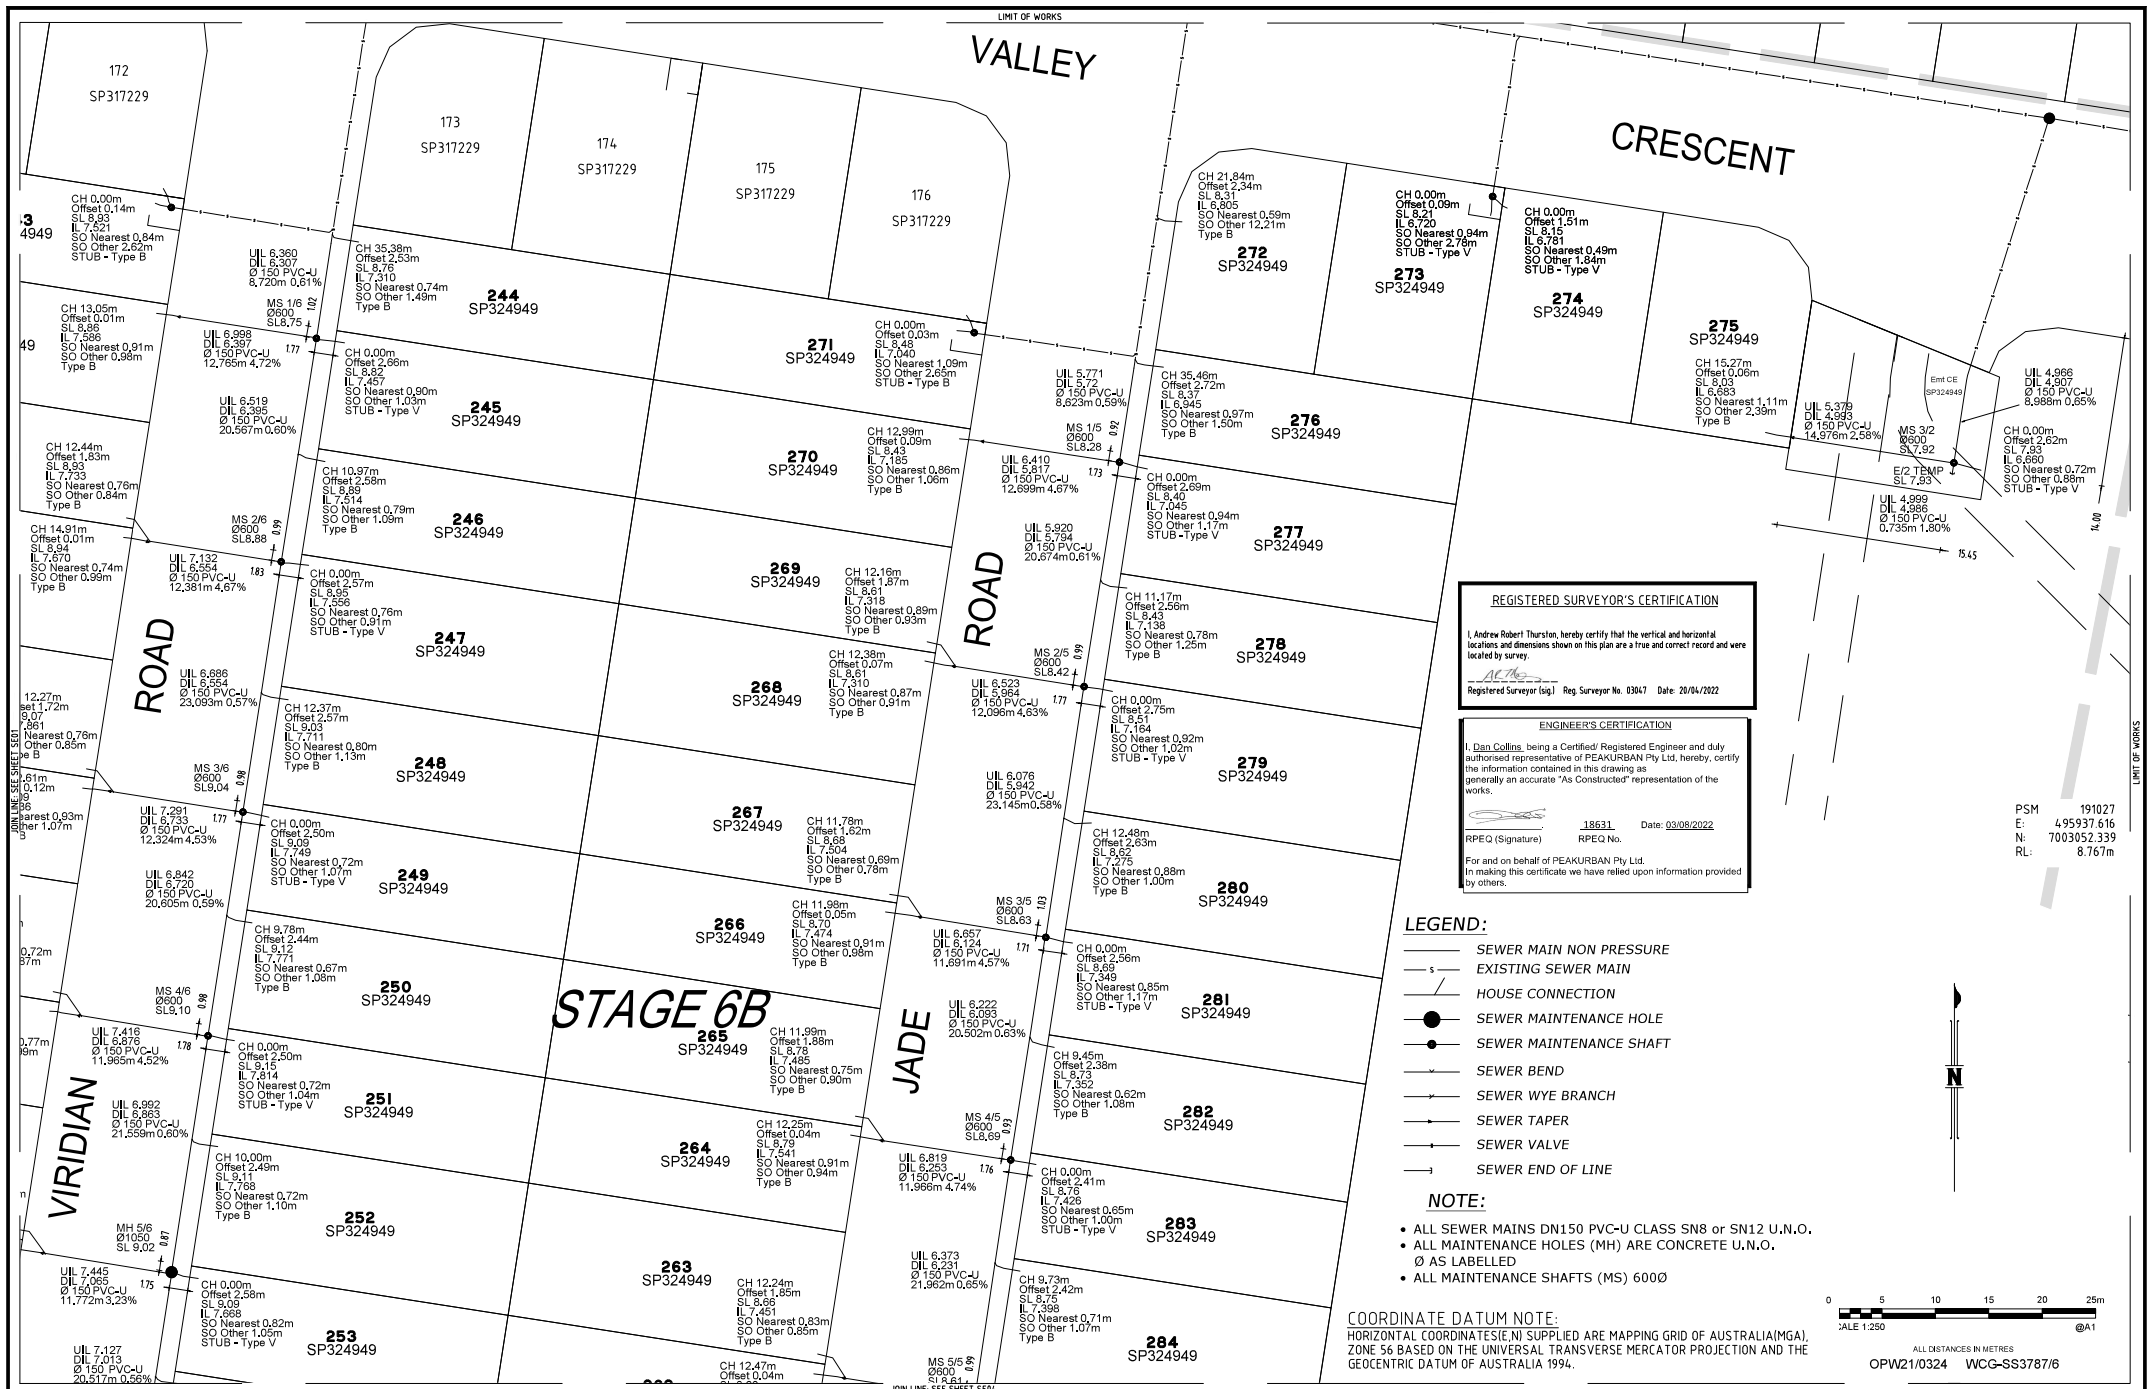

REGISTERED SURVEYOR'S CERTIFICATION

I, Andrew Robert Thurston, hereby certify that the true and horizontal locations and dimensions shown on this plan are a correct record and were located by survey.

Andrew Robert Thurston
 Registered Surveyor (Sgl.) Reg. Surveyor No. 03617 Date: 20/04/2022

ENGINEER'S CERTIFICATION

I, Dan Collins, being a Certified/Registered Engineer and duly authorised representative of PEAKURBAN Pty Ltd, hereby, certify the information contained in this drawing as generally an accurate "As Constructed" representation of the works.


Dan Collins
 18631 Date: 03/08/2022
 RPEQ (Signature) RPEQ No. 7003052.339

For and on behalf of PEAKURBAN Pty Ltd.
 In making this certificate we have relied upon information provided by others.

- LEGEND:**
- SEWER MAIN NON PRESSURE
 - s - EXISTING SEWER MAIN
 - HOUSE CONNECTION
 - SEWER MAINTENANCE HOLE
 - SEWER MAINTENANCE SHAFT
 - SEWER BEND
 - SEWER WYE BRANCH
 - SEWER TAPER
 - SEWER VALVE
 - SEWER END OF LINE

- NOTE:**
- ALL SEWER MAINS DN150 PVC-U CLASS SN8 or SN12 U.N.O.
 - ALL MAINTENANCE HOLES (MH) ARE CONCRETE U.N.O.
 - Ø AS LABELLED
 - ALL MAINTENANCE SHAFTS (MS) 600Ø

COORDINATE DATUM NOTE:
 HORIZONTAL COORDINATES (E/N) SUPPLIED ARE MAPPING GRID OF AUSTRALIA (MGA), ZONE 56 BASED ON THE UNIVERSAL TRANSVERSE MERCATOR PROJECTION AND THE GEOCENTRIC DATUM OF AUSTRALIA 1994.

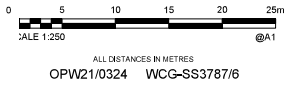

A1	C	20/04/2022	AS CONSTRUCTED - EXISTING SEQ WATER MAIN ADDED	J.Braga	A.Dahm	A.Thurston	DRAWN	JWB	20/04/2022
	B	22/03/2022	AS CONSTRUCTED	J.Braga	A.Dahm	A.Thurston	CHECKED	AMD	20/04/2022
	A	22/12/2021	AS CONSTRUCTED - PRELIMINARY WITH DESIGN SURFACE LEVELS	J.Braga	A.Dahm	A.Thurston	PASSED	ART	20/04/2022
	INDEX	DATE	REVISIONS	DRAWN	CHECKED	PASSED	PASSED	INITIALS	DATE

WOLTER consulting group

Planning Urban Design Landscape Environment Surveying


Unit 2, 1 Breakfast Ck Rd, Newstead, QLD 4006 Phone: 1073 566 5200

Unitywater

Unitywater

20190139158 - VAR01 - ACP
 Village Green Stage 6
 Peter Crosby Way, Palmview
 Sewer Retification

SHEET 4 OF 11 SHEETS	SCALE 250
REVISION NUMBER 20/04/2022	REVISION C
DISCIPLINE CODE C	
DRAWING NO. U-2021-3856 SE03	

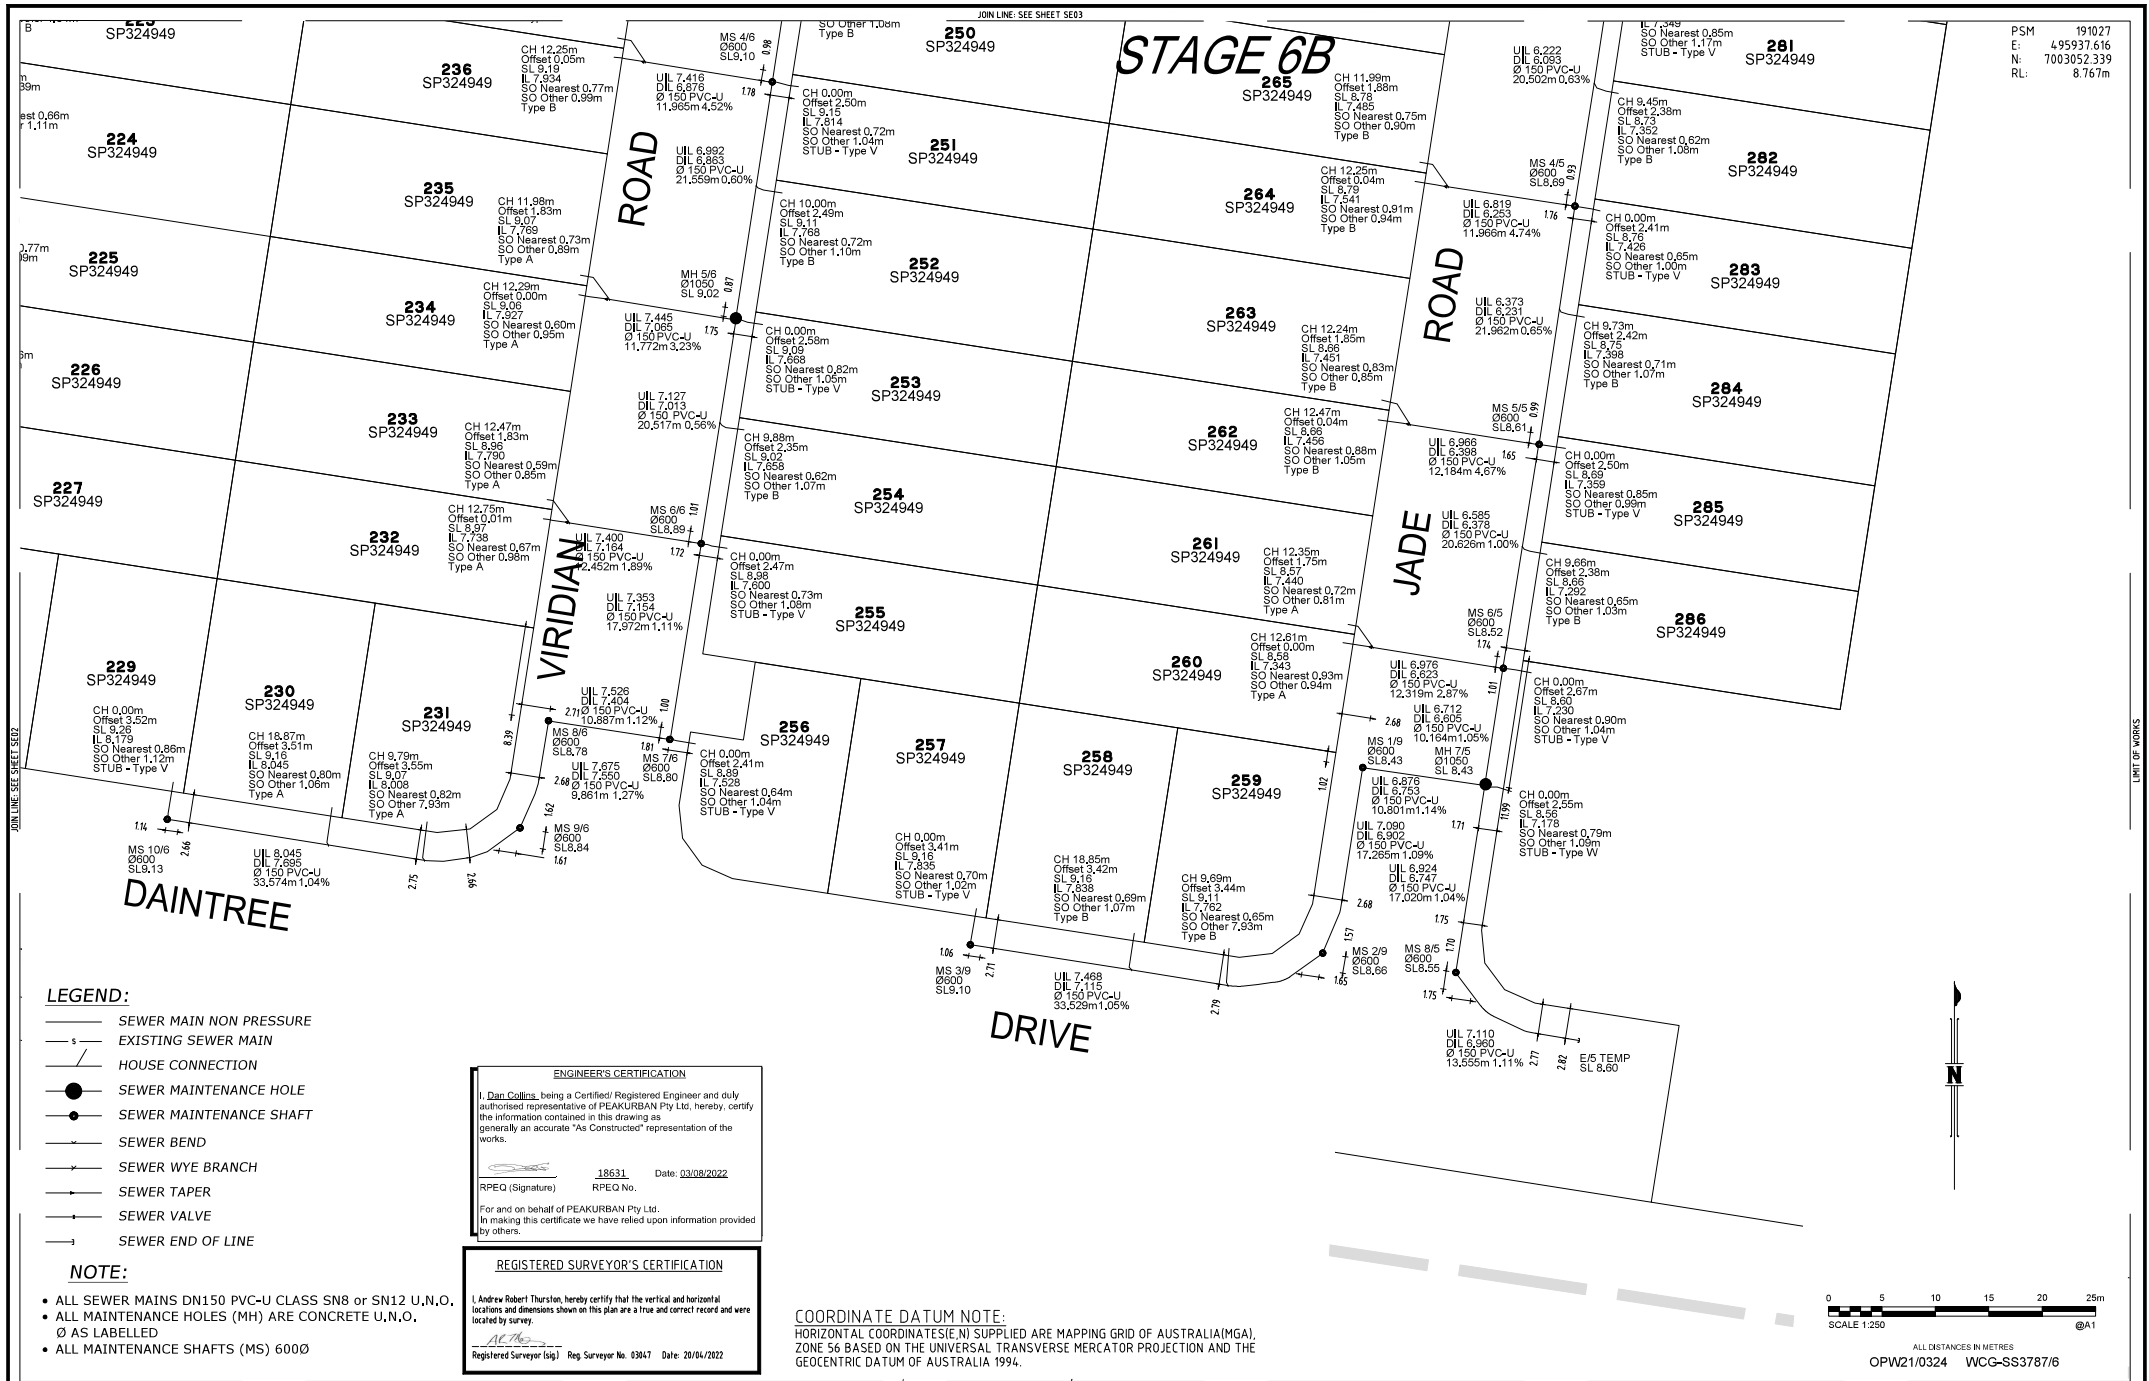

A1	C	20/04/2022	AS CONSTRUCTED - EXISTING SEQ WATER MAIN ADDED	J.Braga	A.Dahn	A.Thurston	DRAWN	JWB	20/04/2022
	B	22/03/2022	AS CONSTRUCTED	J.Braga	A.Dahn	A.Thurston	CHECKED	AMD	20/04/2022
	A	22/12/2021	AS CONSTRUCTED - PRELIMINARY WITH DESIGN SURFACE LEVELS	J.Braga	A.Dahn	A.Thurston	PASSED	ART	20/04/2022
	INDEX	DATE	REVISIONS	DRAWN	CHECKED	PASSED	INITIALS	DATE	

	Planning Urban Design Landscape Environment Surveying Birlinn: Level 2 & Breakfast Ck Road, Newport, QLD 4006 Phone: 1073 566 5200

Unitywater

201901391158 - VAR01 - ACP
 Village Green Stage 6
 Peter Crosby Way, Palmview
 Sewer Reticulation

SHEET 5 OF 11 SHEETS	SCALE 250
REVISION DATE 20/04/2022	REVISION C
DISCIPLINE CODE C	
DRAWING NO. U-2021-3856 SE04	

PSM 191027
 E: 495937.616
 N: 7003052.339
 RL: 8.767m

COORDINATE DATUM NOTE:
 HORIZONTAL COORDINATES (E,N) SUPPLIED ARE MAPPING GRID OF AUSTRALIA (MGA),
 ZONE 56 BASED ON THE UNIVERSAL TRANSVERSE MERCATOR PROJECTION AND THE
 GEOCENTRIC DATUM OF AUSTRALIA 1994.

LIMIT OF WORKS

LEGEND:

- Ø150 OR Ø200 PVC-O CLASS PN16 WATERMAIN AS NOTED
- EXISTING WATER MAIN
- DICL WATERMAIN
- READY TAP HOUSE CONNECTION
- TAPPING BAND HOUSE CONNECTION
- HYDRANT
- SLUICE VALVE
- TAPER/REDUCER
- BEND
- END CAP
- WATER SERVICE PIPE
- WATER SERVICE METER
- WATER SERVICE CONDUIT 1000 PVC-O

ENGINEER'S CERTIFICATION

I, Dan Collins, being a Certified/Registered Engineer and duly authorised representative of PEAKURBAN Pty Ltd, hereby certify the information contained in this drawing as generally an accurate "As Constructed" representation of the works.

18631 Date: 03/08/2022
 RPEQ (Signature) RPEQ No.


For and on behalf of PEAKURBAN Pty Ltd.
 In making this certificate we have relied upon information provided by others.

REGISTERED SURVEYOR'S CERTIFICATION

I, Andrew Robert Thurston, hereby certify that the vertical and horizontal locations and dimensions shown on this plan are a true and correct record and were located by survey.

Registered Surveyor (sig) Reg. Surveyor No. 03047 Date: 20/04/2022


LIMIT OF WORKS

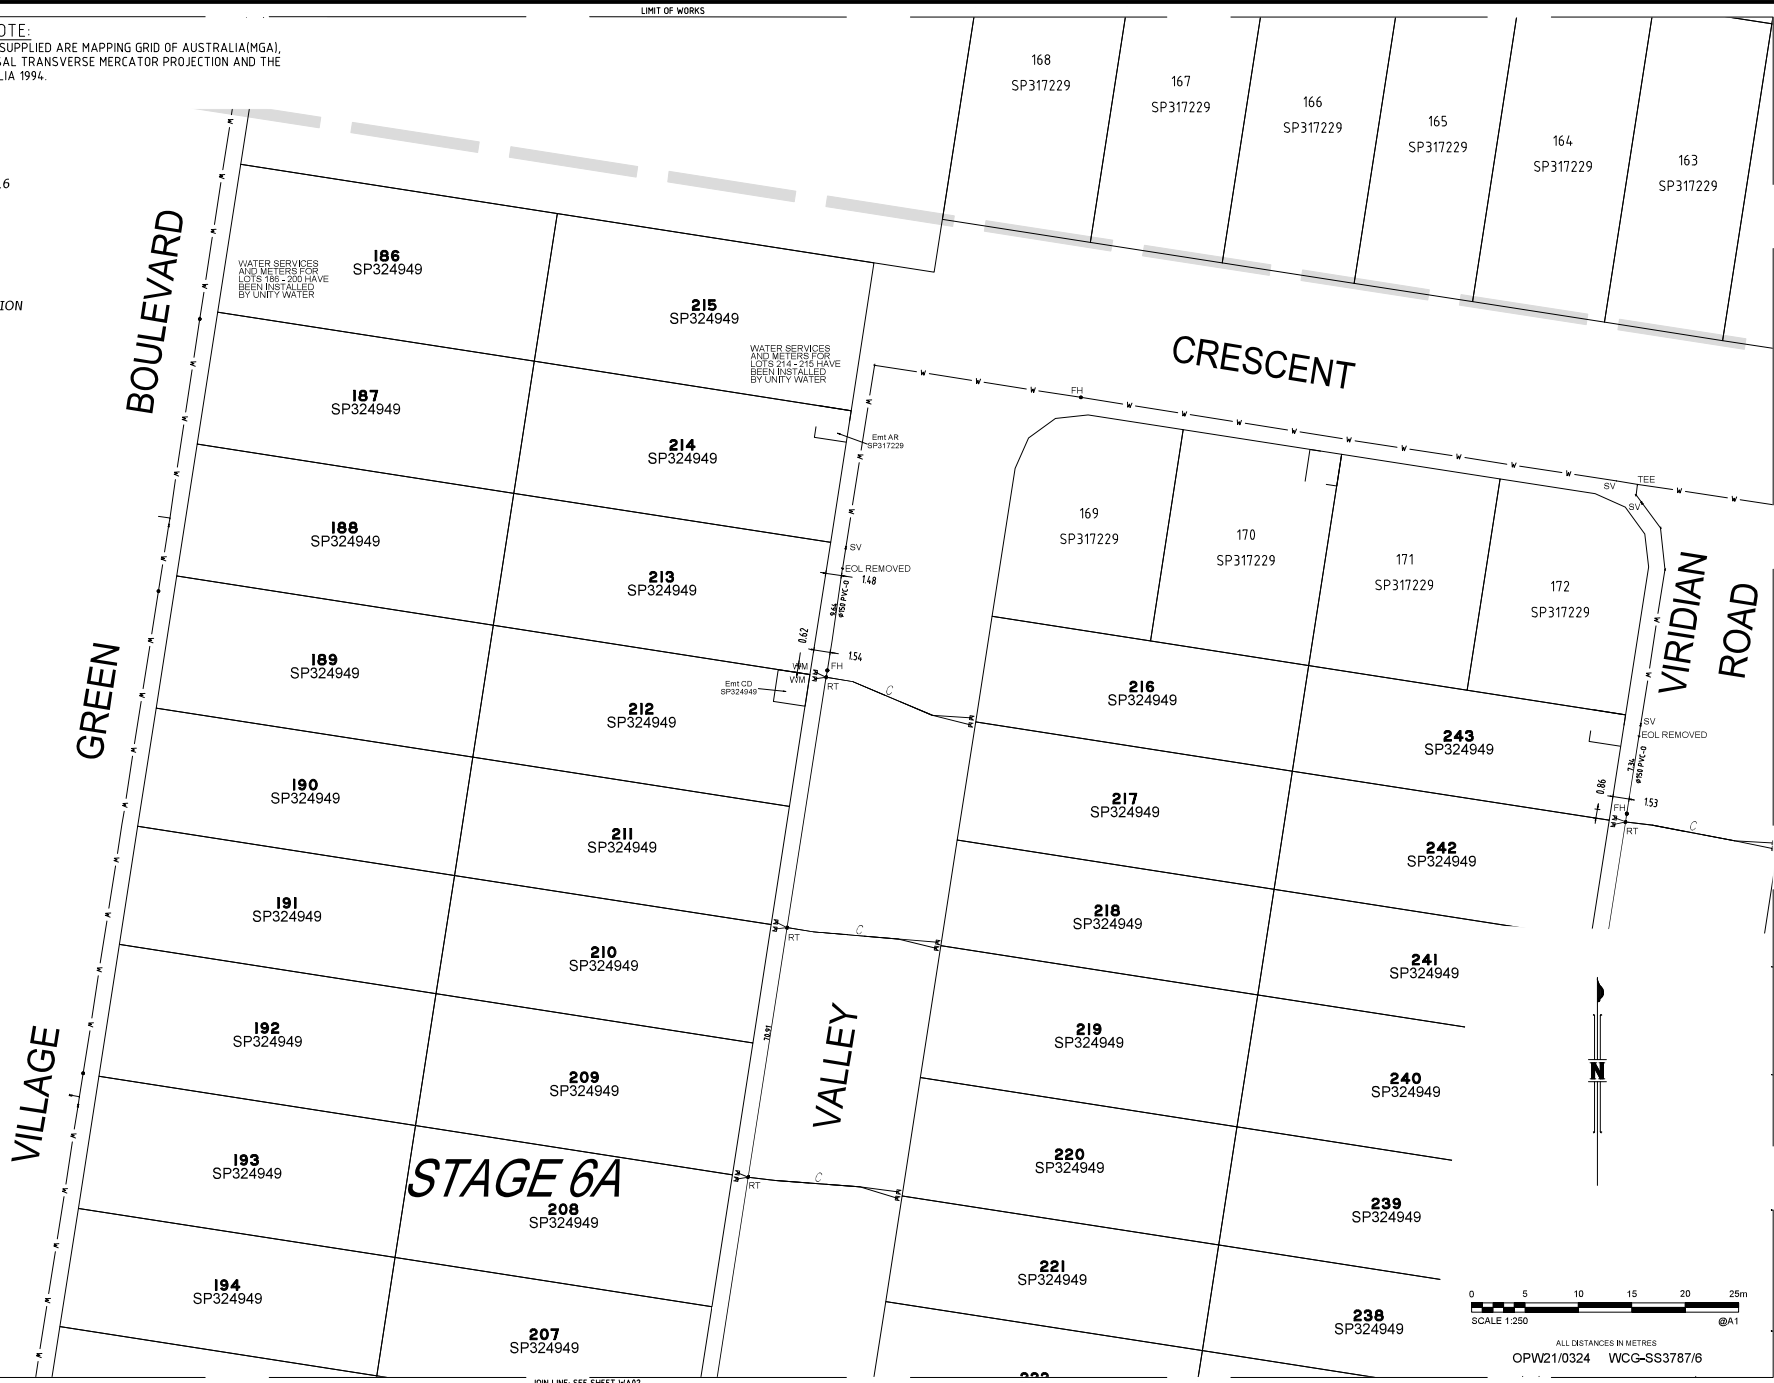

WATER SERVICES AND METERS FOR LOTS 186 - 200 HAVE BEEN INSTALLED BY UNITY WATER

WATER SERVICES AND METERS FOR LOTS 214 - 216 HAVE BEEN INSTALLED BY UNITY WATER

JOIN LINE - SEE SHEET WA01

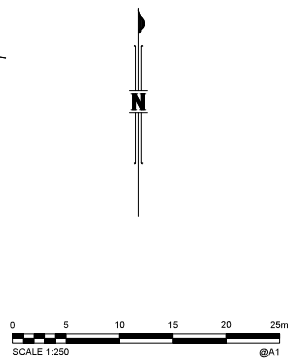

OPW21/0324 WCG-SS3787/6

A1	C	20/04/2022	AS CONSTRUCTED - EXISTING SEQ WATER MAIN ADDED	J.Brigo	A.Dihn	A.Thurston	DRAWN	JWB	20/04/2022
	B	22/03/2022	AS CONSTRUCTED	J.Brigo	A.Dihn	A.Thurston	CHECKED	AMD	20/04/2022
	A	22/12/2021	AS CONSTRUCTED - PRELIMINARY WITH DESIGN SURFACE LEVELS	J.Brigo	A.Dihn	A.Thurston	PASSED	ART	20/04/2022
	INDEX	DATE	REVISIONS	DRAWN	CHECKED	PASSED	INITIALS	DATE	

WOLTER
consulting group

Planning Urban Design Landscape Environment Surveying

Brisbane Level 2, 1 Breakfast Ck Road, Newstead, QLD 4006 Phone: 071 5666 5200

Unitywater

20190139158 - VAR01 - ACP
Village Green Stage 6
Peter Crosby Way, Palmview
Water Retification

SHEET 6 OF 11 SHEETS | SCALE 250



 



 







REVISION DATE 20/04/2022 | REVISION C

DISCIPLINE CODE C

 DRAWING NO. U-2021-3856 WA01


PSM 191027
 E: 495937.616
 N: 7003052.339
 RL: 8.767m

LEGEND:

-  Ø150 OR Ø200 PVC-O CLASS PN16 WATERMAIN AS NOTED
-  EXISTING WATER MAIN
-  DI CL WATERMAIN
-  READY TAP HOUSE CONNECTION
-  TAPPING BAND HOUSE CONNECTION
-  HYDRANT
-  SLUICE VALVE
-  TAPER
-  TAPER/REDUCER
-  BEND
-  END CAP
-  WATER SERVICE PIPE
-  WATER SERVICE METER
-  WATER SERVICE CONDUIT 100Ø PVC-O

ENGINEER'S CERTIFICATION

I, Dan Collins, being a Certified/Registered Engineer and duly authorised representative of PEAKURBAN Pty Ltd, hereby certify the information contained in this drawing as generally an accurate "As Constructed" representation of the works.

 18631 Date: 03/08/2022
 RPEQ (Signature) RPEQ No.

For and on behalf of PEAKURBAN Pty Ltd.
 In making this certificate we have relied upon information provided by others.

REGISTERED SURVEYOR'S CERTIFICATION

I, Andrew Robert Thurston, hereby certify that the vertical and horizontal locations and dimensions shown on this plan are a true and correct record and were located by survey.

 Registered Surveyor (sig) Reg. Surveyor No. 03047 Date: 20/04/2022



COORDINATE DATUM NOTE:

HORIZONTAL COORDINATES (E,N) SUPPLIED ARE MAPPING GRID OF AUSTRALIA (MGA), ZONE 56 BASED ON THE UNIVERSAL TRANSVERSE MERCATOR PROJECTION AND THE GEOCENTRIC DATUM OF AUSTRALIA 1994.

A1

INDEX	DATE	REVISIONS	DRAWN	CHECKED	PASSED	INITIALS	DATE
C	20/04/2022	AS CONSTRUCTED - EXISTING SEQ WATER MAIN ADDED	J.Braga	A.Dahn	A.Thurston	DRAWN	JWB 20/04/2022
B	22/03/2022	AS CONSTRUCTED	J.Braga	A.Dahn	A.Thurston	CHECKED	AMD 20/04/2022
A	22/12/2021	AS CONSTRUCTED - PRELIMINARY WITH DESIGN SURFACE LEVELS	J.Braga	A.Dahn	A.Thurston	PASSED	ART 20/04/2022

WOLTER consulting group

Planning Urban Design Landscape Environment Surveying

Brisbane Level 2, 1 Breakfast Ck Road, Newstead, QLD 4006 Phone: (07) 3666 5200



Unitywater
 20190139158 - VAR01 - ACP
 Village Green Stage 6
 Peter Crossby Way, Palmview
 Water Retification

SHEET 7 OF 11 SHEETS	SCALE 250
REVISION DATE 20/04/2022	REVISION C
DISCIPLINE CODE C	
DRAWING NO.	U-2021-3856 WA02

PSM 191027
 E: 495937.616
 N: 7003052.339
 RL: 8.767m

LEGEND:

- Ø150 OR Ø200 PVC-O CLASS PN16 WATERMAIN AS NOTED
- EXISTING WATER MAIN
- DICL WATERMAIN
- READY TAP HOUSE CONNECTION
- TAPPING BAND HOUSE CONNECTION
- HYDRANT
- SLUICE VALVE
- TAPER/REDUCER
- BEND
- END CAP
- WATER SERVICE PIPE
- WATER SERVICE METER
- WATER SERVICE CONDUIT 1000 PVC-O

ENGINEER'S CERTIFICATION

I, Dan Collins, being a Certified Registered Engineer and duly authorised representative of PEAKURBAN Pty Ltd, hereby certify the information contained in this drawing as generally an accurate "As Constructed" representation of the works.

RPEQ (Signature) 18631 Date: 02/08/2022
 RPEQ No.

For and on behalf of PEAKURBAN Pty Ltd.
 In making this certificate we have relied upon information provided by others.

REGISTERED SURVEYOR'S CERTIFICATION


I, Andrew Robert Thurston, hereby certify that the vertical and horizontal locations and dimensions shown on this plan are a true and correct record and were located by survey.

Registered Surveyor (sig) Reg. Surveyor No. 03047 Date: 20/04/2022



WATER SERVICES AND METERS FOR LOTS 198-200 HAVE BEEN INSTALLED BY UNITY WATER

COORDINATE DATUM NOTE:
 HORIZONTAL COORDINATES (E,N) SUPPLIED ARE MAPPING GRID OF AUSTRALIA (MGA), ZONE 56 BASED ON THE UNIVERSAL TRANSVERSE MERCATOR PROJECTION AND THE GEOCENTRIC DATUM OF AUSTRALIA 1994.

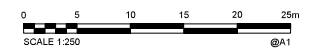

OPW21/0324 WCG-SS3787/6

A1	C	20/04/2022	AS CONSTRUCTED - EXISTING SEQ WATER MAIN ADDED	J.Braga	A.Dihn	A.Thurston	DRAWN	JWB	20/04/2022
	B	22/03/2022	AS CONSTRUCTED	J.Braga	A.Dihn	A.Thurston	CHECKED	AMD	20/04/2022
	A	22/12/2021	AS CONSTRUCTED - PRELIMINARY WITH DESIGN SURFACE LEVELS	J.Braga	A.Dihn	A.Thurston	PASSED	ART	20/04/2022
	INDEX	DATE	REVISIONS	DRAWN	CHECKED	PASSED		INITIALS	DATE

WOLTER consulting group


Planning Urban Design Landscape Environment Surveying

Brisbane Level 2, 1 Breakfast Ck Road, Newstead, QLD 4006 Phone: (07) 3666 5200



Unitywater
 20190139158 - VAR01 - ACP
 Village Green Stage 6
 Peter Crosby Way, Palmview
 Water Retification

SHEET 8 OF 11 SHEETS	SCALE 250
REVISION DATE 20/04/2022	REVISION C
DISCIPLINE CODE C	
DRAWING NO.	U-2021-3856 WA03

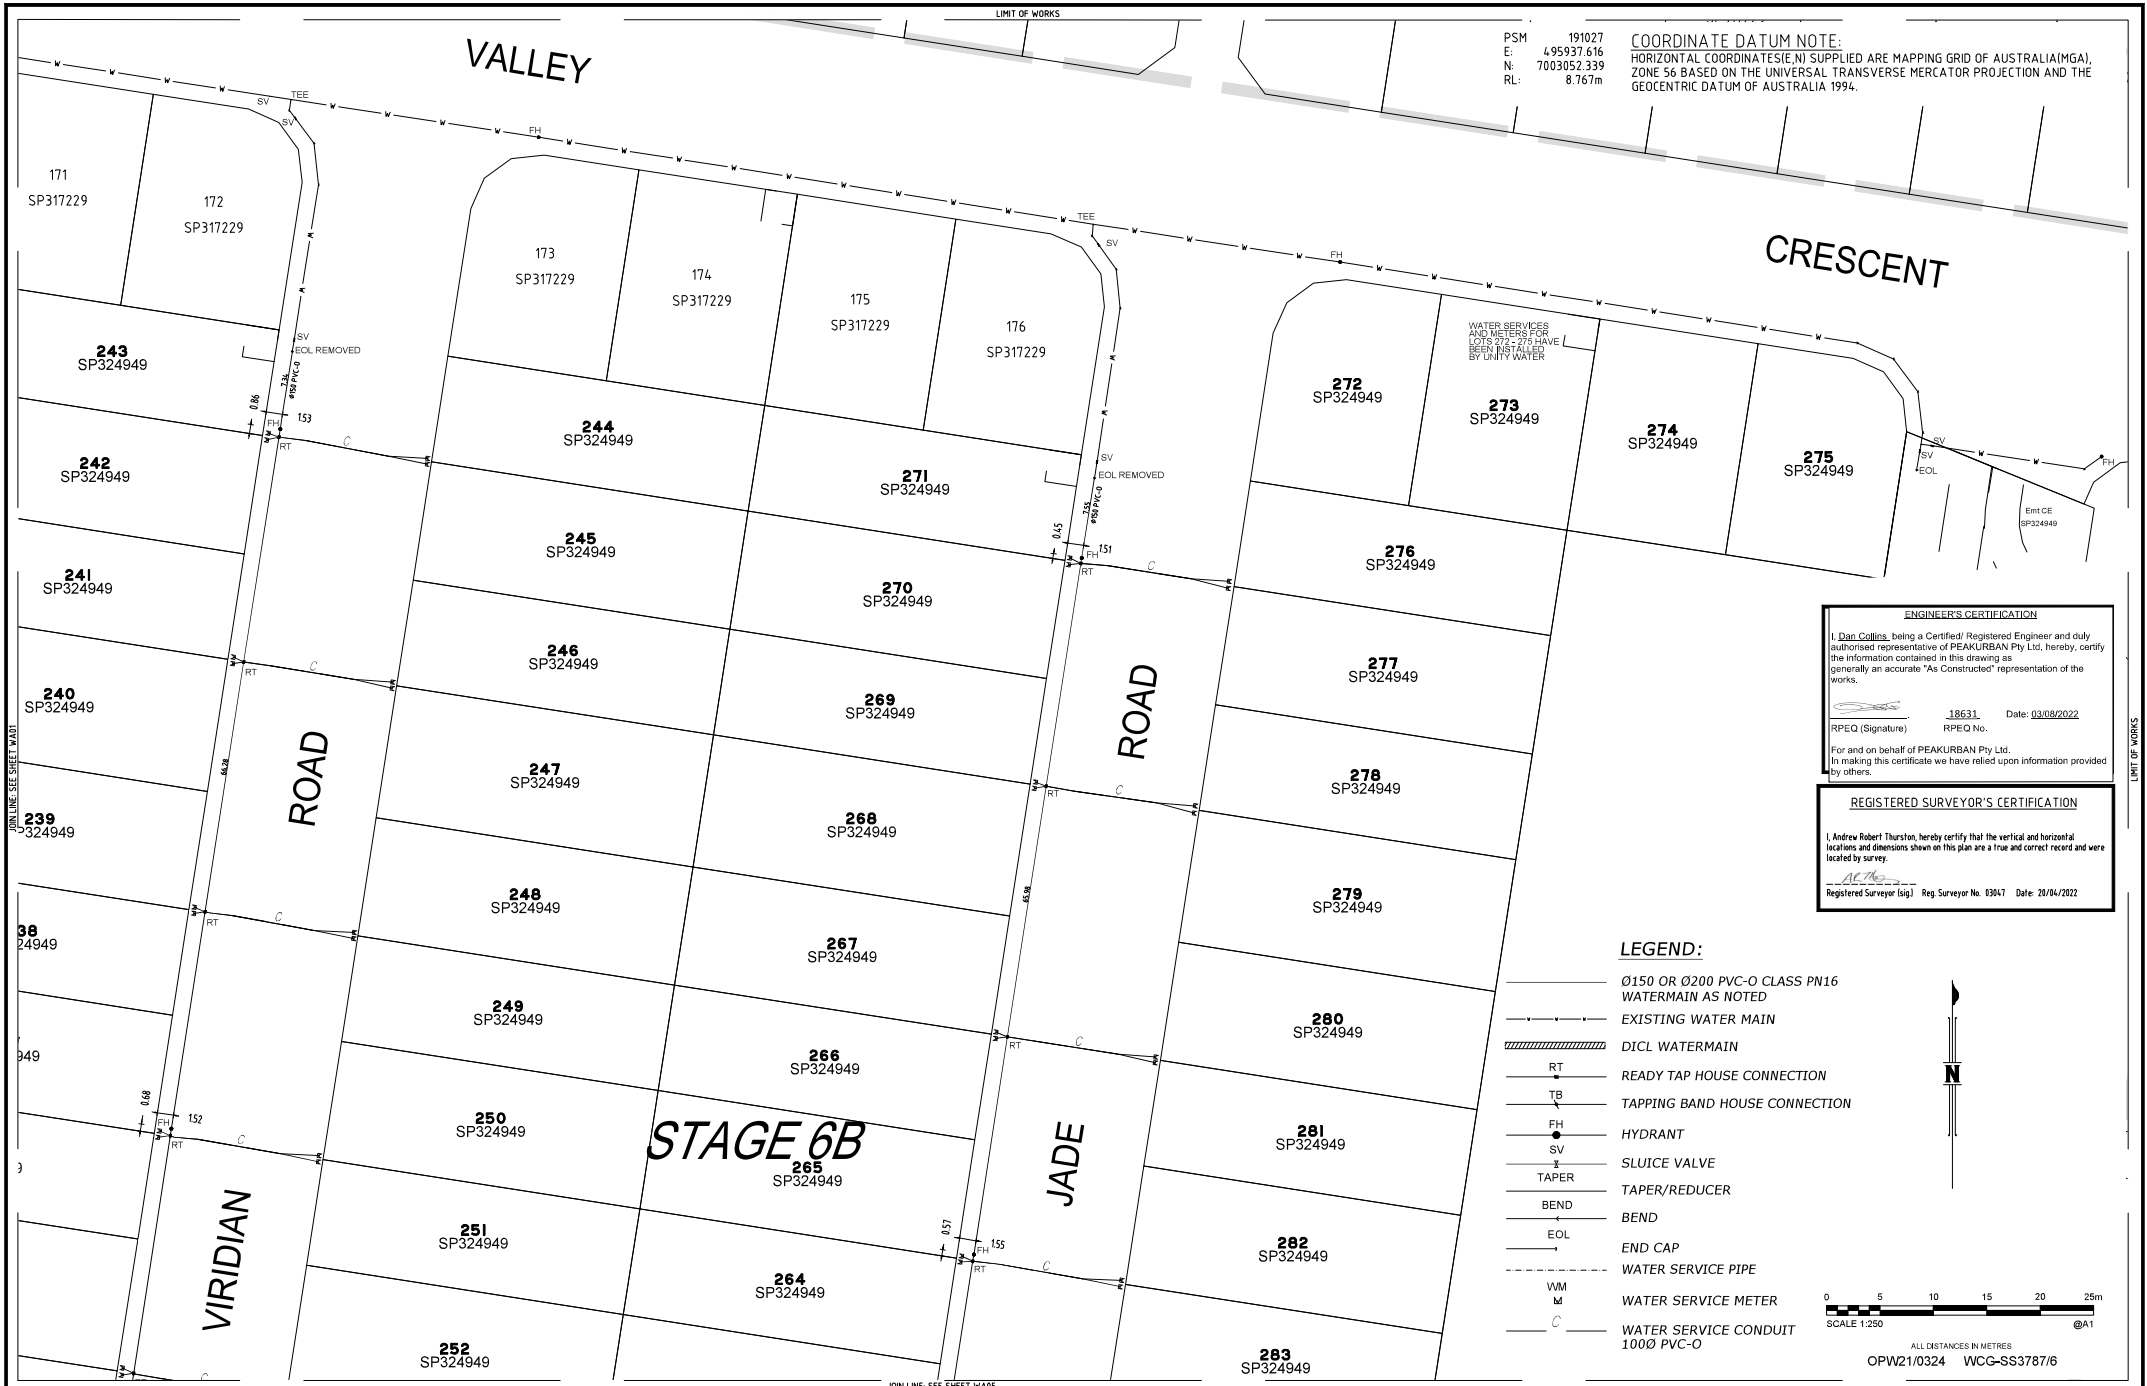

PSM 191027
 E: 4.95937 616
 N: 7003052.339
 RL: 8.767m

COORDINATE DATUM NOTE:
 HORIZONTAL COORDINATES(E,N) SUPPLIED ARE MAPPING GRID OF AUSTRALIA(MGA),
 ZONE 56 BASED ON THE UNIVERSAL TRANSVERSE MERCATOR PROJECTION AND THE
 GEOCENTRIC DATUM OF AUSTRALIA 1994.

WATER SERVICES
 AND METER PIPES
 LOTS 272-275 HAVE
 BEEN INSTALLED
 BY UNITY WATER

ENGINEER'S CERTIFICATION
 I, Dan Collins, being a Certified/Registered Engineer and duly
 authorised representative of PEAKURBAN Pty Ltd, hereby, certify
 the information contained in this drawing as
 generally an accurate "As Constructed" representation of the
 works.
 RPEQ (Signature) 18631 Date: 03/08/2022
 RPEQ No. RPEQ No.
 For and on behalf of PEAKURBAN Pty Ltd.
 In making this certificate we have relied upon information provided
 by others.

REGISTERED SURVEYOR'S CERTIFICATION
 I, Andrew Robert Thurston, hereby certify that the vertical and horizontal
 locations and dimensions shown on this plan are a true and correct record and were
 located by survey.
 Registered Surveyor (sig) Reg. Surveyor No. 63941 Date: 20/04/2022

LEGEND:

- Ø150 OR Ø200 PVC-O CLASS PN16 WATERMAIN AS NOTED
- EXISTING WATER MAIN
- ▨ DICL WATERMAIN
- RT READY TAP HOUSE CONNECTION
- TB TAPPING BAND HOUSE CONNECTION
- FH HYDRANT
- SV SLUICE VALVE
- TAPER TAPER/REDUCER
- BEND BEND
- EOL END CAP
- WATER SERVICE PIPE
- WM WATER SERVICE METER
- WATER SERVICE CONDUIT 1000 PVC-O

0 5 10 15 20 25m
 SCALE 1:250
 ALL DISTANCES IN METRES
 OPW21/0324 WCG-SS3787/6


A1	C	20/04/2022	AS CONSTRUCTED - EXISTING SEQ WATER MAIN ADDED	J.Braga	A.Dihn	A.Thurston	DRAWN	JWB	20/04/2022
	B	22/03/2022	AS CONSTRUCTED	J.Braga	A.Dihn	A.Thurston	CHECKED	AMD	20/04/2022
	A	22/12/2021	AS CONSTRUCTED - PRELIMINARY WITH DESIGN SURFACE LEVELS	J.Braga	A.Dihn	A.Thurston	PASSED	ART	20/04/2022
	INDEX	DATE	REVISIONS	DRAWN	CHECKED	PASSED	INITIALS	DATE	

WOLTER consulting group
 Planning Urban Design Landscape Environment Surveying
 Brisbane Level 2, 1 Breakfast Ck Road, Newstead, QLD 4006 Phone: (07) 3666 5200



Unitywater
 201901391158 - VAR01 - ACP
 Village Green Stage 6
 Peter Crosby Way, Palmview
 Water Retification

SHEET 9 OF 11 SHEETS	SCALE 250
REVISION DATE 20/04/2022	REVISION C
DISCIPLINE CODE C	
DRAWING NO. U-2021-3856 WA04	

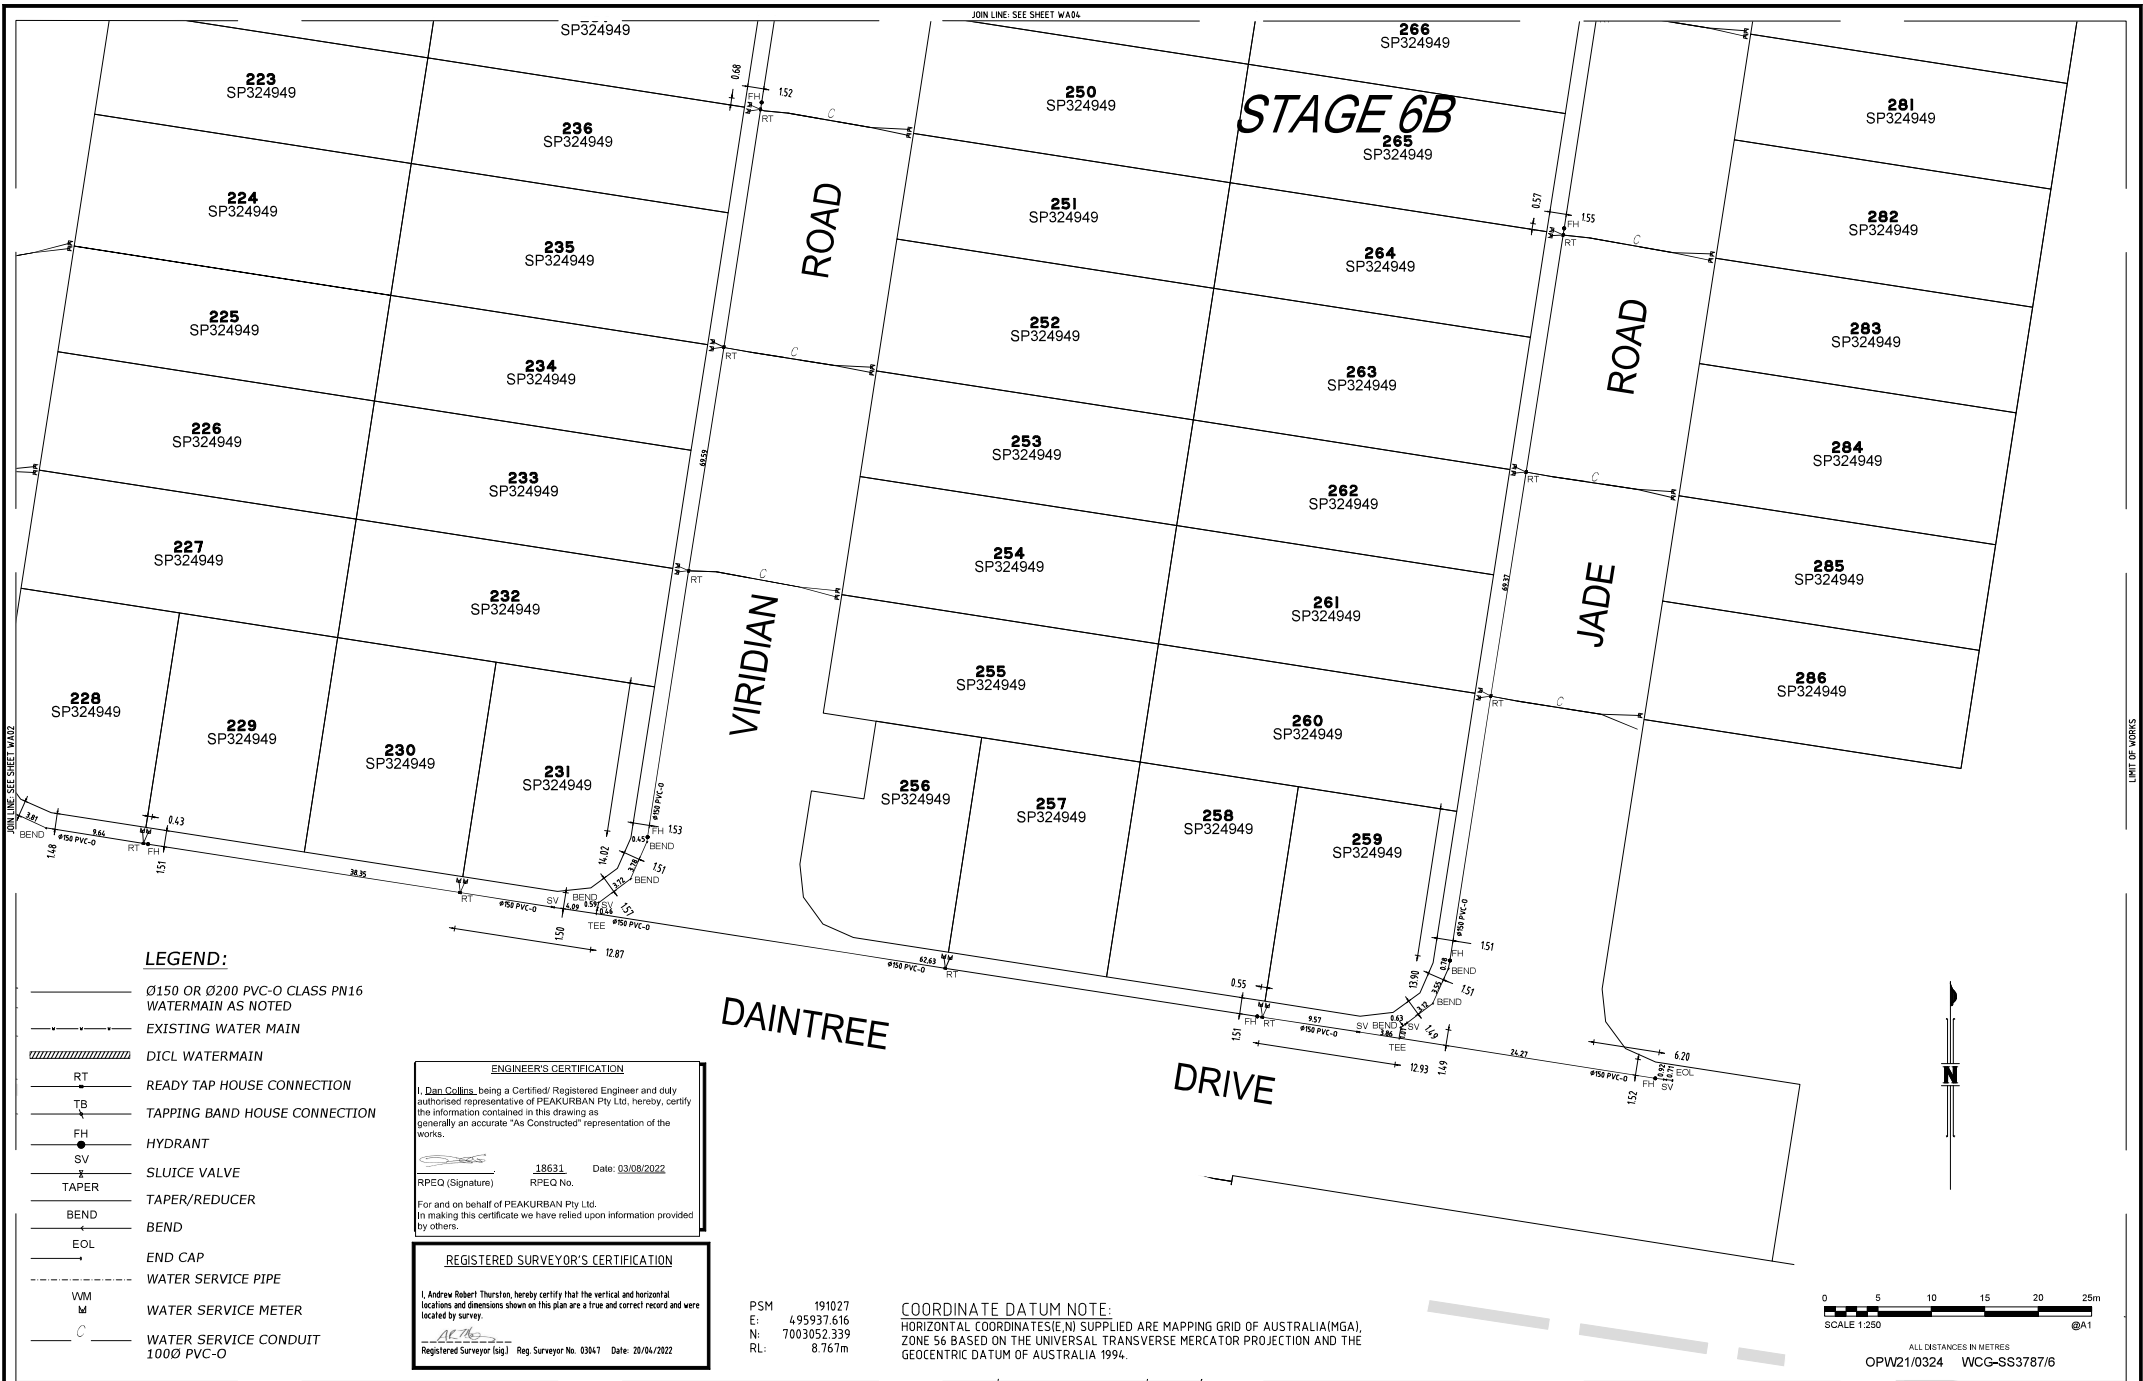

A1	C	20/04/2022	AS CONSTRUCTED - EXISTING SEQ WATER MAIN ADDED	J.Braga	A.Dihn	A.Thurston	DRAWN	JWB	20/04/2022
	B	22/03/2022	AS CONSTRUCTED	J.Braga	A.Dihn	A.Thurston	CHECKED	AMD	20/04/2022
	A	22/12/2021	AS CONSTRUCTED - PRELIMINARY WITH DESIGN SURFACE LEVELS	J.Braga	A.Dihn	A.Thurston	PASSED	ART	20/04/2022
	INDEX	DATE	REVISIONS	DRAWN	CHECKED	PASSED		INITIALS	DATE

JOIN LINE - SEE SHEET WA04

WOLTER consulting group

Planning Urban Design Landscape Environment Surveying

Brisbane Level 2, 1 Breakfast Ck Road, Newstead, QLD 4006 Phone: 071 5666 5200



Unitywater

201901391158 - VAR01 - ACP
 Village Green Stage 6
 Peter Crossby Way, Palmview
 Water Retification

SHEET 10 OF 11 SHEETS	SCALE 250
REVISION DATE 20/04/2022	REVISION C
DISCIPLINE CODE C	
DRAWING NO.	U-2021-3856 WA05



LEGEND:


- Ø150 OR Ø200 PVC-O CLASS PN16 WATERMAIN AS NOTED
- EXISTING WATER MAIN
- ▨ DICL WATERMAIN
- RT READY TAP HOUSE CONNECTION
- TB TAPPING BAND HOUSE CONNECTION
- FH HYDRANT
- SV SLUICE VALVE
- TAPER TAPER/REDUCER
- BEND BEND
- EOL END CAP
- WATER SERVICE PIPE
- WM WATER SERVICE METER
- C WATER SERVICE CONDUIT 1000 PVC-O

ENGINEER'S CERTIFICATION
 I, Dan Collins, being a Certified/Registered Engineer and duly authorised representative of PEAKURBAN Pty Ltd, hereby, certify the information contained in this drawing as generally an accurate "As Constructed" representation of the works.
 RPEQ (Signature) 18631 Date: 03/08/2022
 RPEQ No.

REGISTERED SURVEYOR'S CERTIFICATION
 I, Andrew Robert Thurston, hereby certify that the vertical and horizontal locations and dimensions shown on this plan are a true and correct record and were located by survey.
 Registered Surveyor (sig) 18631 Reg. Surveyor No. 03847 Date: 20/04/2022

PSM 191027
 E: 495937.616
 N: 700352.339
 RL: 8.767m

COORDINATE DATUM NOTE:
 HORIZONTAL COORDINATES (E, N) SUPPLIED ARE MAPPING GRID OF AUSTRALIA (MGA), ZONE 56 BASED ON THE UNIVERSAL TRANSVERSE MERCATOR PROJECTION AND THE GEODESIC DATUM OF AUSTRALIA 1994.

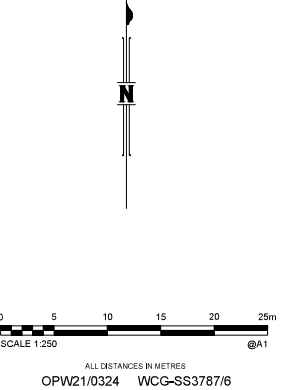

A1	C	20/04/2022	AS CONSTRUCTED - EXISTING SEQ WATER MAIN ADDED	J.Braga	A.Dihn	A.Thurston	DRAWN	JWB	20/04/2022
	B	22/03/2022	AS CONSTRUCTED	J.Braga	A.Dihn	A.Thurston	CHECKED	AMD	20/04/2022
	A	22/12/2021	AS CONSTRUCTED - PRELIMINARY WITH DESIGN SURFACE LEVELS	J.Braga	A.Dihn	A.Thurston	PASSED	ART	20/04/2022
	INDEX	DATE	REVISIONS	DRAWN	CHECKED	PASSED	INITIALS	DATE	

WOLTER consulting group
 Planning Urban Design Landscape Environment Surveying
 Brisbane: Level 2, 1 Breakfast Ck Road, Newstead, QLD 4006 Phone: (07) 5666 5200



Unitywater
 20190139158 - VAR01 - ACP
 Village Green Stage 6
 Peter Crossby Way, Palmview
 Water Retification

SHEET 11 OF 11 SHEETS	SCALE 250
REVISION DATE 20/04/2022	REVISION C
DISCIPLINE CODE C	
DRAWING NO.	U-2021-3856 WA06