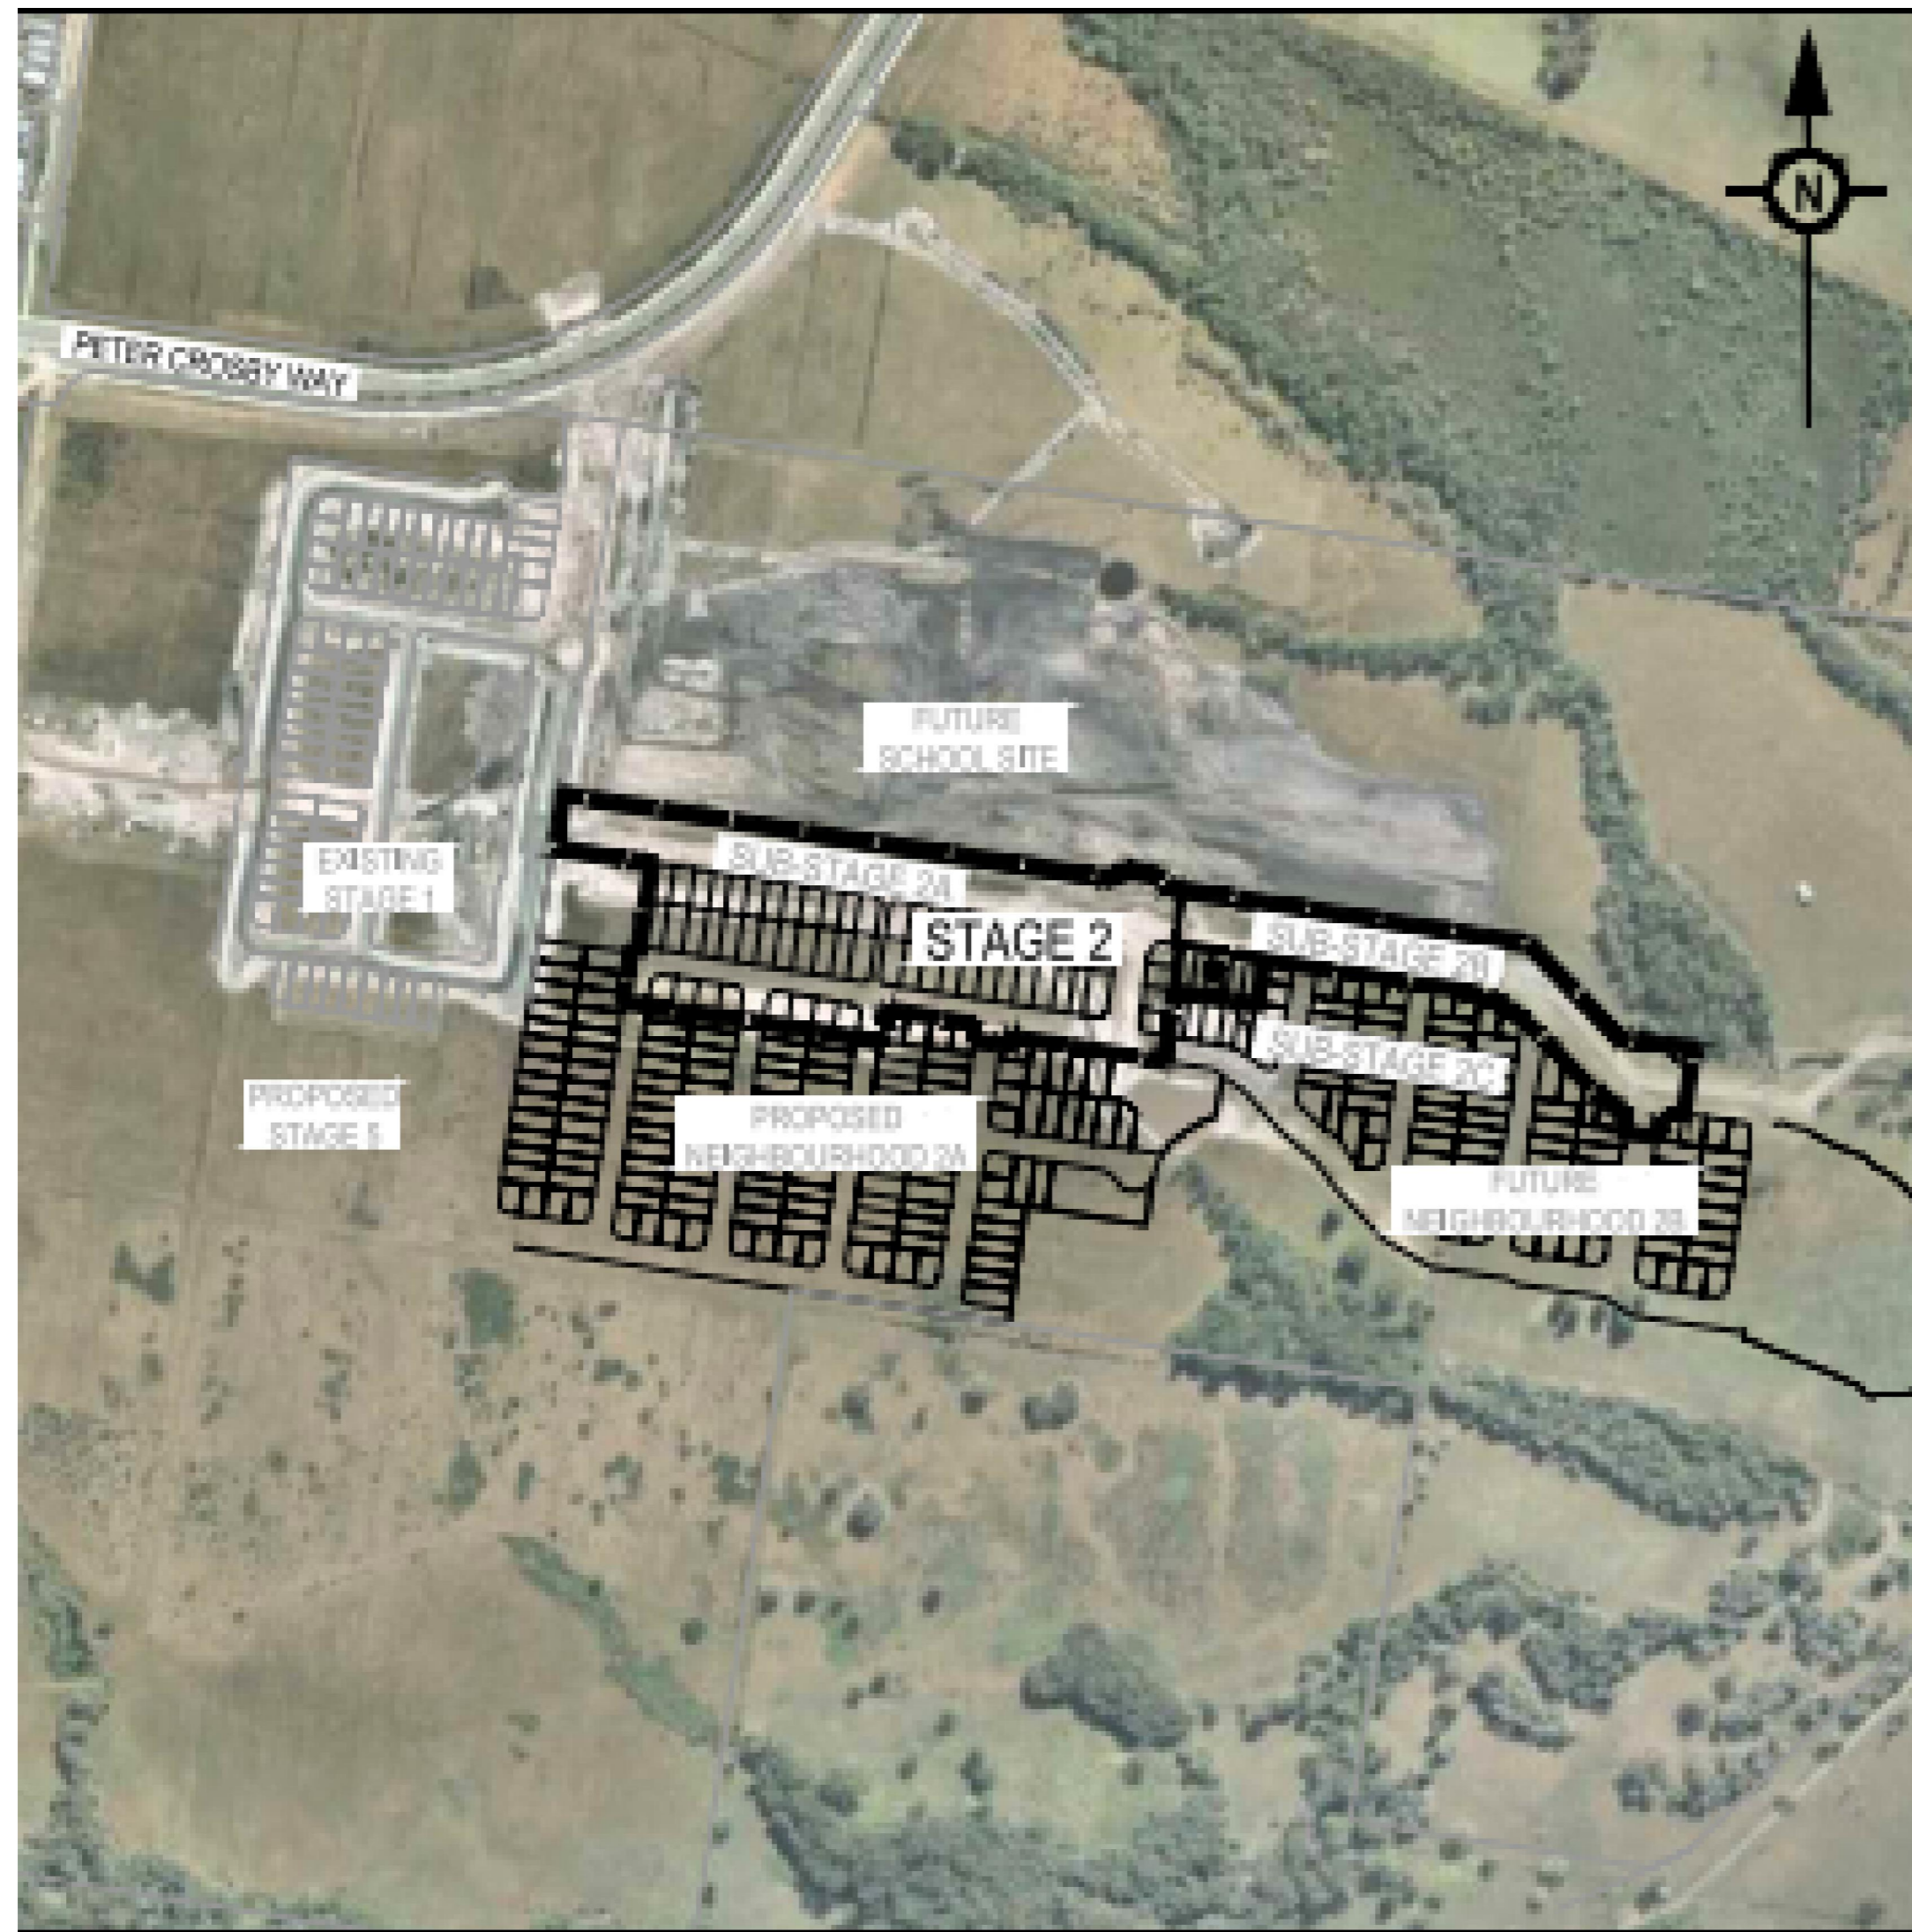



PSM 191027  
 E: 495937.616  
 N: 7003052.339  
 RL: 8.767m

# UNITYWATER PROJECT NUMBER 2019013911S6-AMD01 VILLAGE GREEN BOULEVARD, PALMVIEW U-2020-3359 SEWER/WATER MAIN



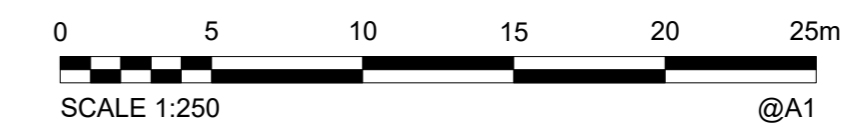DRAWING INDEX	
DRAWING NUMBER	DESCRIPTION
U-2020-3359	LOCALITY PLAN AND DRAWING INDEX
U-2020-3359 SE01	SEWER RETICULATION
U-2020-3359 SE01	SEWER RETICULATION
U-2020-3359 SE01	SEWER RETICULATION
U-2020-3359 WA01	WATER RETICULATION
U-2020-3359 WA02	WATER RETICULATION
U-2020-3359 WA03	WATER RETICULATION

**COORDINATE DATUM NOTE:**  
 HORIZONTAL COORDINATES(E,N) SUPPLIED ARE MAPPING GRID OF AUSTRALIA(MGA),  
 ZONE 56 BASED ON THE UNIVERSAL TRANSVERSE MERCATOR PROJECTION AND THE  
 GEOCENTRIC DATUM OF AUSTRALIA 1994.



<b>A1</b>										 <b>WOLTER</b> consulting group <small>Planning Urban Design Landscape Environment Surveying</small> Brisbane: Level 2, 1 Breakfast Ck Road, Newstead, QLD 4006 Phone: (07) 3666 5200	 <b>Unitywater</b>	<b>Unitywater</b> <small>2019013911S2          Village Green Stage 2A          Peter Crosby Way, Palmview          Sewer and Water Reticulation</small>	SHEET 1 OF 7 SHEETS REVISION DATE 14/10/2021 REVISION <b>A</b> DISCIPLINE CODE <b>C</b> DRAWING NO. <b>U-2020-3359</b>
	INDEX	DATE	AS CONSTRUCTED	REVISIONS	DRAWN	CHECKED	PASSED	INITIALS	DATE			DRAWN	CHECKED

PSM 201158  
 E: 506353.976  
 N: 7042428.644  
 RL: 12.944m

**LEGEND:**

- SEWER MAIN NON PRESSURE
- s — EXISTING SEWER MAIN
- HOUSE CONNECTION
- SEWER MAINTENANCE HOLE
- SEWER MAINTENANCE SHAFT
- SEWER BEND
- SEWER WYE BRANCH
- SEWER TAPER
- SEWER VALVE
- SEWER END OF LINE

**NOTE:**

- ALL SEWER MAINS DN150 PVC-U CLASS SN8 U.N.O.
- ALL MAINTENANCE HOLES (MH) 1200Ø CONCRETE INSITU U.N.O.
- ALL MAINTENANCE SHAFTS (MS) 600Ø SERVICESTREAM PE100
- SURFACE LEVELS ARE DESIGN ONLY FROM DATA PROVIDED PROJECT ENGINEER.

**ENGINEER'S CERTIFICATION**

1. I, \_\_\_\_\_, hereby certify that:
1. The information contained in this drawing / document is generally in compliance with approved drawings and design.
2. The new sewerage works defined by this drawing have been designed and constructed generally in accordance with the SEQ code.
3. This represents an accurate record of as-constructed works.
4. I accept the information contained in this drawing / document.

RPEQ (signature) RPEQ No. \_\_\_\_\_ Date: \_\_\_\_\_

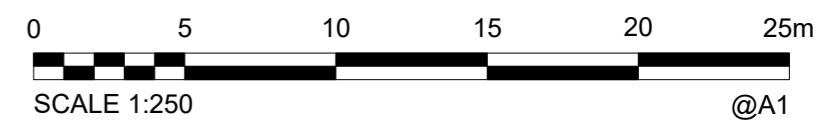
**REGISTERED SURVEYOR'S CERTIFICATION**

I, Andrew Robert Thurston, hereby certify that the vertical and horizontal locations and dimensions shown on this plan are a true and correct record and were located by survey.

*ATC*  
 Registered Surveyor (sig) Reg Surveyor No. 03047 Date: 14/10/2021

**COORDINATE DATUM NOTE:**

HORIZONTAL COORDINATES (E, N) SUPPLIED ARE MAPPING GRID OF AUSTRALIA (MGA), ZONE 56 BASED ON THE UNIVERSAL TRANSVERSE MERCATOR PROJECTION AND THE GEOCENTRIC DATUM OF AUSTRALIA 1994.



**A1**

INDEX	DATE	AS CONSTRUCTED	REVISIONS
A	14/10/2021	AS CONSTRUCTED	

DRAWN	CHECKED	PASSED	INITIALS	DATE
JWB	AMD	ART		14/10/2021
J Braga	A Dahn	A Thurston		14/10/2021

**WOLTER consulting group**  
 Planning Urban Design Landscape Environment Surveying  
 Brisbane: Level 2, 1 Breakfast Ck Road, Newstead, QLD 4006 Phone: (07) 3666 5200

**Unitywater**

**Unitywater**  
 201901391152  
 Village Green Stage 2A  
 Peter Crosby Way, Palmview  
 Sewer Reticulation

SHEET 2 OF 7 SHEETS	SCALE 250
REVISION DATE 14/10/2021	REVISION A
DISCIPLINE CODE C	
DRAWING NO. U-2020-3359 SE01	

PSM 201158  
 E: 506353.976  
 N: 7042428.644  
 RL: 12.944m

**LEGEND:**

- SEWER MAIN NON PRESSURE
- s — EXISTING SEWER MAIN
- HOUSE CONNECTION
- SEWER MAINTENANCE HOLE
- SEWER MAINTENANCE SHAFT
- SEWER BEND
- SEWER WYE BRANCH
- SEWER TAPER
- SEWER VALVE
- SEWER END OF LINE

**NOTE:**

- ALL SEWER MAINS DN150 PVC-U CLASS SN8 U.N.O.
- ALL MAINTENANCE HOLES (MH) 1200Ø CONCRETE INSTITU U.N.O.
- ALL MAINTENANCE SHAFTS (MS) 600Ø SERVICESTREAM PE100
- SURFACE LEVELS ARE DESIGN ONLY FROM DATA PROVIDED PROJECT ENGINEER.

**ENGINEER'S CERTIFICATION**

I, \_\_\_\_\_, hereby certify that:  
 1. The information contained in this drawing / document is generally in compliance with approved drawings and design.  
 2. The new sewerage works defined by this drawing have been designed and constructed generally in accordance with the SEQ code.  
 3. This represents an accurate record of as-constructed works.  
 4. I accept the information contained in this drawing / document.

RPE0 (signature) RPE0 No. \_\_\_\_\_ Date: \_\_\_\_\_

**REGISTERED SURVEYOR'S CERTIFICATION**

I, Andrew Robert Thurston, hereby certify that the vertical and horizontal locations and dimensions shown on this plan are a true and correct record and were located by survey.

ATC  
 Registered Surveyor (sig) Reg Surveyor No. 03047 Date: 14/10/2021

**COORDINATE DATUM NOTE:**

HORIZONTAL COORDINATES (E, N) SUPPLIED ARE MAPPING GRID OF AUSTRALIA (MGA), ZONE 56 BASED ON THE UNIVERSAL TRANSVERSE MERCATOR PROJECTION AND THE GEOCENTRIC DATUM OF AUSTRALIA 1994.



JOIN LINE - SEE SHEET SE01

JOIN LINE - SEE SHEET SE03

**A1**

INDEX	DATE	AS CONSTRUCTED	REVISIONS	DRAWN	CHECKED	PASSED
A	14/10/2021	AS CONSTRUCTED		J Braga	A Dahn	A Thurston

DRAWN	CHECKED	PASSED	INITIALS	DATE
JWB	AMD	ART		14/10/2021

**WOLTER consulting group**  
 Planning Urban Design Landscape Environment Surveying  
 Brisbane: Level 2, 1 Breakfast Ck Road, Newstead, QLD 4006 Phone: (07) 3666 5200



**Unitywater**  
 201901391152  
 Village Green Stage 2A  
 Peter Crosby Way, Palmview  
 Sewer Reticulation

SHEET 2 OF 7 SHEETS	SCALE 250
REVISION DATE 14/10/2021	REVISION A
DISCIPLINE CODE C	
DRAWING NO. U-2020-3359 SE02	

PSM 201158  
 E: 506353.976  
 N: 7042428.644  
 RL: 12.944m

**LEGEND:**

- SEWER MAIN NON PRESSURE
- s- EXISTING SEWER MAIN
- HOUSE CONNECTION
- SEWER MAINTENANCE HOLE
- SEWER MAINTENANCE SHAFT
- SEWER BEND
- SEWER WYE BRANCH
- SEWER TAPER
- SEWER VALVE
- SEWER END OF LINE

**NOTE:**

- ALL SEWER MAINS DN150 PVC-U CLASS SN8 U.N.O.
- ALL MAINTENANCE HOLES (MH) 1200Ø CONCRETE INSITU U.N.O.
- ALL MAINTENANCE SHAFTS (MS) 600Ø SERVICESTREAM PE100
- SURFACE LEVELS ARE DESIGN ONLY FROM DATA PROVIDED PROJECT ENGINEER.

**ENGINEER'S CERTIFICATION**

I, \_\_\_\_\_, hereby certify that:  
 1. The information contained in this drawing / document is generally in compliance with approved drawings and design.  
 2. The new sewerage works defined by this drawing have been designed and constructed generally in accordance with the SEQ code.  
 3. This represents an accurate record of as-constructed works.  
 4. I accept the information contained in this drawing / document.

RPE0 (signature) RPE0 No. \_\_\_\_\_ Date: \_\_\_\_\_

**REGISTERED SURVEYOR'S CERTIFICATION**

I, Andrew Robert Thurston, hereby certify that the vertical and horizontal locations and dimensions shown on this plan are a true and correct record and were located by survey.

Registered Surveyor (sig) Reg Surveyor No. 03047 Date: 14/10/2021

**COORDINATE DATUM NOTE:**

HORIZONTAL COORDINATES (E, N) SUPPLIED ARE MAPPING GRID OF AUSTRALIA (MGA), ZONE 56 BASED ON THE UNIVERSAL TRANSVERSE MERCATOR PROJECTION AND THE GEOCENTRIC DATUM OF AUSTRALIA 1994.



JOIN LINE SEE SHEET SE02

LIMIT OF WORKS

**A1**

INDEX	DATE	AS CONSTRUCTED	REVISIONS	DRAWN	CHECKED	PASSED
A	14/10/2021	AS CONSTRUCTED		J Braga	A Dahn	A Thurston

INITIALS	DATE
JWB	14/10/2021
AMD	14/10/2021
ART	14/10/2021

**WOLTER consulting group**  
 Planning Urban Design Landscape Environment Surveying  
 Brisbane: Level 2, 1 Breakfast Ck Road, Newstead, QLD 4006 Phone: (07) 3666 5200



**Unitywater**  
 2019013911S2  
 Village Green Stage 2A  
 Peter Crosby Way, Palmview  
 Sewer reticulation


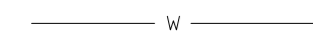
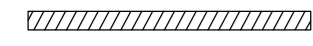
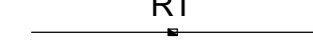
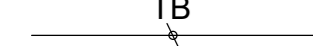

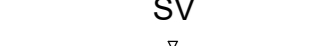






SHEET 4 OF 7 SHEETS	SCALE 250
REVISION DATE 14/10/2021	REVISION A
DISCIPLINE CODE C	
DRAWING NO. U-2020-3359 SE03	

PSM 191027  
 E: 495937.616  
 N: 7003052.339  
 RL: 8.767m

LIMIT OF WORKS



**LEGEND:**

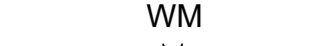-  Ø150 PVC-U CLASS PN16 WATERMAIN
-  EXISTING WATER MAIN
-  DICL WATERMAIN
-  RT  
READY TAP PROPERTY CONNECTION
-  TB  
TAPPING BAND PROPERTY CONNECTION
-  FH  
HYDRANT
-  SV  
SLUICE VALVE
-  TAPER  
TAPER/REDUCER
-  BEND  
BEND
-  EOL  
END CAP
-  WATER SERVICE PIPE
-  WM  
WATER SERVICE METER
-  C  
WATER SERVICE CONDUIT 100Ø PVC-O

**ENGINEER'S CERTIFICATION**

I, \_\_\_\_\_, hereby certify that:  
 1. The information contained in this drawing / document is generally in compliance with approved drawings and design.  
 2. The new sewerage works defined by this drawing have been designed and constructed generally in accordance with the SEQ code.  
 3. This represents an accurate record of as-constructed works.  
 4. I accept the information contained in this drawing / document.

RPEQ (signature) RPEQ No. \_\_\_\_\_ Date: \_\_\_\_\_

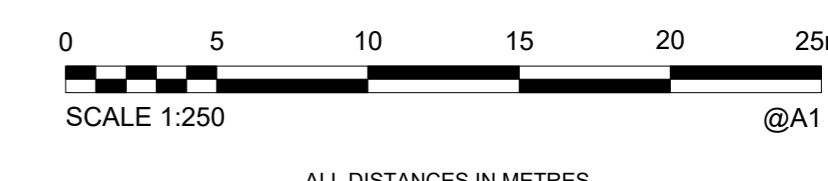
**REGISTERED SURVEYOR'S CERTIFICATION**

I, Andrew Robert Thurston, hereby certify that the vertical and horizontal locations and dimensions shown on this plan are a true and correct record and were located by survey.

*AT*  
 Registered Surveyor (sig) Reg. Surveyor No. 03047 Date: 14/10/2021

**COORDINATE DATUM NOTE:**

HORIZONTAL COORDINATES (E, N) SUPPLIED ARE MAPPING GRID OF AUSTRALIA (MGA), ZONE 56 BASED ON THE UNIVERSAL TRANSVERSE MERCATOR PROJECTION AND THE GEOCENTRIC DATUM OF AUSTRALIA 1994.



**A1**

INDEX	DATE	AS CONSTRUCTED	REVISIONS	DRAWN	CHECKED	PASSED
A	14/10/2021	AS CONSTRUCTED		J Braga	A Dahn	A Thurston

INITIALS	DATE
DRAWN	JWB 14/10/2021
CHECKED	AMD 14/10/2021
PASSED	ART 14/10/2021

**WOLTER consulting group**  
 Planning Urban Design Landscape Environment Surveying  
 Brisbane: Level 2, 1 Breakfast Ck Road, Newstead, QLD 4006 Phone: (07) 3666 5200



Unitywater  
 2019013911S2  
 Village Green Stage 2A  
 Peter Crosby Way, Palmview  
 Water Reticulation

SHEET 5 OF 7 SHEETS	SCALE 250
REVISION DATE 14/10/2021	REVISION A
DISCIPLINE CODE C	
DRAWING NO. U-2020-3359 WA01	

PSM 191027  
 E: 495937.616  
 N: 7003052.339  
 RL: 8.767m

LIMIT OF WORKS

COLLEGE

DRIVE

VALLEY

CRESCENT

JADE ROAD



**LEGEND:**

- Ø150 PVC-U CLASS PN16 WATERMAIN
- EXISTING WATER MAIN
- DICL WATERMAIN
- READY TAP PROPERTY CONNECTION
- TAPPING BAND PROPERTY CONNECTION
- HYDRANT
- SLUICE VALVE
- TAPER/REDUCER
- BEND
- END CAP
- WATER SERVICE PIPE
- WATER SERVICE METER
- WATER SERVICE CONDUIT 100Ø PVC-O

**ENGINEER'S CERTIFICATION**

1. I, \_\_\_\_\_, hereby certify that:
2. The information contained in this drawing / document is generally in compliance with approved drawings and design.
3. The new sewerage works defined by this drawing have been designed and constructed generally in accordance with the SEQ code.
4. This represents an accurate record of as-constructed works.
5. I accept the information contained in this drawing / document.

RPEQ (signature) RPEQ No. \_\_\_\_\_ Date: \_\_\_\_\_

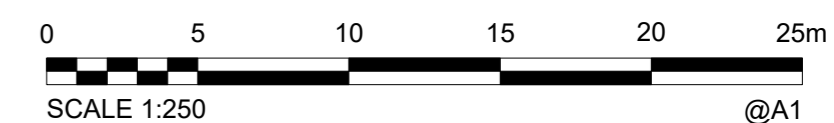
**REGISTERED SURVEYOR'S CERTIFICATION**

- I, Andrew Robert Thurston, hereby certify that the vertical and horizontal locations and dimensions shown on this plan are a true and correct record and were located by survey.

Registered Surveyor (sig) Reg. Surveyor No. 03047 Date: 14/10/2021

**COORDINATE DATUM NOTE:**

HORIZONTAL COORDINATES(E,N) SUPPLIED ARE MAPPING GRID OF AUSTRALIA(MGA), ZONE 56 BASED ON THE UNIVERSAL TRANSVERSE MERCATOR PROJECTION AND THE GEOCENTRIC DATUM OF AUSTRALIA 1994.



LIMIT OF WORKS

A1

INDEX	DATE	AS CONSTRUCTED	REVISIONS
A	14/10/2021	AS CONSTRUCTED	J Braga A Dahn A Thurston

DRAWN	CHECKED	PASSED	INITIALS	DATE
JWB	AMD	ART		14/10/2021

**WOLTER consulting group**  
 Planning Urban Design Landscape Environment Surveying  
 Brisbane: Level 2, 1 Breakfast Ck Road, Newstead, QLD 4006 Phone: (07) 3666 5200



Unitywater

2019013911S2  
 Village Green Stage 2A  
 Peter Crosby Way, Palmview  
 Water Reticulation

SHEET 6 OF 7 SHEETS	SCALE 250
REVISION DATE 14/10/2021	REVISION A
DISCIPLINE CODE C	
DRAWING NO. U-2020-3359 WA02	

PSM 191027  
 E: 495937.616  
 N: 7003052.339  
 RL: 8.767m

COLLEGE

DRIVE

3  
7229

I34  
SP317229

I35  
SP317229

I36  
SP317229

I37  
SP317229

I38  
SP317229

I39  
SP317229

I40  
SP317229

I41  
SP317229

I42  
SP317229

I43  
SP317229

I44  
SP317229

I80  
SP317229

I52  
SP317229

I51  
SP317229

I50  
SP317229

I49  
SP317229

I48  
SP317229

I47  
SP317229

I46  
SP317229

I45  
SP317229

I79  
SP317229

I78  
SP317229

I77  
SP317229

FOREST

 
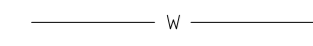
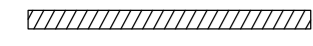
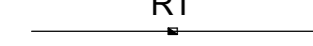
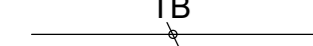

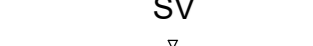






ROAD

CRESCENT

SAGE

SAGE  
CRESCENT

**LEGEND:**

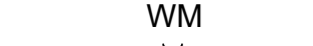-  Ø150 PVC-U CLASS PN16 WATERMAIN
-  EXISTING WATER MAIN
-  DICL WATERMAIN
-  READY TAP PROPERTY CONNECTION
-  TAPPING BAND PROPERTY CONNECTION
-  HYDRANT
-  SLUICE VALVE
-  TAPER/REDUCER
-  BEND
-  END CAP
-  WATER SERVICE PIPE
-  WATER SERVICE METER
-  WATER SERVICE CONDUIT 100Ø PVC-O

**ENGINEER'S CERTIFICATION**

I, \_\_\_\_\_, hereby certify that:  
 1. The information contained in this drawing / document is generally in compliance with approved drawings and design.  
 2. The new sewerage works defined by this drawing have been designed and constructed generally in accordance with the SEQ code.  
 3. This represents an accurate record of as-constructed works.  
 4. I accept the information contained in this drawing / document.

RPEQ (signature) RPEQ No. \_\_\_\_\_ Date: \_\_\_\_\_

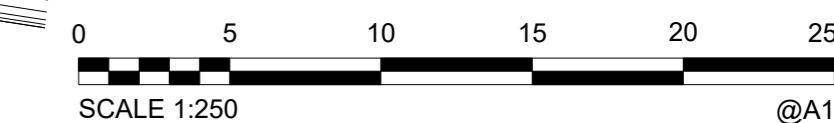
**REGISTERED SURVEYOR'S CERTIFICATION**

I, Andrew Robert Thurston, hereby certify that the vertical and horizontal locations and dimensions shown on this plan are a true and correct record and were located by survey.

Registered Surveyor (sig) Reg. Surveyor No. 03047 Date: 14/10/2021

**COORDINATE DATUM NOTE:**

HORIZONTAL COORDINATES (E, N) SUPPLIED ARE MAPPING GRID OF AUSTRALIA (MGA), ZONE 56 BASED ON THE UNIVERSAL TRANSVERSE MERCATOR PROJECTION AND THE GEOCENTRIC DATUM OF AUSTRALIA 1994.



ALL DISTANCES IN METRES

A1

INDEX	DATE	AS CONSTRUCTED	DRAWN	CHECKED	PASSED
A	14/10/2021	AS CONSTRUCTED	J Braga	A Dahn	A Thurston

INITIALS	DATE
DRAWN JWb	14/10/2021
CHECKED AMD	14/10/2021
PASSED ART	14/10/2021

**WOLTER consulting group**  
 Planning Urban Design Landscape Environment Surveying  
 Brisbane: Level 2, 1 Breakfast Ck Road, Newstead, QLD 4006 Phone: (07) 3666 5200



Unitywater

2019013911S2  
 Village Green Stage 2A  
 Peter Crosby Way, Palmview  
 Water Reticulation

SHEET 7 OF 7 SHEETS	SCALE 250
REVISION DATE 14/10/2021	REVISION A
DISCIPLINE CODE C	
DRAWING NO. U-2020-3359 WA03	