


FOR CONTINUATION REFER TO INSET BELOW RIGHT

These plans are design plans and are indicative only and parties must not make any objection, requisition or claim for compensation in relation to the plans. The final condition of lots upon completion may vary from the condition described in the plans.
The Property may have been filled, raised, levelled, compacted or cut prior to the Vendor becoming registered proprietor of the Property and the condition of the Property may change after completion of works due to circumstances beyond the Vendor's control. No warranty or representation is given or to be construed in respect of such works or changes in condition. Parties should review the plans carefully, make their own inquiries and obtain independent advice before taking any action in relation to the Property.

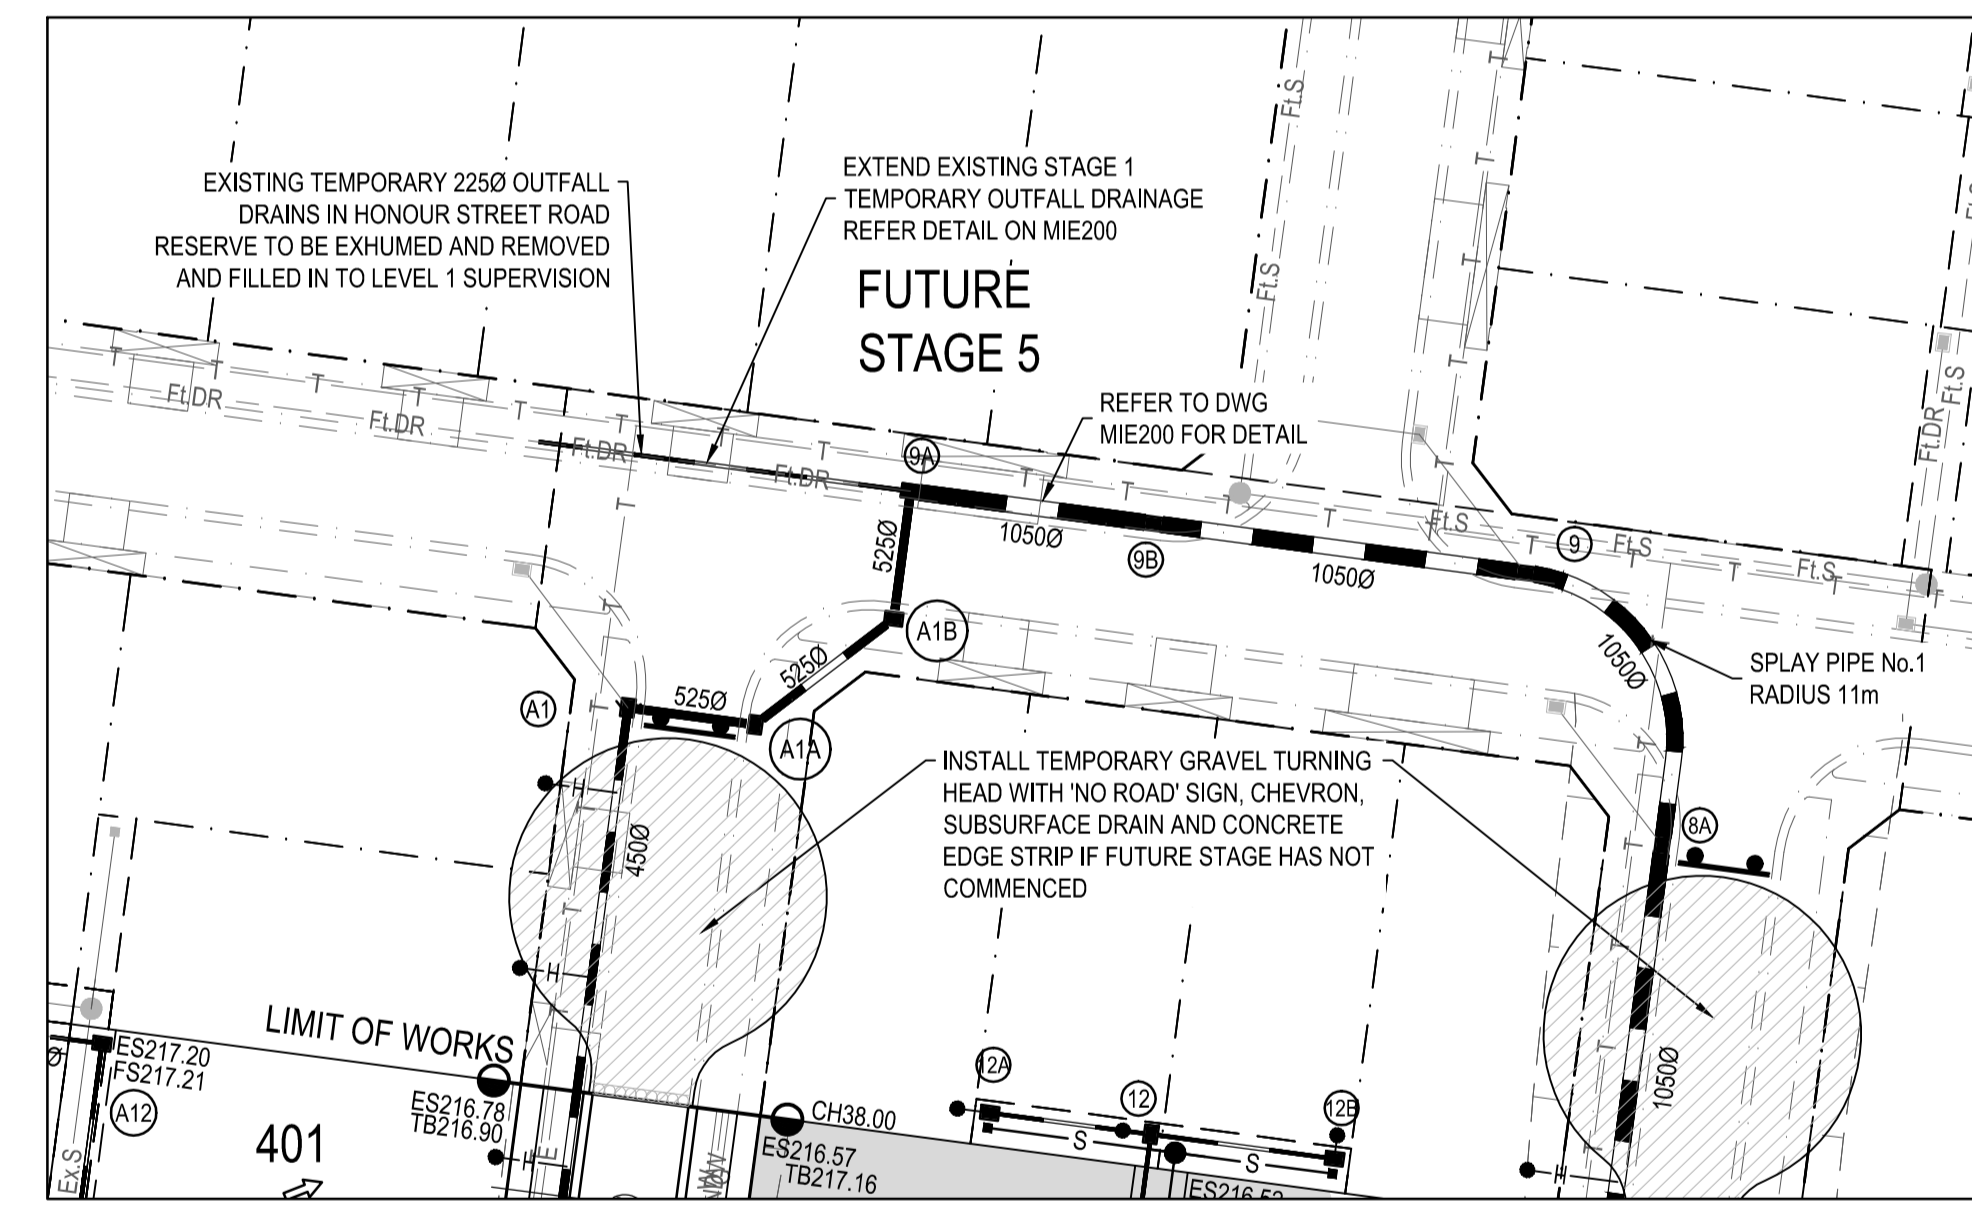



NOTE:
CAUTION REGARDING DRAINAGE TRENCH LOTS 401 TO 410. TYPE 2 SEWER BRANCHES IN PLACE FROM STAGE 1.

WARNING
PROPOSED SERVICES
THE LOCATION AND EXTENT OF PROPOSED SERVICES IS INDICATIVE ONLY AND ARE NOT TO BE USED FOR CONSTRUCTION. REFER TO AUTHORISED DOCUMENTATION BY RELEVANT AUTHORITY FOR CONSTRUCTION DETAILS

WARNING
BEWARE OF UNDERGROUND SERVICES
THE LOCATIONS OF UNDERGROUND SERVICES ARE APPROXIMATE ONLY AND THEIR EXACT POSITION SHOULD BE PROVEN ON SITE. NO GUARANTEE IS GIVEN THAT ALL EXISTING SERVICES ARE SHOWN.

STREET NAME	GAS	NON-DRINKING WATER	POTABLE WATER	TELECOM.	ELECTRICITY
GALLANTRY AVENUE	EX. 2.10N	EX. 2.50N	EX. 3.00N	0.30S	0.80S
HONOUR STREET	2.10E	2.50E	3.00N	1.85W	2.35W
FAITH ROAD	2.10E	2.50E	3.00N	1.85W	2.35W
MOXIE ROAD	2.10N	2.50N	3.00N	1.85S	2.35S
ANZACS WAY	2.10N	2.50N	3.00N	1.85S	2.35S

REV	DESCRIPTION	BY	APP	DATE
00	CONSTRUCTION ISSUE			
01	CONSTRUCTION ISSUE - P.O.S AND ROAD NAMES AMENDED	BHJ	MB	06.10.11
02	CONSTRUCTION ISSUE - DRIVEWAYS ADDED TO LANEWAY	MG	MB	14.12.11
03	CONSTRUCTION ISSUE - POS AMENDED FOR ADDITIONAL LOT 447	AJB	MB	12.01.12
04	CONSTRUCTION ISSUE - POS AMENDED FOR SUPER LOT A	MG	MB	10.02.12
05	AS CONSTRUCTED ISSUE	AJB	MH	03.10.12

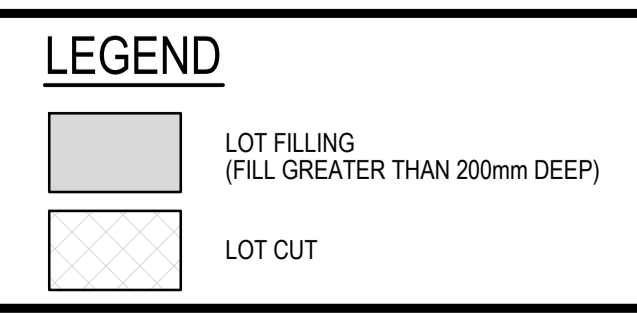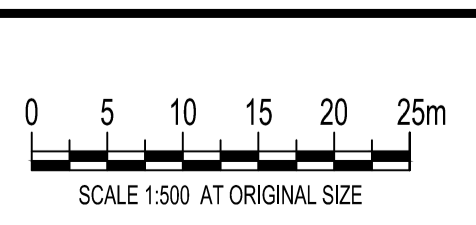

PEET

aston
www.craigieburn

MEINHARDT
INFRASTRUCTURE & ENVIRONMENT

L12, 501 Swanston Street, Melbourne, VIC, Australia 3000
 Telephone: (03) 8676 1200
 Fax: (03) 8676 1201
 www.meinhardtgroup.com
 A.C.N. 100 988 979
 © Copyright

CLIENT **PEET LTD**
 DESIGNED **MG** DRAWN **MG** APPROVED **MB** SCALE @ A1
 STATUS **AS CONSTRUCTED**

PROJECT **ASTON ESTATE STAGE 4 HUME CITY COUNCIL**
 TITLE **DETAIL PLAN**
 PROJECT No **102419-04 MIE100** DRAWING No **05**

