

PSM191027  
 E: 495937.616  
 N: 7003052.339  
 RL: 8.767m



# UNITYWATER PROJECT NUMBER U-2022-4273

## DAINTREE DRIVE, PALMVIEW

### DN150/DN100-DN150 SEWER/WATER MAIN



DRAWING INDEX	
DRAWING NUMBER	DESCRIPTION
U-2022-4273-S1	LOCALITY PLAN AND DRAWING INDEX
U-2022-4273-S2	SEWER RETICULATION
U-2022-4273-S3	SEWER RETICULATION
U-2022-4273-S4	WATER RETICULATION
U-2022-4273-S5	WATER RETICULATION

**COORDINATE DATUM NOTE:**  
 HORIZONTAL COORDINATES(E,N) SUPPLIED ARE MAPPING GRID OF AUSTRALIA(MGA), ZONE 56 BASED ON THE UNIVERSAL TRANSVERSE MERCATOR PROJECTION AND THE GEOCENTRIC DATUM OF AUSTRALIA 1994.

**ENGINEER'S CERTIFICATION**

I, \_\_\_\_\_, hereby certify that:

- The information contained in this drawing / document is in compliance with approved drawings and design.
- The new water and sewerage works defined by this drawing have been designed and constructed in accordance with the SEQ Code.
- This represents an accurate record of as-constructed works
- I accept responsibility for the information contained in this drawing / document.

\_\_\_\_\_  
 RPEQ (signature) RPEQ No. \_\_\_\_\_ Date: \_\_\_\_\_

**REGISTERED SURVEYOR'S CERTIFICATION**

I, ANDREW ROBERT THURSTON, hereby certify that the vertical and horizontal locations and dimensions shown on this plan are a true and correct record and were located by survey.

*AL*  
 Registered Surveyor (sig) Reg. Surveyor No. 03047 Date: 03.05.2023

**AS CONSTRUCTED**

<b>A1</b>											
	INDEX	DATE	REVISIONS	DRAWN	CHECKED	PASSED	INITIALS	DATE	DRAWN	CHECKED	PASSED
	A	03.05.2023	AS CONSTRUCTED	JC	AD	AT	JC	03.05.2023			

**WOLTER**  
consulting group

Planning Urban Design Landscape Environment Surveying  
 Brisbane: Level 2, 1 Breakfast Ck Road, Newstead, QLD 4006 Phone: (07) 3666 5200

**Unitywater**

201901391159  
 VILLAGE GREEN STAGE 7A & 7B  
 PALMVIEW, QLD  
 SEWER AS CONSTRUCTED

SHEET 1 OF 5 SHEETS	SCALE NA
REVISION DATE 03-05-2022	REVISION A
DISCIPLINE CODE C	
DRAWING NO. U-2022-4273	

PSM191027  
 E: 495937.616  
 N: 7003052.339  
 RL: 8.767m

**ENGINEER'S CERTIFICATION**

I, \_\_\_\_\_, hereby certify that:


- The information contained in this drawing / document is in compliance with approved drawings and design.
- The new water and sewerage works defined by this drawing have been designed and constructed in accordance with the SEQ Code.
- This represents an accurate record of as-constructed works.
- I accept responsibility for the information contained in this drawing / document.

RPEQ (signature) RPEQ No. \_\_\_\_\_ Date: \_\_\_\_\_

**REGISTERED SURVEYOR'S CERTIFICATION**

I, ANDREW ROBERT THURSTON, hereby certify that the vertical and horizontal locations and dimensions shown on this plan are a true and correct record and were located by survey.

*Andrew Thurston*  
 Registered Surveyor (sig) Reg. Surveyor No. 03047 Date: 03.05.2023

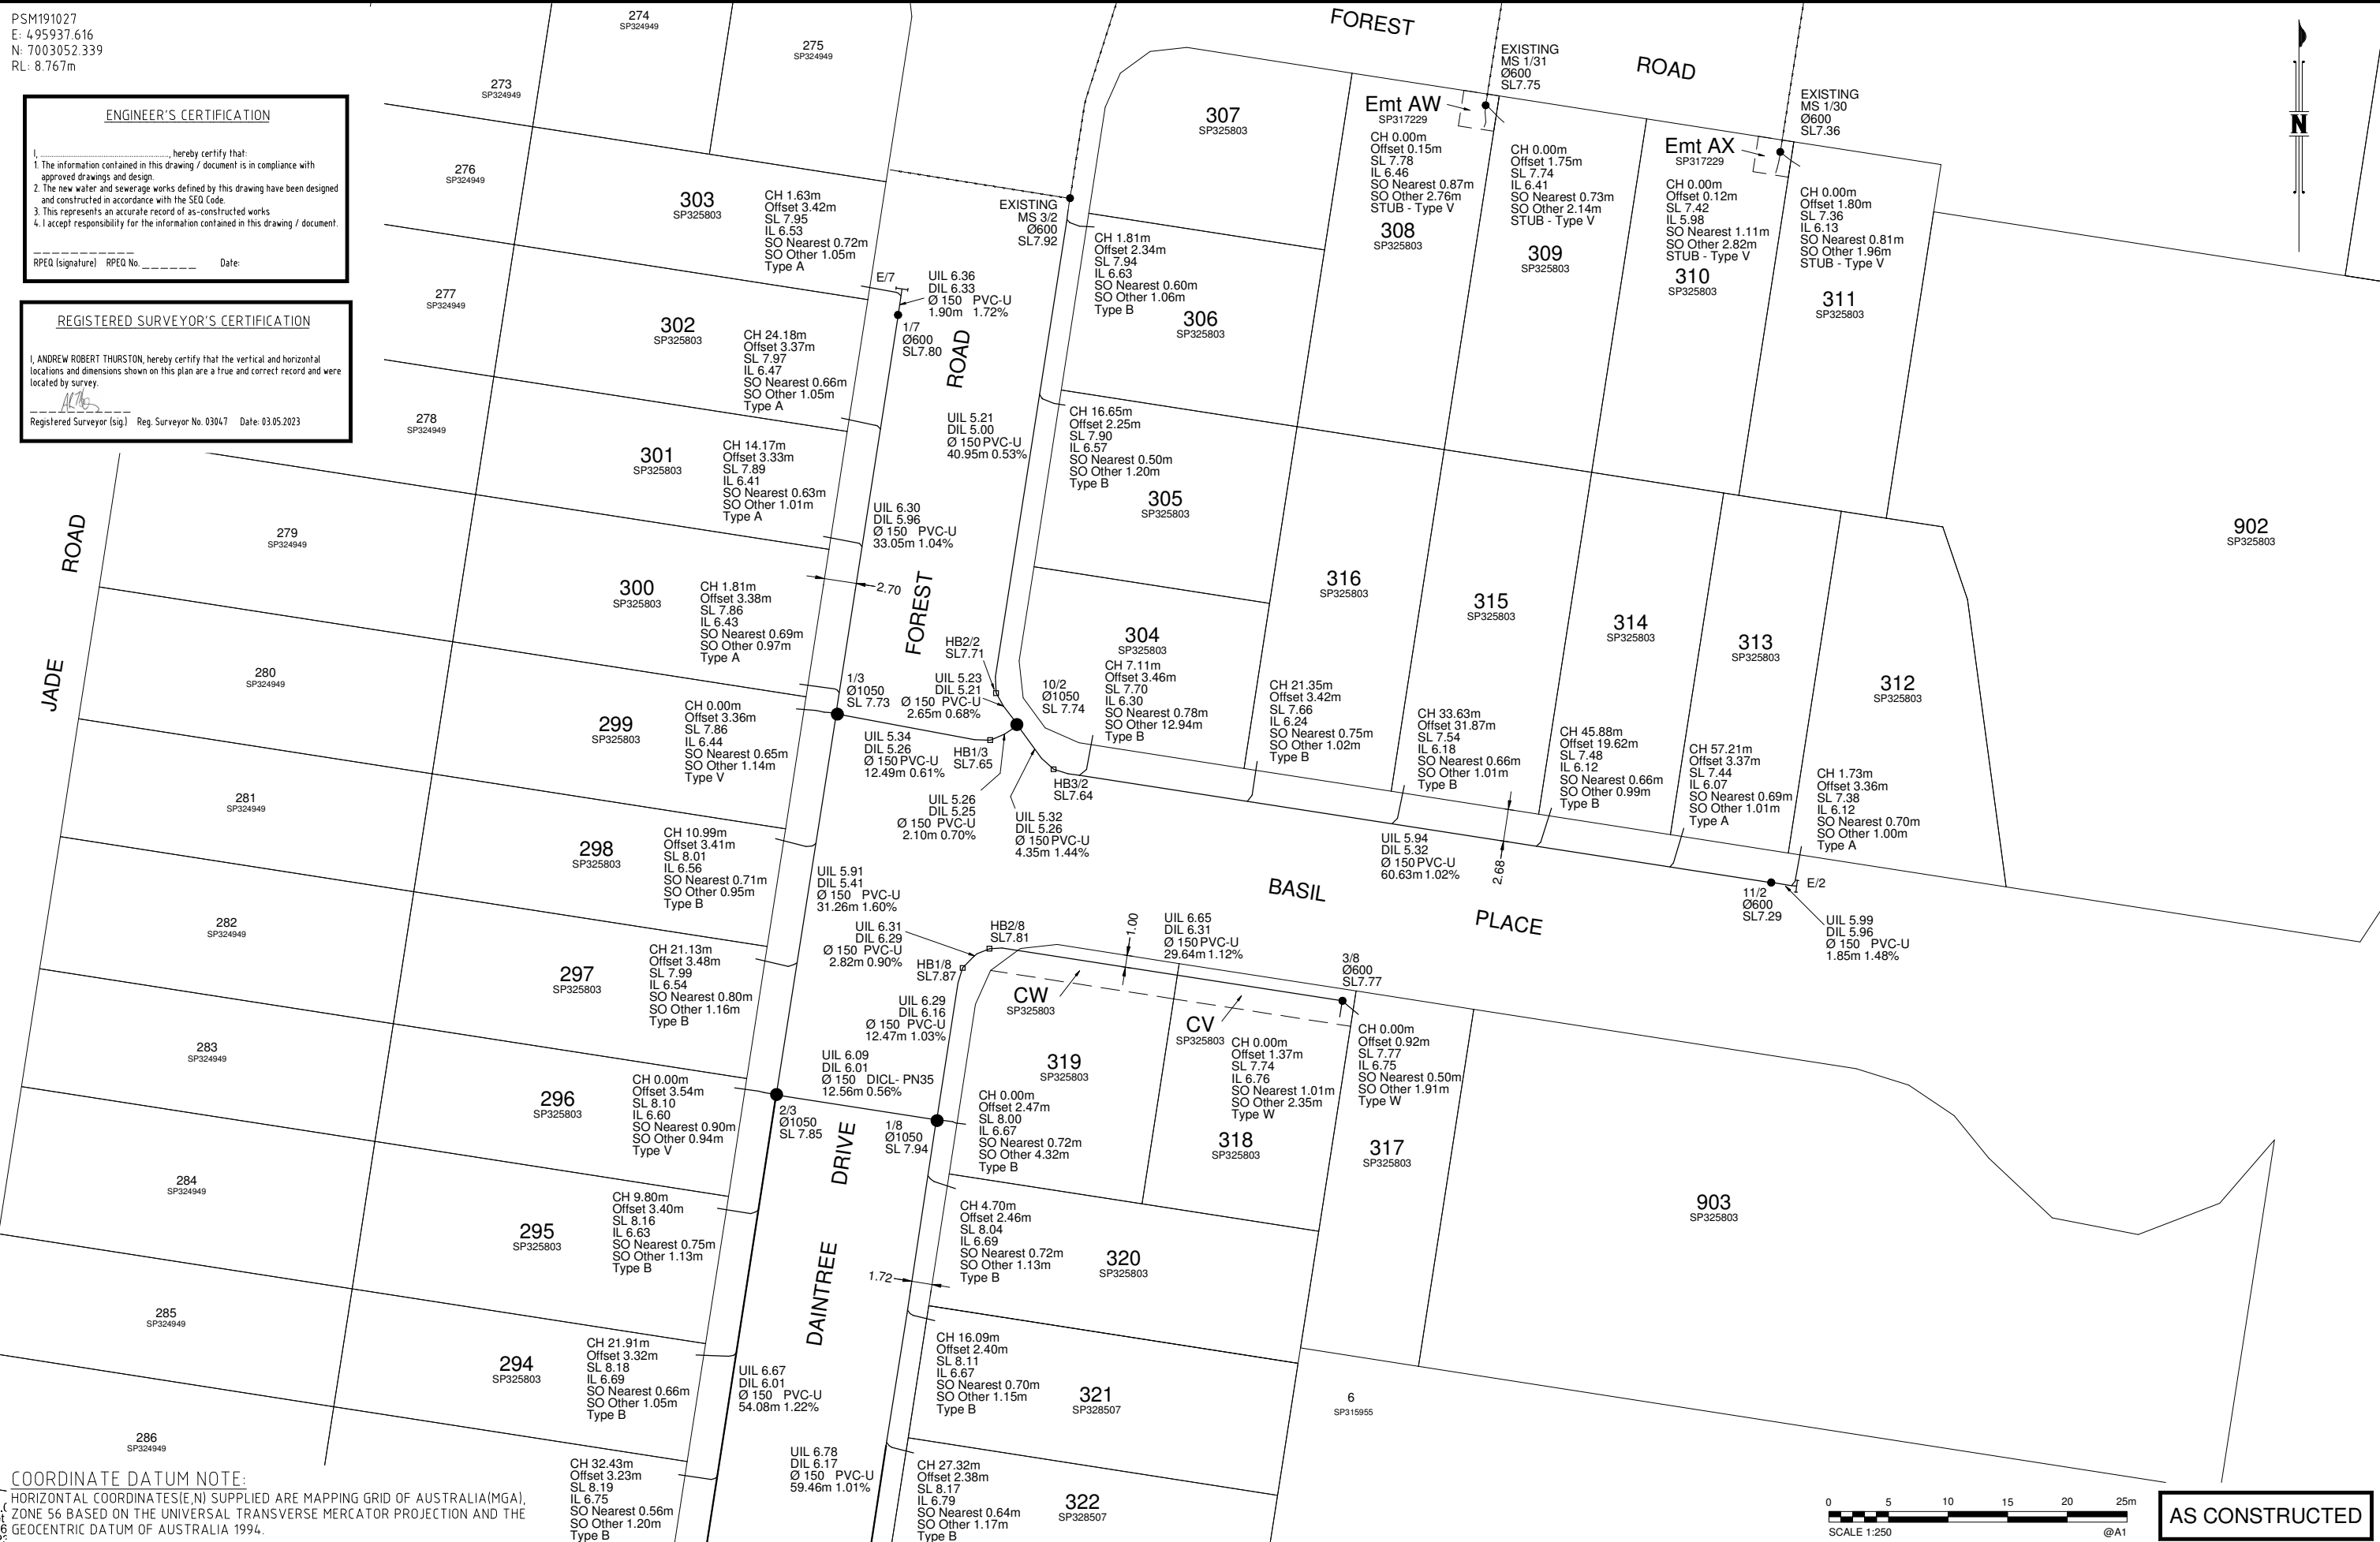

**COORDINATE DATUM NOTE:**  
 HORIZONTAL COORDINATES (E,N) SUPPLIED ARE MAPPING GRID OF AUSTRALIA (MGA), ZONE 56 BASED ON THE UNIVERSAL TRANSVERSE MERCATOR PROJECTION AND THE GEOCENTRIC DATUM OF AUSTRALIA 1994.

**AS CONSTRUCTED**

A1	INDEX	DATE	REVISIONS	DRAWN	CHECKED	PASSED	INITIALS	DATE
	A	03.05.2023	AS CONSTRUCTED	JC	AD	AT		

**WOLTER consulting group**

Planning Urban Design Landscape Environment Surveying

Brisbane Level 2, 1 Breakfast Ck Road, Newstead, QLD 4006 Phone: (07) 3666 5200



**Unitywater**

2019013911S9  
 VILLAGE GREEN STAGE 7A & 7B  
 PALMVIEW, QLD  
 SEWER AS CONSTRUCTED

SHEET 2 OF 5 SHEETS	SCALE 1:250
REVISION DATE 03.05.2023	REVISION A
DISCIPLINE CODE C	
DRAWING NO. U-2022-4273	

PSM191027  
 E: 495937.616  
 N: 7003052.339  
 RL: 8.767m

**ENGINEER'S CERTIFICATION**


- I, \_\_\_\_\_, hereby certify that:
- The information contained in this drawing / document is in compliance with approved drawings and design.
  - The new water and sewerage works defined by this drawing have been designed and constructed in accordance with the SEQ Code.
  - This represents an accurate record of as-constructed works.
  - I accept responsibility for the information contained in this drawing / document.

RPEQ (signature) RPEQ No. \_\_\_\_\_ Date: \_\_\_\_\_

**REGISTERED SURVEYOR'S CERTIFICATION**

I, ANDREW ROBERT THURSTON, hereby certify that the vertical and horizontal locations and dimensions shown on this plan are a true and correct record and were located by survey.

Registered Surveyor (sig) Reg. Surveyor No. 03047 Date: 03.05.2023

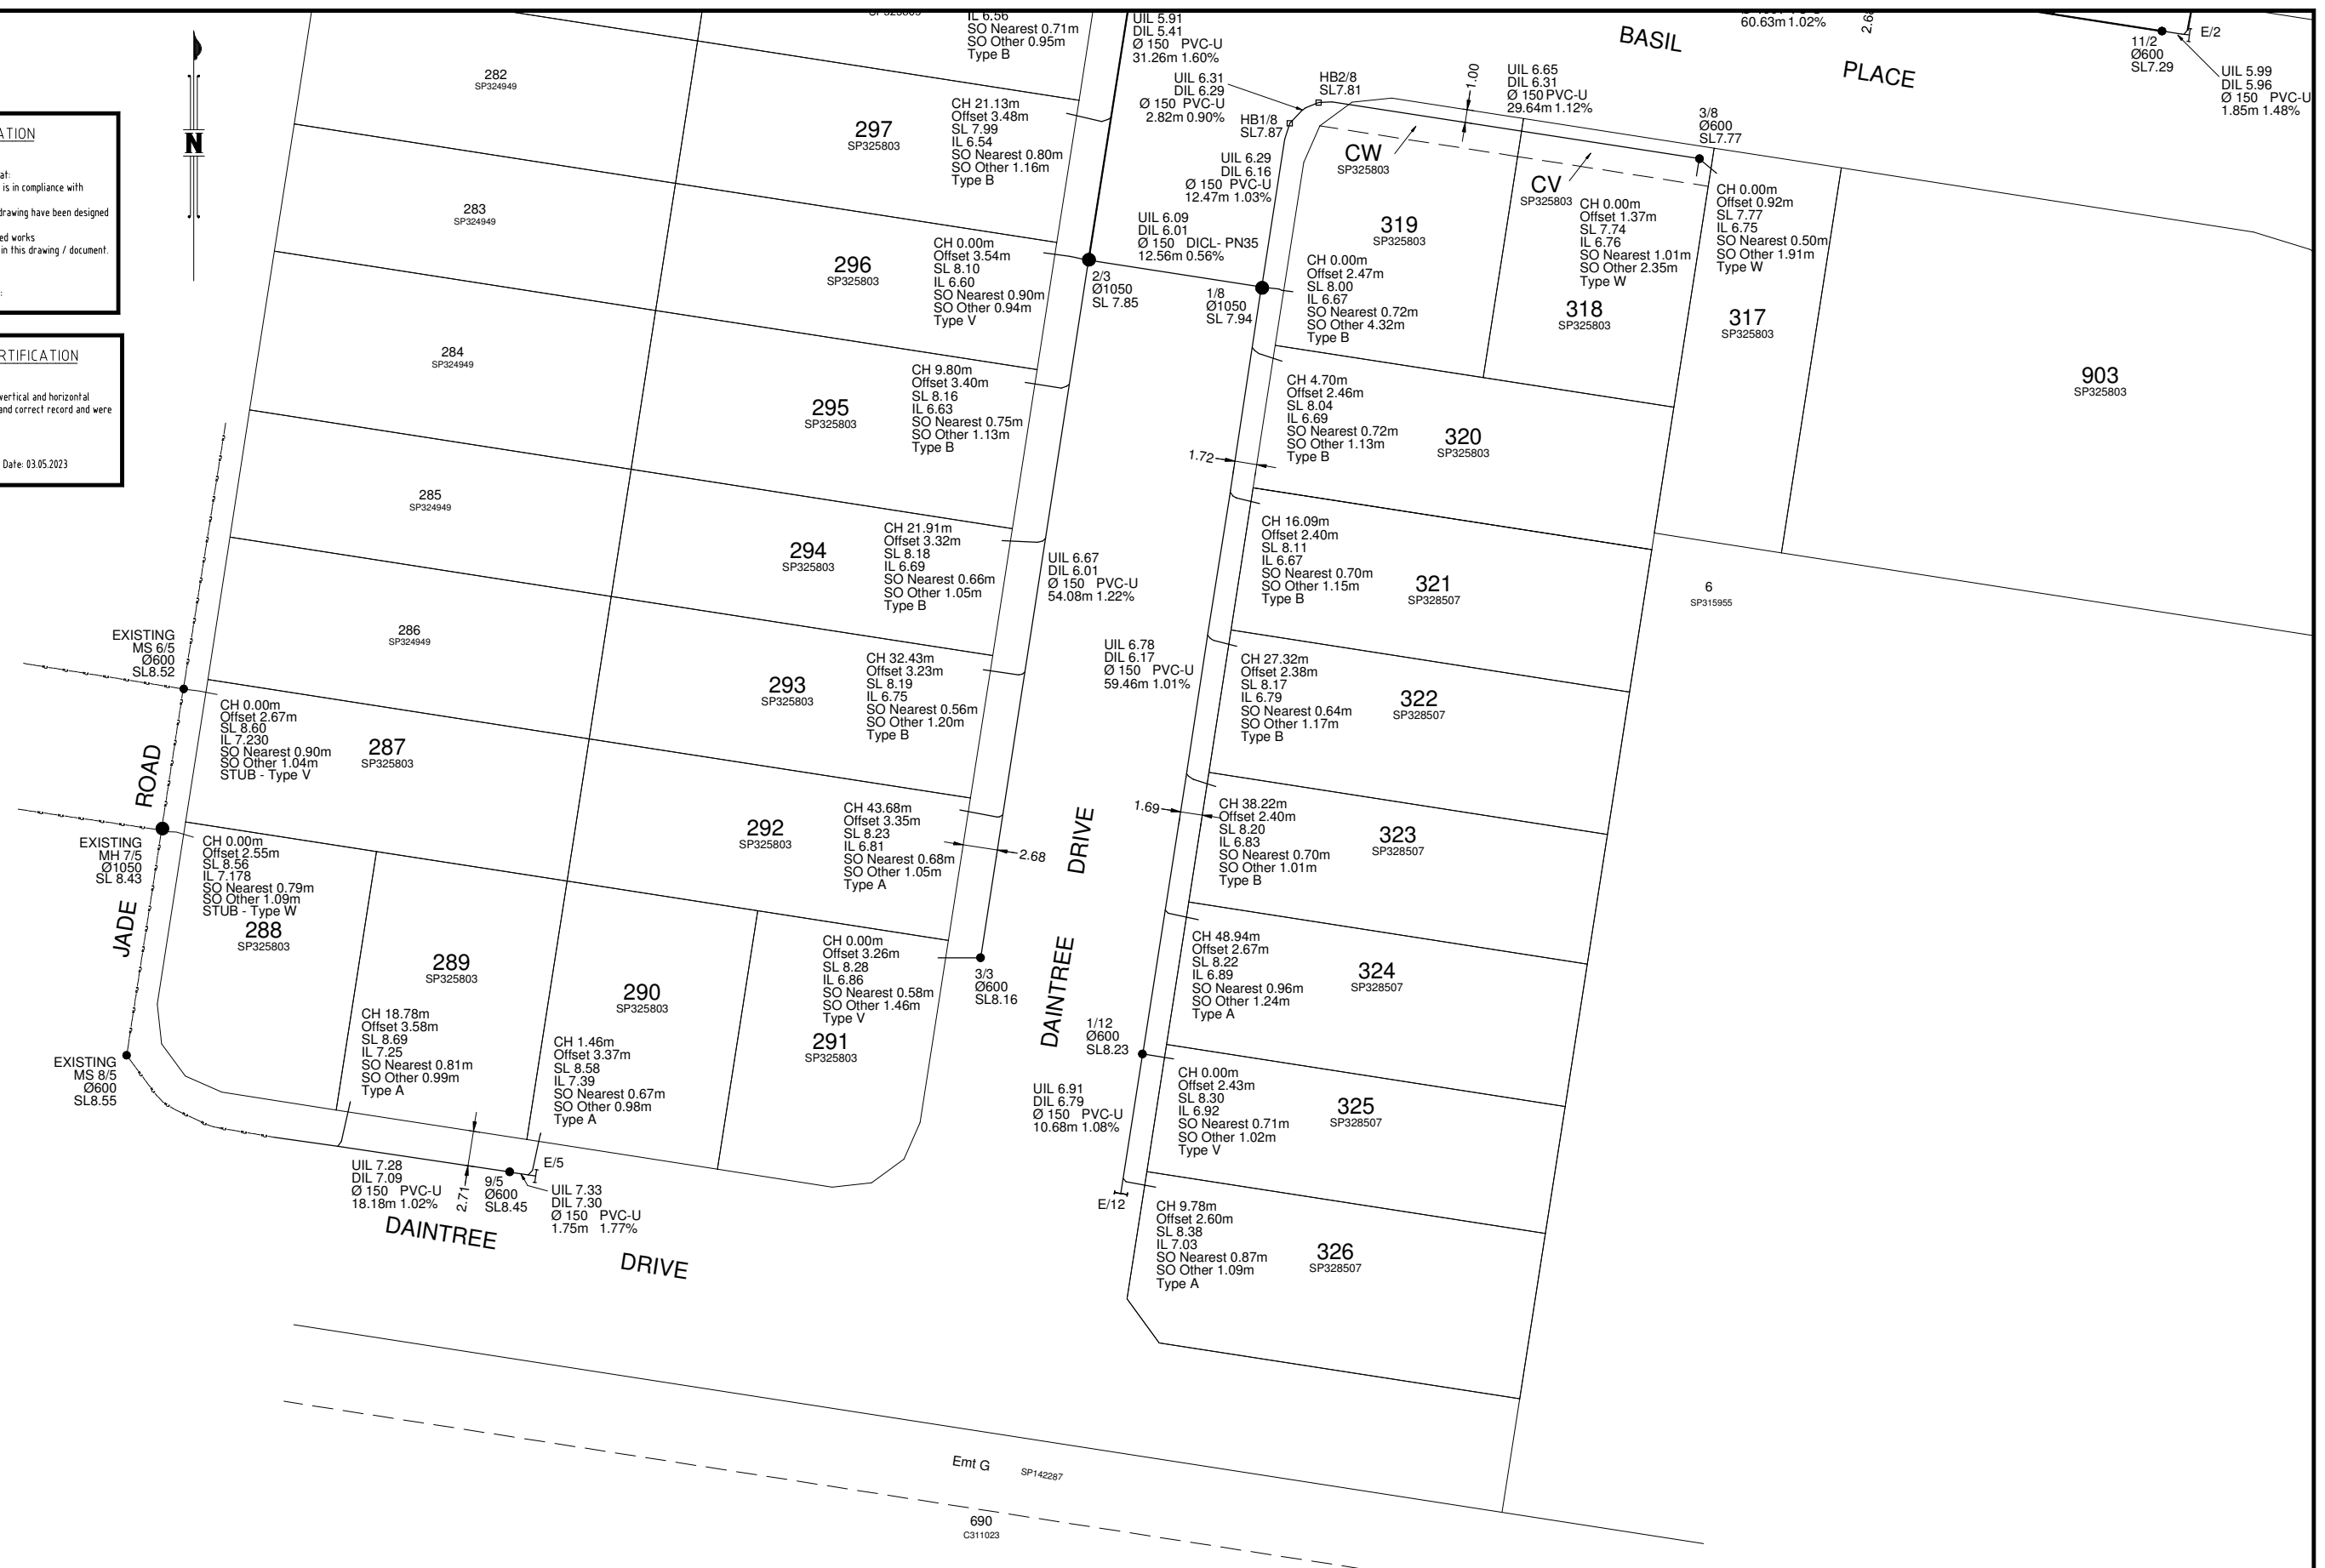

**COORDINATE DATUM NOTE:**  
 HORIZONTAL COORDINATES (E,N) SUPPLIED ARE MAPPING GRID OF AUSTRALIA (MGA), ZONE 56 BASED ON THE UNIVERSAL TRANSVERSE MERCATOR PROJECTION AND THE GEOCENTRIC DATUM OF AUSTRALIA 1994.



**AS CONSTRUCTED**

<b>A1</b>	INDEX	DATE	REVISIONS	DRAWN	CHECKED	PASSED	INITIALS	DATE
	A	03.05.2023	AS CONSTRUCTED	JC	AD	AT		

**WOLTER consulting group**  
 Planning Urban Design Landscape Environment Surveying  
 Brisbane Level 2, 1 Breakfast Ck Road, Newstead, QLD 4006 Phone: (07) 3666 5200



**Unitywater**  
 2019013911S9  
 VILLAGE GREEN STAGE 7A & 7B  
 PALMVIEW, QLD  
 SEWER AS CONSTRUCTED

SHEET 3 OF 5 SHEETS	SCALE 1:250
REVISION DATE 03.05.2023	REVISION A
DISCIPLINE CODE C	
DRAWING NO. U-2022-4273	


PSM191027  
 E: 495937.616  
 N: 7003052.339  
 RL: 8.767m

**ENGINEER'S CERTIFICATION**  
 I, \_\_\_\_\_, hereby certify that:  
 1. The information contained in this drawing / document is in compliance with approved drawings and design.  
 2. The new water and sewerage works defined by this drawing have been designed and constructed in accordance with the SEQ Code.  
 3. This represents an accurate record of as-constructed works.  
 4. I accept responsibility for the information contained in this drawing / document.  
 RPEQ (signature) RPEQ No. \_\_\_\_\_ Date: \_\_\_\_\_

**REGISTERED SURVEYOR'S CERTIFICATION**  
 I, ANDREW ROBERT THURSTON, hereby certify that the vertical and horizontal locations and dimensions shown on this plan are a true and correct record and were located by survey.  
 Registered Surveyor (sig.) Reg. Surveyor No. 03047 Date: 03.05.2023



**COORDINATE DATUM NOTE:**  
 HORIZONTAL COORDINATES(E,N) SUPPLIED ARE MAPPING GRID OF AUSTRALIA(MGA), ZONE 56 BASED ON THE UNIVERSAL TRANSVERSE MERCATOR PROJECTION AND THE GEOCENTRIC DATUM OF AUSTRALIA 1994.

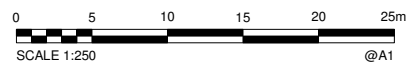

**AS CONSTRUCTED**

<b>A1</b>									
	A	03.05.2023	AS CONSTRUCTED	JC	AD	AT			
INDEX	DATE	REVISIONS	DRAWN	CHECKED	PASSED	INITIALS	DATE		

DRAWN	JC	03.05.2023
CHECKED	AD	03.05.2023
PASSED	AT	03.05.2023

**WOLTER consulting group**  
 Planning Urban Design Landscape Environment Surveying  
 Brisbane: Level 2, 1 Breakfast Ck Road, Newstead, QLD 4006 Phone: (07) 3666 5200



**Unitywater**  
 2019013911S9  
 VILLAGE GREEN STAGE 7A & 7B  
 PALMVIEW, QLD  
 WATER AS CONSTRUCTED

SHEET 4 OF 5 SHEETS	SCALE 1:250
REVISION DATE 03.05.2023	REVISION A
DISCIPLINE CODE C	
DRAWING NO. U-2022-4273	

PSM191027  
 E: 495937.616  
 N: 7003052.339  
 RL: 8.767m

**ENGINEER'S CERTIFICATION**


I, \_\_\_\_\_, hereby certify that:  
 1. The information contained in this drawing / document is in compliance with approved drawings and design.  
 2. The new water and sewerage works defined by this drawing have been designed and constructed in accordance with the SEQ Code.  
 3. This represents an accurate record of as-constructed works.  
 4. I accept responsibility for the information contained in this drawing / document.

RPEQ (signature) RPEQ No. \_\_\_\_\_ Date: \_\_\_\_\_


**REGISTERED SURVEYOR'S CERTIFICATION**

I, ANDREW ROBERT THURSTON, hereby certify that the vertical and horizontal locations and dimensions shown on this plan are a true and correct record and were located by survey.

Registered Surveyor (sig) Reg. Surveyor No. 03047 Date: 03.05.2023

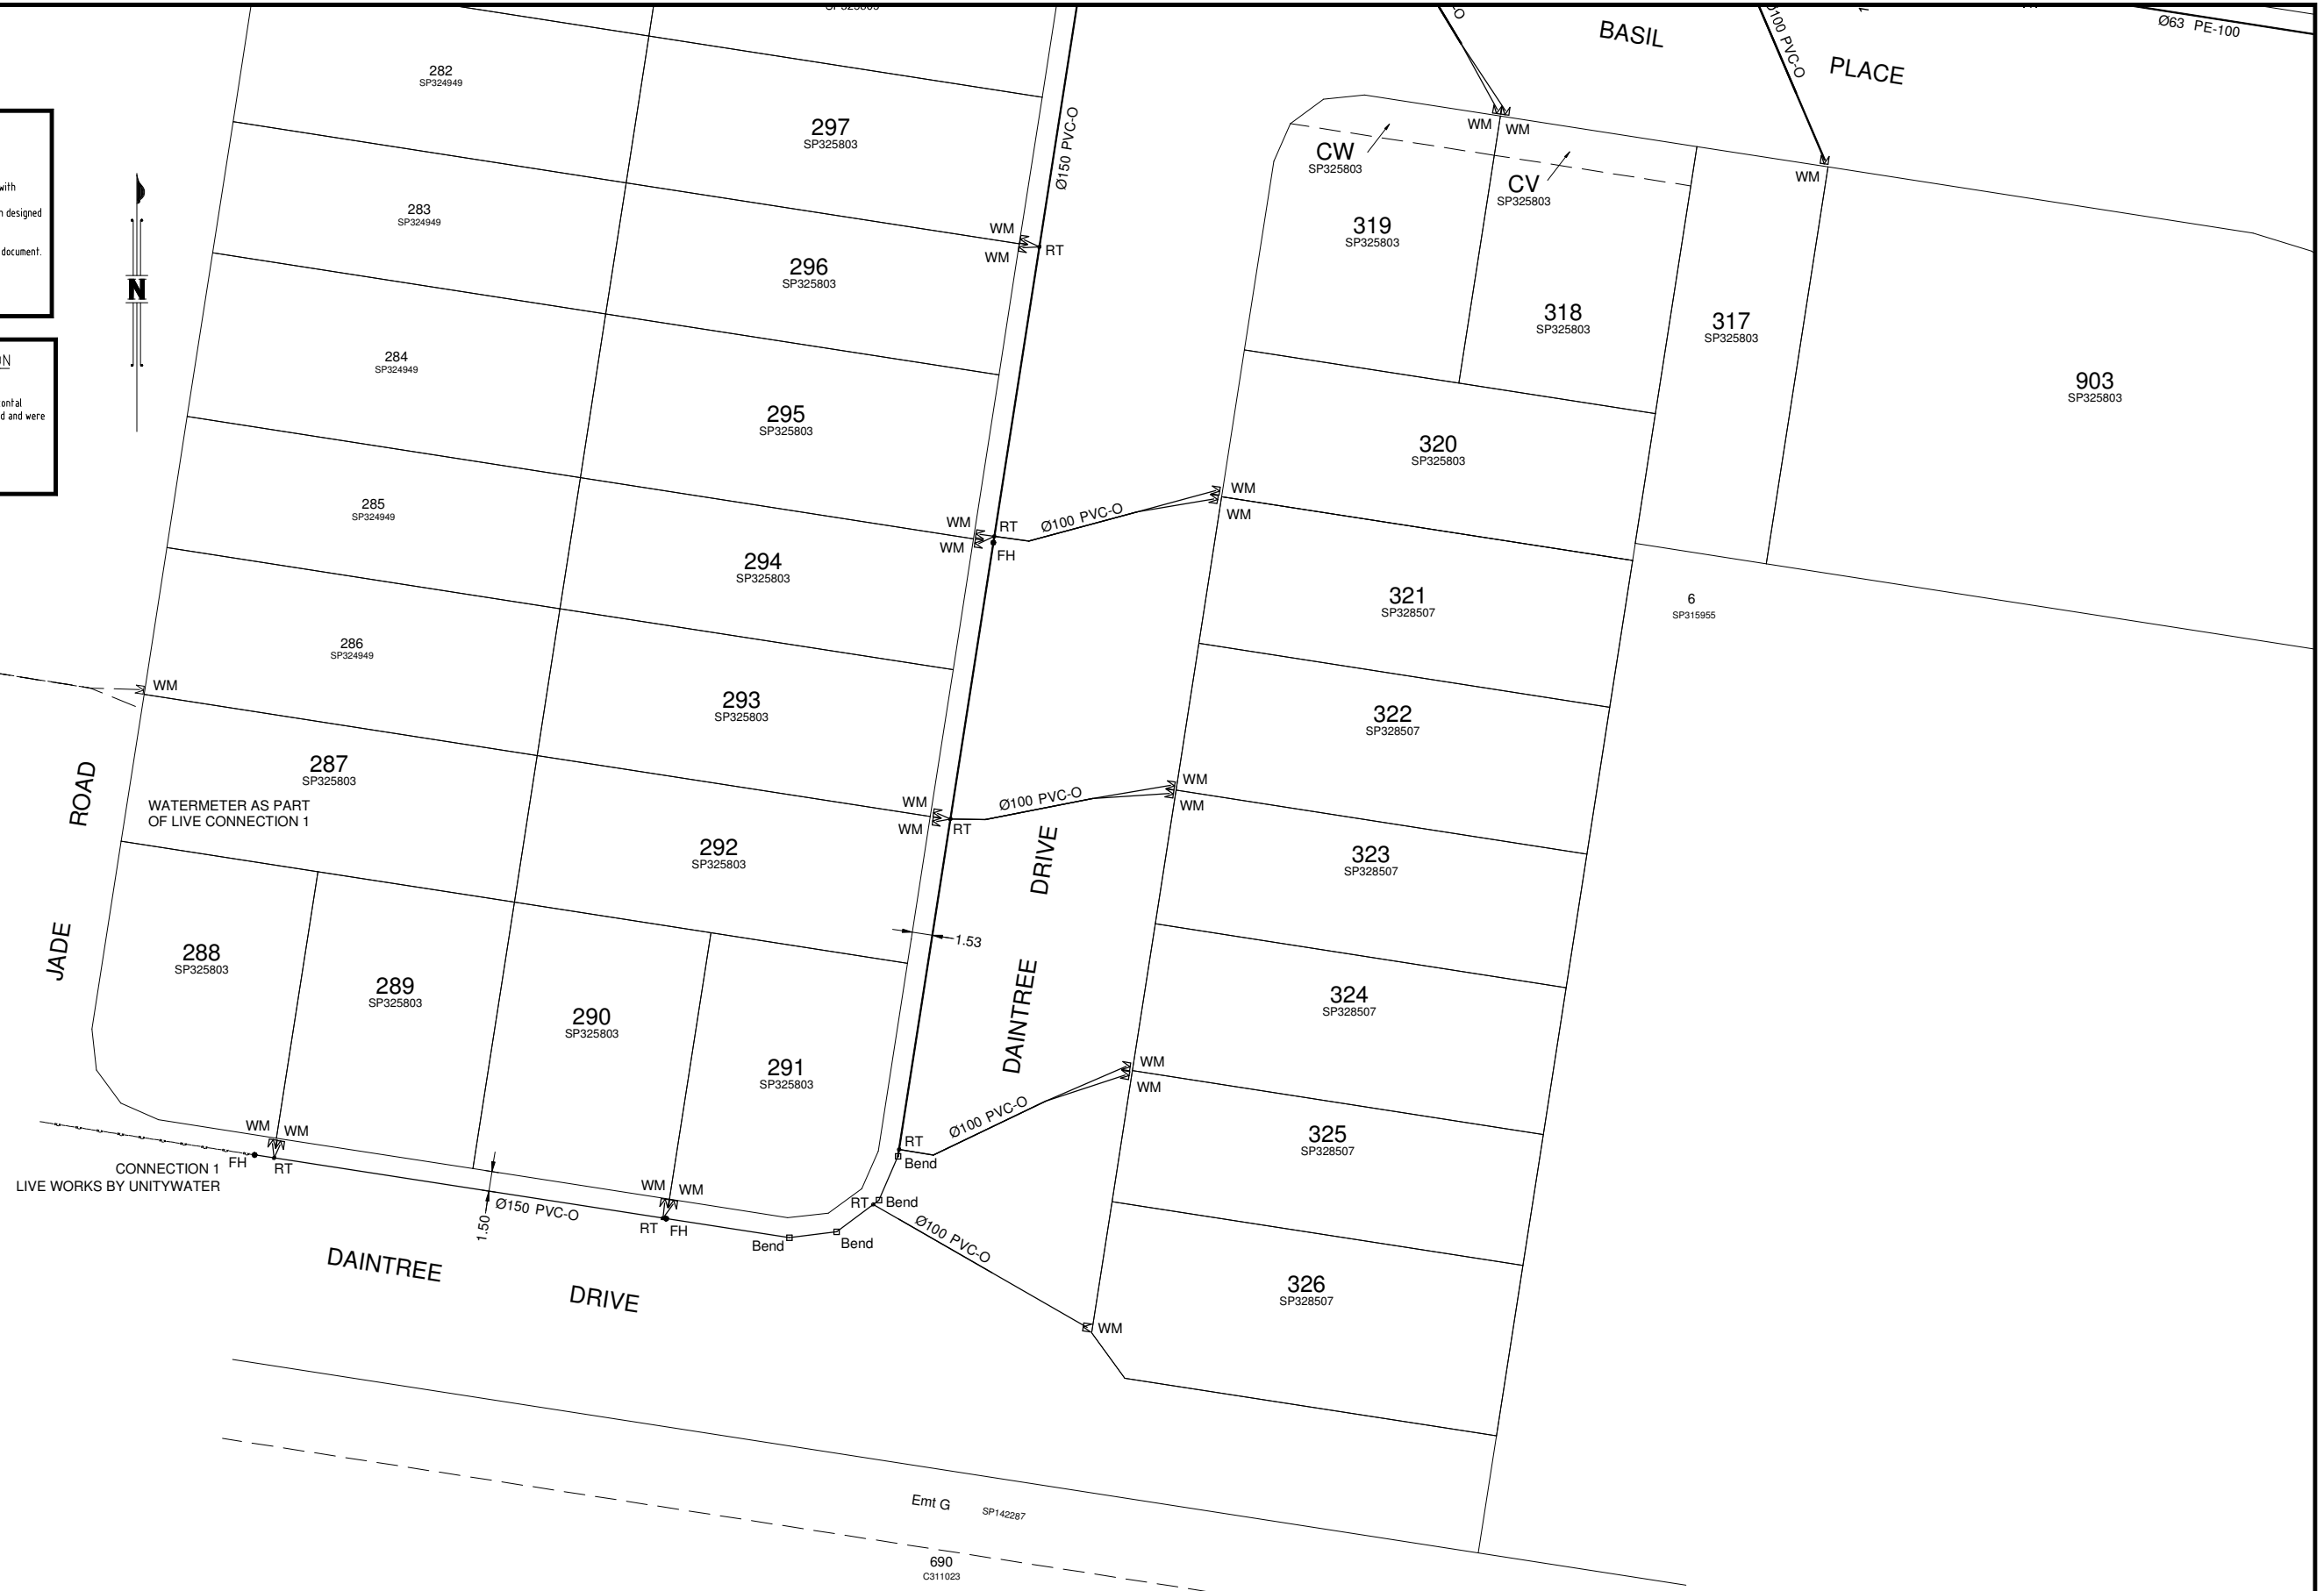

**COORDINATE DATUM NOTE:**  
 HORIZONTAL COORDINATES(E,N) SUPPLIED ARE MAPPING GRID OF AUSTRALIA(MGA), ZONE 56 BASED ON THE UNIVERSAL TRANSVERSE MERCATOR PROJECTION AND THE GEOCENTRIC DATUM OF AUSTRALIA 1994.

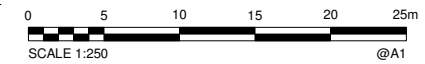

**AS CONSTRUCTED**

**A1**

INDEX	DATE	REVISIONS	DRAWN	CHECKED	PASSED
A	03.05.2023	AS CONSTRUCTED	JC	AD	AT

DRAWN	CHECKED	PASSED	INITIALS	DATE
JC	AD	AT		03.05.2023
				03.05.2023
				03.05.2023



**Unitywater**  
 2019013911S9  
 VILLAGE GREEN STAGE 7A & 7B  
 PALMVIEW, QLD  
 WATER AS CONSTRUCTED

SHEET 5 OF 5 SHEETS	SCALE 1:250
REVISION DATE 03.05.2023	REVISION A
DISCIPLINE CODE C	
DRAWING NO. U-2022-4273	

PSM- 201158  
 E- 506354.007  
 N- 7042428.628  
 RL- 12.943m

LIMIT OF WORKS



**LEGEND:**

- STORMWATER PIPE
- EXISTING STORMWATER
- STORMWATER MANHOLE
- STORMWATER PIT



**ENGINEER'S CERTIFICATION**

I, \_\_\_\_\_, hereby certify that:

- The information contained in this drawing / document is in compliance with approved drawings and design.
- The new water and sewerage works defined by this drawing have been designed and constructed in accordance with the SED Code.
- This represents an accurate record of as-constructed works.
- I accept responsibility for the information contained in this drawing / document.

RPEQ (signature) RPEQ No. \_\_\_\_\_ Date: \_\_\_\_\_


**REGISTERED SURVEYOR'S CERTIFICATION**

I, ANDREW ROBERT THURSTON, hereby certify that the vertical and horizontal locations and dimensions shown on this plan are a true and correct record and were located by survey.

*AT*  
 Registered Surveyor (sig) Reg. Surveyor No. 03047 Date: 17-05-2023

**COORDINATE DATUM NOTE:**  
 HORIZONTAL COORDINATES (E, N) SUPPLIED ARE MAPPING GRID OF AUSTRALIA (MGA), ZONE 56 BASED ON THE UNIVERSAL TRANSVERSE MERCATOR PROJECTION AND THE GEOCENTRIC DATUM OF AUSTRALIA 1994.  
 LEVELS SUPPLIED ARE ON THE AUSTRALIAN HEIGHT DATUM (AHD)

**AS CONSTRUCTED**

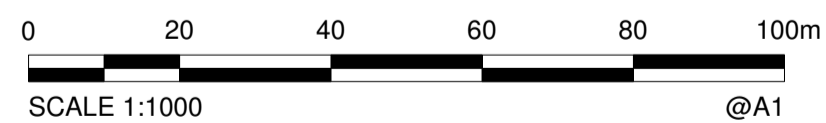

ALL DISTANCES IN METRES  
 OPW21/0481.01

SEE SHEET 2

<b>A1</b>	A	17-05-2023	AS CONSTRUCTED	JC	AD	AT
	INDEX	DATE	REVISIONS	DRAWN	CHECKED	APPROVED

**WOLTER consulting group**

Planning Urban Design Landscape Environment Surveying

Brisbane: Level 2, 1 Breakfast Ck Road, Newstead, QLD 4006 Phone: (07) 3666 5200



**Sunshine Coast Council**





PALMVIEW ESTATE STAGE 7  
 LAXTON ROAD, PALMVIEW  
 STORMWATER AS CONSTRUCTED


SCALE	1:250
SHEET 1 OF 6 SHEETS	
DRAWING NO.	SS3787-7_101_AC

PSM- 201158  
 E- 506354.007  
 N- 7042428.628  
 RL- 12.943m

SEE SHEET 1

**LEGEND:**

-  STORMWATER PIPE
-  EXISTING STORMWATER
-  STORMWATER MANHOLE
-  STORMWATER PIT

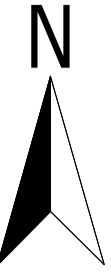

**ENGINEER'S CERTIFICATION**


- I, \_\_\_\_\_, hereby certify that:
- The information contained in this drawing / document is in compliance with approved drawings and design.
  - The new water and sewerage works defined by this drawing have been designed and constructed in accordance with the SEQ Code.
  - This represents an accurate record of as-constructed works.
  - I accept responsibility for the information contained in this drawing / document.

RPEQ (signature) RPEQ No. \_\_\_\_\_ Date: \_\_\_\_\_


**REGISTERED SURVEYOR'S CERTIFICATION**

- I, ANDREW ROBERT THURSTON, hereby certify that the vertical and horizontal locations and dimensions shown on this plan are a true and correct record and were located by survey.

Registered Surveyor (sig) Reg. Surveyor No. 03047 Date: 17-05-2023

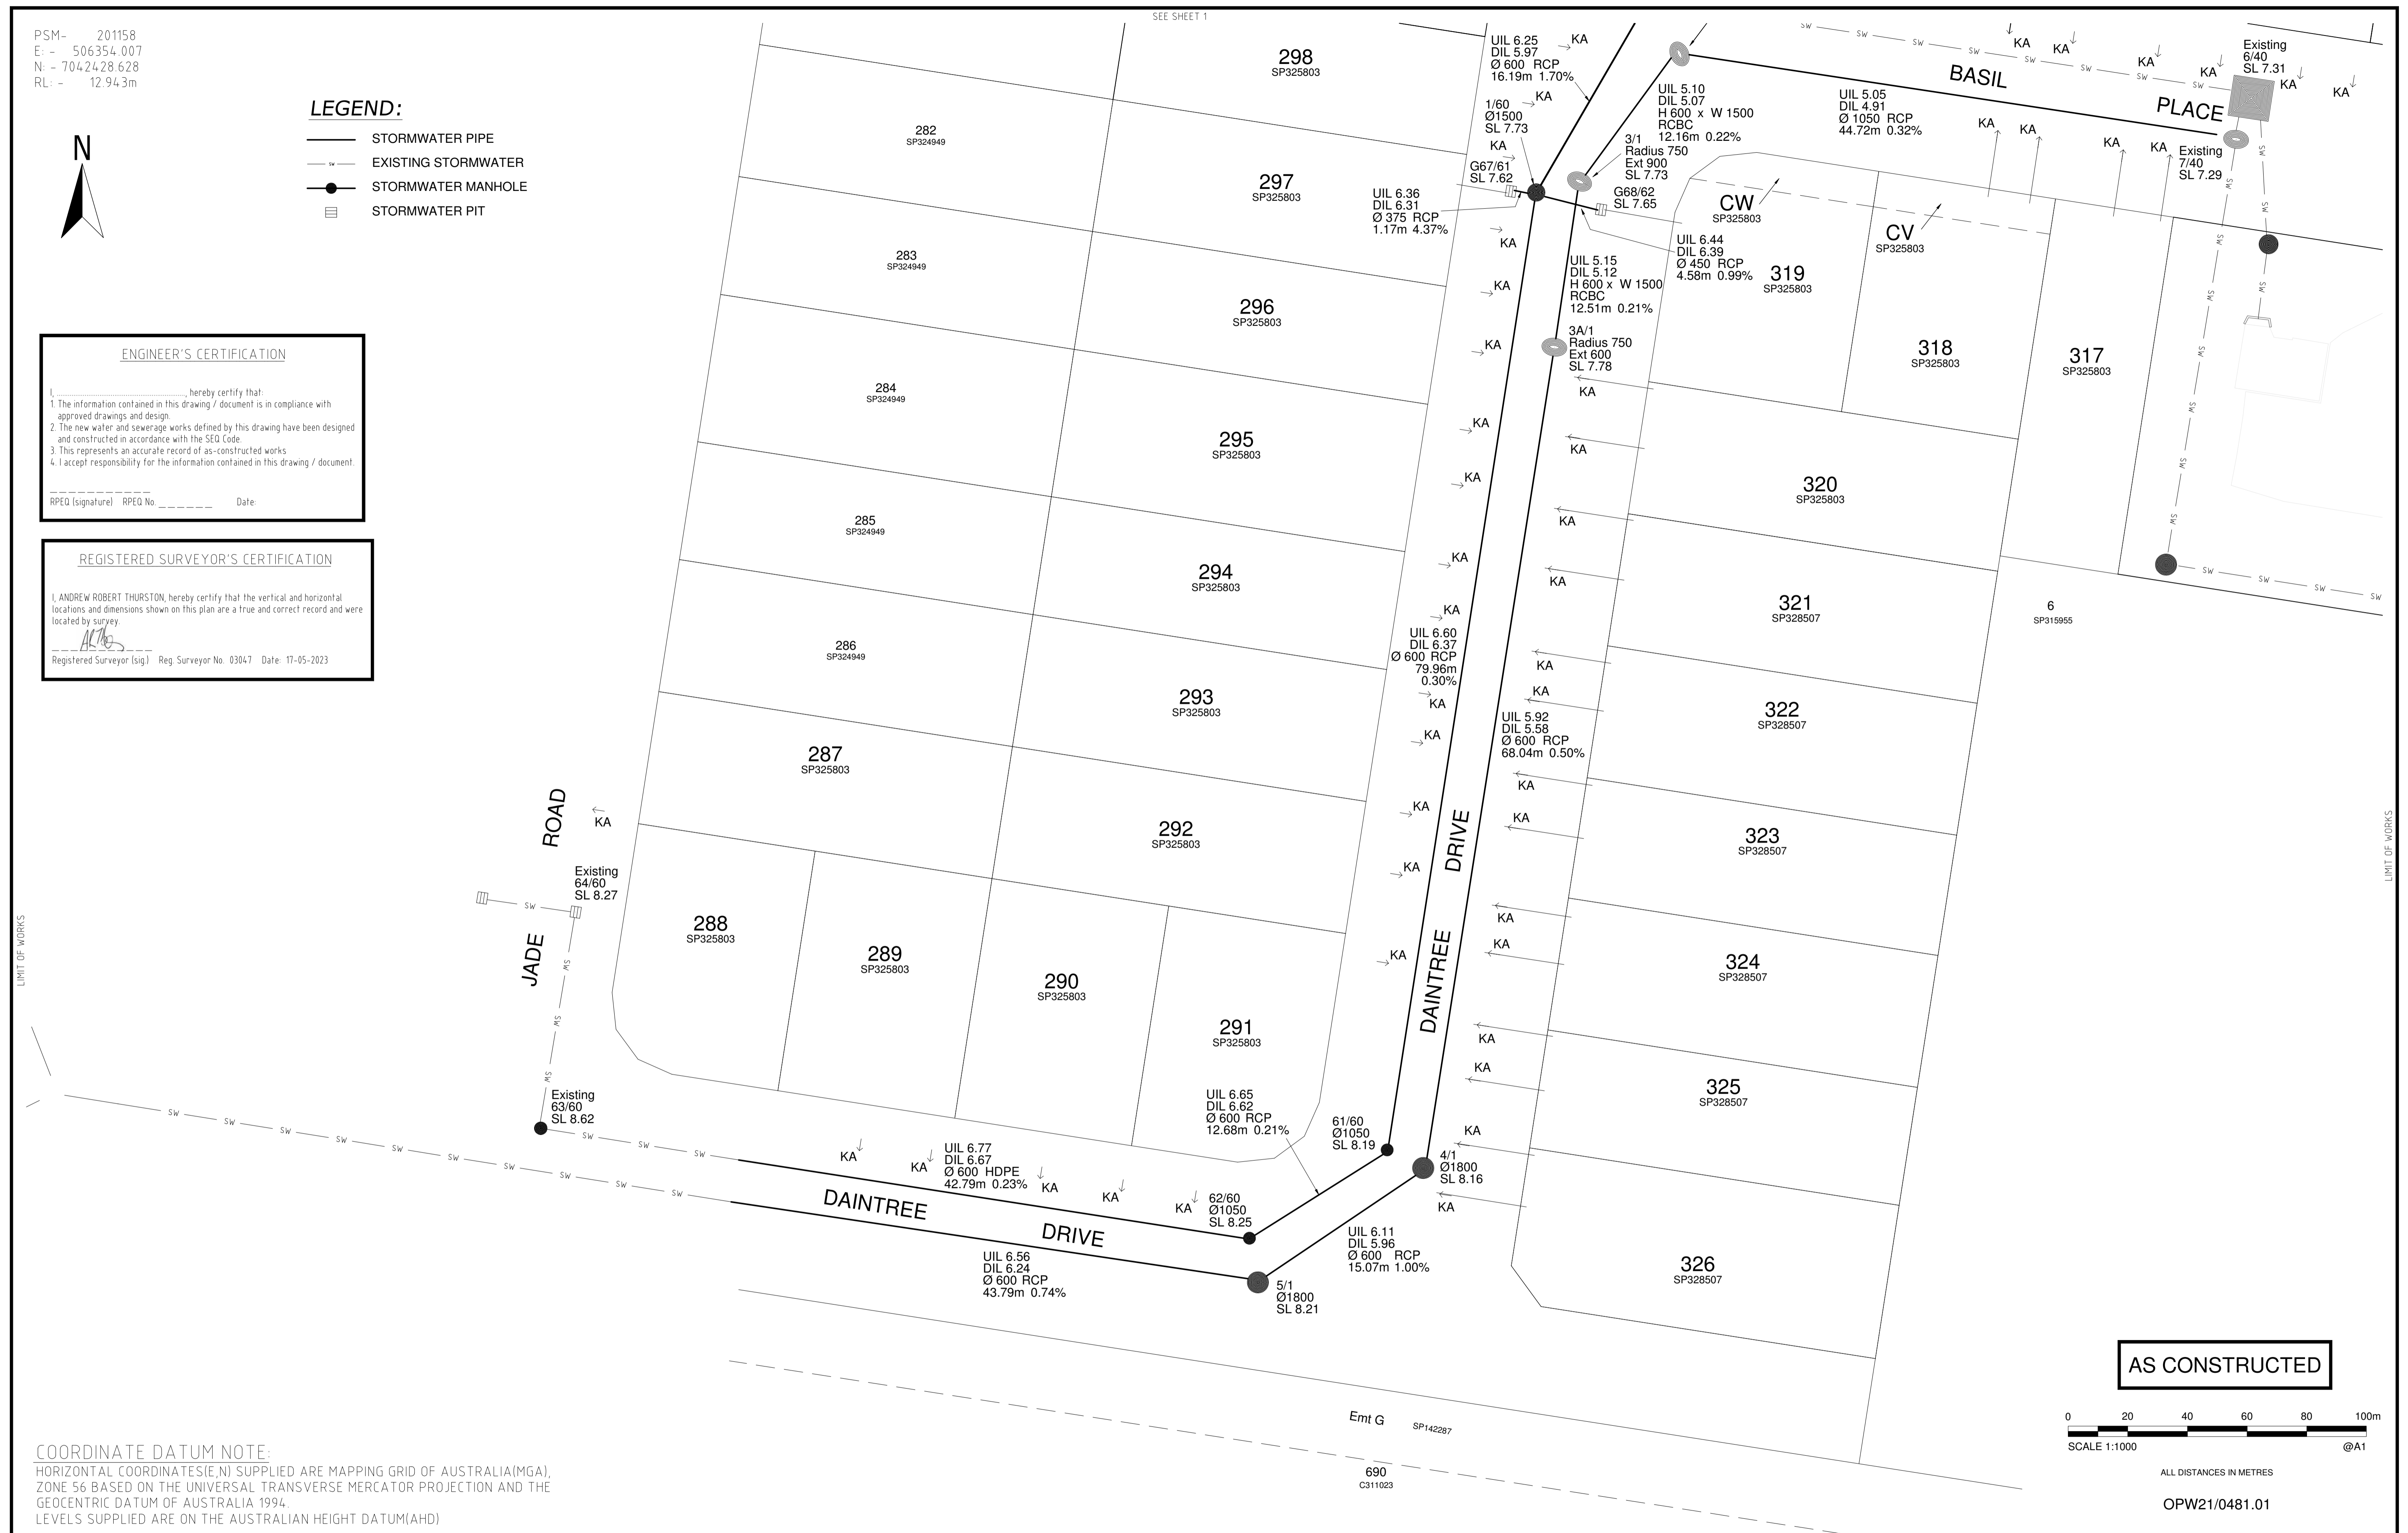

**AS CONSTRUCTED**

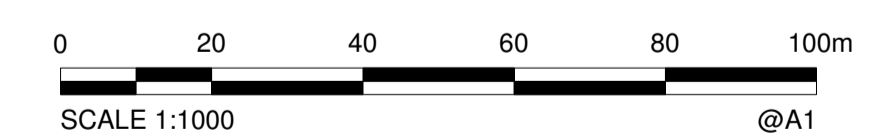

ALL DISTANCES IN METRES

OPW21/0481.01

**COORDINATE DATUM NOTE:**  
 HORIZONTAL COORDINATES (E, N) SUPPLIED ARE MAPPING GRID OF AUSTRALIA (MGA), ZONE 56 BASED ON THE UNIVERSAL TRANSVERSE MERCATOR PROJECTION AND THE GEOCENTRIC DATUM OF AUSTRALIA 1994.  
 LEVELS SUPPLIED ARE ON THE AUSTRALIAN HEIGHT DATUM (AHD)

**A1**

INDEX	DATE	REVISIONS	DRAWN	CHECKED	APPROVED
A	17-05-2023	AS CONSTRUCTED	JC	BA	AT

**WOLTER consulting group**  
 Planning Urban Design Landscape Environment Surveying  
 Brisbane: Level 2, 1 Breakfast Ck Road, Newstead, QLD 4006 Phone: (07) 3666 5200

**Sunshine Coast COUNCIL**

**Sunshine Coast Council**

PALMVIEW ESTATE STAGE 7  
 LAXTON ROAD, PALMVIEW  
 STORMWATER AS CONSTRUCTED

SCALE	1:250
SHEET 2	OF 6 SHEETS
DRAWING NO.	SS3787-7_100_AC

PSM- 201158  
 E- 506354.007  
 N- 7042428.628  
 RL- 12.943m

LIMIT OF WORKS



**ENGINEER'S CERTIFICATION**

I, \_\_\_\_\_, hereby certify that:  
 1. The information contained in this drawing / document is in compliance with approved drawings and design.  
 2. The new water and sewerage works defined by this drawing have been designed and constructed in accordance with the SEQ Code.  
 3. This represents an accurate record of as-constructed works.  
 4. I accept responsibility for the information contained in this drawing / document.

RPEQ (signature) RPEQ No. \_\_\_\_\_ Date: \_\_\_\_\_

**REGISTERED SURVEYOR'S CERTIFICATION**


I, ANDREW ROBERT THURSTON, hereby certify that the vertical and horizontal locations and dimensions shown on this plan are a true and correct record and were located by survey.

Registered Surveyor (sig) Reg. Surveyor No. 03047 Date: 17-05-2023

**COORDINATE DATUM NOTE:**

HORIZONTAL COORDINATES(E,N) SUPPLIED ARE MAPPING GRID OF AUSTRALIA(MGA), ZONE 56 BASED ON THE UNIVERSAL TRANSVERSE MERCATOR PROJECTION AND THE GEOCENTRIC DATUM OF AUSTRALIA 1994.  
 LEVELS SUPPLIED ARE ON THE AUSTRALIAN HEIGHT DATUM(AHD)

**AS CONSTRUCTED**

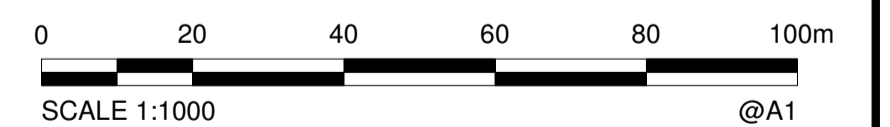

ALL DISTANCES IN METRES

OPW21/0481.01

SEE SHEET 4

**A1**

INDEX	DATE	REVISIONS	DRAWN	CHECKED	APPROVED
A	17-05-2023	AS CONSTRUCTED	JC	AD	AT

**WOLTER consulting group**  
 Planning Urban Design Landscape Environment Surveying  
 Brisbane: Level 2, 1 Breakfast Ck Road, Newstead, QLD 4006 Phone: (07) 3666 5200

**Sunshine Coast COUNCIL**

**Sunshine Coast Council**


PALMVIEW ESTATE STAGE 7  
 LAXTON ROAD, PALMVIEW  
 TRANSPORT AS CONSTRUCTED

SCALE	1:250
SHEET	3 OF 6 SHEETS
DRAWING NO.	SS3787-7_101_AC



PSM- 201158  
 E- 506354.007  
 N- 7042428.628  
 RL- 12.943m

SEE SHEET 3

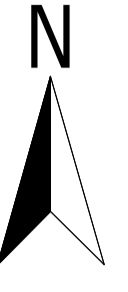

**ENGINEER'S CERTIFICATION**

I, \_\_\_\_\_, hereby certify that:  
 1. The information contained in this drawing / document is in compliance with approved drawings and design.  
 2. The new water and sewerage works defined by this drawing have been designed and constructed in accordance with the SEQ Code.  
 3. This represents an accurate record of as-constructed works.  
 4. I accept responsibility for the information contained in this drawing / document.

\_\_\_\_\_  
 RPEQ (signature) RPEQ No. \_\_\_\_\_ Date: \_\_\_\_\_


**REGISTERED SURVEYOR'S CERTIFICATION**

I, ANDREW ROBERT THURSTON, hereby certify that the vertical and horizontal locations and dimensions shown on this plan are a true and correct record and were located by survey.

*Andrew Thurston*  
 Registered Surveyor (sig) Reg. Surveyor No. 03047 Date: 17-05-2023



**AS CONSTRUCTED**

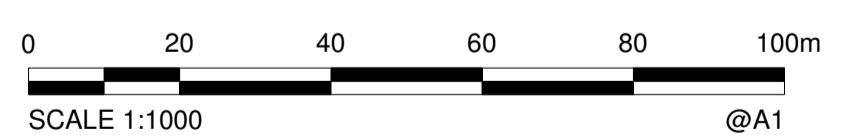

**COORDINATE DATUM NOTE:**  
 HORIZONTAL COORDINATES (E, N) SUPPLIED ARE MAPPING GRID OF AUSTRALIA (MGA), ZONE 56 BASED ON THE UNIVERSAL TRANSVERSE MERCATOR PROJECTION AND THE GEOCENTRIC DATUM OF AUSTRALIA 1994.  
 LEVELS SUPPLIED ARE ON THE AUSTRALIAN HEIGHT DATUM (AHD)

OPW21/0481.01

**A1**

INDEX	DATE	REVISIONS	DRAWN	CHECKED	APPROVED
A	17-05-2023	AS CONSTRUCTED	JC	BA	AT


**WOLTER consulting group**  
 Planning Urban Design Landscape Environment Surveying  
 Brisbane: Level 2, 1 Breakfast Ck Road, Newstead, QLD 4006 Phone: (07) 3666 5200



**Sunshine Coast Council**  
 PALMVIEW ESTATE STAGE 7  
 LAXTON ROAD, PALMVIEW  
 TRANSPORT AS CONSTRUCTED

SCALE	1:250
SHEET	4 OF 6 SHEETS
DRAWING NO.	SS3787-7_100_AC

PSM- 201158  
 E- 506354.007  
 N- 7042428.628  
 RL- 12.943m

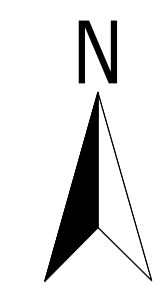

**ENGINEER'S CERTIFICATION**

I, \_\_\_\_\_, hereby certify that:

- The information contained in this drawing / document is in compliance with approved drawings and design.
- The new water and sewerage works defined by this drawing have been designed and constructed in accordance with the SEQ Code.
- This represents an accurate record of as-constructed works.
- I accept responsibility for the information contained in this drawing / document.

RPEQ (signature) RPEQ No. \_\_\_\_\_ Date: \_\_\_\_\_


**REGISTERED SURVEYOR'S CERTIFICATION**

I, ANDREW ROBERT THURSTON, hereby certify that the vertical and horizontal locations and dimensions shown on this plan are a true and correct record and were located by survey.

*Andrew Thurston*  
 Registered Surveyor (sig) Reg. Surveyor No. 03047 Date: 17-05-2023

**COORDINATE DATUM NOTE:**  
 HORIZONTAL COORDINATES (E, N) SUPPLIED ARE MAPPING GRID OF AUSTRALIA (MGA), ZONE 56 BASED ON THE UNIVERSAL TRANSVERSE MERCATOR PROJECTION AND THE GEOCENTRIC DATUM OF AUSTRALIA 1994.  
 LEVELS SUPPLIED ARE ON THE AUSTRALIAN HEIGHT DATUM (AHD)

**AS CONSTRUCTED**

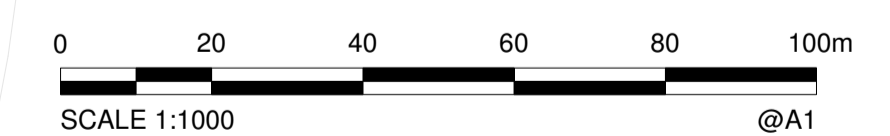

ALL DISTANCES IN METRES  
 OPW21/0481.01

<b>A1</b>	A	17-05-2023	AS CONSTRUCTED	JC	AD	AT
	INDEX	DATE	REVISIONS	DRAWN	CHECKED	APPROVED

**WOLTER consulting group**

Planning Urban Design Landscape Environment Surveying

Brisbane: Level 2, 1 Breakfast Ck Road, Newstead, QLD 4006 Phone: (07) 3666 5200




**Sunshine Coast Council**

PALMVIEW ESTATE STAGE 7  
 LAXTON ROAD, PALMVIEW  
 SURFACE AS CONSTRUCTED

SCALE	1:250
SHEET	5 OF 6 SHEETS
DRAWING NO.	SS3787-7_101_AC

SEE SHEET 6

PSM- 201158  
 E- 506354.007  
 N- 7042428.628  
 RL- 12.943m

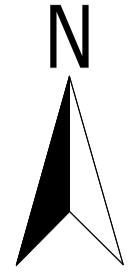

**ENGINEER'S CERTIFICATION**


- I, \_\_\_\_\_, hereby certify that:
- The information contained in this drawing / document is in compliance with approved drawings and design.
  - The new water and sewerage works defined by this drawing have been designed and constructed in accordance with the SEQ Code.
  - This represents an accurate record of as-constructed works.
  - I accept responsibility for the information contained in this drawing / document.

RPEQ (signature) RPEQ No. \_\_\_\_\_ Date: \_\_\_\_\_


**REGISTERED SURVEYOR'S CERTIFICATION**

I, ANDREW ROBERT THURSTON, hereby certify that the vertical and horizontal locations and dimensions shown on this plan are a true and correct record and were located by survey.

Registered Surveyor (sig) Reg. Surveyor No. 03047 Date: 17-05-2023

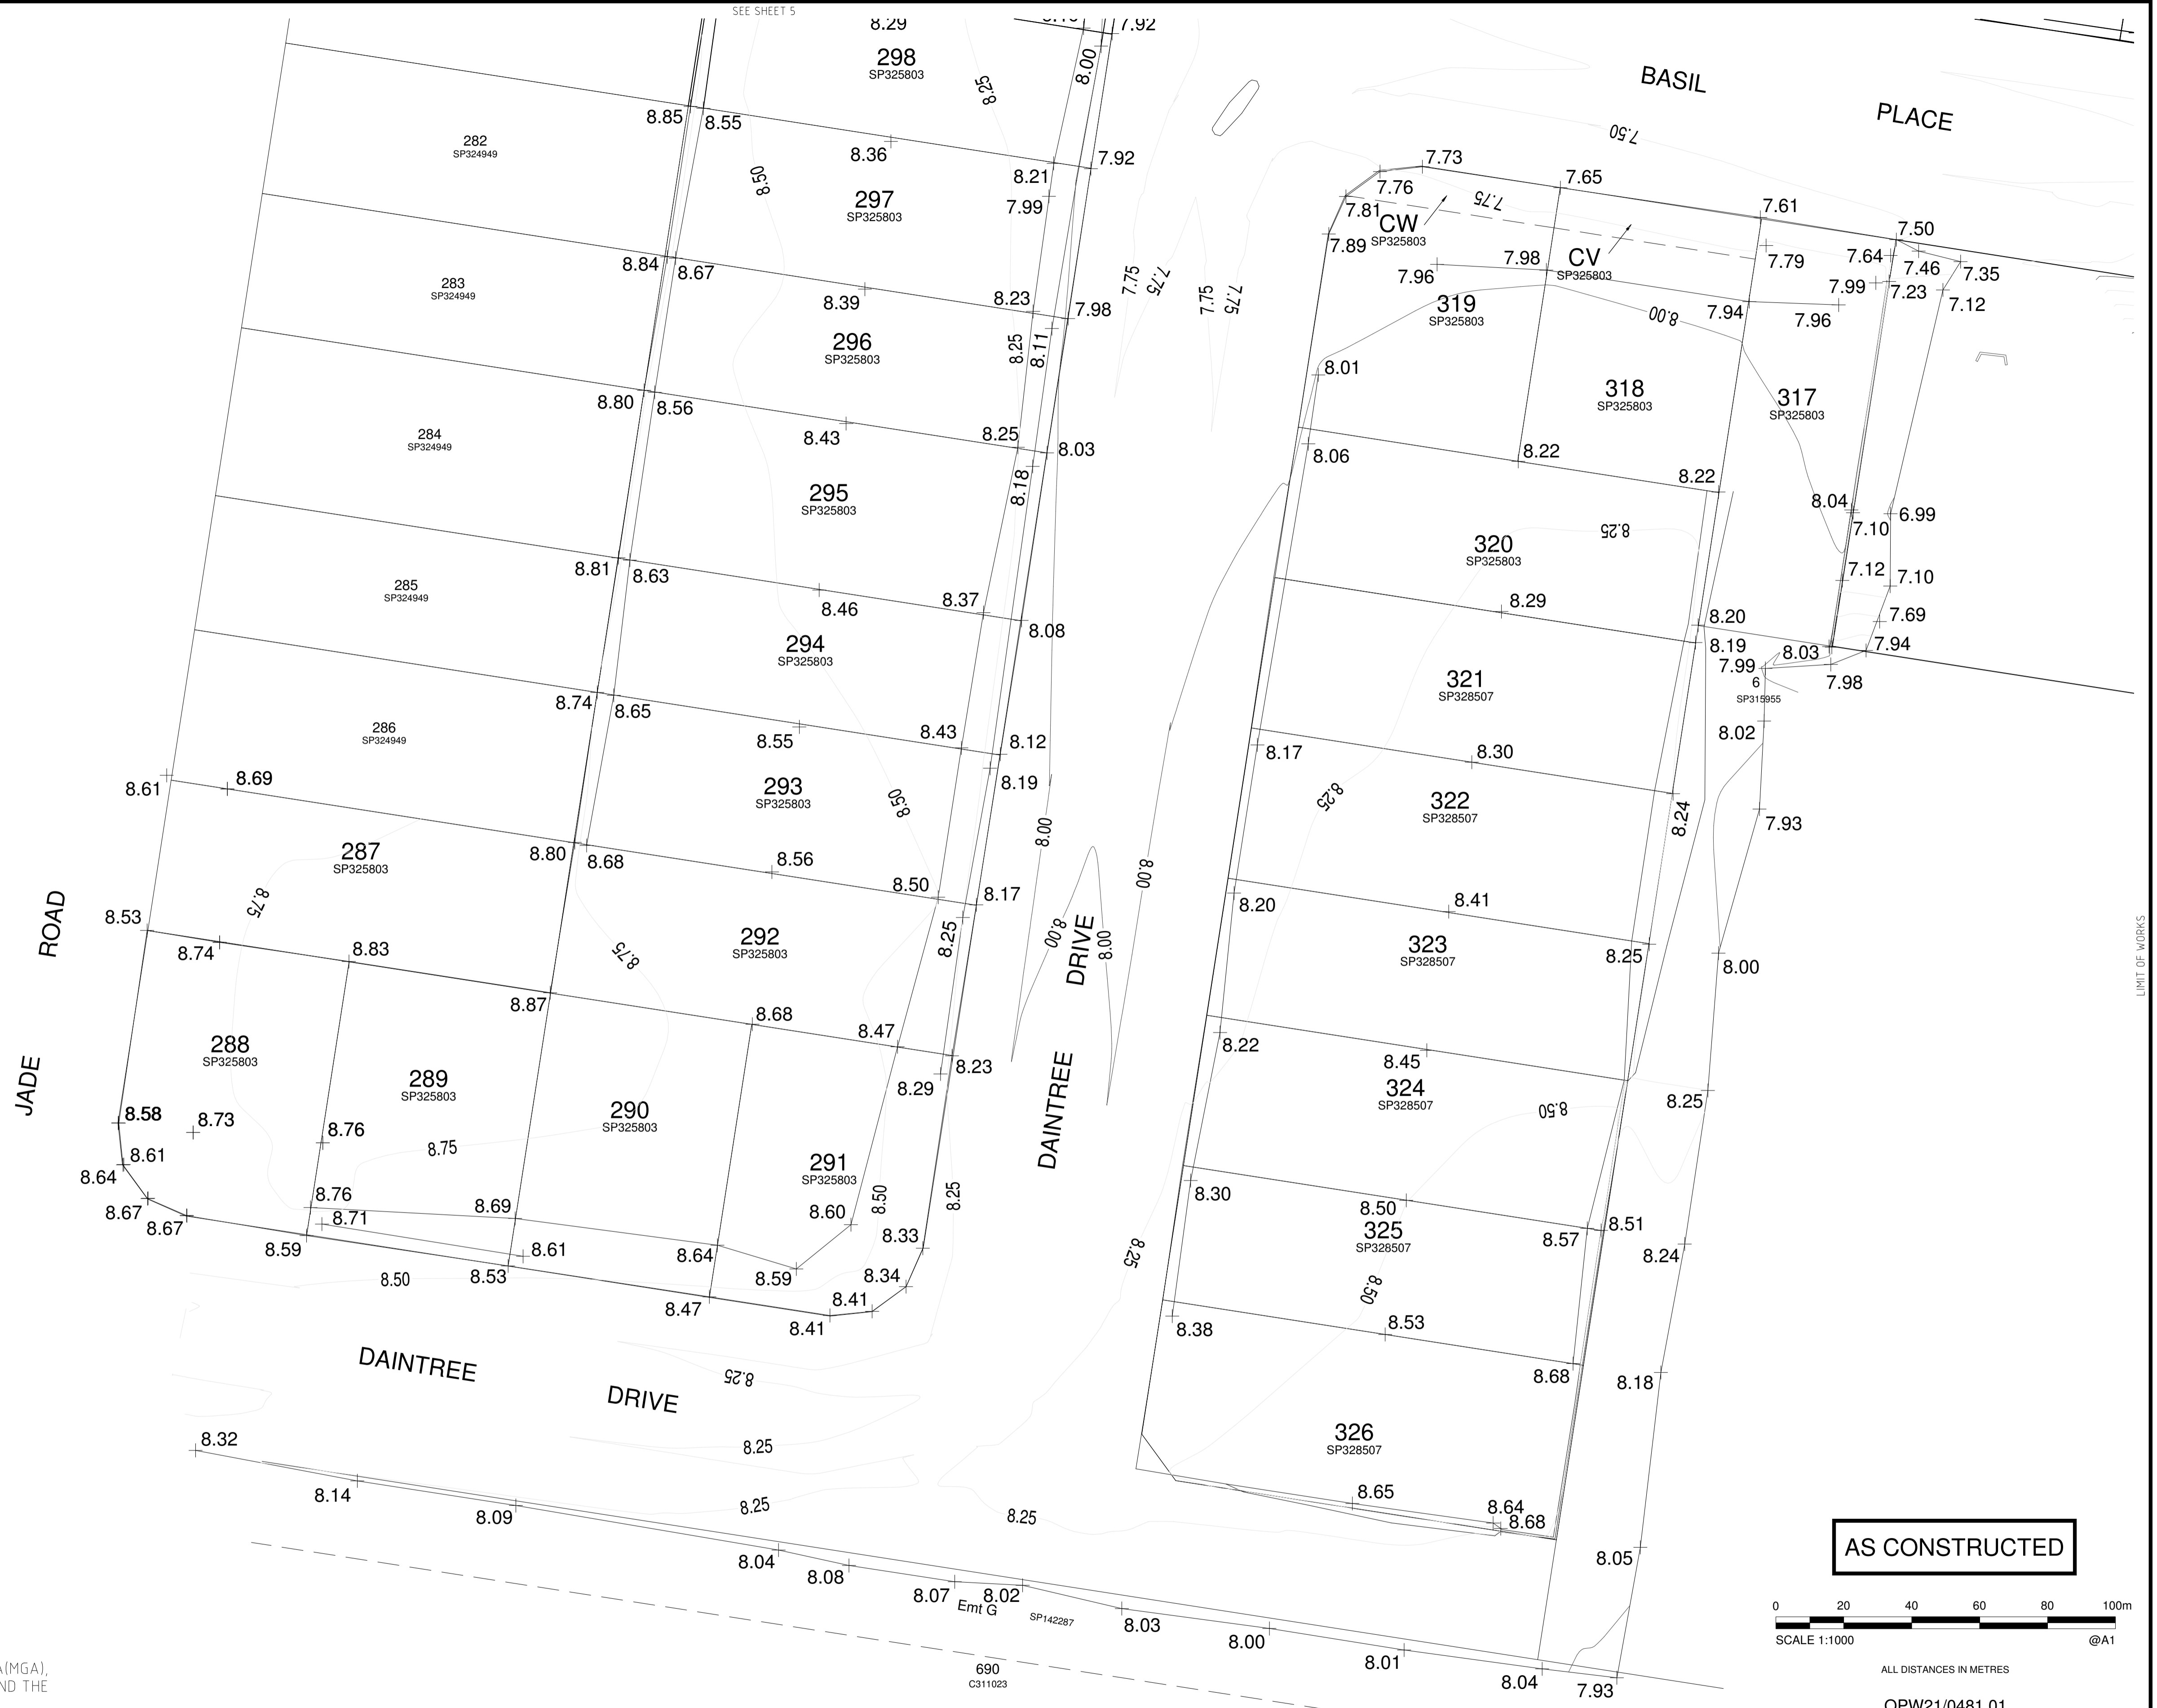

**COORDINATE DATUM NOTE:**  
 HORIZONTAL COORDINATES (E, N) SUPPLIED ARE MAPPING GRID OF AUSTRALIA (MGA), ZONE 56 BASED ON THE UNIVERSAL TRANSVERSE MERCATOR PROJECTION AND THE GEOCENTRIC DATUM OF AUSTRALIA 1994.  
 LEVELS SUPPLIED ARE ON THE AUSTRALIAN HEIGHT DATUM (AHD)

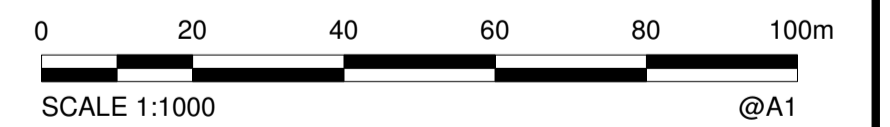

ALL DISTANCES IN METRES

OPW21/0481.01

**A1**

INDEX	DATE	REVISIONS	DRAWN	CHECKED	APPROVED
A	17-05-2023	AS CONSTRUCTED	JC	BA	AT



**Sunshine Coast Council**

PALMVIEW ESTATE STAGE 7  
 LAXTON ROAD, PALMVIEW  
 SURFACE AS CONSTRUCTED

SCALE 1:250  
 SHEET 6 OF 6 SHEETS  
 DRAWING NO.  
 SS3787-7\_100\_AC