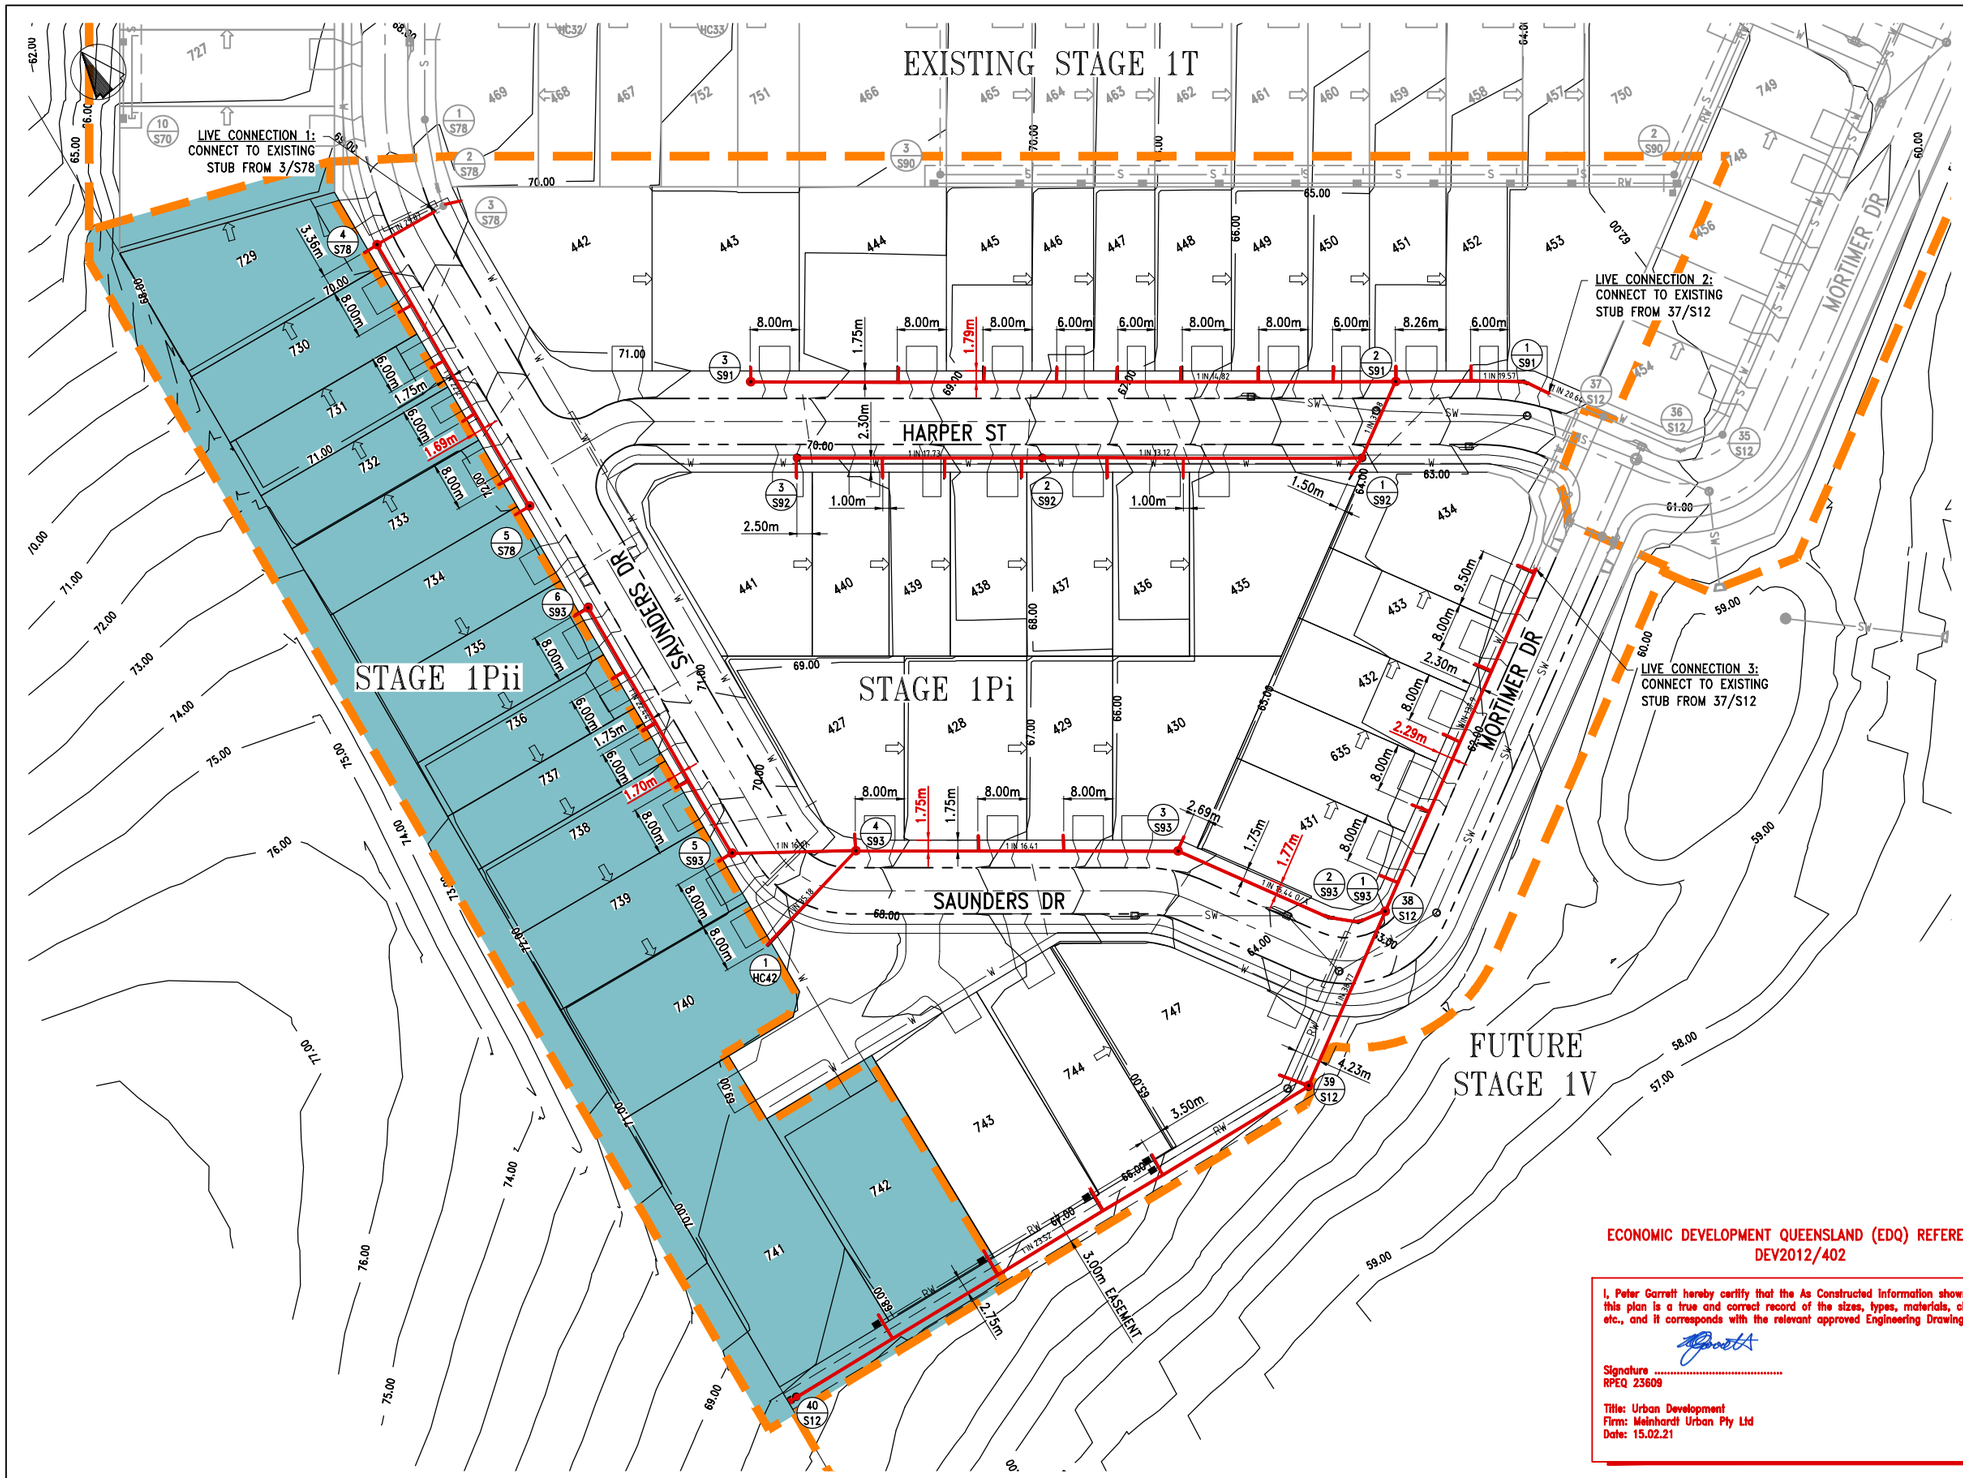

SEWERAGE NOTES:

1. REFER DRAWING 400 FOR NOTES.

LEGEND

- 12 — FINISHED SURFACE CONTOURS
- NOMINAL KERB LINE
- 1/S2 — SEWERAGE MANHOLE 1 ON LINE 2
- AS CONSTRUCTED SEWER
- SW — STORMWATER
- W — WATER MAIN
- WATER CONDUITS
- RW — ROOF WATER
- EASEMENT
- S — EXISTING SEWER
- SW — EXISTING STORMWATER
- W — EXISTING WATER
- STAGE BOUNDARY
- DRIVEWAY LOCATIONS CONSIDERED DURING DESIGN (NOT TO BE BUILT BY CIVILS)
- STAGE 1Pii

ECONOMIC DEVELOPMENT QUEENSLAND (EDQ) REFERENCE: DEV2012/402

I, Peter Garrett hereby certify that the As Constructed information shown on this plan is a true and correct record of the sizes, types, materials, classes etc., and it corresponds with the relevant approved Engineering Drawings.

Signature .....
RPEQ 23609

Title: Urban Development
Firm: Meinhardt Urban Pty Ltd
Date: 15.02.21

FIRE ANT NOTE:

UNDER QUEENSLAND LEGISLATION, FIRE ANTS ARE A NOTIFIABLE PEST AND SUSPECTED SIGHTING MUST BE REPORTED TO BIOSECURITY QUEENSLAND. MOVEMENT OF FIRE ANTS IS PROHIBITED UNLESS APPROVED OTHERWISE BY THE DEPARTMENT OF PRIMARY INDUSTRIES. THE CONTRACTOR SHALL ACQUIRE THE NECESSARY PERMITS TO COMPLETE THE WORKS.

LOCAL AUTHORITY:	ECONOMIC DEVELOPMENT QUEENSLAND
EDQ FILE REF NO:	DEV2012/402
RP DESCRIPTION:	LOT 908 RP819216
PARISH/COUNTY:	MACLEAN/UNDULLAH
ORIGIN:	PM107142 (RL39.078)
HORIZONTAL DATUM:	MGA

REV	DESCRIPTION	BY	SIDR	DATE
A	ORIGINAL ISSUE	LH	JH	24.07.18
B	STAGE 1Pi BOUNDARY ADDED	LH	JH	13.08.18
C	LOTS AND SEWER UPDATED	LH	JH	21.06.19
D	EASEMENT ADDED & DIMENSIONED	KC	JH	02.09.19
E	CONTOURS, SEWER & DRAINAGE LAYOUT AMENDED	HS	RKB	01.07.20
F	AS CONSTRUCTED	LB	AM	15.02.21

5 0 5 10 15 20 25m
1 : 500 (FULL SIZE A1)

veris
BRISBANE (07) 3666 4700 PROSERPINE (07) 4945 1722
MACKAY (07) 4961 3911 CAIRNS (07) 4051 0722
veris.com.au
ACN 604 671 374
Queensland Surveying Pty Ltd t/a Veris

PETER GARRETT
RPEQ 23609

Approved by, for and on behalf of Meinhardt

This drawing has been produced for the exclusive use of the client (nominated on this document). No third party is to rely on this document without written permission from Meinhardt. This drawing is not to be constructed from unless "Issued for construction" is displayed and only where signed by an RPEQ.
© Copyright

SCI QUAL JAS-ANZ

Meinhardt Urban Pty Ltd
A.B.N. 29 064 159 191
Brisbane - Level 2, 135 Wickham Terrace, Spring Hill QLD 4000
Gold Coast - Level 1, 34 Thomas Drive, Chevron Island QLD 4217
Sunshine Coast - 8 Pikki Street, Maroochydore QLD 4558
Postal PO Box 2293, Southport QLD 4215
T: +61 7 5528 6411
F: +61 7 5528 6422
info@meinhardtgroup.com
http://www.meinhardtgroup.com
© Copyright

MEINHARDT

CLIENT: PEET FLAGSTONE CITY Pty. Ltd.

TITLE: SEWER RETICULATION LAYOUT PLAN

PROJECT: FLAGSTONE CITY - STAGE 1Pi

ECONOMIC DEVELOPMENT QUEENSLAND

STATUS: AS CONSTRUCTED

DESIGNED	DRAWN	APPROVED	DATE	SCALE @ A1	SHEET
NM	LH	JH	24.07.18		2 OF 2

PROJECT No	DRAWING No	REV
118576	C1-S1P-CIL-401	F

DWG FILE: K:\Projects\118576 - Flagstone Stage 1P\Acad\C1-S1P-CIL-400\SEWERRETICULATION LAYOUT.dwg - MH PLOT TIME: 15 Feb 2021, 2:39pm