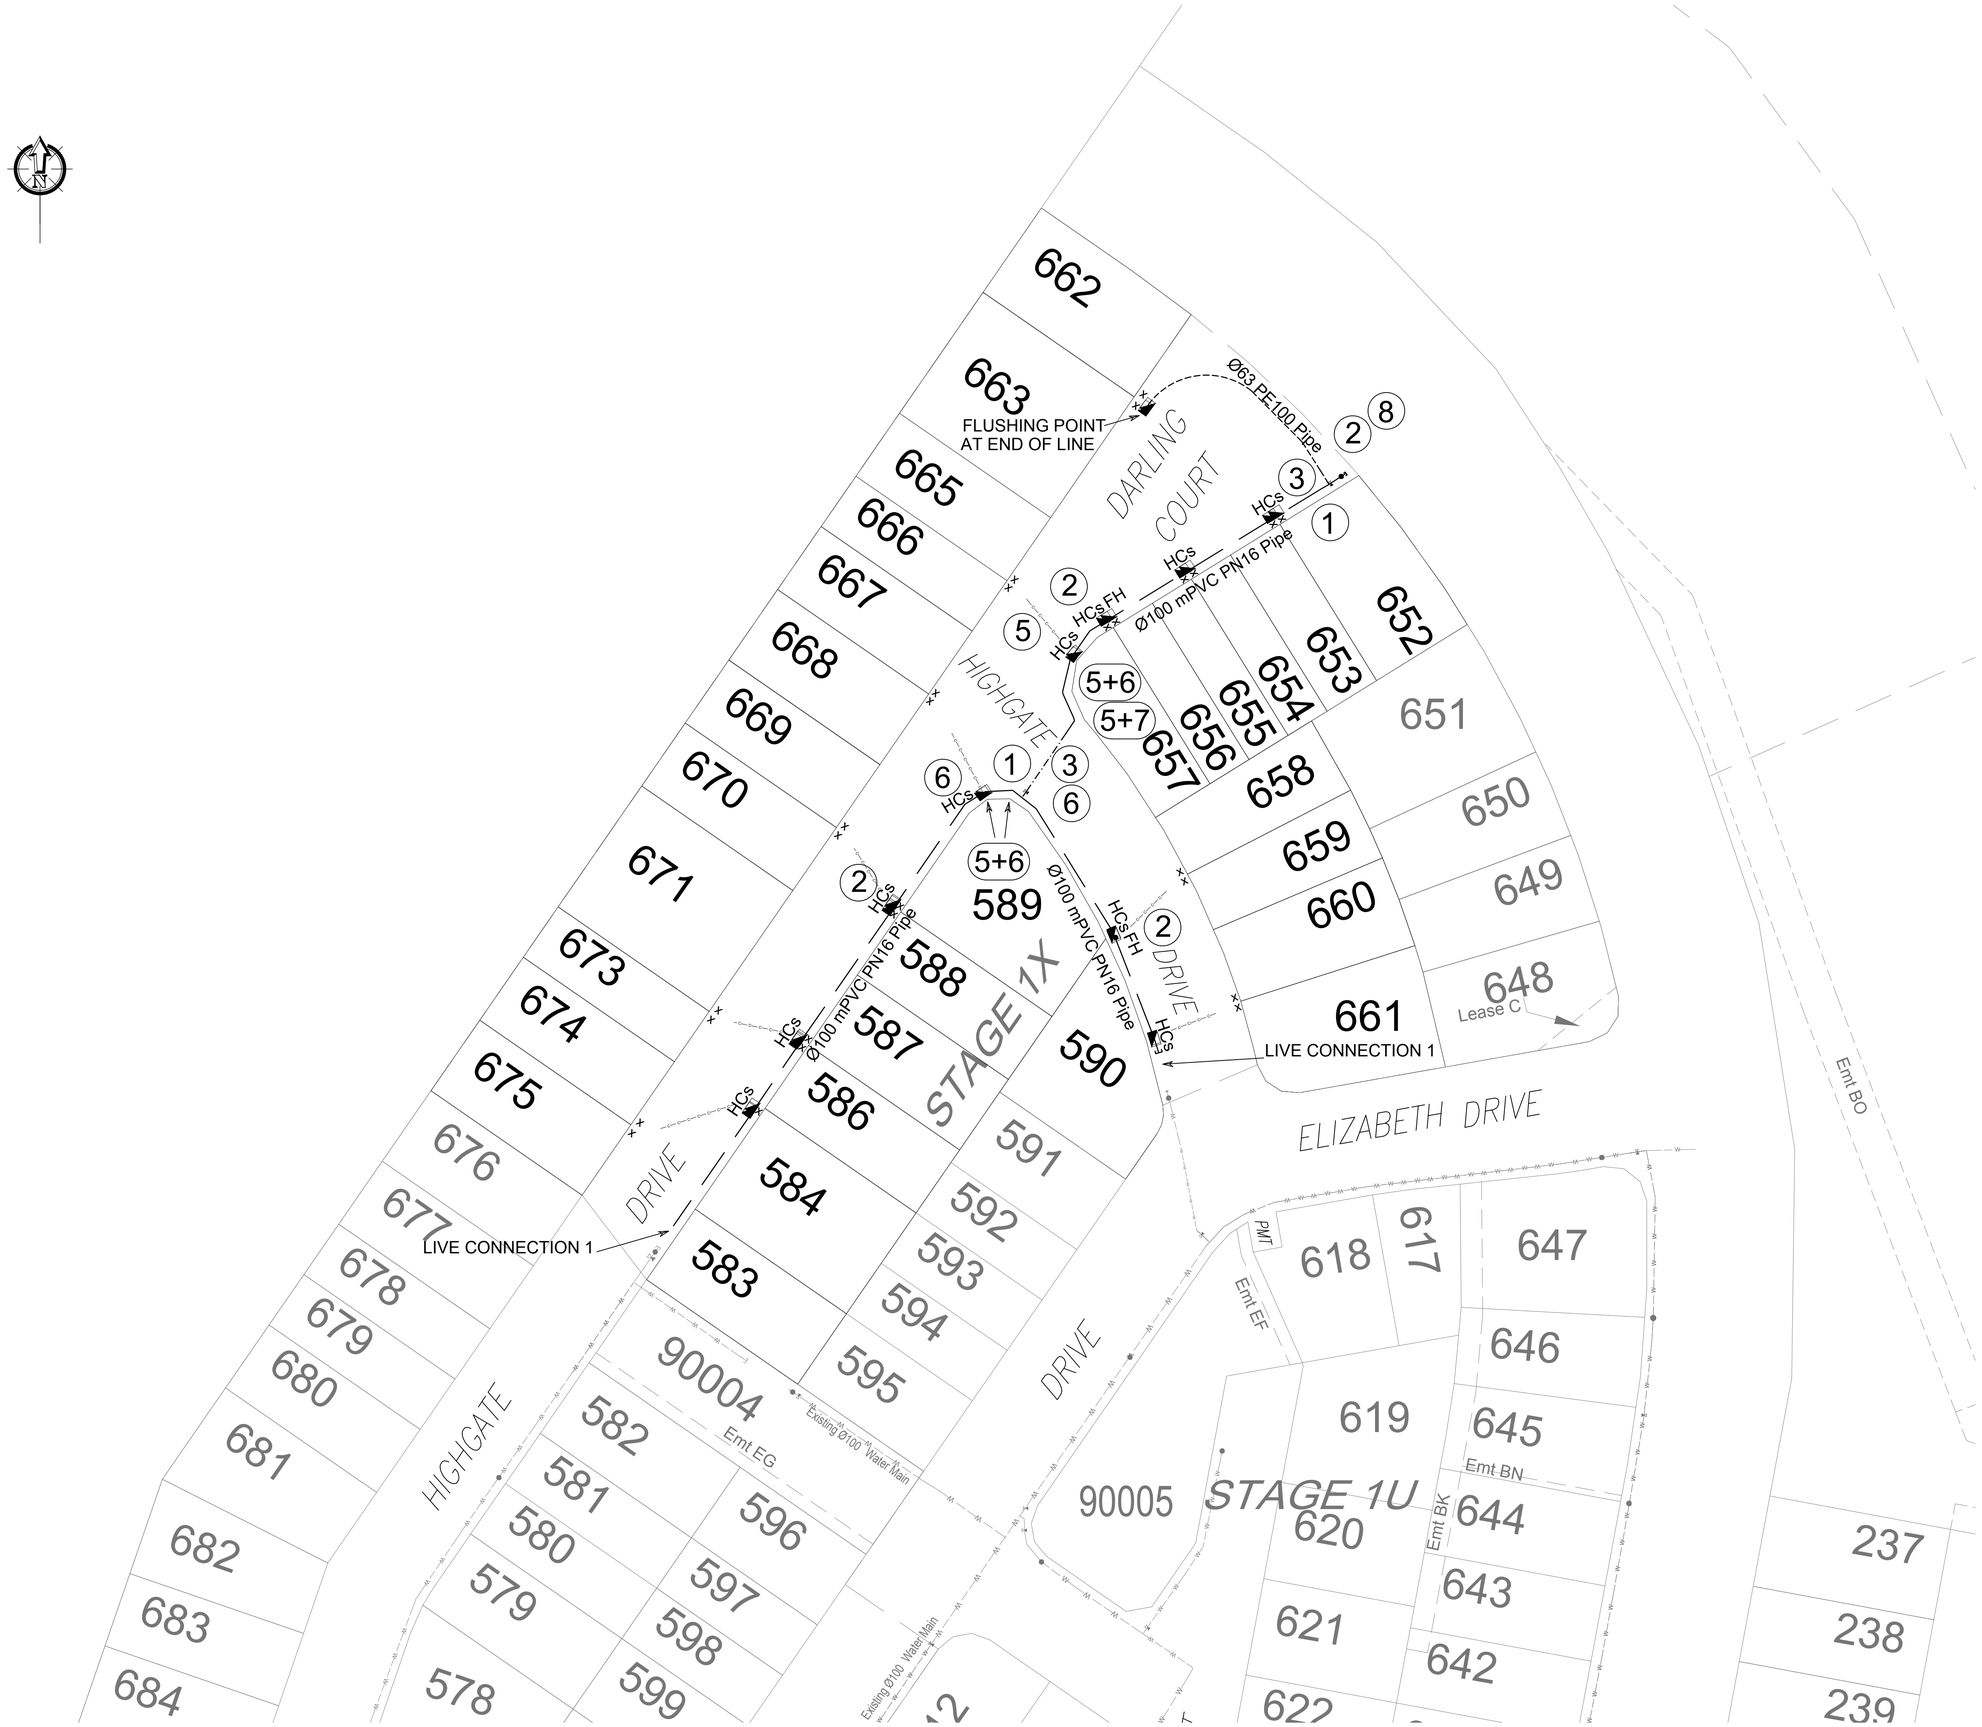

Consulting Engineer's Certification.

I, Jason Harley hereby certify that the As Constructed information shown on this plan is a true and correct record of the sizes, types, materials, classes etc., and it corresponds with the relevant approved Engineering Drawings.

Jason Harley

Signed..... RPEQ No 5665 Dated.....

Registered Surveyor's Certification.

We, VERIS AUSTRALIA Pty Ltd hereby certify that the horizontal and vertical locations, and dimensions shown on this plan are a true and correct record of the As Constructed information.

Signed.. Cadastral Surveyor & Delegate Reg. No 6448 Dated 04/04/2019

LEGEND

Ø DN63 PE100 Pipe	--------
Ø100 PVC-M Pipe	—— ——
Ø100 DICL Pipe	—— · ——
Ø100 uPVC CONDUIT	—c—c—c—
House Connection	HC
Service Point(Indicative)	x

TABLE OF FITTINGS

1. Ø100 Stop Valve
2. Ø100 Fire Hydrant
3. Ø100 x Ø100 Tee
4. Ø100 Dead End Cap
5. Ø100 11.25° Bend
6. Ø100 22.5° Bend
7. Ø100 45° Bend
8. Ø100 Blank Flange

FLAGSTONE
STAGE 1X
For
PEET FLAGSTONE CITY PTY LTD

IMPORTANT NOTES:

This Plan has been prepared for PEET FLAGSTONE CITY PTY LTD to Logan City Council standards for the purpose of recording the As Constructed details of a new service constructed under a specific Council Approval and should not be used for any other purpose.

No report is made on any other service/s, nor any service/s that may exist before or be constructed after, the time of survey, or constructed under any other approval.

The property boundaries, easements and lot numbers shown hereon may be proposed only and subject to registration by the Department of Natural Resources. All property information should be determined from the registered Survey Plans.

All dimensions should be verified and confirmed against the latest information prior to commencement by any person using this plan for building purposes.

Queensland Surveying Pty Ltd accepts no responsibility for any changes made to construction or otherwise, after the date of this plan. Any discrepancies should be clarified in writing with the relevant Authority prior to commencement of the work.

Copyright © Queensland Surveying Pty Ltd & Veris

company 22/03/2016

THESE DESIGNS AND DRAWINGS ARE COPYRIGHT AND ARE NOT TO BE USED OR REPRODUCED WITHOUT THE WRITTEN PERMISSION OF VERIS

Data Sources

Cadastral Boundaries	30109-LC-Master(BM) FSM 2014.dwg
As-con survey	Veris
Engineering Design	Meinhardt

Issue	Revisions	Date	Drawn
C	Progress Plot	04.04.2019	JMc
B	Progress Plot	02.04.2019	JMc
A	Progress Plot	01.03.2019	JMc

Local Authority:	LCC
Horizontal Meridian:	MGA
Vertical Level Datum:	AHD D
Level Origin:	PM107142(RL39.078)
Scale:	1:500 @ A1
Surveyed:	DWE
Designed:	MEINHARDT
Drawn:	JMc
Checked:	JMc
Plot Date:	04 Apr, 2019
Computer File Ref:	30109-11249 AW01(C) MGA56.dwg

AS-CONSTRUCTED
WATER
RETICULATION

veris

BRISBANE (07) 3666 4700
WHITSUNDAYS (07) 4946 1722
MACKAY (07) 4951 2911
CAIRNS (07) 4051 6722

veris.com.au

ACN 604 671 374
Queensland Surveying Pty Ltd, a Veris Company

Drawing No 30109-11249-AW01

Issue C