


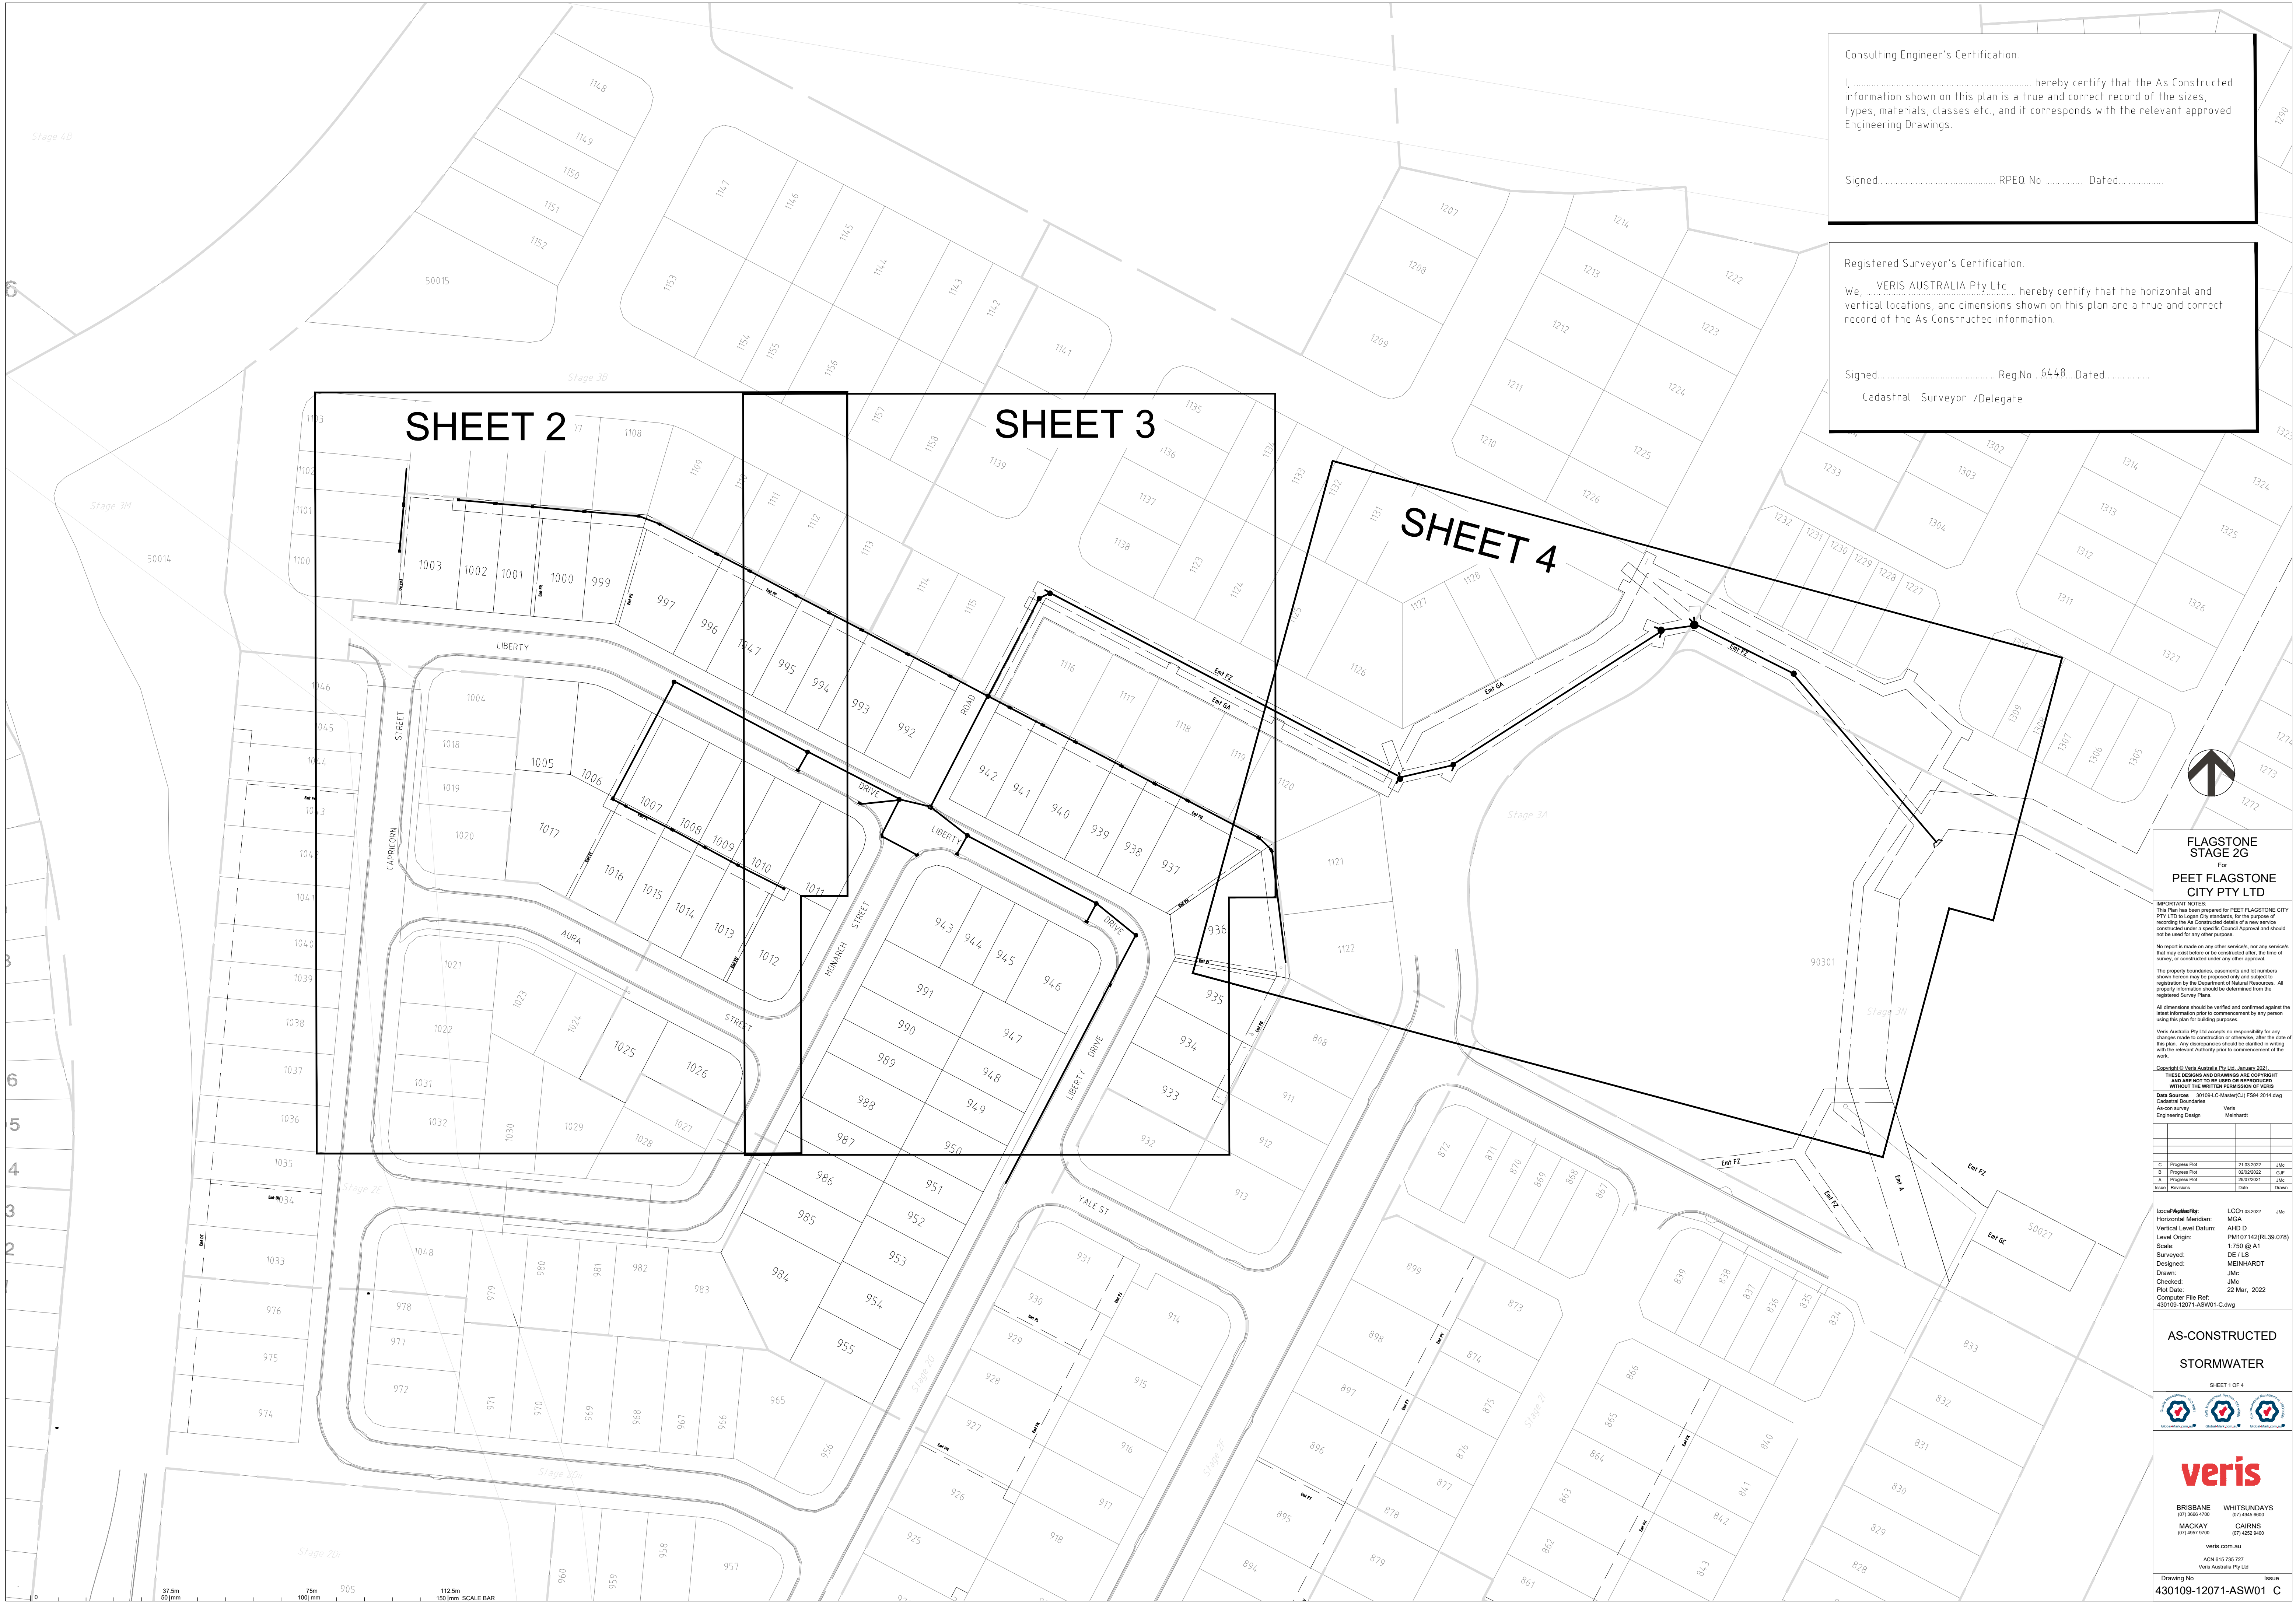

Consulting Engineer's Certification.

I, hereby certify that the As Constructed information shown on this plan is a true and correct record of the sizes, types, materials, classes etc., and it corresponds with the relevant approved Engineering Drawings.

Signed..... RPEQ No Dated.....

Registered Surveyor's Certification.

We, VERIS AUSTRALIA Pty Ltd, hereby certify that the horizontal and vertical locations, and dimensions shown on this plan are a true and correct record of the As Constructed information.

Signed..... Reg.No .6448...Dated.....

Cadastral Surveyor /Delegate

FLAGSTONE
STAGE 2G

PEET FLAGSTONE
CITY PTY LTD

IMPORTANT NOTES

This Plan has been prepared for PEET FLAGSTONE CITY PTY LTD in Logan City standards, for the purpose of recording the As Constructed details of a new service constructed under a specific Council Approval and should not be used for any other purpose.

No report is made on any other services, nor any services that may exist before or be constructed after the time of survey, or constructed under any other approval.

The property boundaries, easements and lot numbers shown herein may be proposed only and subject to registration by the Department of Natural Resources. All property information should be determined from the registered Survey Plans.

All dimensions should be verified and confirmed against the latest information prior to commencement by any person using this plan for building purposes.

Veris Australia Pty Ltd accepts no responsibility for any changes made to construction or otherwise, after the date of this plan. Any discrepancies should be clarified in writing with the relevant Authority prior to commencement of the work.

Copyright © Veris Australia Pty Ltd, January 2022

These issues and drawings are copyright and are not to be used or reproduced without the written permission of Veris

Data Sources 30109-C-Alaster(CA) FSM 2014.dwg

Cadastral Boundaries

As-con survey Veris

Engineering Design Meinhardt

C	Progress Plot	21/03/2022	JMc
B	Progress Plot	02/02/2022	oLP
A	Progress Plot	26/02/2021	JMc
	Revision	Date	Drawn

Local Authority: LCC

Horizontal Meridian: MGA

Vertical Level Datum: AHD D

Level Origin: PM107142(RL39.078)

Scale: 1:750 @ A1

Surveyed: DE / LS

Designed: MEINHARDT

Drawn: JMc

Checked: JMc

Plot Date: 22 Mar, 2022

Computer File Ref: 430109-12071-ASW01-C.dwg

AS-CONSTRUCTED

STORMWATER

SHEET 1 OF 4

veris

BRISBANE
(07) 3661 4700
MACKAY
(07) 4907 8700

WHITSUNDAYS
(07) 4665 6000
CAIRNS
(07) 4252 5400

veris.com.au
ACN 615 735 727
Veris Australia Pty Ltd

Drawing No

Issue

430109-12071-ASW01 C



Stage 3B

Consulting Engineer's Certification.

I, hereby certify that the As Constructed information shown on this plan is a true and correct record of the sizes, types, materials, classes etc., and if corresponds with the relevant approved Engineering Drawings.


Signed..... RPEQ No Dated.....

Registered Surveyor's Certification.

We, VERIS AUSTRALIA Pty Ltd hereby certify that the horizontal and vertical locations, and dimensions shown on this plan are a true and correct record of the As Constructed information.

Signed..... Reg.No. 6448.....Dated.....

Cadastral Surveyor /Delegate

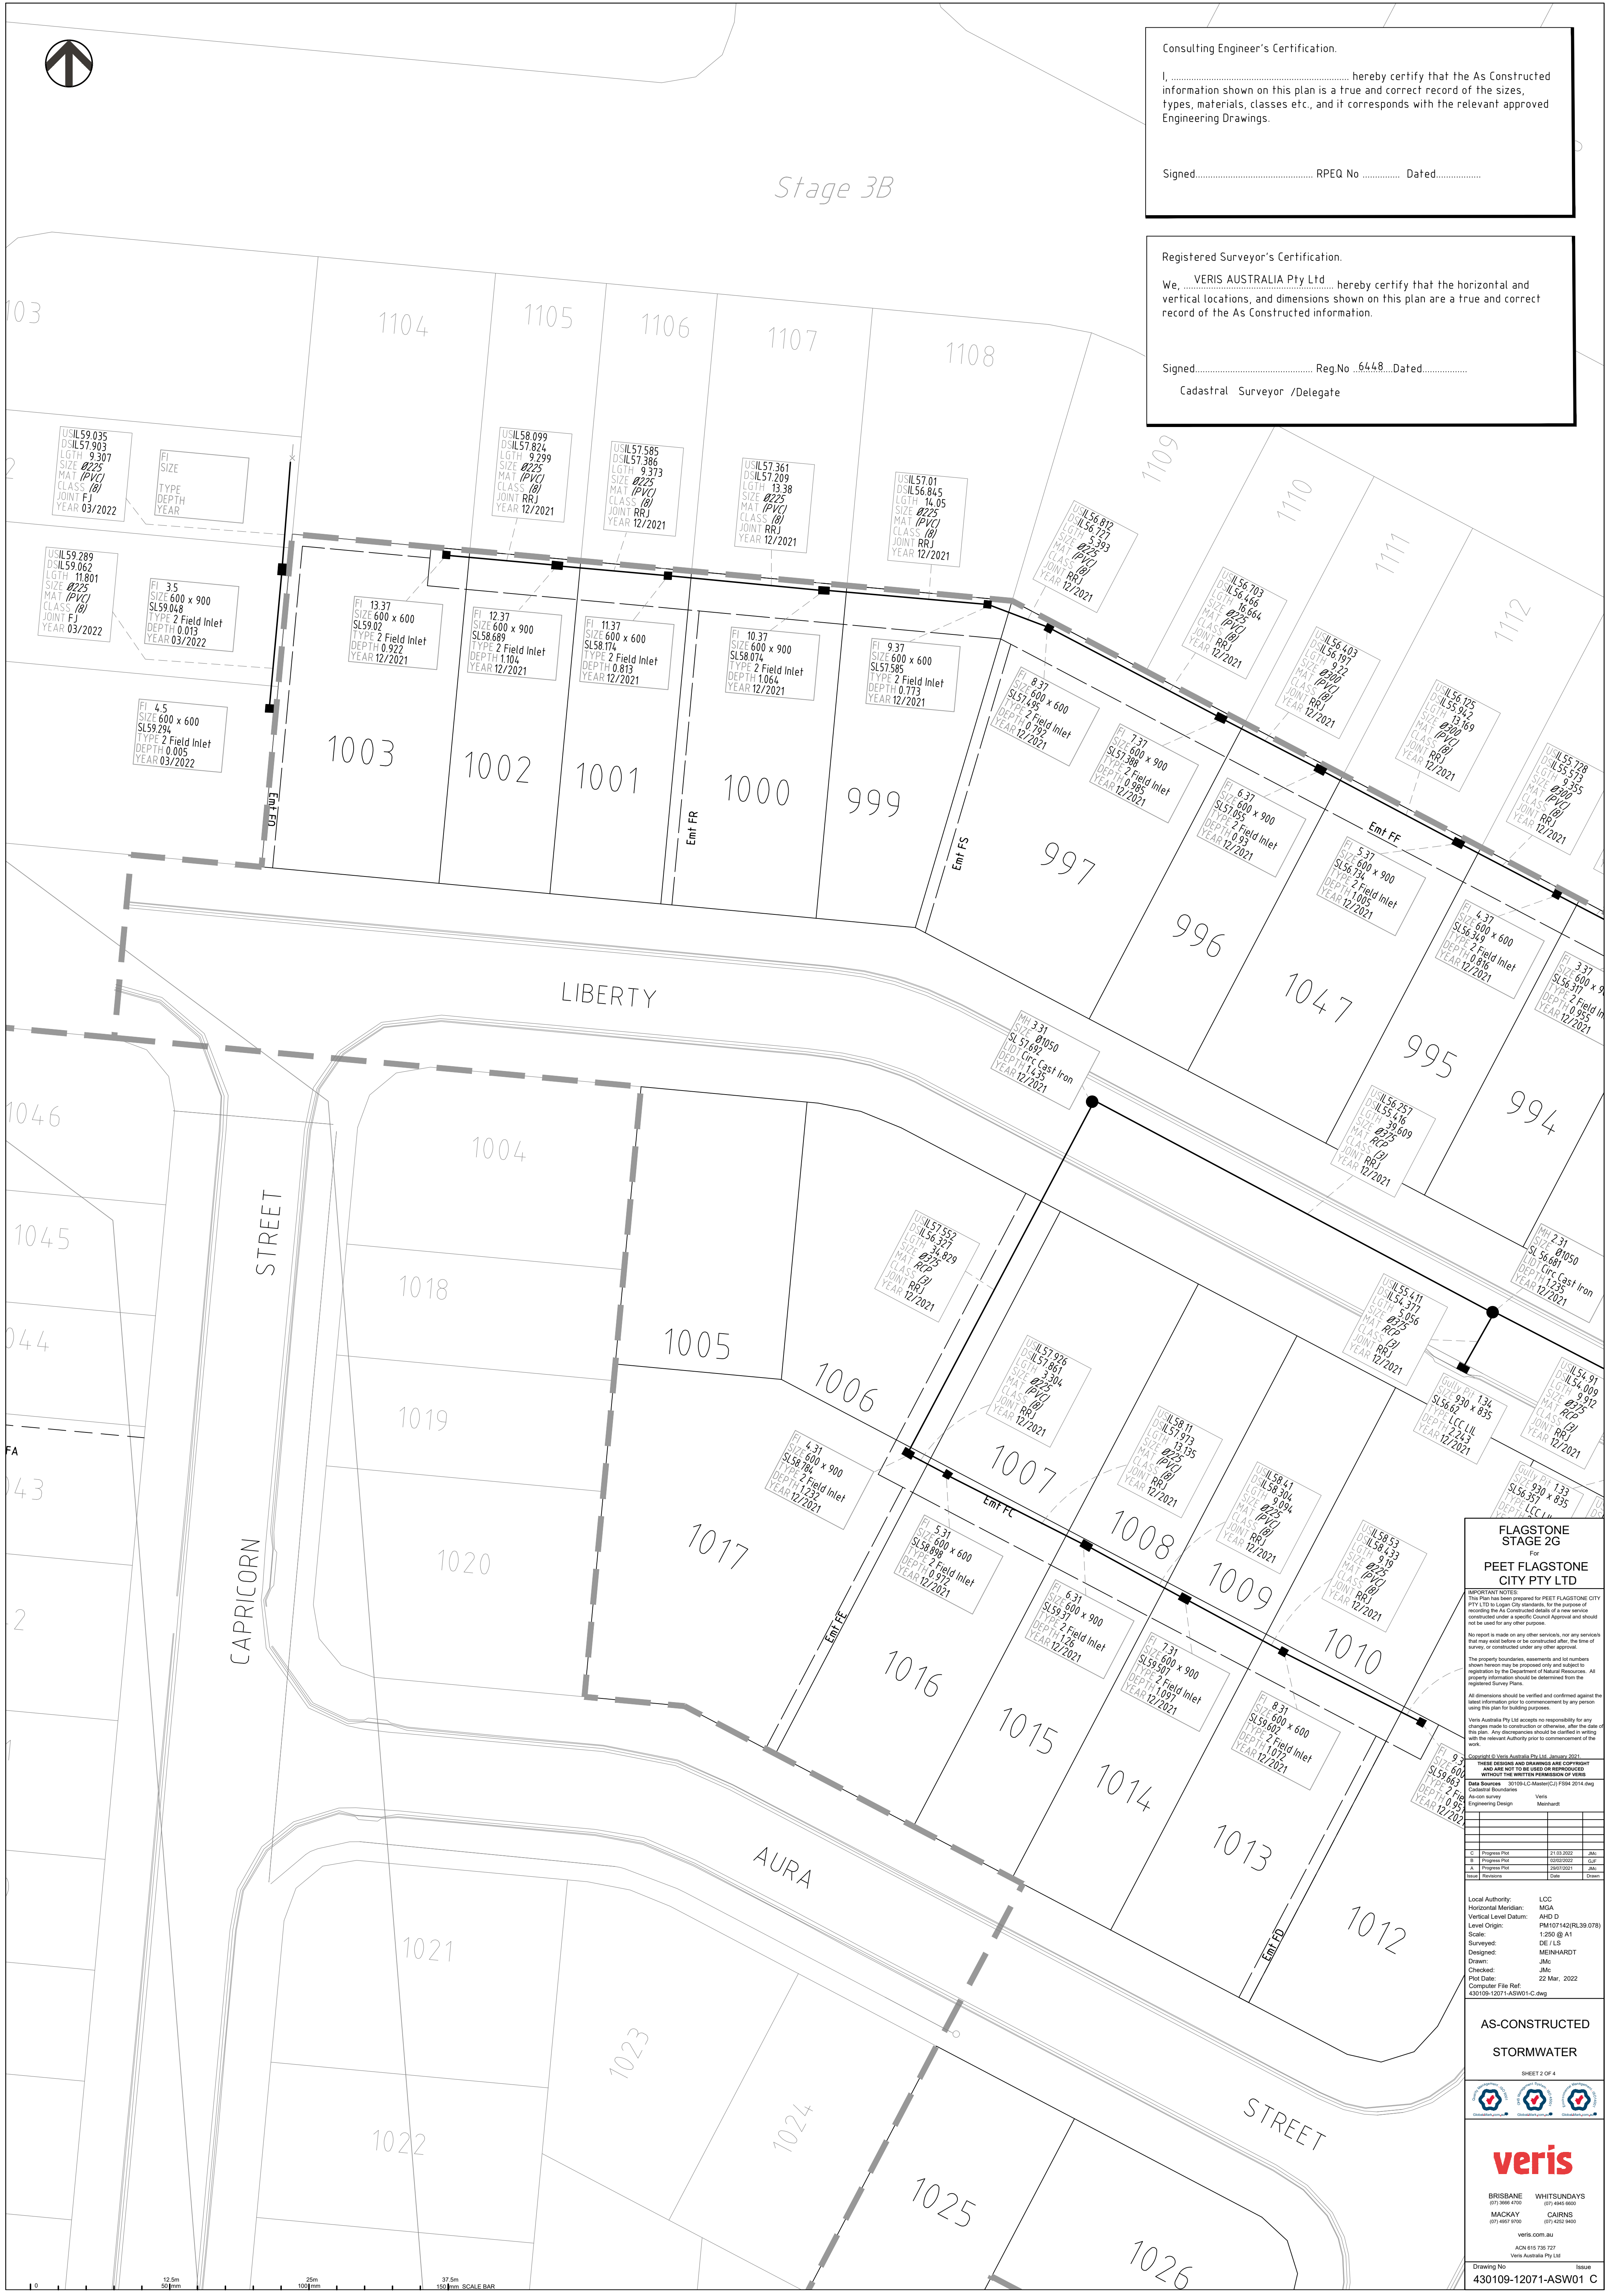

FLAGSTONE
STAGE 2G
For
PEET FLAGSTONE
CITY PTY LTD

IMPORTANT NOTES:
This Plan has been prepared for PEET FLAGSTONE CITY PTY LTD to be used for the purpose of recording the As Constructed details of a new service controlled under a specific Council Approval and should not be used for any other purpose.

No report is made on any other services, nor any services that may exist below or be constructed after the time of survey, or controlled under any other approval.

The property boundaries, easements and lot numbers shown herein may be provided only and subject to registration by the Department of Natural Resources. All property information should be determined from the registered Survey Plans.

All dimensions should be verified and confirmed against the latest information prior to commencement by any person using this plan for building purposes.

Veris Australia Pty Ltd accepts no responsibility for any changes made to construction or otherwise, after the date of this plan. Any discrepancies should be clarified in writing with the relevant Authority prior to commencement of the work.

Copyright © Veris Australia Pty Ltd, January 2022.
These DESIGNS AND DRAWINGS ARE COPYRIGHTED AND ARE NOT TO BE REPRODUCED OR REPRODUCED WITHOUT THE WRITTEN PERMISSION OF VERIS.



Local Authority: LCC
Horizontal Meridian: MGA
Vertical Level Datum: AHD D
Level Origin: PM1107142(RL39.078)
Scale: 1:250 @ A1
Surveyed: DE / LS
Designed: MEIN-HARDT
Drawn: JMc
Checked: JMc
Plot Date: 22 Mar, 2022
Computer File Ref: 430109-12071-ASW01-C.dwg

AS-CONSTRUCTED
STORMWATER
SHEET 2 OF 4

BRISBANE
(07) 386 4700

WHITSUNDAYS
(07) 466 6600

MACKAY
(07) 4967 0700

CAIRNS
(07) 4252 9400

veris.com.au
ACN 615 735 721
Veris Australia Pty Ltd

Drawing No 430109-12071-ASW01 C Issue

Consulting Engineer's Certification.

I, hereby certify that the As Constructed information shown on this plan is a true and correct record of the sizes, types, materials, classes etc., and it corresponds with the relevant approved Engineering Drawings.

Signed..... RPEQ No Dated.....

Registered Surveyor's Certification.

We, VERIS AUSTRALIA Pty Ltd hereby certify that the horizontal and vertical locations, and dimensions shown on this plan are a true and correct record of the As Constructed information.

Signed..... Reg.No. 64448 Dated.....

Cadastral Surveyor /Delegate



FLAGSTONE
STAGE 2G
For
PEET FLAGSTONE
CITY PTY LTD

IMPORTANT NOTES
This Plan has been prepared for PEET FLAGSTONE CITY PTY LTD to Lagan City standards, for the purpose of recording the As Constructed details of a new service contributed under a specific Council Approval and should not be used for any other purpose.

No report is made on any other services, nor any services that may exist before or be constructed after, the time of survey, or contributed under any other approval.

The property boundaries, assessments and lot numbers shown herein may be updated only and subject to registration by the Department of Natural Resources. All property information should be determined from the registered Survey Plans.

All dimensions should be verified and confirmed against the latest information prior to commencement by any person using this plan for building purposes.

Veris Australia Pty Ltd accepts no responsibility for any changes made to construction or otherwise, after the date of this plan. Any discrepancies should be clarified in writing with the relevant Authority prior to commencement of the work.

Copyright © Veris Australia Pty Ltd, January 2021
THESE DESIGNS AND DRAWINGS ARE COPYRIGHT AND ARE NOT TO BE USED OR REPRODUCED WITHOUT THE WRITTEN PERMISSION OF VERIS.

Date Sources: 30/10/2014-C-Master(C) FSN 2014.dwg
Cadastral Boundaries: Veris
As-con survey: Veris
Engineering Design: Mainhardt

C	Progress Plot	21/03/2022	JAL
B	Progress Plot	03/05/2022	CLP
A	Progress Plot	28/01/2021	JAL
Revised	Revisions	Date	Drawn

Local Authority: LCC
Horizontal Meridian: MGA
Vertical Level Datum: AHD D
Level Origin: PM1107142(RL39.078)
Scale: 1:250 @ A1
Surveyed: DE / LS
Designed: MEINHARDT
Drawn: JMc
Checked: JMc
Plot Date: 22 Mar, 2022
Computer File Ref: 430109-12071-ASW01-C.dwg

AS-CONSTRUCTED
STORMWATER

BRISBANE
(07) 366 4700

WHITSUNDAYS
(07) 466 6000

MACKAY
(07) 466 0700

CAIRNS
(07) 4252 9400

veris.com.au

ACN 615 735 721
Veris Australia Pty Ltd

Drawing No 430109-12071-ASW01 C Issue

