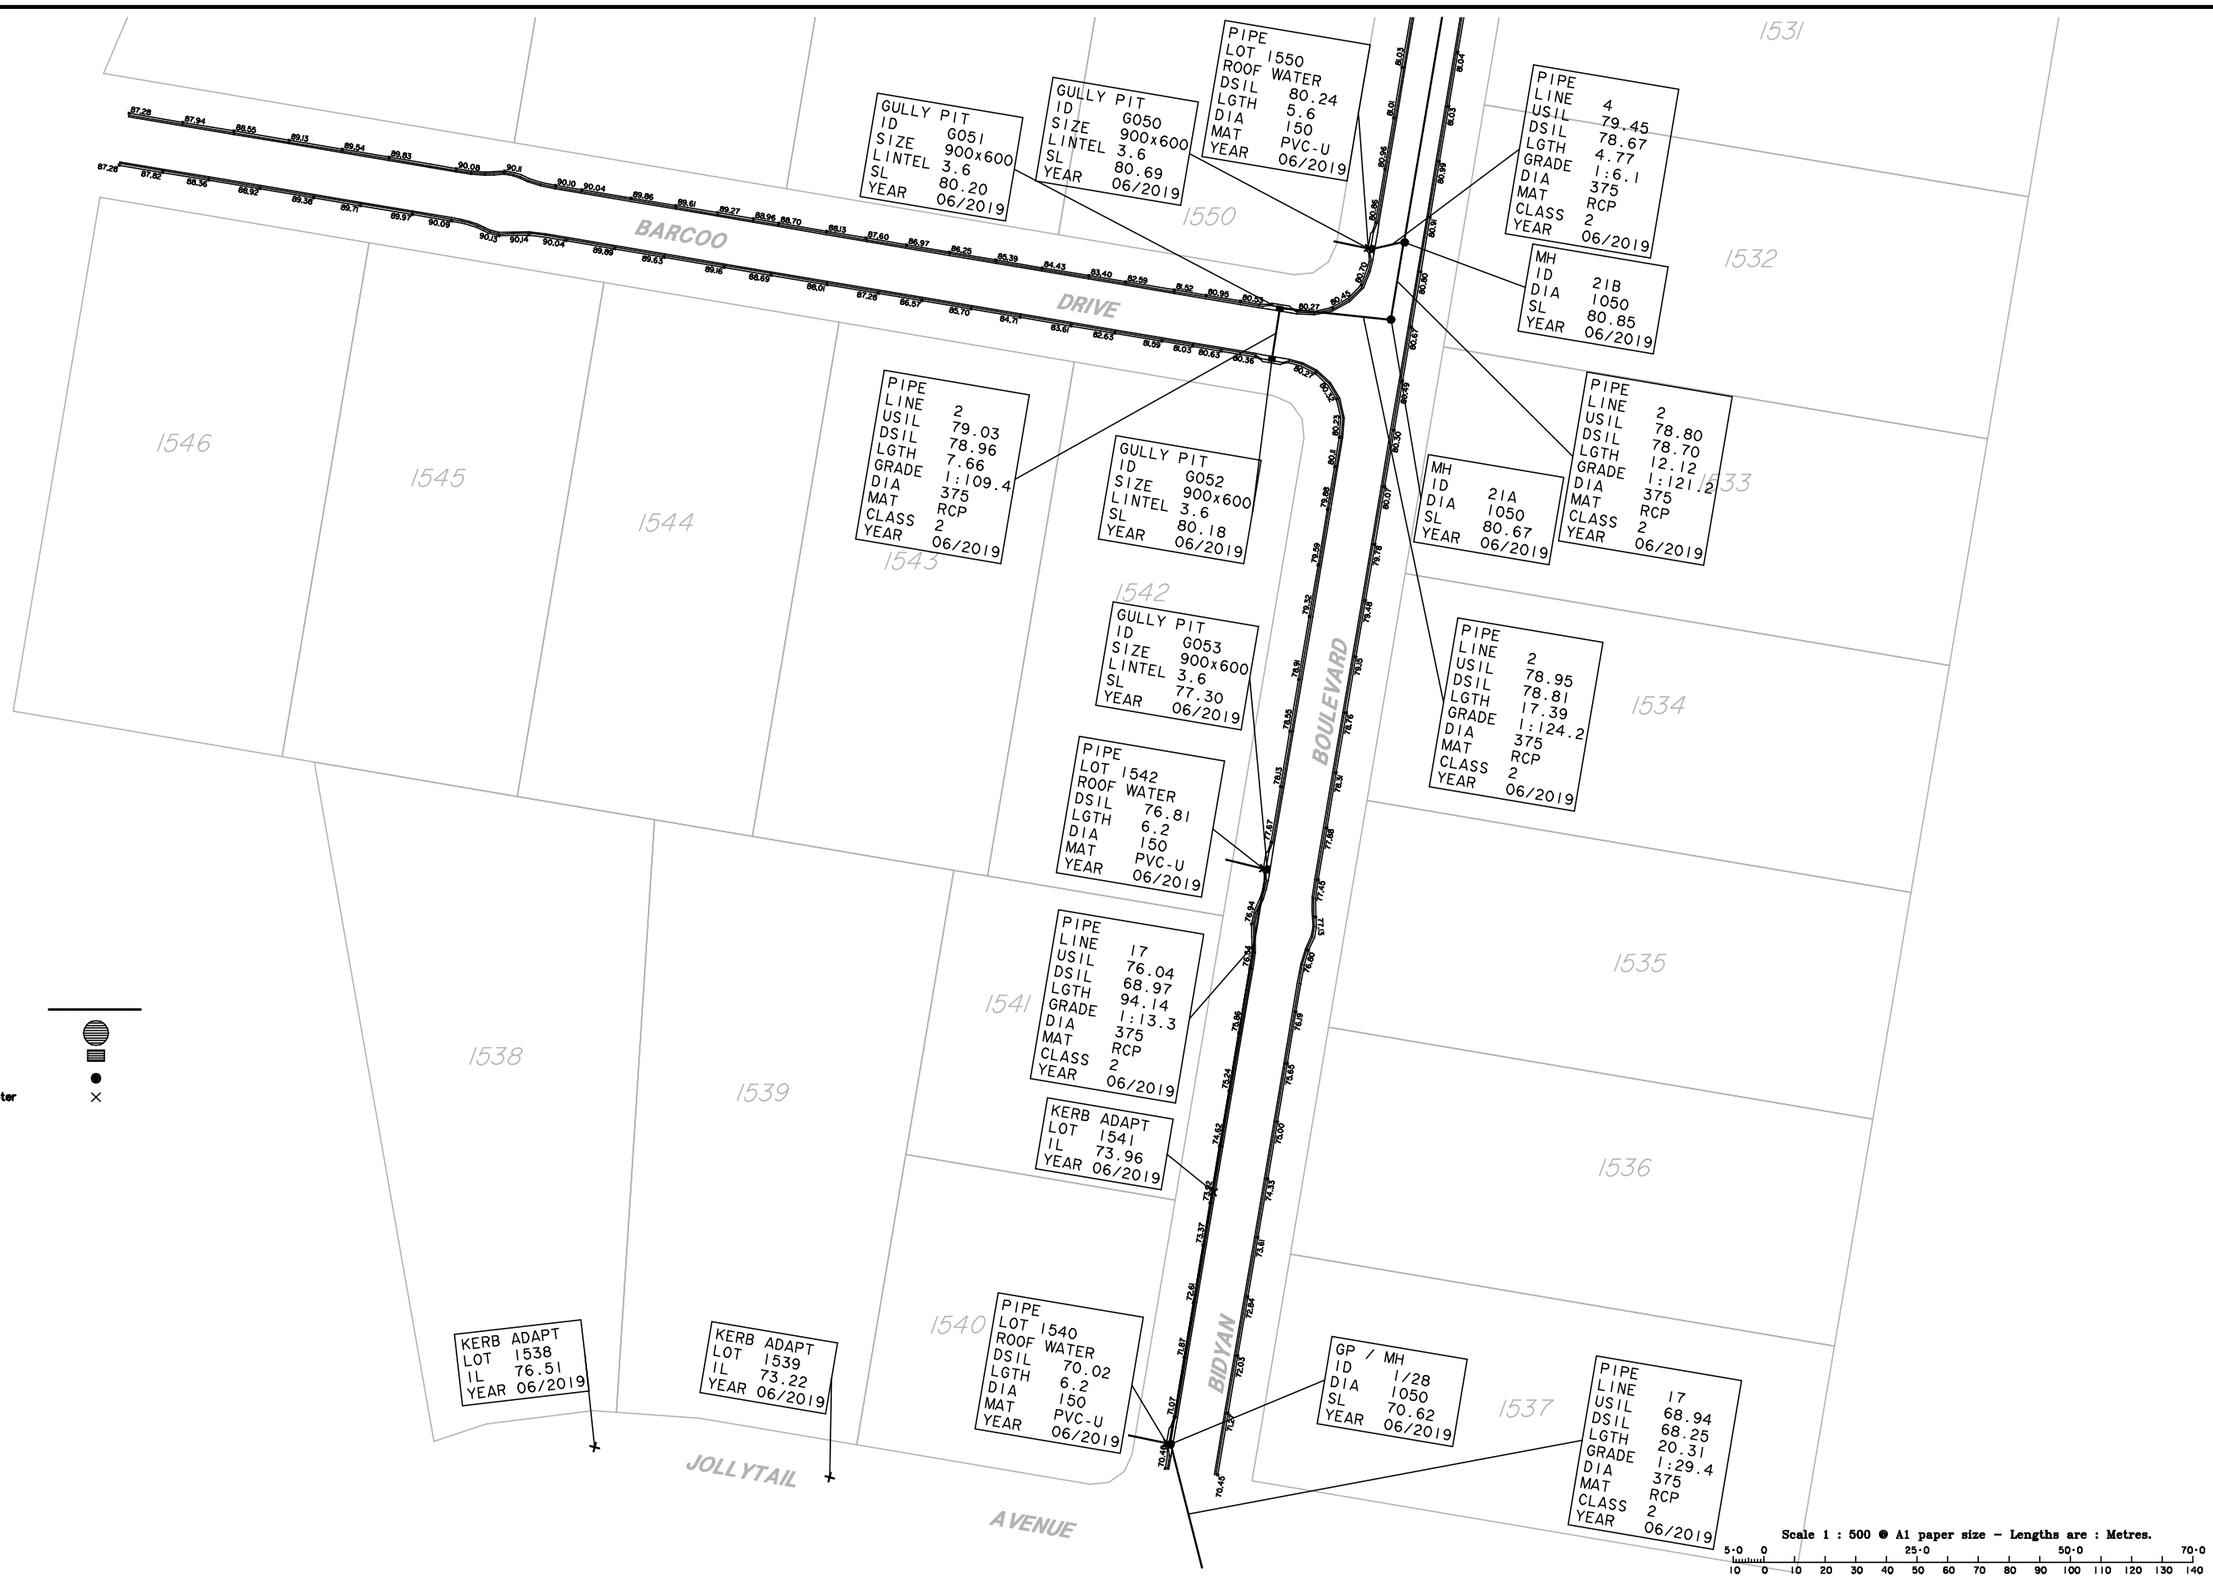

REVISIONS	DATE	BY	CHKD
–	–	–	–

IMPORTANT NOTE.
This Plan has been prepared for Logan City Council for the purpose of recording the As Constructed details of a new service constructed under a specific Council Approval and should not be used for any other purpose. No report is made on any other service/s, nor any service/s that may exist before or be constructed after, the time of survey, or constructed under any other approval. The property boundaries, easements and lot numbers shown hereon may be proposed only and subject to registration by the Department of Natural Resources & Mines. All property information should be determined from the registered Survey Plans.

THIS NOTE IS AN INTEGRAL PART OF THIS PLAN.

SCHLENCKER SURVEYING (QLD)
Consultants in Surveying, Mapping & Engineering
Rockhampton . Brisbane . Gold Coast

Registered Surveyor's Certification :

I, Bruce Victor DALTON hereby certify that the vertical and horizontal locations, and dimensions shown on this plan are a true and correct record of the As Constructed information.

Signed ..... Date 21/6/2019
For and on behalf of Schlencker Surveying (Qld) Pty. Ltd.

Consulting Engineer's Certification :

1. I state the the works described on this drawing have been constructed under my supervision, and I or my authorised representatives have inspected the works at all stages of construction.

2. I certify that the works have been constructed in accordance with the development approval, the approved drawings, the Logan Planning Scheme 2006 and any relevant planning scheme policies and standards specifications.

3. I certify the approved drawings have been carefully compared with the site works as to line, levels and dimensions, and this drawing has been accurately amended : all respects as to constitute a true record of the works.

Project Name: SPRING MOUNTAIN STAGE 15A
Company: KN GROUP PTY LTD
Consultant: GEOFFREY GREENHALGH
RPEQ/CPEng Membership No.: 1988

;Signature ..... Date .....

SURVEYOR : PAN
DRAWN BY : SPR
JOB NO : 15159
LOCAL AUTHORITY : LOGAN
PARISH : STAPYLTON
COUNTY : STANLEY
LEVEL DATUM : AHD Der
LEVEL ORIGIN : PM61324
RL : 69.322

AS CONSTRUCTED DRAINAGE
Spring Mountain Estate, Stage 15A
GREENBANK

OW / 334 / 2018
RL / 44 / 2008 / E

SHEET : 1 OF 2
SCALE: 1:500 (@A1)
PLAN NO: 15159-69

Plotted Jul 1,2019 12:06:19 Mon
J:\15159 PEET - Spring Mountain 15-18\120 Data\190513 15A Ascon\15159-190513 15A Asconstructed Working.pro