LEGEND

FH	FIRE HYDRANT
TEE	TEE
TB	TAPPING BAND
HB	HORIZONTAL BEND
SV	STOP/GATE VALVE
	WATER MAIN (DICL PN35)
	WATER MAIN (PVC-M PN16)
	SERVICE PIPE (ø25 PVC-U PN16)
	CONDUIT PIPE (ø100 PVC-M PN9)
ex_w	EXISTING WATER MAIN

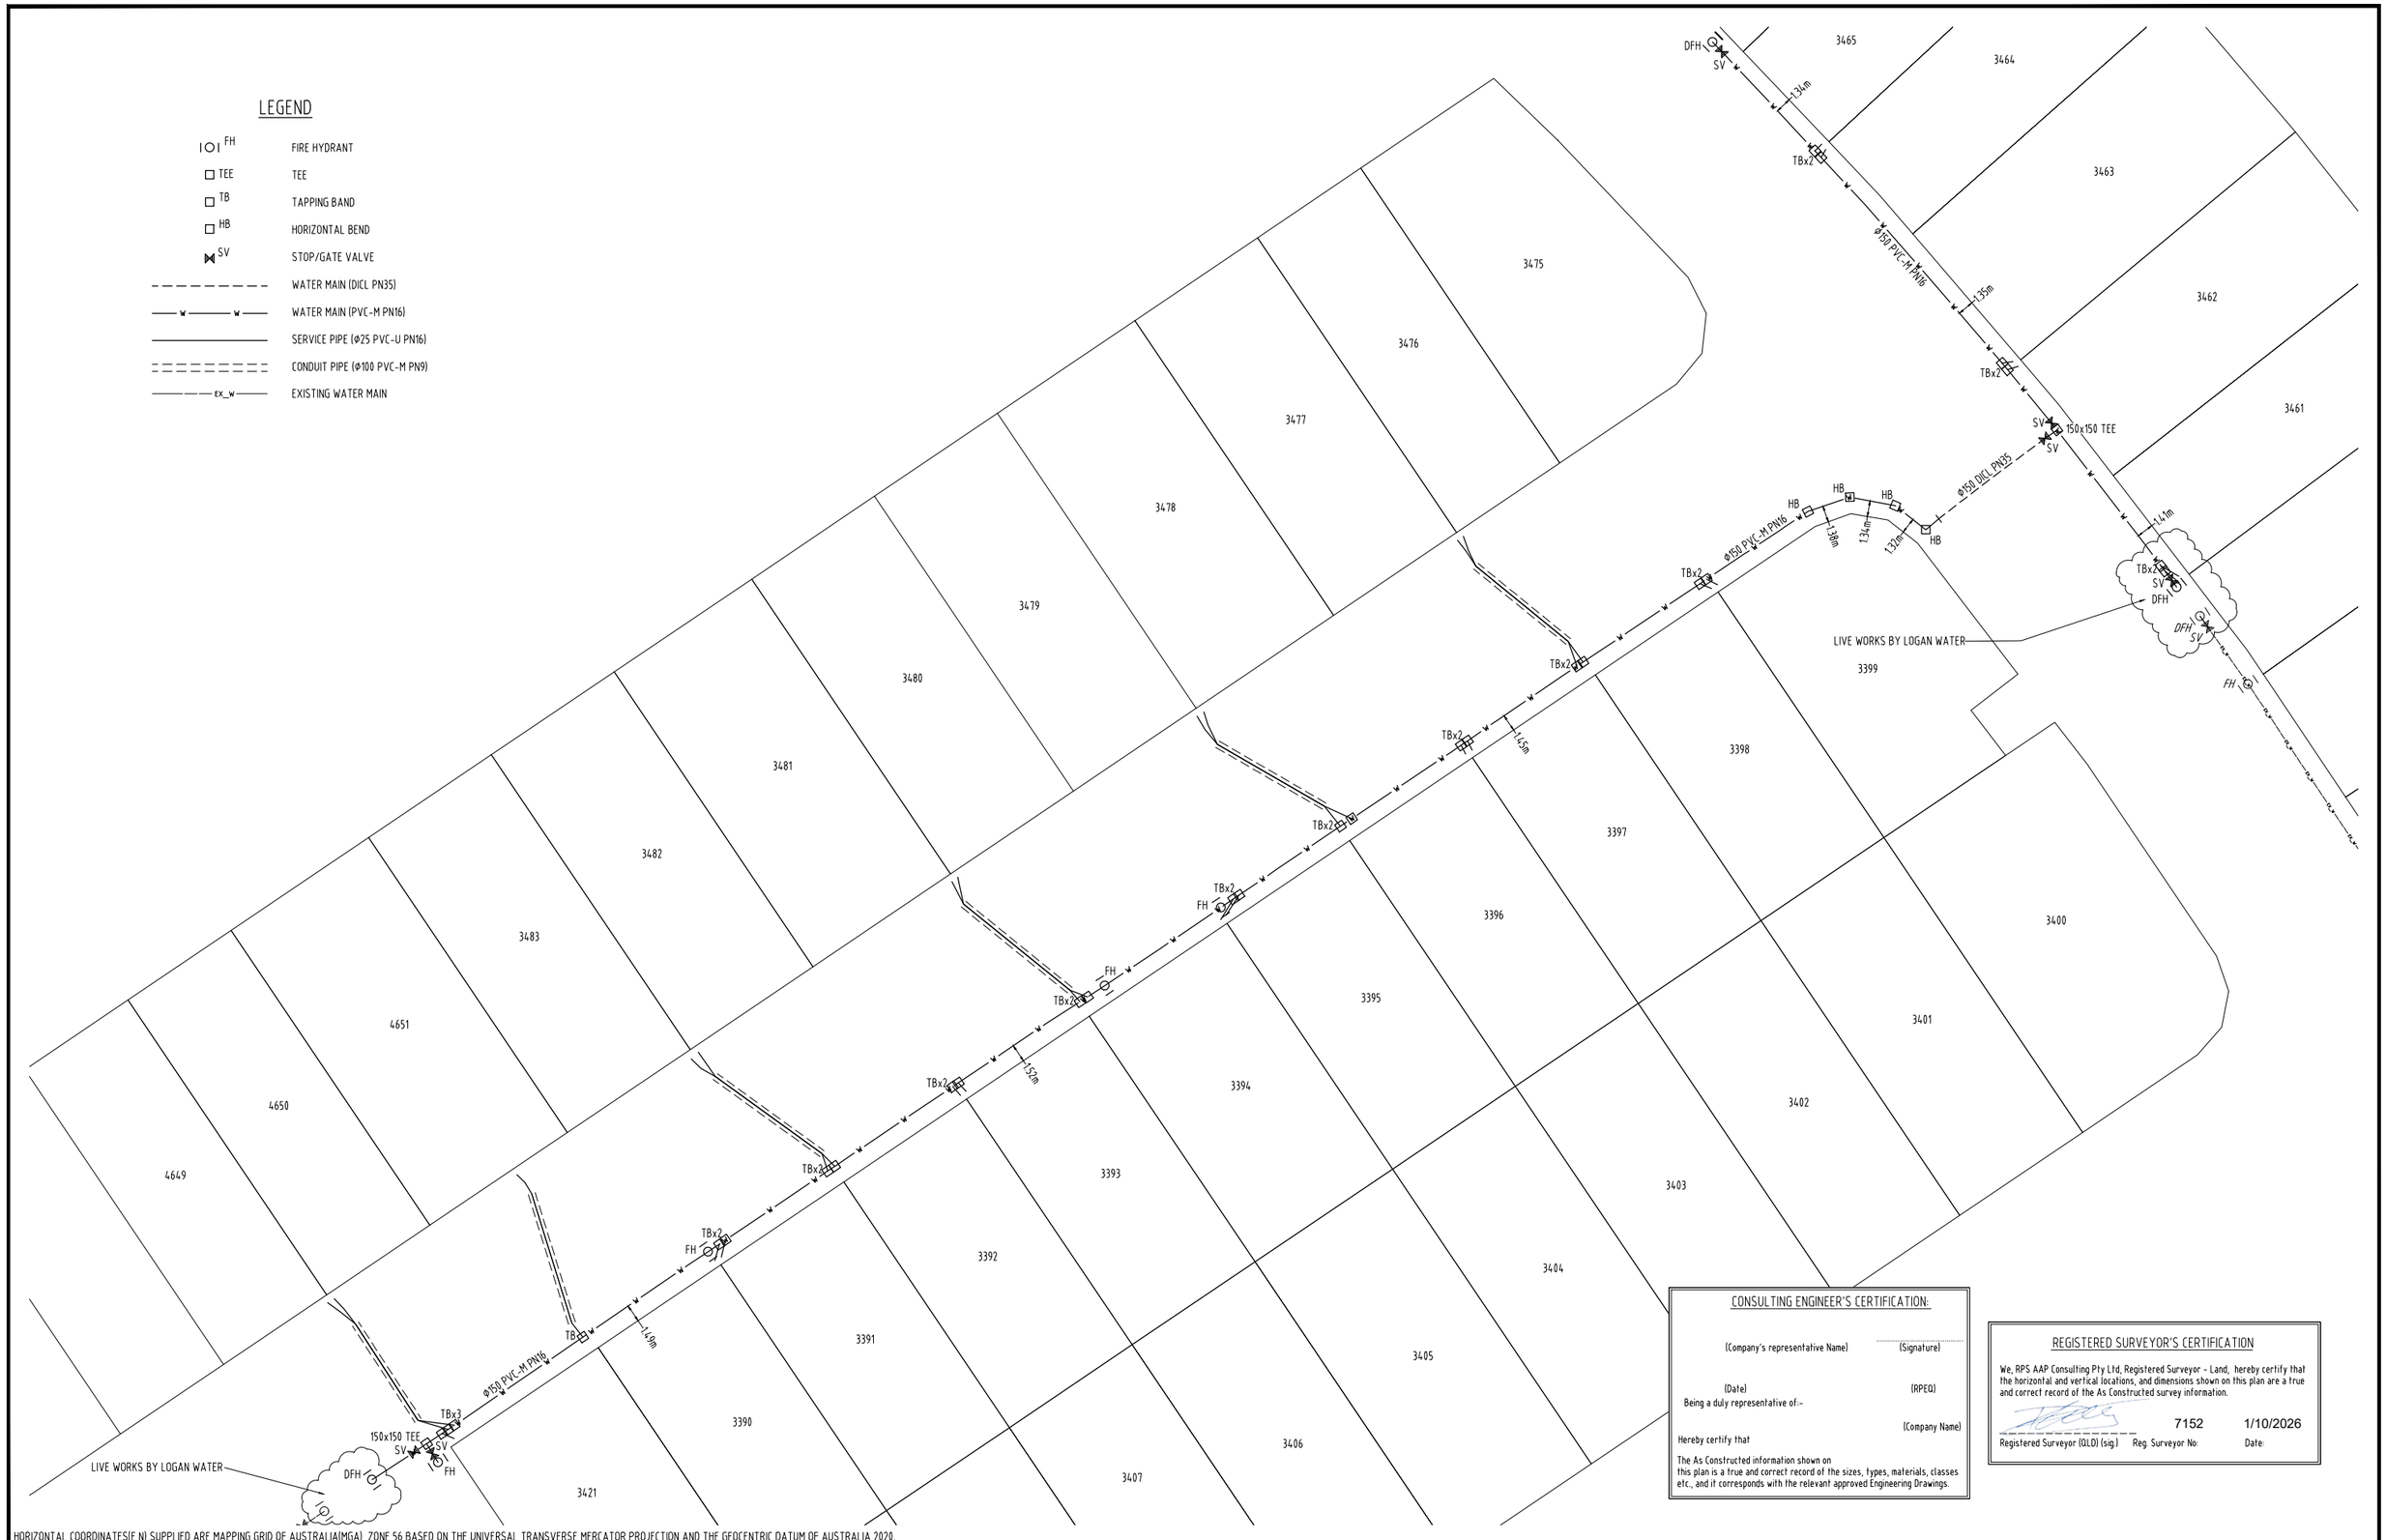

HORIZONTAL COORDINATES(E,N) SUPPLIED ARE MAPPING GRID OF AUSTRALIA(MGA), ZONE 56 BASED ON THE UNIVERSAL TRANSVERSE MERCATOR PROJECTION AND THE GEOCENTRIC DATUM OF AUSTRALIA 2020.

CONSULTING ENGINEER'S CERTIFICATION:

(Company's representative Name) (Signature)

(Date) (RPEQ)

Being a duly representative of:-

(Company Name)

Hereby certify that

The As Constructed information shown on this plan is a true and correct record of the sizes, types, materials, classes etc., and it corresponds with the relevant approved Engineering Drawings.

REGISTERED SURVEYOR'S CERTIFICATION

We, RPS AAP Consulting Pty Ltd, Registered Surveyor - Land, hereby certify that the horizontal and vertical locations, and dimensions shown on this plan are a true and correct record of the As Constructed survey information.

Registered Surveyor (QLD) (sig.) | Reg. Surveyor No: 7152 | Date: 1/10/2026

A1

INDEX	DATE	REVISIONS	DRAWN	CHECKED	PASSED
----	----	----	----	----	----
----	----	----	----	----	----
----	----	----	----	----	----
B	28/09/26	AMENDED AS CONTRUCTED	RG	DF	DJL
A	29/07/2026	ISSUED AS CONSTRUCTED	JPD	DF	----

APPROVED OPERATIONAL WORKS NUMBER: DEV2012/403

DRAWN	RG	28/09/2026
CHECKED	DF	1/10/2026
PASSED	DJL	1/10/2026
	INITIALS	DATE

N

AS CONSTRUCTED

5 2.5 0 2.5 5 7.5 10 12.5

SCALE OF METRES
1:250 FULL SIZE A1 SHEET

RPS AAP Consulting Pty Ltd
ACN 117 883 173
ABN 97 117 883 173
Level 8
31 Duncan Street
PO Box 1559
Fortitude Valley QLD 4006
T +61 7 3539 9500
W rpsgroup.com

A TETRA TECH COMPANY
©COPYRIGHT PROTECTS THIS PLAN Unauthorised reproduction or amendment not permitted. Please contact the author.

CITY OF LOGAN

CITY OF LOGAN

FLAGSTONE CITY
STAGE 10B
WATER AS CONSTRUCTED

SCALE 1:250
SHEET 1 OF 1 SHEETS
DRAWING NO. 370977-81
---- ---- ---- B A

\\tf.local\RPO\S1212_BNE\Survey\Projects TLX\TLX370977 - Flagstone\DWG\ADAC\Stage 10\Stage 10B\370977-81 B Flagstone 10B Water.dwg

LEGEND

- MAINTENANCE CHAMEBR (ø600 PE SMARTSTREAM MINI PIT)
- MAINTENANCE HOLE (INSITU CONCRETE)
- HB — HORIZONTAL BEND
- WYE — 150-150 WYE INCLUDING 150-100 REDUCER ON EACH BRANCH
- DEC — DEAD END CAP
- RED — 150-100 REDUCER
- S — S — RETICULATION MAIN (ø150 PVC-U SN8)
- HOUSE CONNECTION (ø100 PVC-U SN10)
- EX_S — EX_S — EXISTING SEWER MAIN

NOTE:
RED FEATURES ARE REPRESENTATIVE OF NON AS-CONSTRUCTED VALUES UNTIL CONSTRUCTION IN COMPLETED

CONSULTING ENGINEER'S CERTIFICATION:

(Company's representative Name) (Signature)

(Date) (RPEQ)

Being a duly representative of:-

(Company Name)

Hereby certify that

The As Constructed information shown on this plan is a true and correct record of the sizes, types, materials, classes etc., and it corresponds with the relevant approved Engineering Drawings.

REGISTERED SURVEYOR'S CERTIFICATION

We, RPS AAP Consulting Pty Ltd, Registered Surveyor - Land, hereby certify that the horizontal and vertical locations, and dimensions shown on this plan are a true and correct record of the As Constructed survey information.

Registered Surveyor (QLD) (sig.) | Reg. Surveyor No: 7152 | Date: 1/10/2026

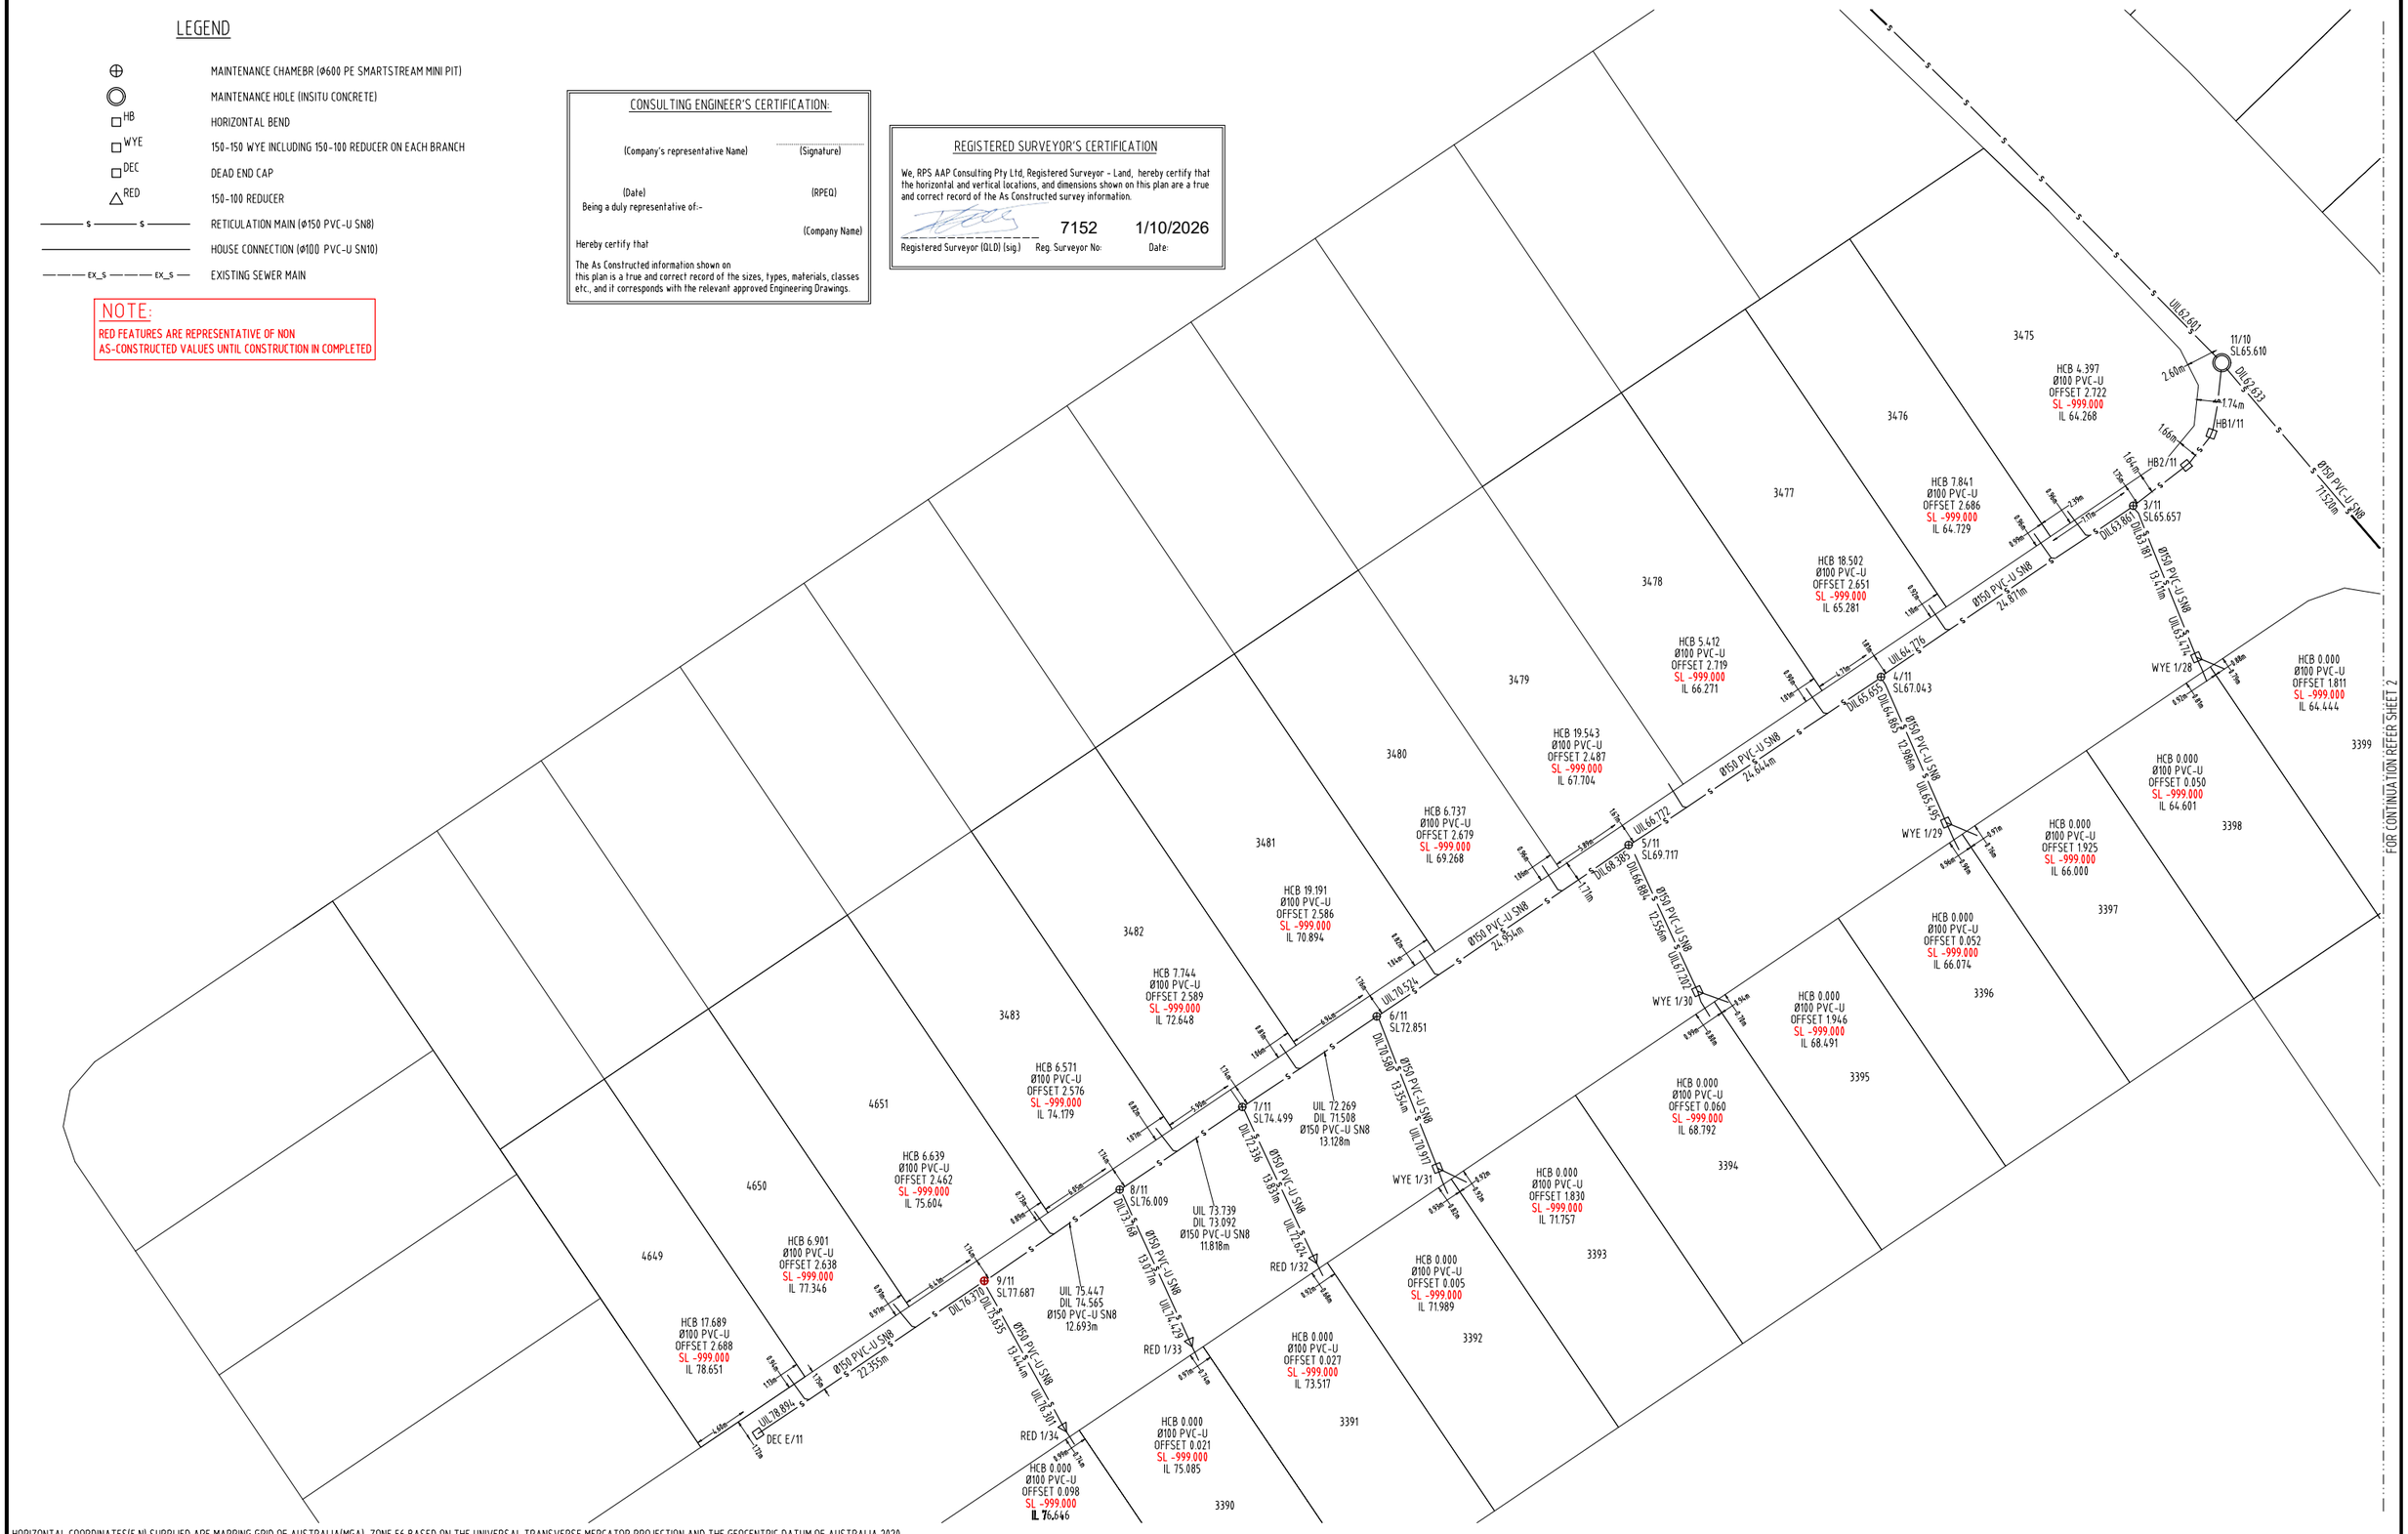

HORIZONTAL COORDINATES(E,N) SUPPLIED ARE MAPPING GRID OF AUSTRALIA(MGA), ZONE 56 BASED ON THE UNIVERSAL TRANSVERSE MERCATOR PROJECTION AND THE GEOCENTRIC DATUM OF AUSTRALIA 2020.

A1

INDEX	DATE	REVISIONS	DRAWN	CHECKED	PASSED
----	----	----	----	----	----
----	----	----	----	----	----
----	----	----	----	----	----
B	28/09/2026	AMENDED AS CONSTRUCTED	RG	DF	DJL
A	13/08/2026	ISSUED AS CONSTRUCTED	JDP	DF	DL

APPROVED OPERATIONAL WORKS NUMBER: DEV2012/403

	INITIALS	DATE
DRAWN	RG	25/09/2026
CHECKED	DF	1/10/2026
PASSED	DJL	1/10/2026

AS CONSTRUCTED

5 2.5 0 2.5 5 7.5 10 12.5

SCALE OF METRES
1:250 FULL SIZE A1 SHEET

RPS AAP Consulting Pty Ltd
ACN 117 883 173
ABN 97 117 883 173

Level 8
31 Duncan Street
PO Box 1559
Fortitude Valley QLD 4006

T +61 7 3539 9500
W rpsgroup.com

©COPYRIGHT PROTECTS THIS PLAN
Unauthorised reproduction or amendment not permitted. Please contact the author.

CITY OF LOGAN

CITY OF LOGAN

FLAGSTONE CITY
STAGE 10B
SEWER AS CONSTRUCTED

SCALE 1:250
SHEET 1 OF 2 SHEETS
DRAWING NO. 370977-93

\\tf.local\RPO\S1212_BNE\Survey\Projects TLX\TLX370977 - Flagstone\DWG\ADAC\Stage 10\Stage 10B\370977-93 B Stage 10B Sewer.dwg

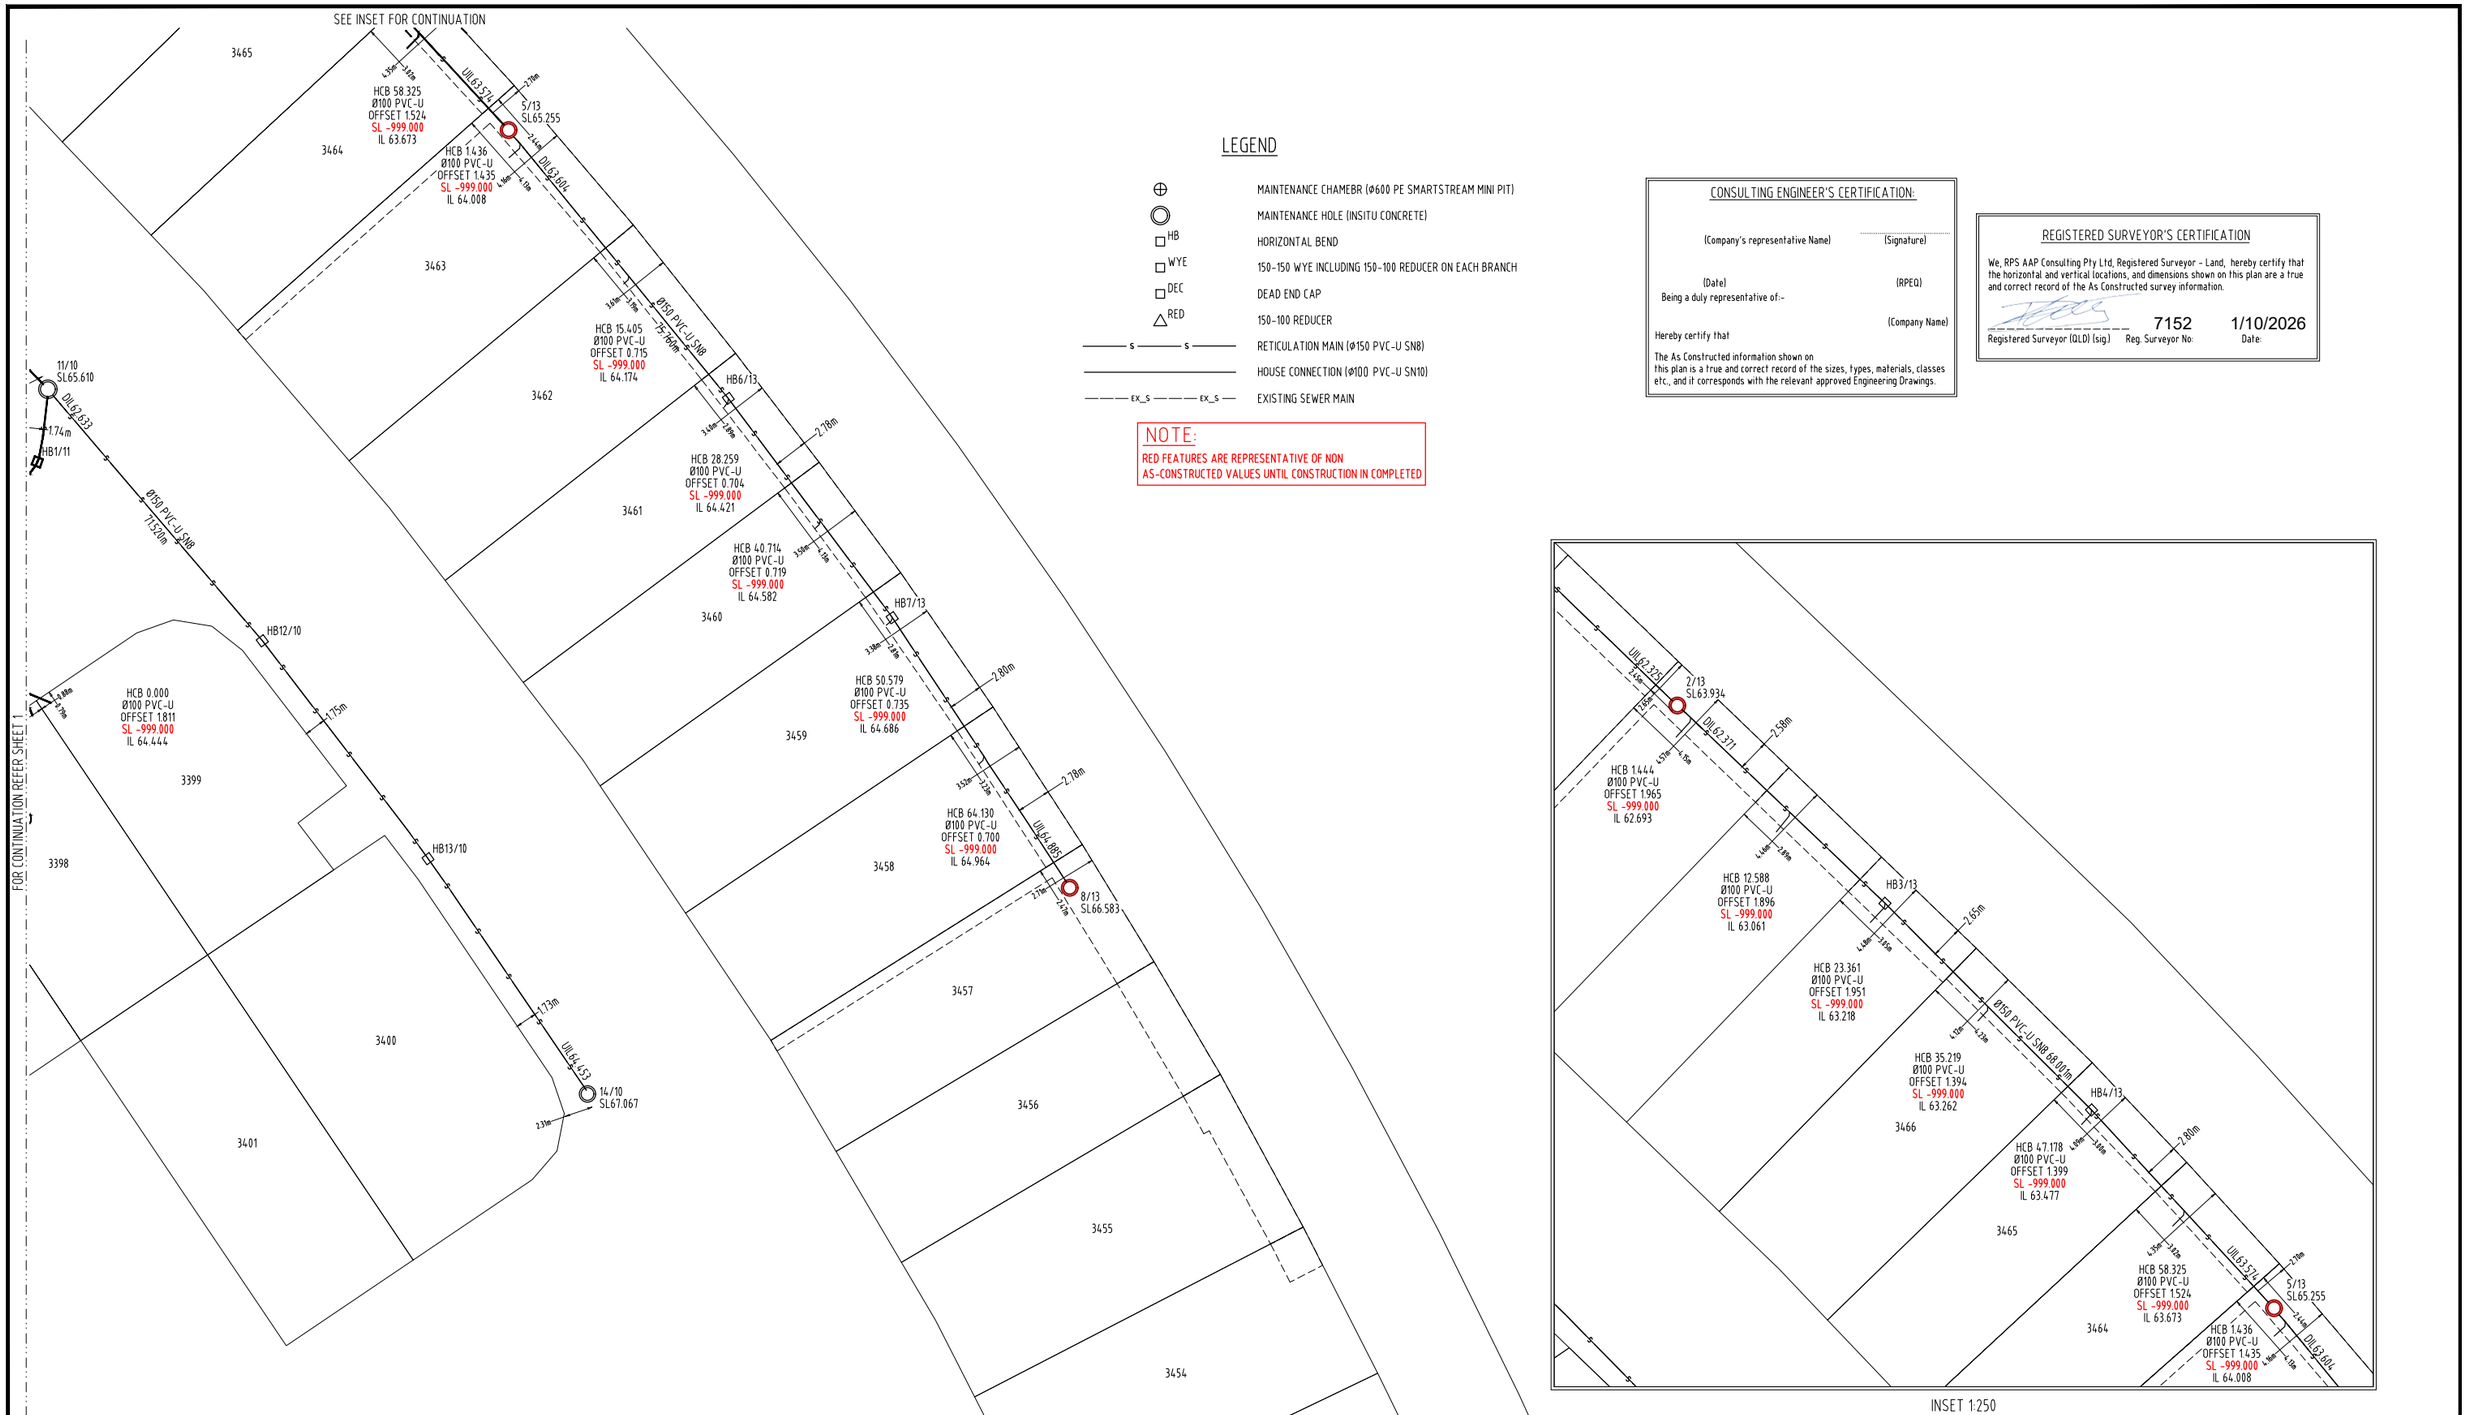

LEGEND

- MAINTENANCE CHAMEBR (Ø600 PE SMARTSTREAM MINI PIT)
- MAINTENANCE HOLE (INSITU CONCRETE)
- HB — HORIZONTAL BEND
- WYE — 150-150 WYE INCLUDING 150-100 REDUCER ON EACH BRANCH
- DEC — DEAD END CAP
- RED — 150-100 REDUCER
- s — s — RETICULATION MAIN (Ø150 PVC-U SN8)
- HOUSE CONNECTION (Ø100 PVC-U SN10)
- ex_s — ex_s — EXISTING SEWER MAIN

NOTE:
RED FEATURES ARE REPRESENTATIVE OF NON AS-CONSTRUCTED VALUES UNTIL CONSTRUCTION IN COMPLETED

CONSULTING ENGINEER'S CERTIFICATION:

(Company's representative Name) ..... (Signature)

(Date) (RPEQ)

Being a duly representative of:-

(Company Name)

Hereby certify that

The As Constructed information shown on this plan is a true and correct record of the sizes, types, materials, classes etc., and it corresponds with the relevant approved Engineering Drawings.

REGISTERED SURVEYOR'S CERTIFICATION

We, RPS AAP Consulting Pty Ltd, Registered Surveyor - Land, hereby certify that the horizontal and vertical locations, and dimensions shown on this plan are a true and correct record of the As Constructed survey information.

Registered Surveyor (QLD) (Sig.) | Reg. Surveyor No: 7152 | Date: 1/10/2026

INSET 1:250

HORIZONTAL COORDINATES(E,N) SUPPLIED ARE MAPPING GRID OF AUSTRALIA(MGA), ZONE 56 BASED ON THE UNIVERSAL TRANSVERSE MERCATOR PROJECTION AND THE GEOCENTRIC DATUM OF AUSTRALIA 2020.

A1

INDEX	DATE	REVISIONS	DRAWN	CHECKED	PASSED
----	----	----	----	----	----
----	----	----	----	----	----
----	----	----	----	----	----
B	28/09/2026	AMENDED AS CONSTRUCTED	RG	DF	DJL
A	13/08/2026	ISSUED AS CONSTRUCTED	JDP	DF	DL

APPROVED OPERATIONAL WORKS NUMBER: DEV2012/403

	INITIALS	DATE
DRAWN	RG	25/09/2026
CHECKED	DF	1/10/2026
PASSED	DJL	1/10/2026

N

AS CONSTRUCTED

5 2.5 0 2.5 5 7.5 10 12.5

SCALE OF METRES
1:250 FULL SIZE A1 SHEET

A TETRA TECH COMPANY
©COPYRIGHT PROTECTS THIS PLAN Unauthorised reproduction or amendment not permitted. Please contact the author.

RPS AAP Consulting Pty Ltd
ACN 117 883 173
ABN 97 117 883 173
Level 8
31 Duncan Street
PO Box 1559
Fortitude Valley QLD 4006
T +61 7 3539 9500
W rpsgroup.com

CITY OF LOGAN

CITY OF LOGAN

FLAGSTONE CITY
STAGE 10B
SEWER AS CONSTRUCTED

SCALE 1:250
SHEET 2 OF 2 SHEETS
DRAWING NO. 370977-93

B
A

\\tt.local\RPO\S1212_BNE\Survey\Projects TLX\TLX370977 - Flagstone\DWG\ADAC\Stage 10\Stage 10B\370977-93 B Stage 10B Sewer.dwg

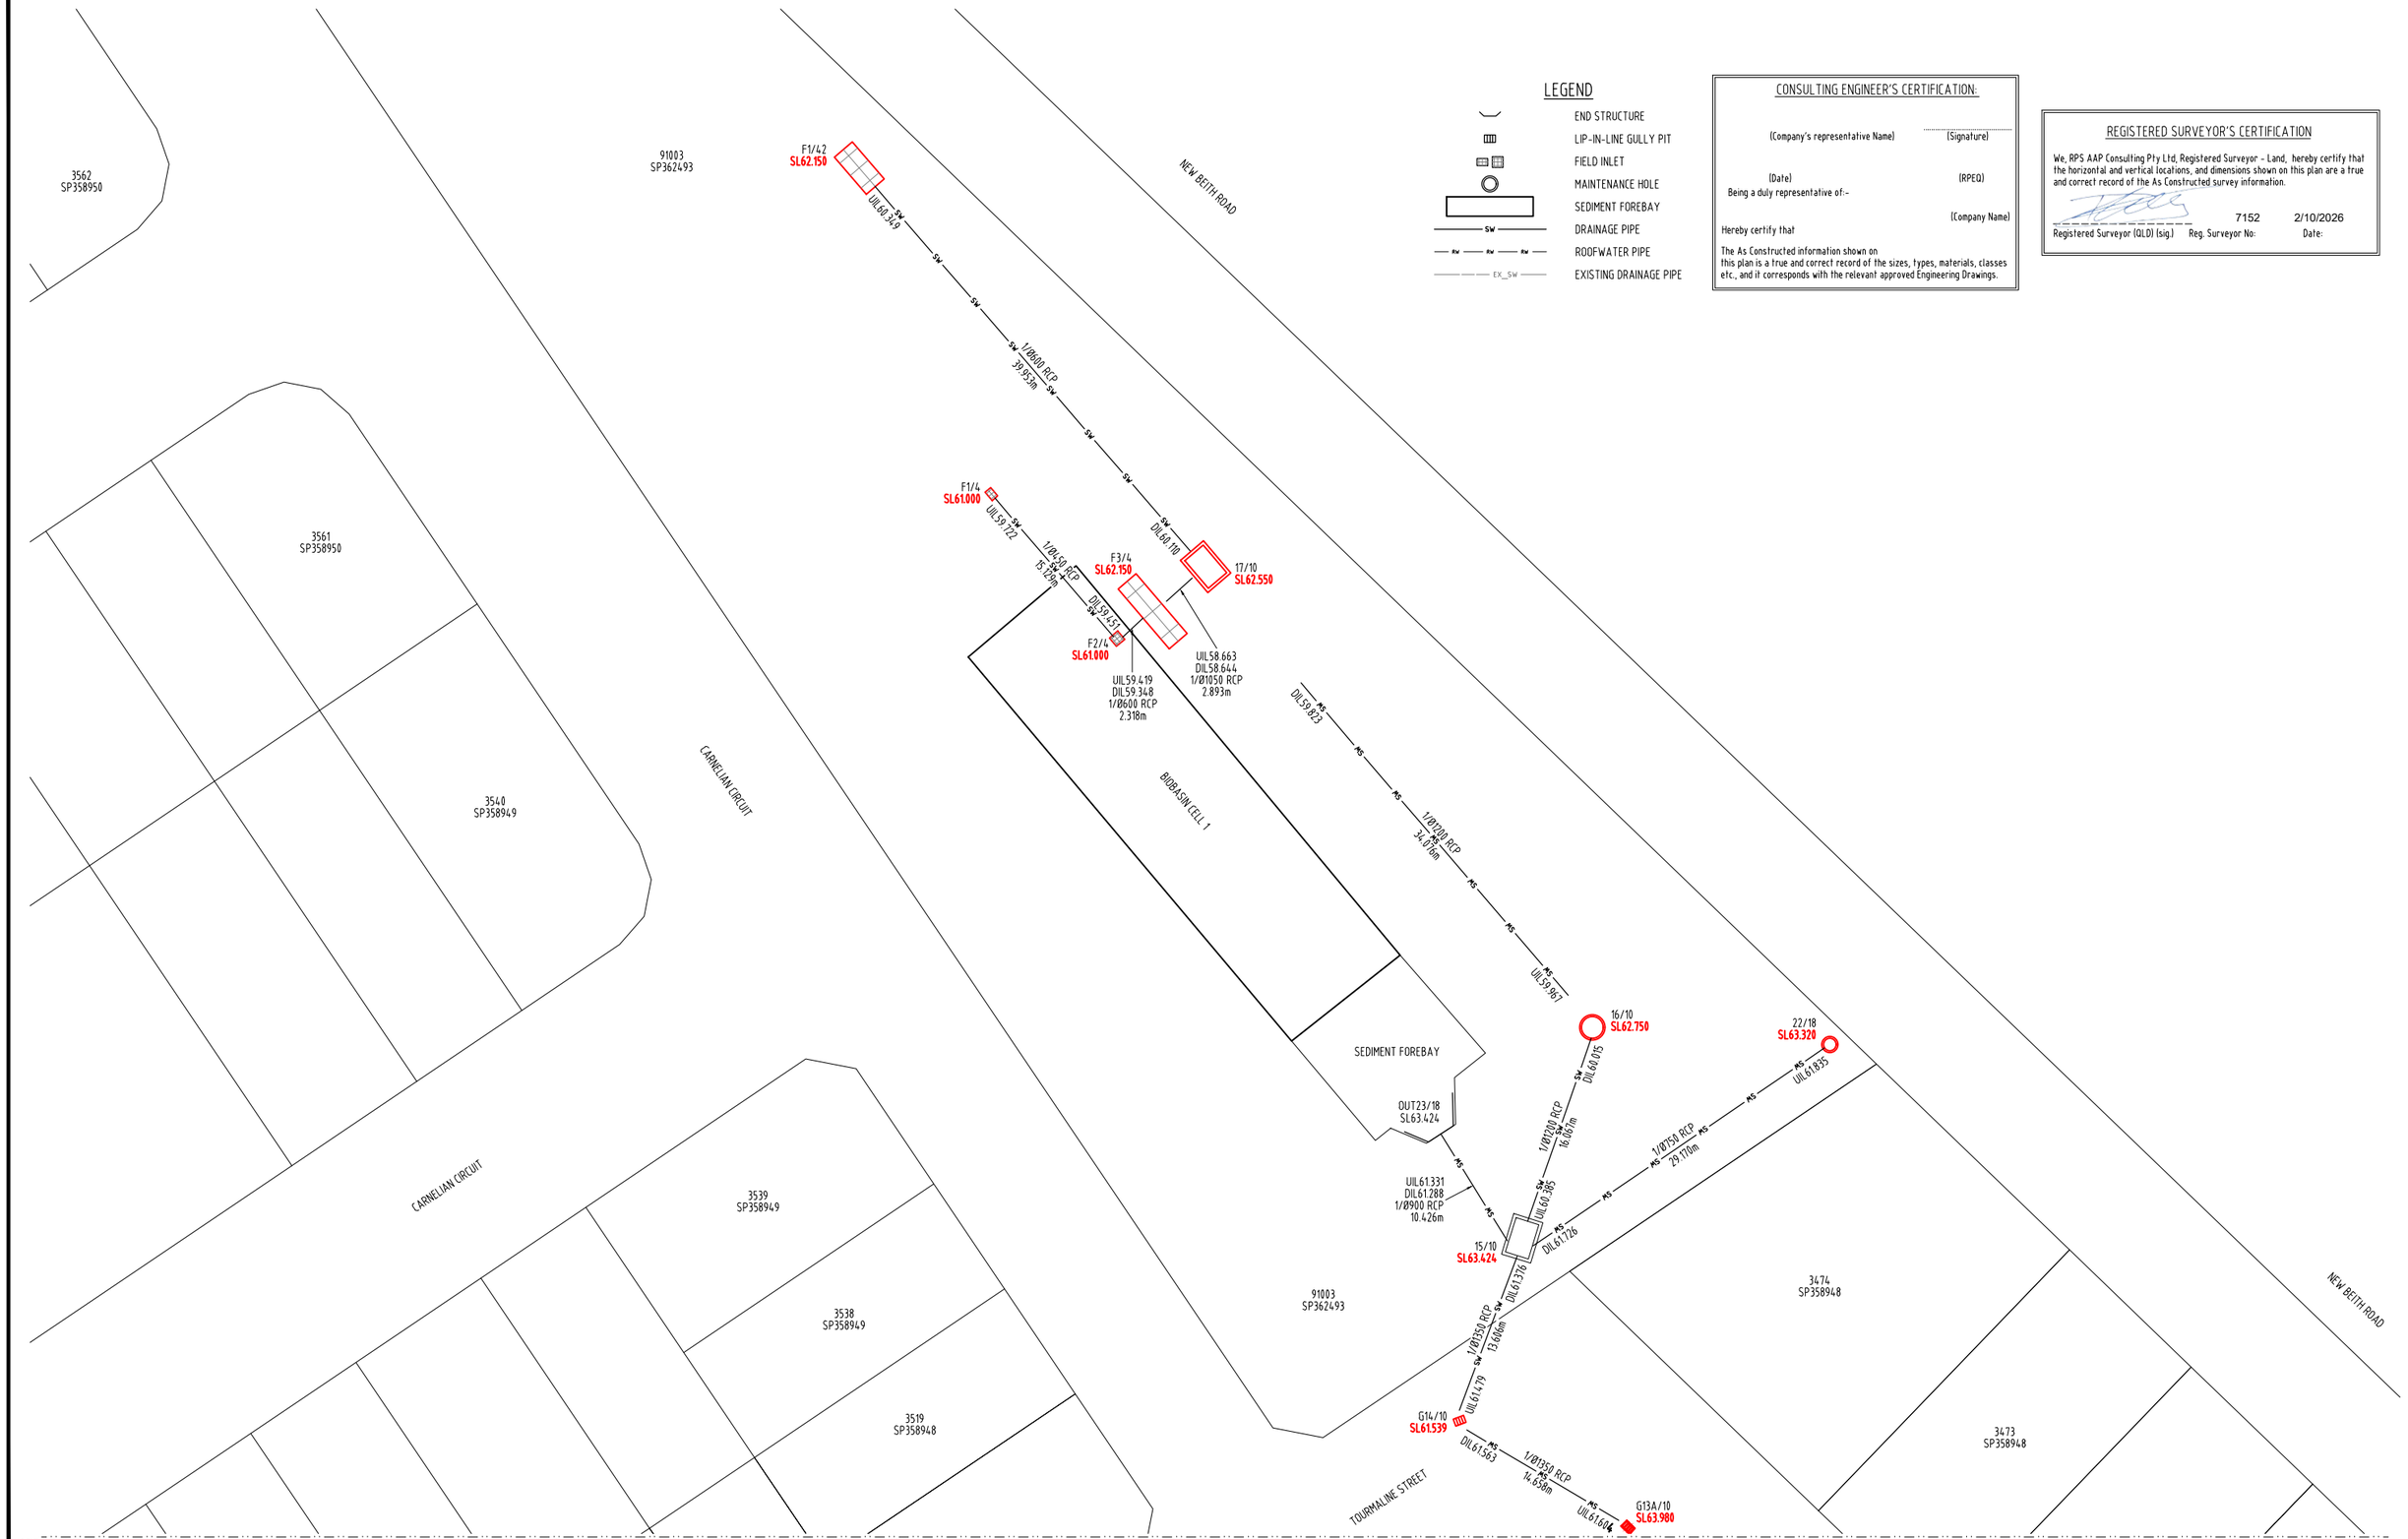

A1

INDEX	DATE	REVISIONS	DRAWN	CHECKED	PASSED
----	----	----	----	----	----
----	----	----	----	----	----
----	----	----	----	----	----
B	02/10/2026	AMENDED AS CONSTRUCTED	BAS	DF	DJL
A	31/07/2026	ISSUED AS CONSTRUCTED	JDP	----	----

APPROVED OPERATIONAL WORKS NUMBER: DEV2012/403

	INITIALS	DATE
DRAWN	BAS	02/10/2026
CHECKED	DF	02/10/2026
PASSED	DJL	02/10/2026

N

AS CONSTRUCTED

5 2.5 0 2.5 5 7.5 10 12.5

SCALE OF METRES
1:250 FULL SIZE A1 SHEET

RPS AAP Consulting Pty Ltd
ACN 117 883 173
ABN 97 117 883 173
Level 8
31 Duncan Street
PO Box 1559
Fortitude Valley QLD 4006
T +61 7 3539 9500
W rpsgroup.com
A TETRA TECH COMPANY

©COPYRIGHT PROTECTS THIS PLAN
Unauthorised reproduction or amendment not permitted. Please contact the author.

CITY OF LOGAN

CITY OF LOGAN

FLAGSTONE CITY
STAGE 18B
STORMWATER DRAINAGE AS CONSTRUCTED

SCALE 1:250
SHEET 1 OF 3 SHEETS
DRAWING NO. TLX370977-84
---- ---- ---- B A

S:\Survey\Projects TLX\TLX370977 - Flagstone\12D\As Constructed\Stage 10\8 FME Processing\Stage 10B\TLX370977-84 B Stage 10B Storm.dwg

FOR CONTINUATION REFER SHEET 1

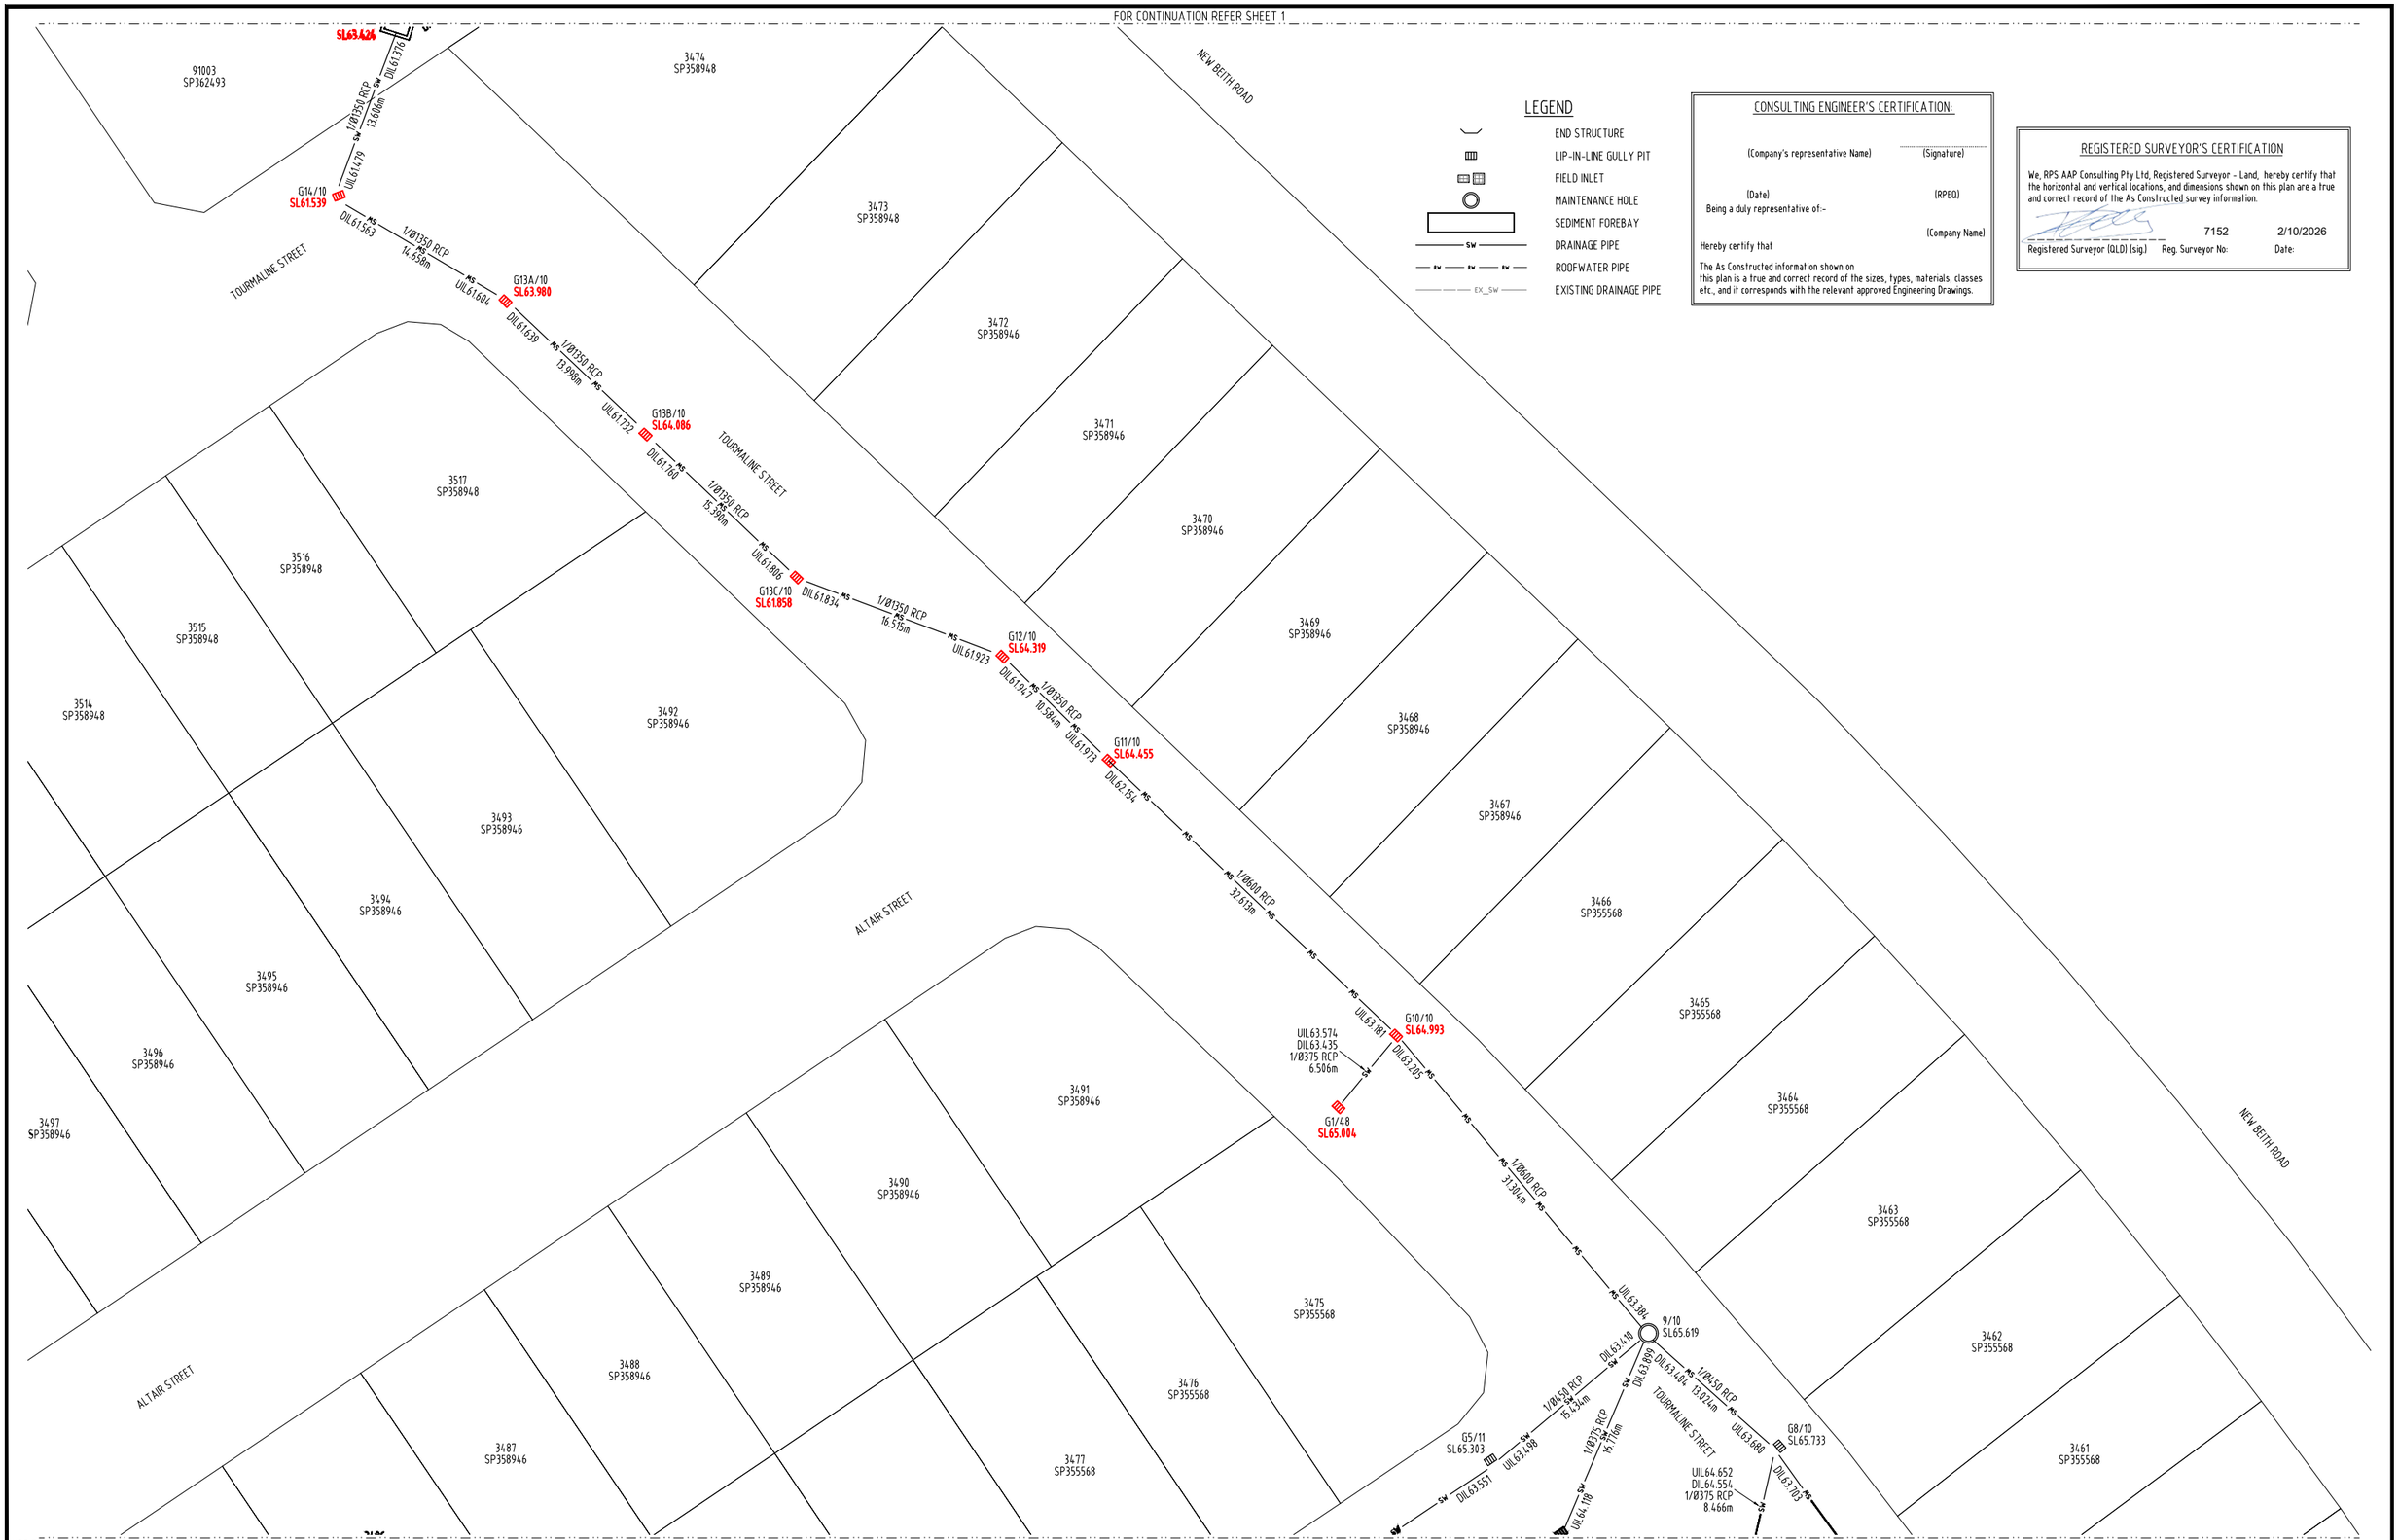

LEGEND

- END STRUCTURE
- LIP-IN-LINE GULLY PIT
- FIELD INLET
- MAINTENANCE HOLE
- SEDIMENT FOREBAY
- DRAINAGE PIPE
- ROOFWATER PIPE
- EXISTING DRAINAGE PIPE

CONSULTING ENGINEER'S CERTIFICATION:

(Company's representative Name) (Signature)

(Date) (RPEQ)

Being a duly representative of:-

(Company Name)

Hereby certify that

The As Constructed information shown on this plan is a true and correct record of the sizes, types, materials, classes etc., and it corresponds with the relevant approved Engineering Drawings.

REGISTERED SURVEYOR'S CERTIFICATION

We, RPS AAP Consulting Pty Ltd, Registered Surveyor - Land, hereby certify that the horizontal and vertical locations, and dimensions shown on this plan are a true and correct record of the As Constructed survey information.

Registered Surveyor (QLD) (sig.) | Reg. Surveyor No: 7152 | Date: 2/10/2026

HORIZONTAL COORDINATES(E,N) SUPPLIED ARE MAPPING GRID OF AUSTRALIA(MGA), ZONE 56 BASED ON THE UNIVERSAL TRANSVERSE MERCATOR PROJECTION AND THE GEOCENTRIC DATUM OF AUSTRALIA 2020.

FOR CONTINUATION REFER SHEET 3

A1

INDEX	DATE	REVISIONS	DRAWN	CHECKED	PASSED
----	----	----	----	----	----
----	----	----	----	----	----
----	----	----	----	----	----
B	02/10/2026	AMENDED AS CONSTRUCTED	BAS	DF	DJL
A	31/07/2026	ISSUED AS CONSTRUCTED	JDP	----	----

APPROVED OPERATIONAL WORKS NUMBER: DEV2012/403		
DRAWN	BAS	02/10/2026
CHECKED	DF	02/10/2026
PASSED	DJL	02/10/2026
	INITIALS	DATE

N

AS CONSTRUCTED

5 2.5 0 2.5 5 7.5 10 12.5

SCALE OF METRES
1:250 FULL SIZE A1 SHEET

RPS AAP Consulting Pty Ltd
ACN 117 883 173
ABN 97 117 883 173
Level 8
31 Duncan Street
PO Box 1559
Fortitude Valley QLD 4006
T +61 7 3539 9500
W rpsgroup.com

A TETRA TECH COMPANY
©COPYRIGHT PROTECTS THIS PLAN Unauthorised reproduction or amendment not permitted. Please contact the author.

CITY OF LOGAN

CITY OF LOGAN

FLAGSTONE CITY
STAGE 18B
STORMWATER DRAINAGE AS CONSTRUCTED

SCALE 1:250
SHEET 2 OF 3 SHEETS
DRAWING NO. TLX370977-84
---- ---- ---- B A

S:\Survey\Projects TLX\TLX370977 - Flagstone\12D\As Constructed\Stage 10\8 FME Processing\Stage 10B\TLX370977-84 B Stage 10B Storm.dwg

FOR CONTINUATION REFER SHEET 2

ALTAIR STREET
AMETHYST STREET
TOURMALINE STREET
GARNET CRESCENT

3489 SP358946
3488 SP358946
3487 SP358946
3486 SP358946
3485 SP358946
3484 SP358946
3483 SP355568
4651 SP355568
4650 SP355568
3475 SP355568
3476 SP355568
3477 SP355568
3478 SP355568
3479 SP355568
3480 SP355568
3481 SP355568
3482 SP355568
3462 SP355568
3461 SP355568
3460 SP355571
3459 SP355571
3458 SP355571
3399 SP355568
3398 SP355568
3397 SP355568
3396 SP355568
3395 SP355568
3394 SP355568
3393 SP355568
3392 SP355568
3391 FUTURE SP
3390 FUTURE SP
3421 FUTURE SP
3400 SP355572
3401 SP355572
3402 SP355572
3403 SP355572
3404 SP355572
3405 SP355572
3406 SP355572
3419 SP355572
3418 SP355572
3417 SP355572
3416 SP355572
3422 SP355572

UIL63.304
9/10 SL65.619
DIL63.410
DIL63.880
DIL63.684
1/Ø450 RCP 13.072m
UIL63.680
G8/10 SL65.733
DIL63.705
1/Ø450 RCP 15.434m
1/Ø375 RCP 16.774m
UIL64.652
DIL64.554
1/Ø375 RCP 8.466m
G1/23 SL65.884
G5/11 SL65.303
UIL63.488
DIL63.551
1/Ø375 RCP 56.986m
UIL64.118
G5/11 SL65.317
1/Ø450 RCP 56.495m
UIL64.297
G7/10 SL66.874
DIL68.238
UIL67.376
G4/11 SL69.704
DIL68.337
1/Ø375 RCP 11.239m
UIL69.511
G1/22 SL70.862
1/Ø375 RCP 38.451m
G3/11 SL74.461
UIL73.054
DIL73.137
1/Ø375 RCP 25.438m
G2/11 SL77.667
UIL76.410
DIL76.472
1/Ø375 RCP 11.633m
UIL77.355
G1/11 SL78.809

LEGEND

- END STRUCTURE
- LIP-IN-LINE GULLY PIT
- FIELD INLET
- MAINTENANCE HOLE
- SEDIMENT FOREBAY
- SW — DRAINAGE PIPE
- RW RW RW — ROOFWATER PIPE
- EX_SW — EXISTING DRAINAGE PIPE

CONSULTING ENGINEER'S CERTIFICATION:

(Company's representative Name) (Signature)

(Date) (RPEQ)

Being a duly representative of:-

(Company Name)

Hereby certify that

The As Constructed information shown on this plan is a true and correct record of the sizes, types, materials, classes etc., and it corresponds with the relevant approved Engineering Drawings.

REGISTERED SURVEYOR'S CERTIFICATION

We, RPS AAP Consulting Pty Ltd, Registered Surveyor - Land, hereby certify that the horizontal and vertical locations, and dimensions shown on this plan are a true and correct record of the As Constructed survey information.

Registered Surveyor (QLD) (sig.) | Reg. Surveyor No: 7152 | Date: 2/10/2026

HORIZONTAL COORDINATES(E,N) SUPPLIED ARE MAPPING GRID OF AUSTRALIA(MGA), ZONE 56 BASED ON THE UNIVERSAL TRANSVERSE MERCATOR PROJECTION AND THE GEOCENTRIC DATUM OF AUSTRALIA 2020.

A1

INDEX	DATE	REVISIONS	DRAWN	CHECKED	PASSED
----	----	----	----	----	----
----	----	----	----	----	----
----	----	----	----	----	----
B	02/10/2026	AMENDED AS CONSTRUCTED	BAS	DF	DJL
A	31/07/2026	ISSUED AS CONSTRUCTED	JDP	----	----

APPROVED OPERATIONAL WORKS NUMBER: DEV2012/403

DRAWN	BAS	02/10/2026
CHECKED	DF	02/10/2026
PASSED	DJL	02/10/2026
	INITIALS	DATE

N

AS CONSTRUCTED

5 2.5 0 2.5 5 7.5 10 12.5

SCALE OF METRES
1:250 FULL SIZE A1 SHEET

RPS AAP Consulting Pty Ltd
ACN 117 883 173
ABN 97 117 883 173
Level 8
31 Duncan Street
PO Box 1559
Fortitude Valley QLD 4006
T +61 7 3539 9500
W rpsgroup.com

A TETRA TECH COMPANY

©COPYRIGHT PROTECTS THIS PLAN
Unauthorised reproduction or amendment not permitted. Please contact the author.

CITY OF LOGAN

CITY OF LOGAN

FLAGSTONE CITY
STAGE 18B
STORMWATER DRAINAGE AS CONSTRUCTED

SCALE 1:250
SHEET 3 OF 3 SHEETS
DRAWING NO. TLX370977-84
---- ---- ---- B A

S:\Survey\Projects TLX\TLX370977 - Flagstone\12D\As Constructed\Stage 10\8 FME Processing\Stage 10B\TLX370977-84 B Stage 10B Storm.dwg